


**SURVEYORS CERTIFICATION:**

I, Daniel E. Gilbert, P.S., Reg. Sur. No. 5402, do hereby certify to MIDLAND TITLE SECURITY, INC. and AMERICAN MORTGAGE SOLUTIONS, that on September 8, 1993, that I made a location survey of the premises shown on this plat and that there are no visible easements or encroachments on the ground. The Buildings and other improvements shown were located from actual monumentation found.

*Daniel E. Gilbert*  
**DANIEL E. GILBERT, P.S.**  
 REG. SUR. NO. 5402  
 400 N. PARK ST.  
 BELLEFONTAINE, OHIO 43311  
 TELEPHONE: 1 (513) 593-1428

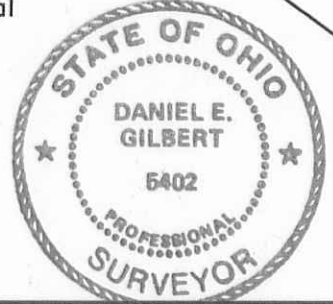

INDEXED ON MAP  
 4847

Reference:  
 Ramseys Addition.  
 Plat Cab. A Slide 105

● - 5/8" Rebars Fd.

<b>Lot No. 132 - Location Survey</b> <b>Ramseys Addition, Village of Belle Center,</b> <b>Richland Township, Logan County, Ohio.</b>		
SCALE: 1" = 20'	APPROVED BY:	DRAWN BY DEG
DATE: 9-8-1993		REVISED
		DRAWING NUMBER
		093-044

S-001