

Area of Encroachment, Lot No. 34-E.

Deed of Reference:  
 William C. Bock  
 O. R. No. 111 Page 623 (8-2-1990).

References:  
 Seminole Shores Subdivision No. 1 (9-17-1944).  
 Plat Cab. A Slide 252.  
 Seminole Shores Subdivision No. 2 (12-14-1944).  
 Plat Cab. A Slide 253.


Symbols:  
 ○ - 5/8" x 30" Rebars Fd.  
 ● - 5/8" x 30" Rebars Set.

William C. Bock Survey - Lot No. 34-E Part and Lot No. 63,  
 Seminole Shores Subdivision No. 1 and 2, Seminole Island,  
 Stokes Township, Logan County, Ohio.

SCALE: 1" = 10'	APPROVED BY:	DRAWN BY: DEG
DATE: 10-6-1993		REVISED:

*Daniel E. Gilbert*  
 Daniel E. Gilbert, P.S.  
 Reg. Sur. No. 5402

DRAWING NUMBER  
 093-046

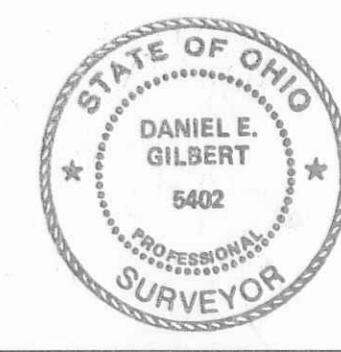

INDEXED ON MAP  
 5042

S-836