


SEE PAGE 33-A

SEE PAGE 32

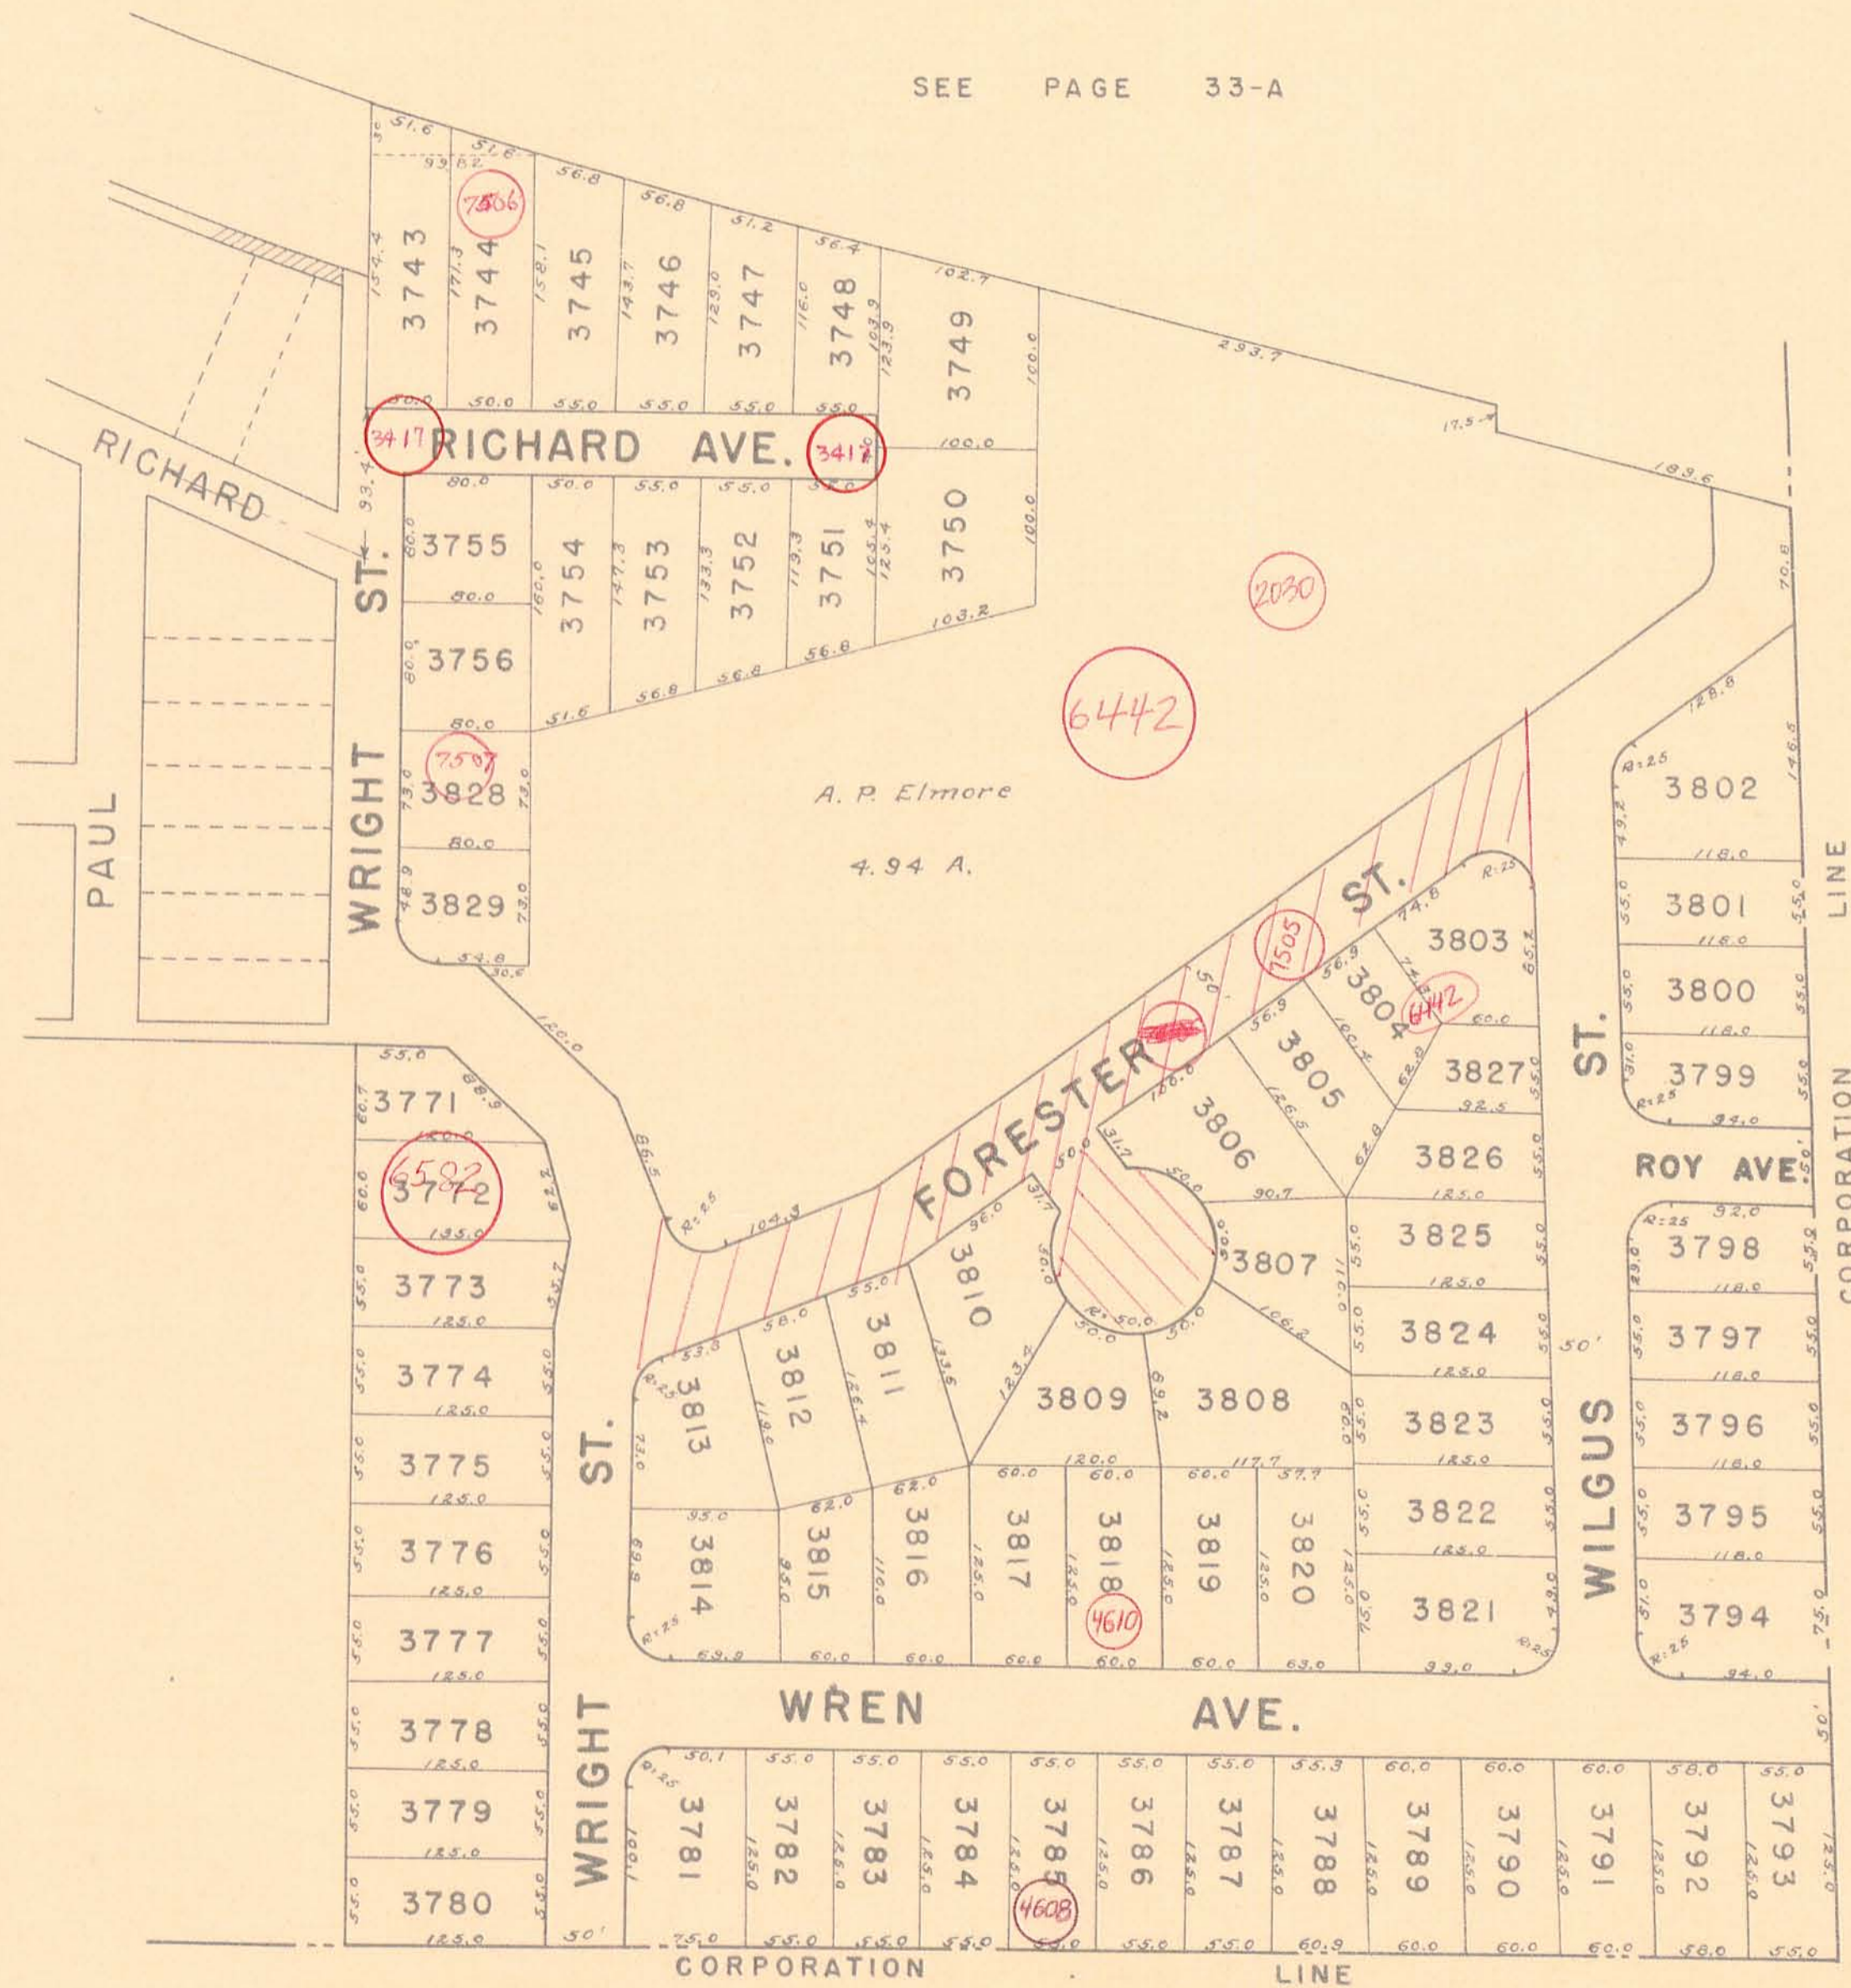

3417 LOTS 3743 TO 3756 SOUTHVIEW ADDITION NO. 1
 3418 LOTS 3771 TO 3829 SOUTHVIEW ADDITION NO. 2

Drawn 12, 10, 1954

C-24-A

1" = 100'