


HARRISON TOWNSHIP

SECTION 15 TOWN 3 RANGE 14

SCALE: 1" = 10 CHAINS = 660'

7907 THOMPSON ESTATES SUBDIVISION

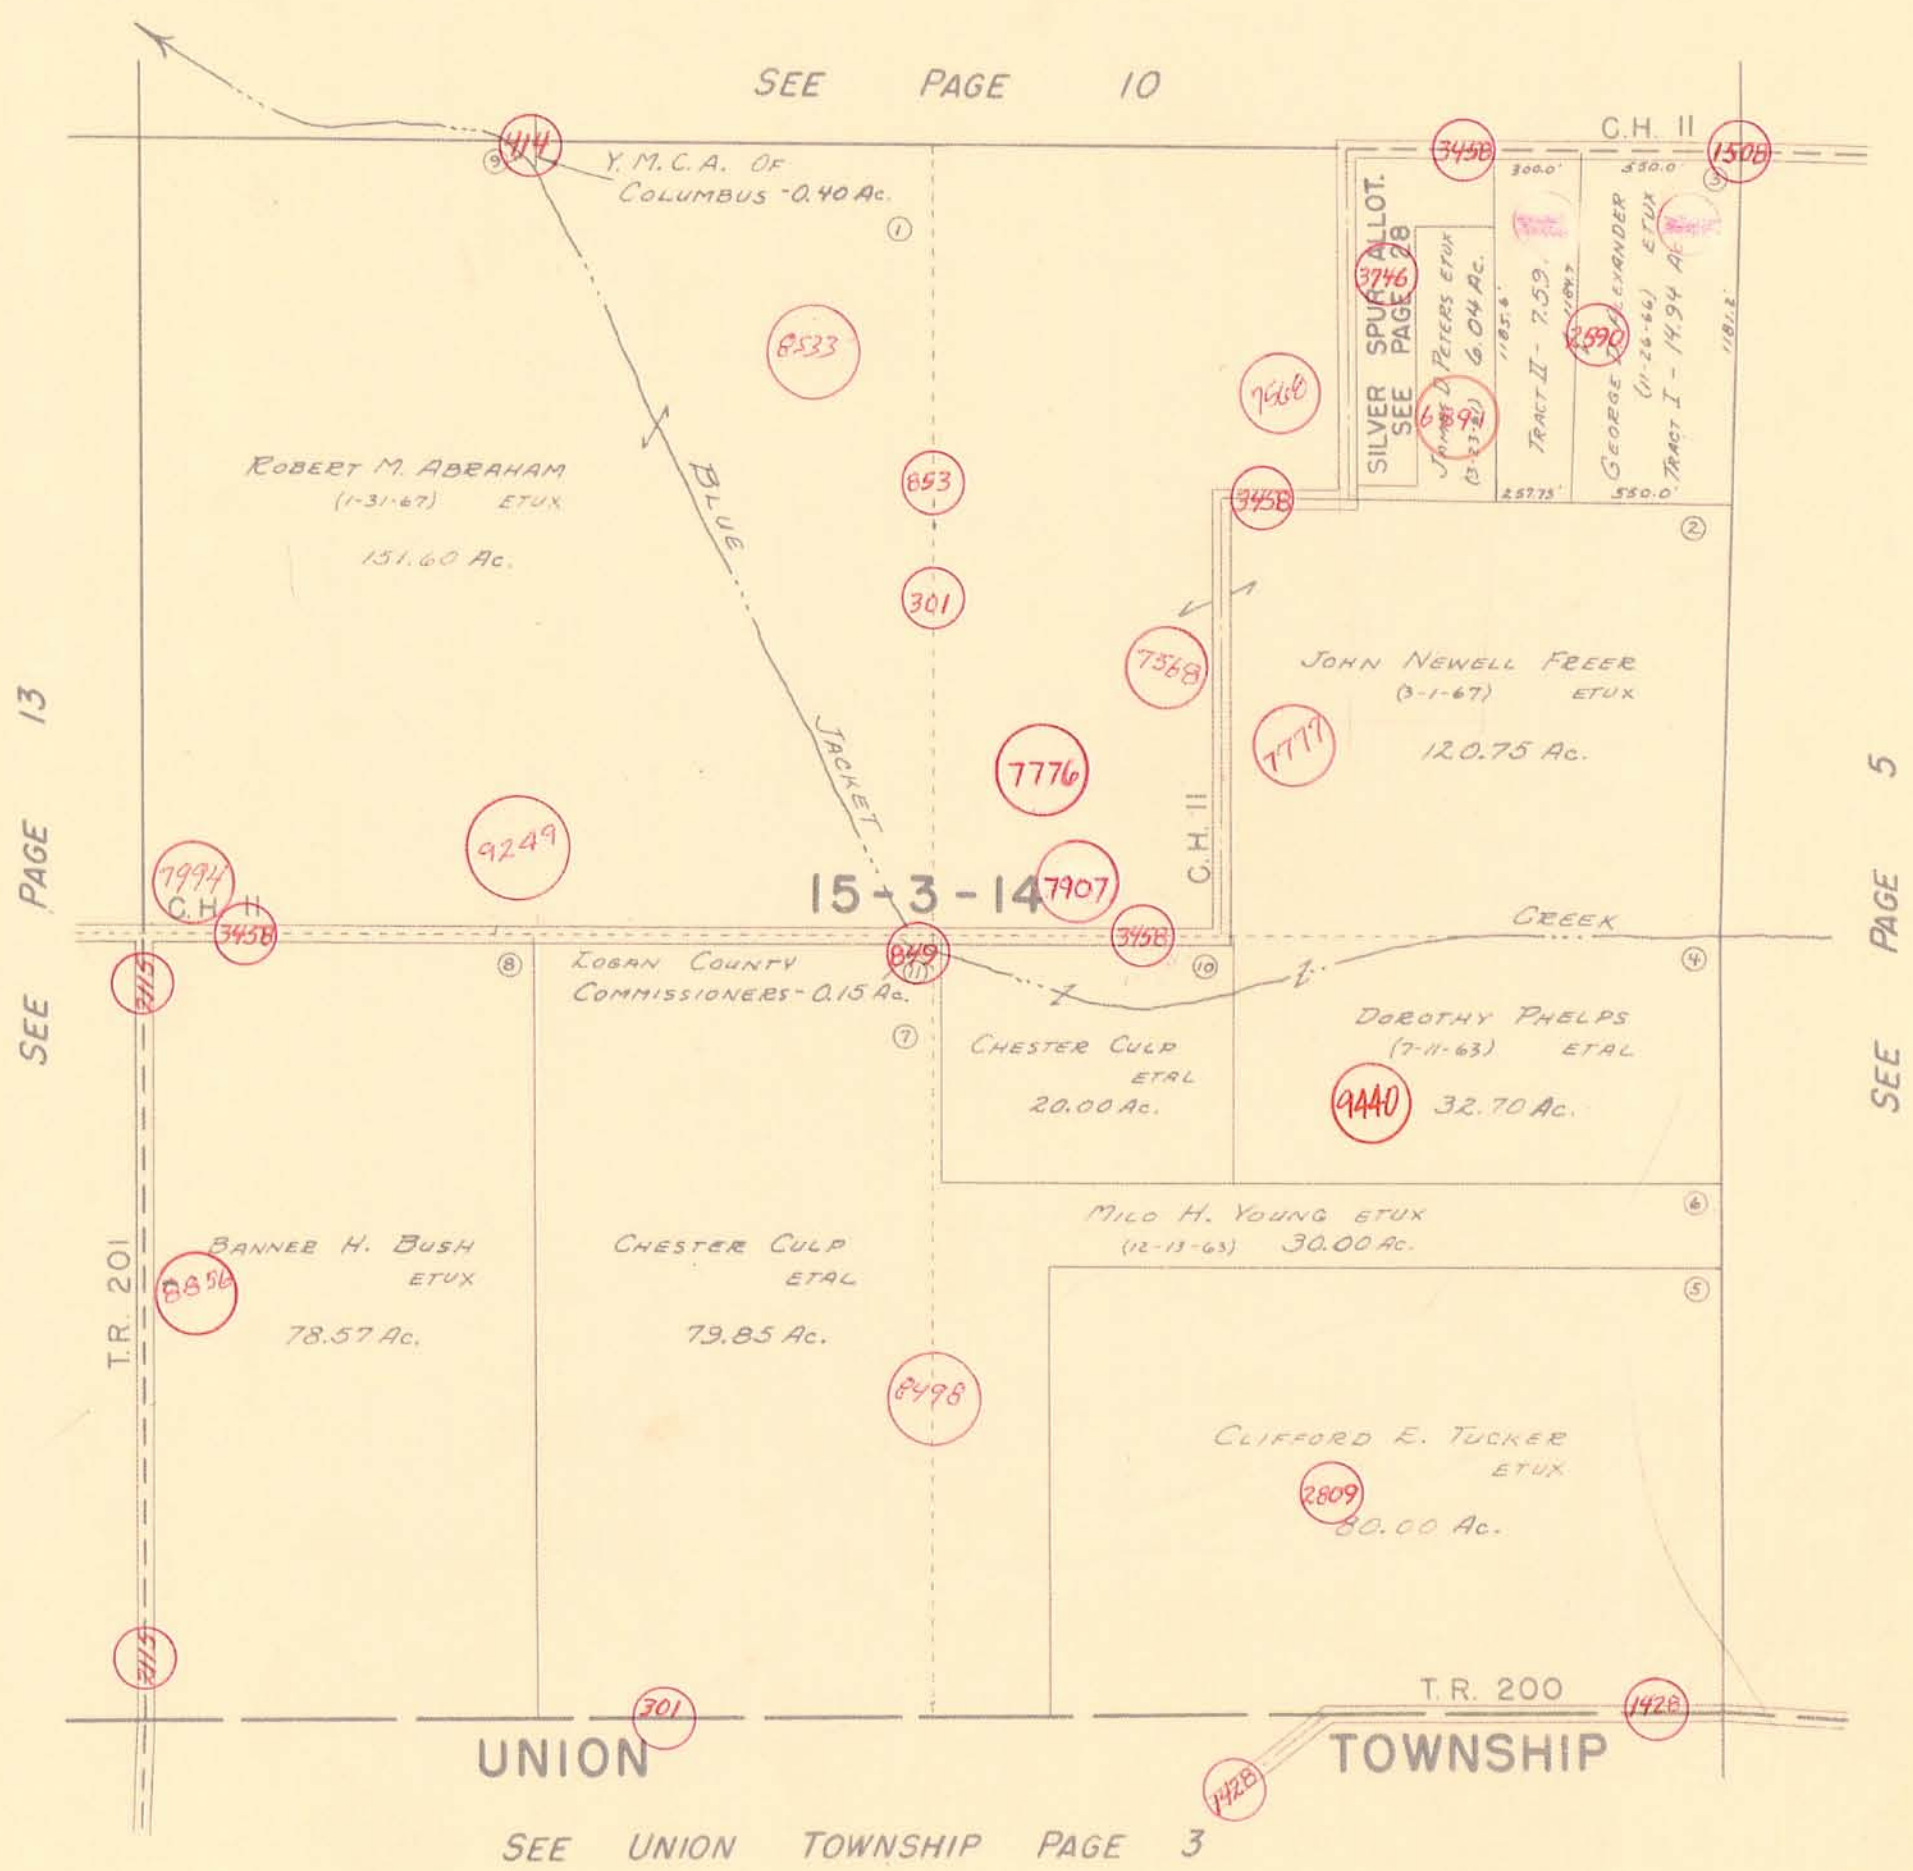

DRAWN: JUNE 5, 1967.
DANIEL E. GILBERT - TMD.