


HARRISON TOWNSHIP
SECTION 25 TOWN 2 RANGE 15

SCALE 10 CHAINS TO THE INCH

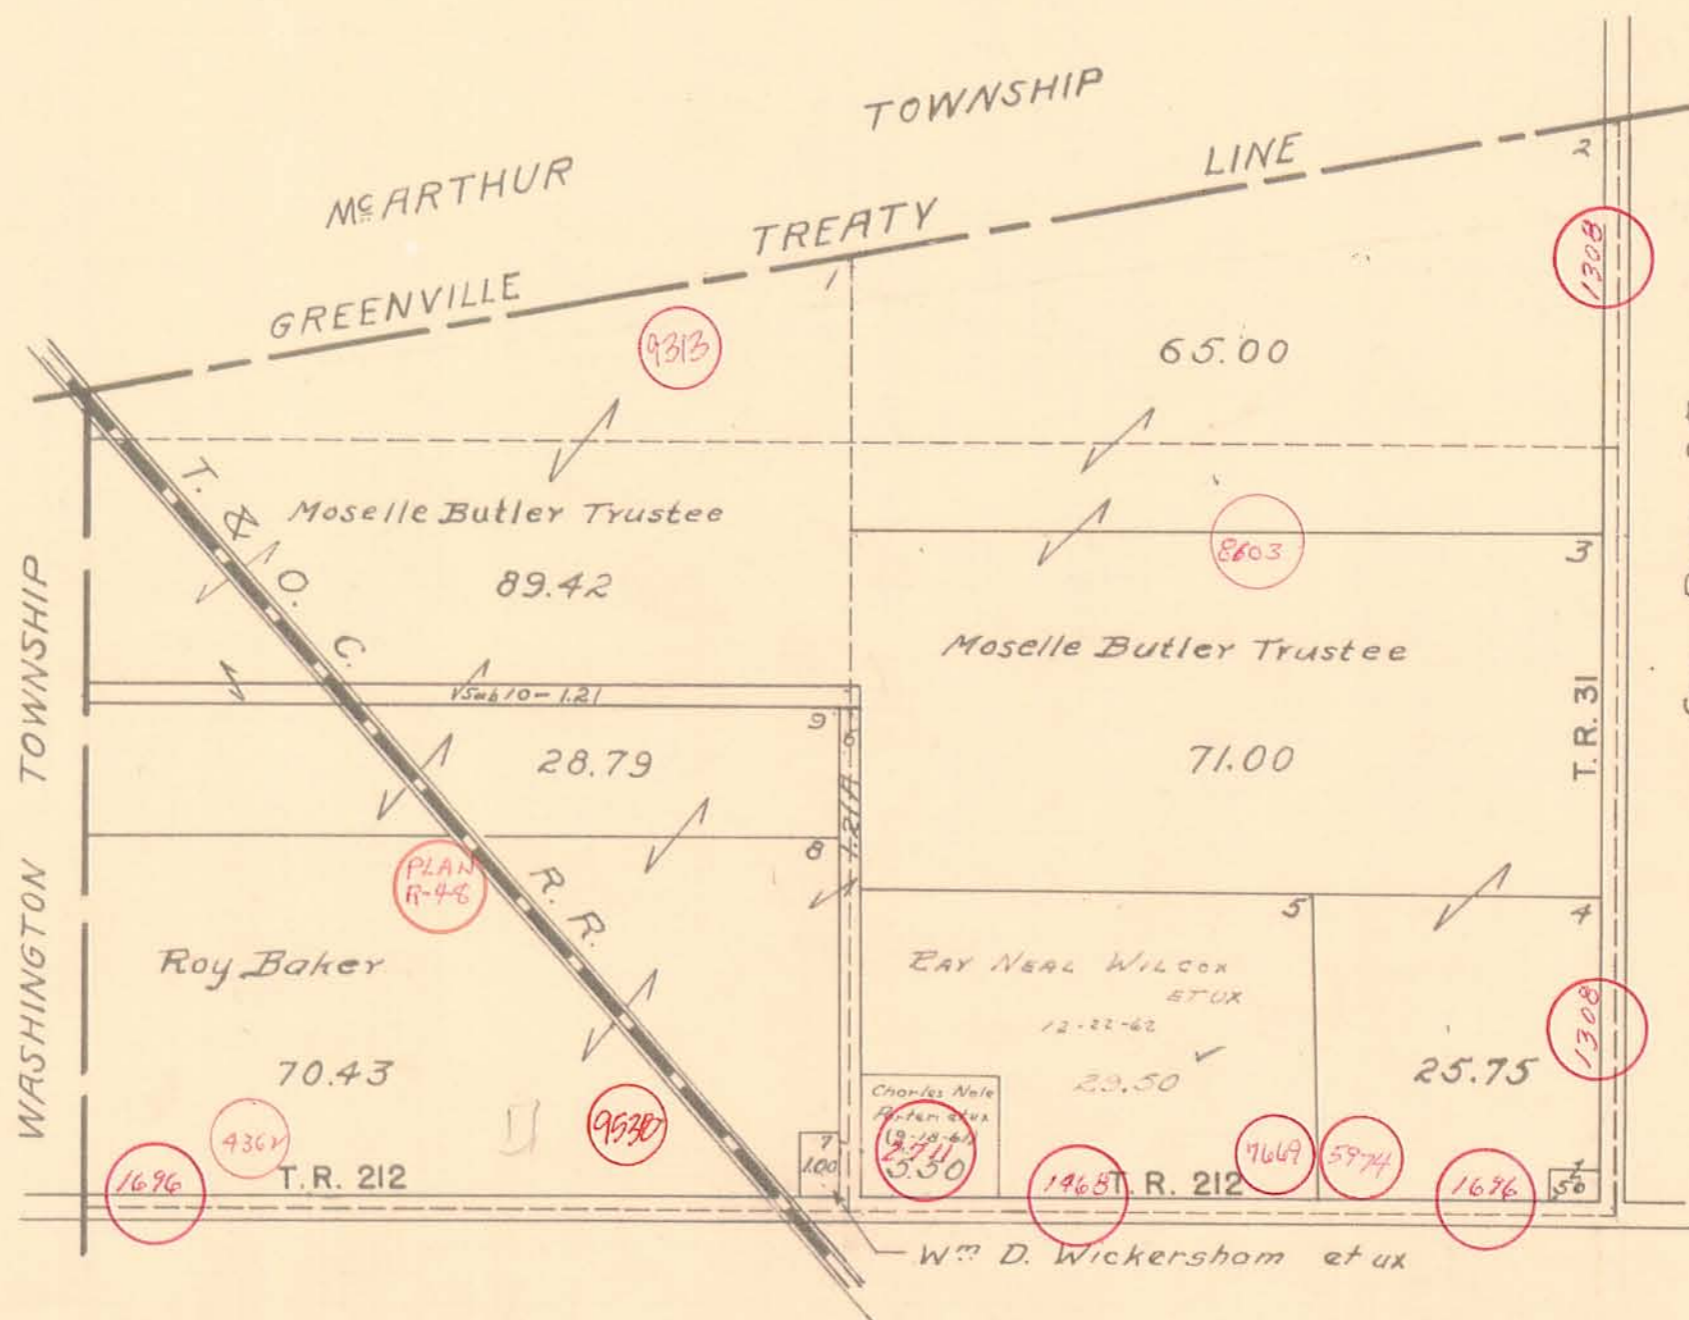

See Page 20

See Page 25

1/1/63
D.E.G.

H.E. Dyserf