


JEFFERSON TOWNSHIP

VIRGINIA MILITARY SURVEY 3437

SCALE: 1"=10 CHAINS=660'

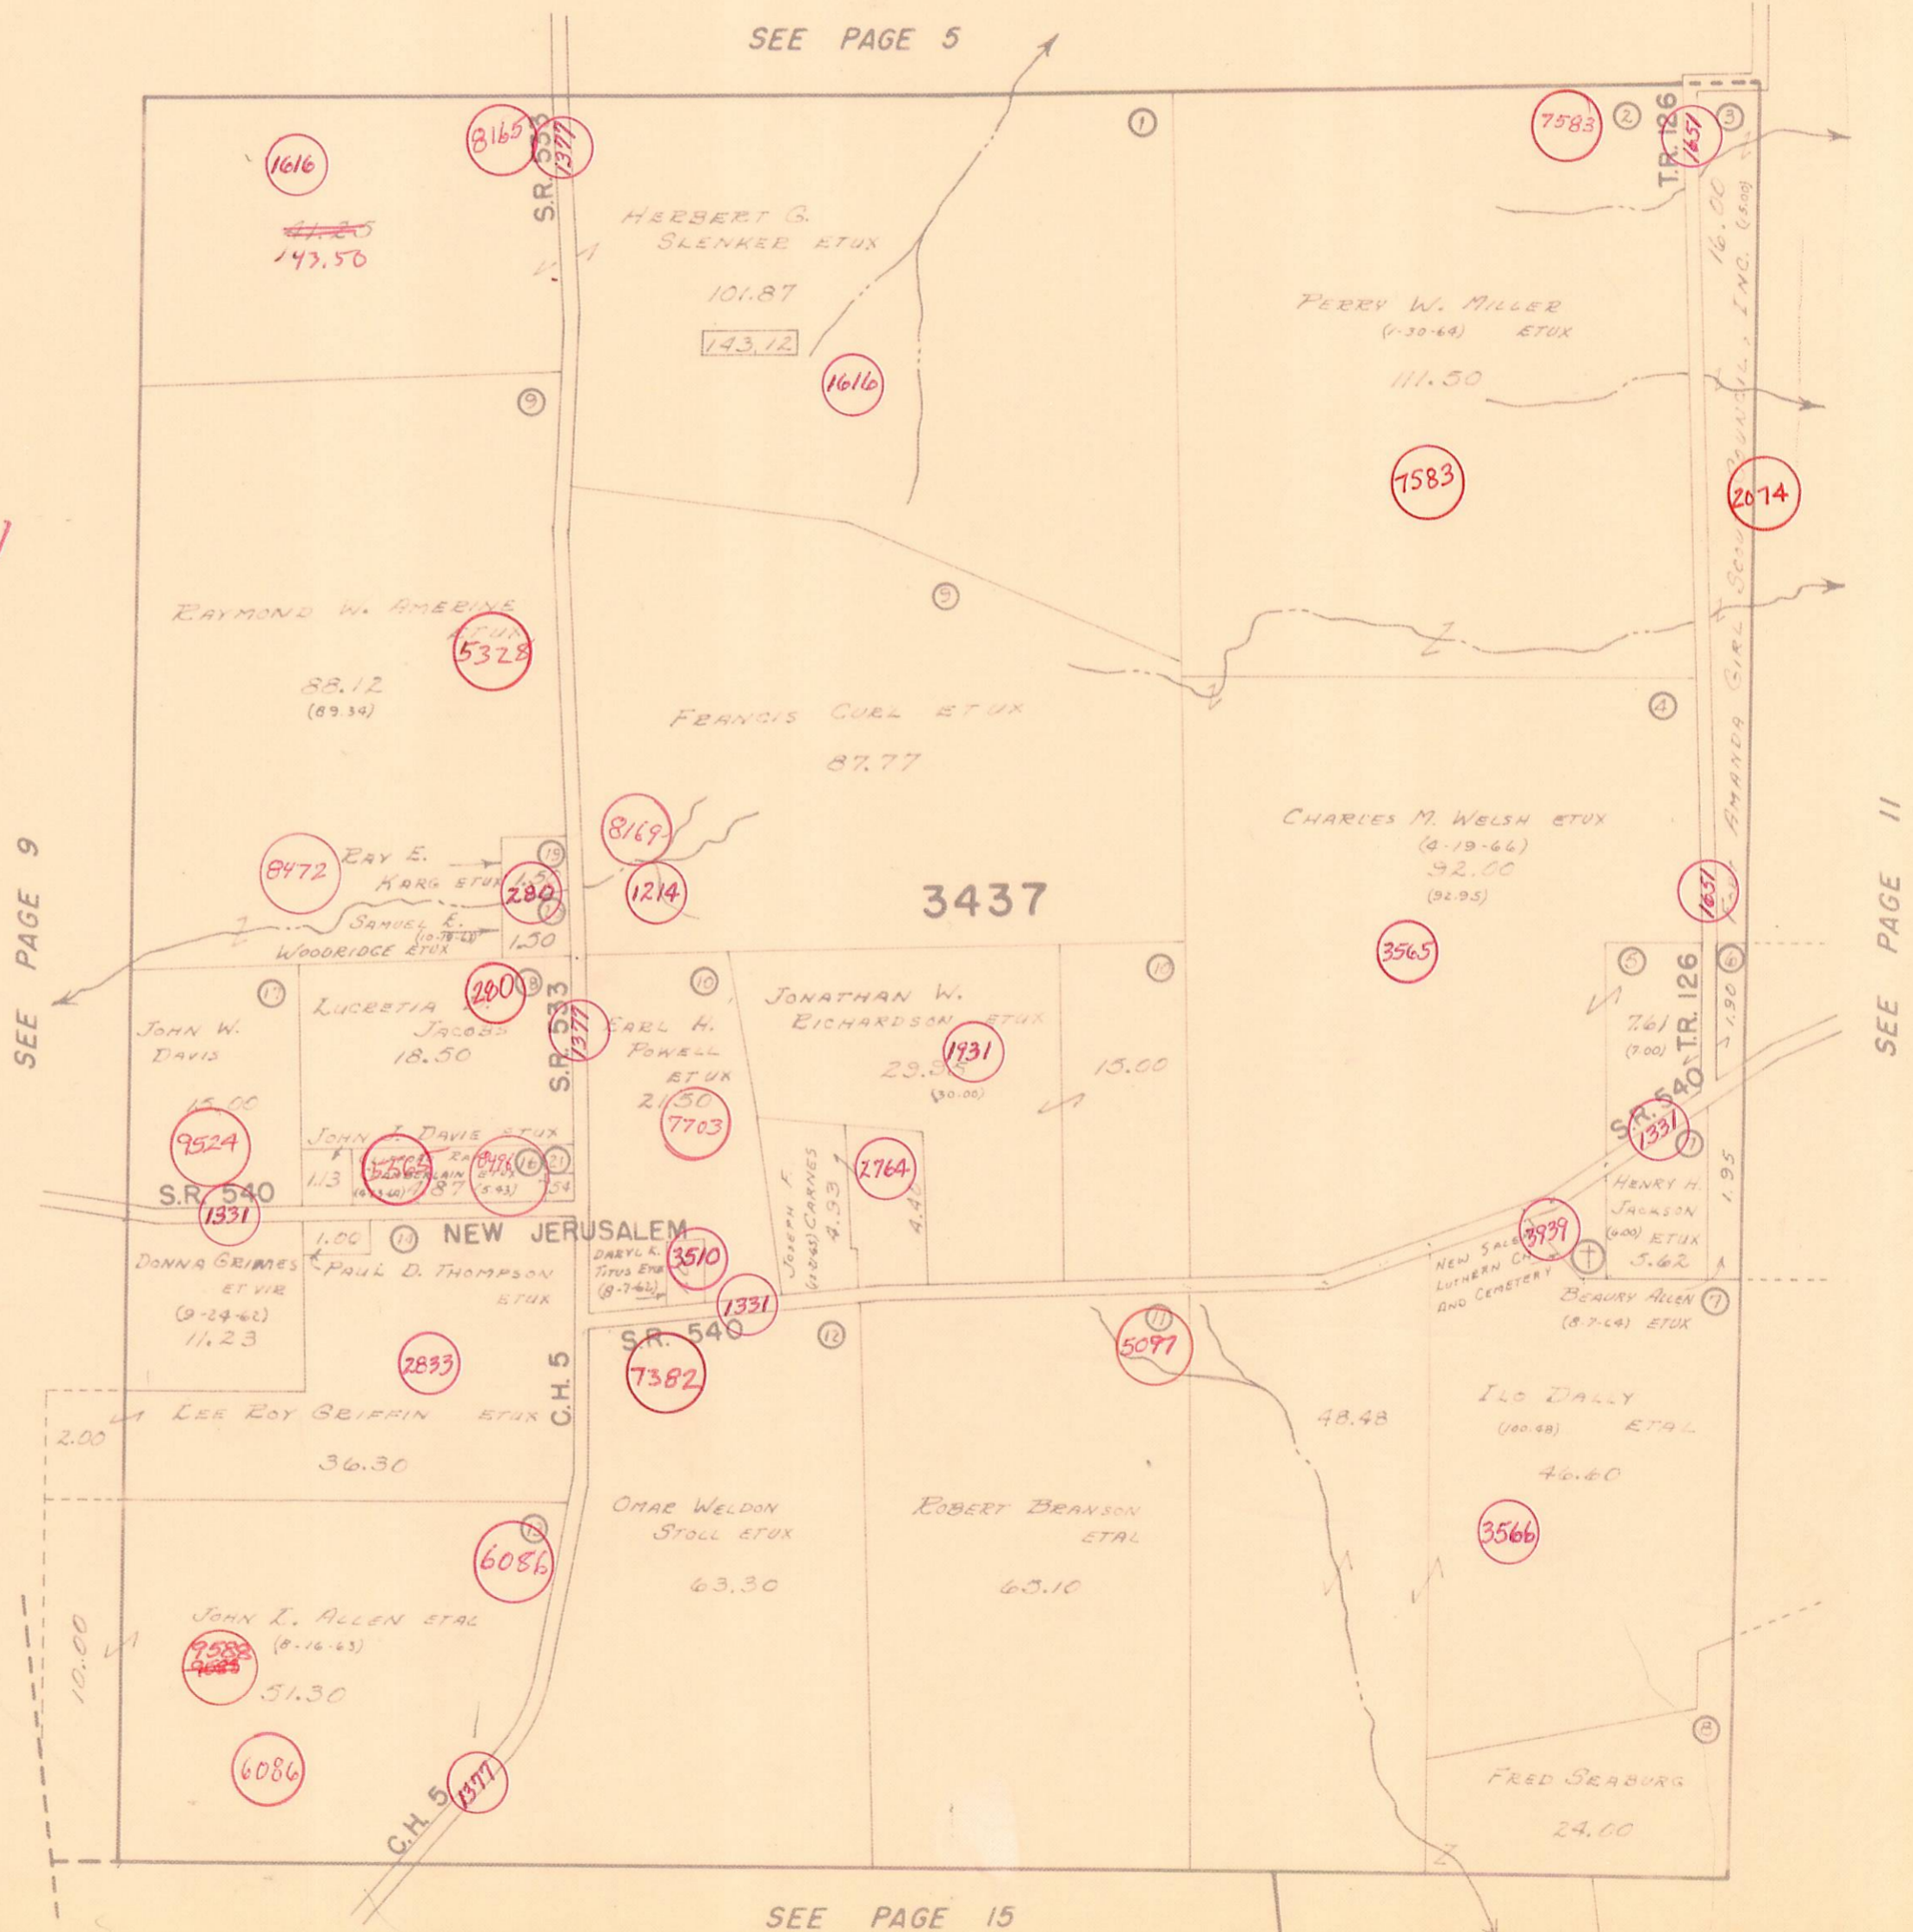

DRAWN AUGUST 7, 1942 BY D.E.G. FROM AERIAL PHOTO