


JEFFERSON TOWNSHIP
VIRGINIA MILITARY SURVEYS 4399 PT. & 4478

SCALE: 1" = 10 CHAINS = 660'

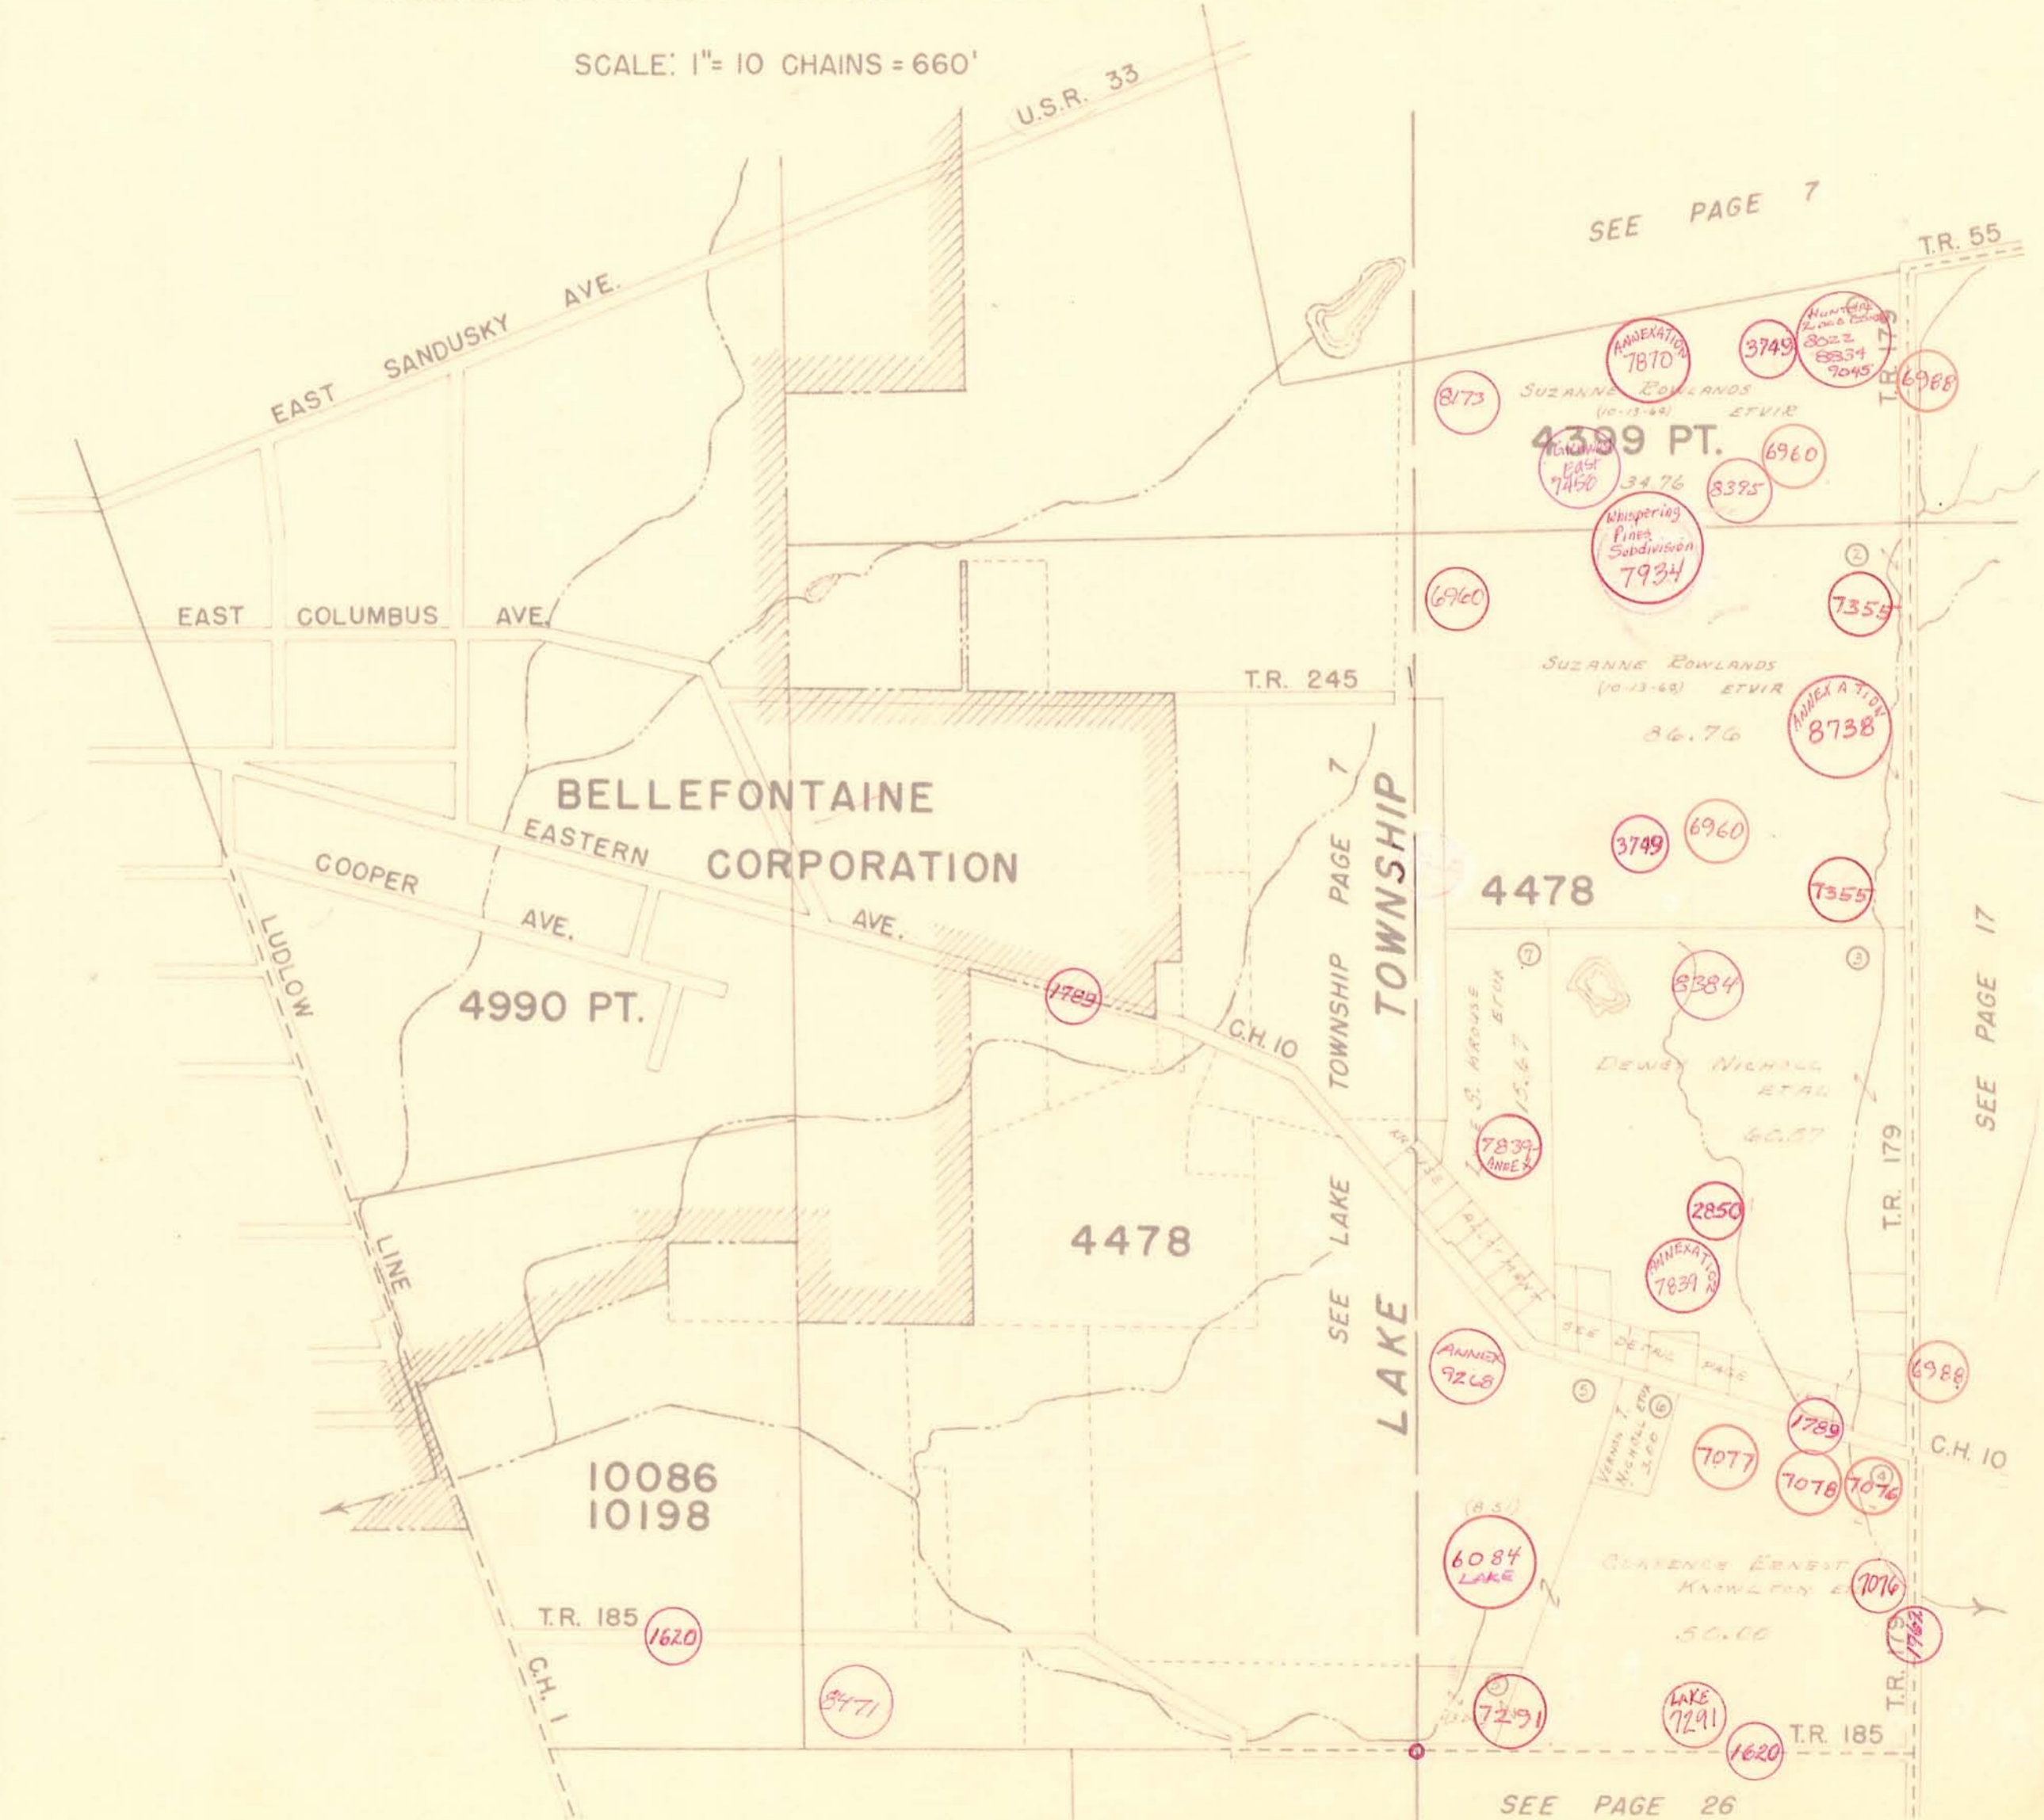

SEE PAGE 7

TR. 55

4399 PT.

4990 PT.

4478

4478

10086
10198

SEE PAGE 26

SEE PAGE 17

DRAWN OCTOBER 30, 1962
BY D.E.G.
FROM AERIAL PHOTO