


JEFFERSON TOWNSHIP

VIRGINIA MILITARY SURVEYS 5088 & 9372

SCALE: 1"=10 CHAINS=660'

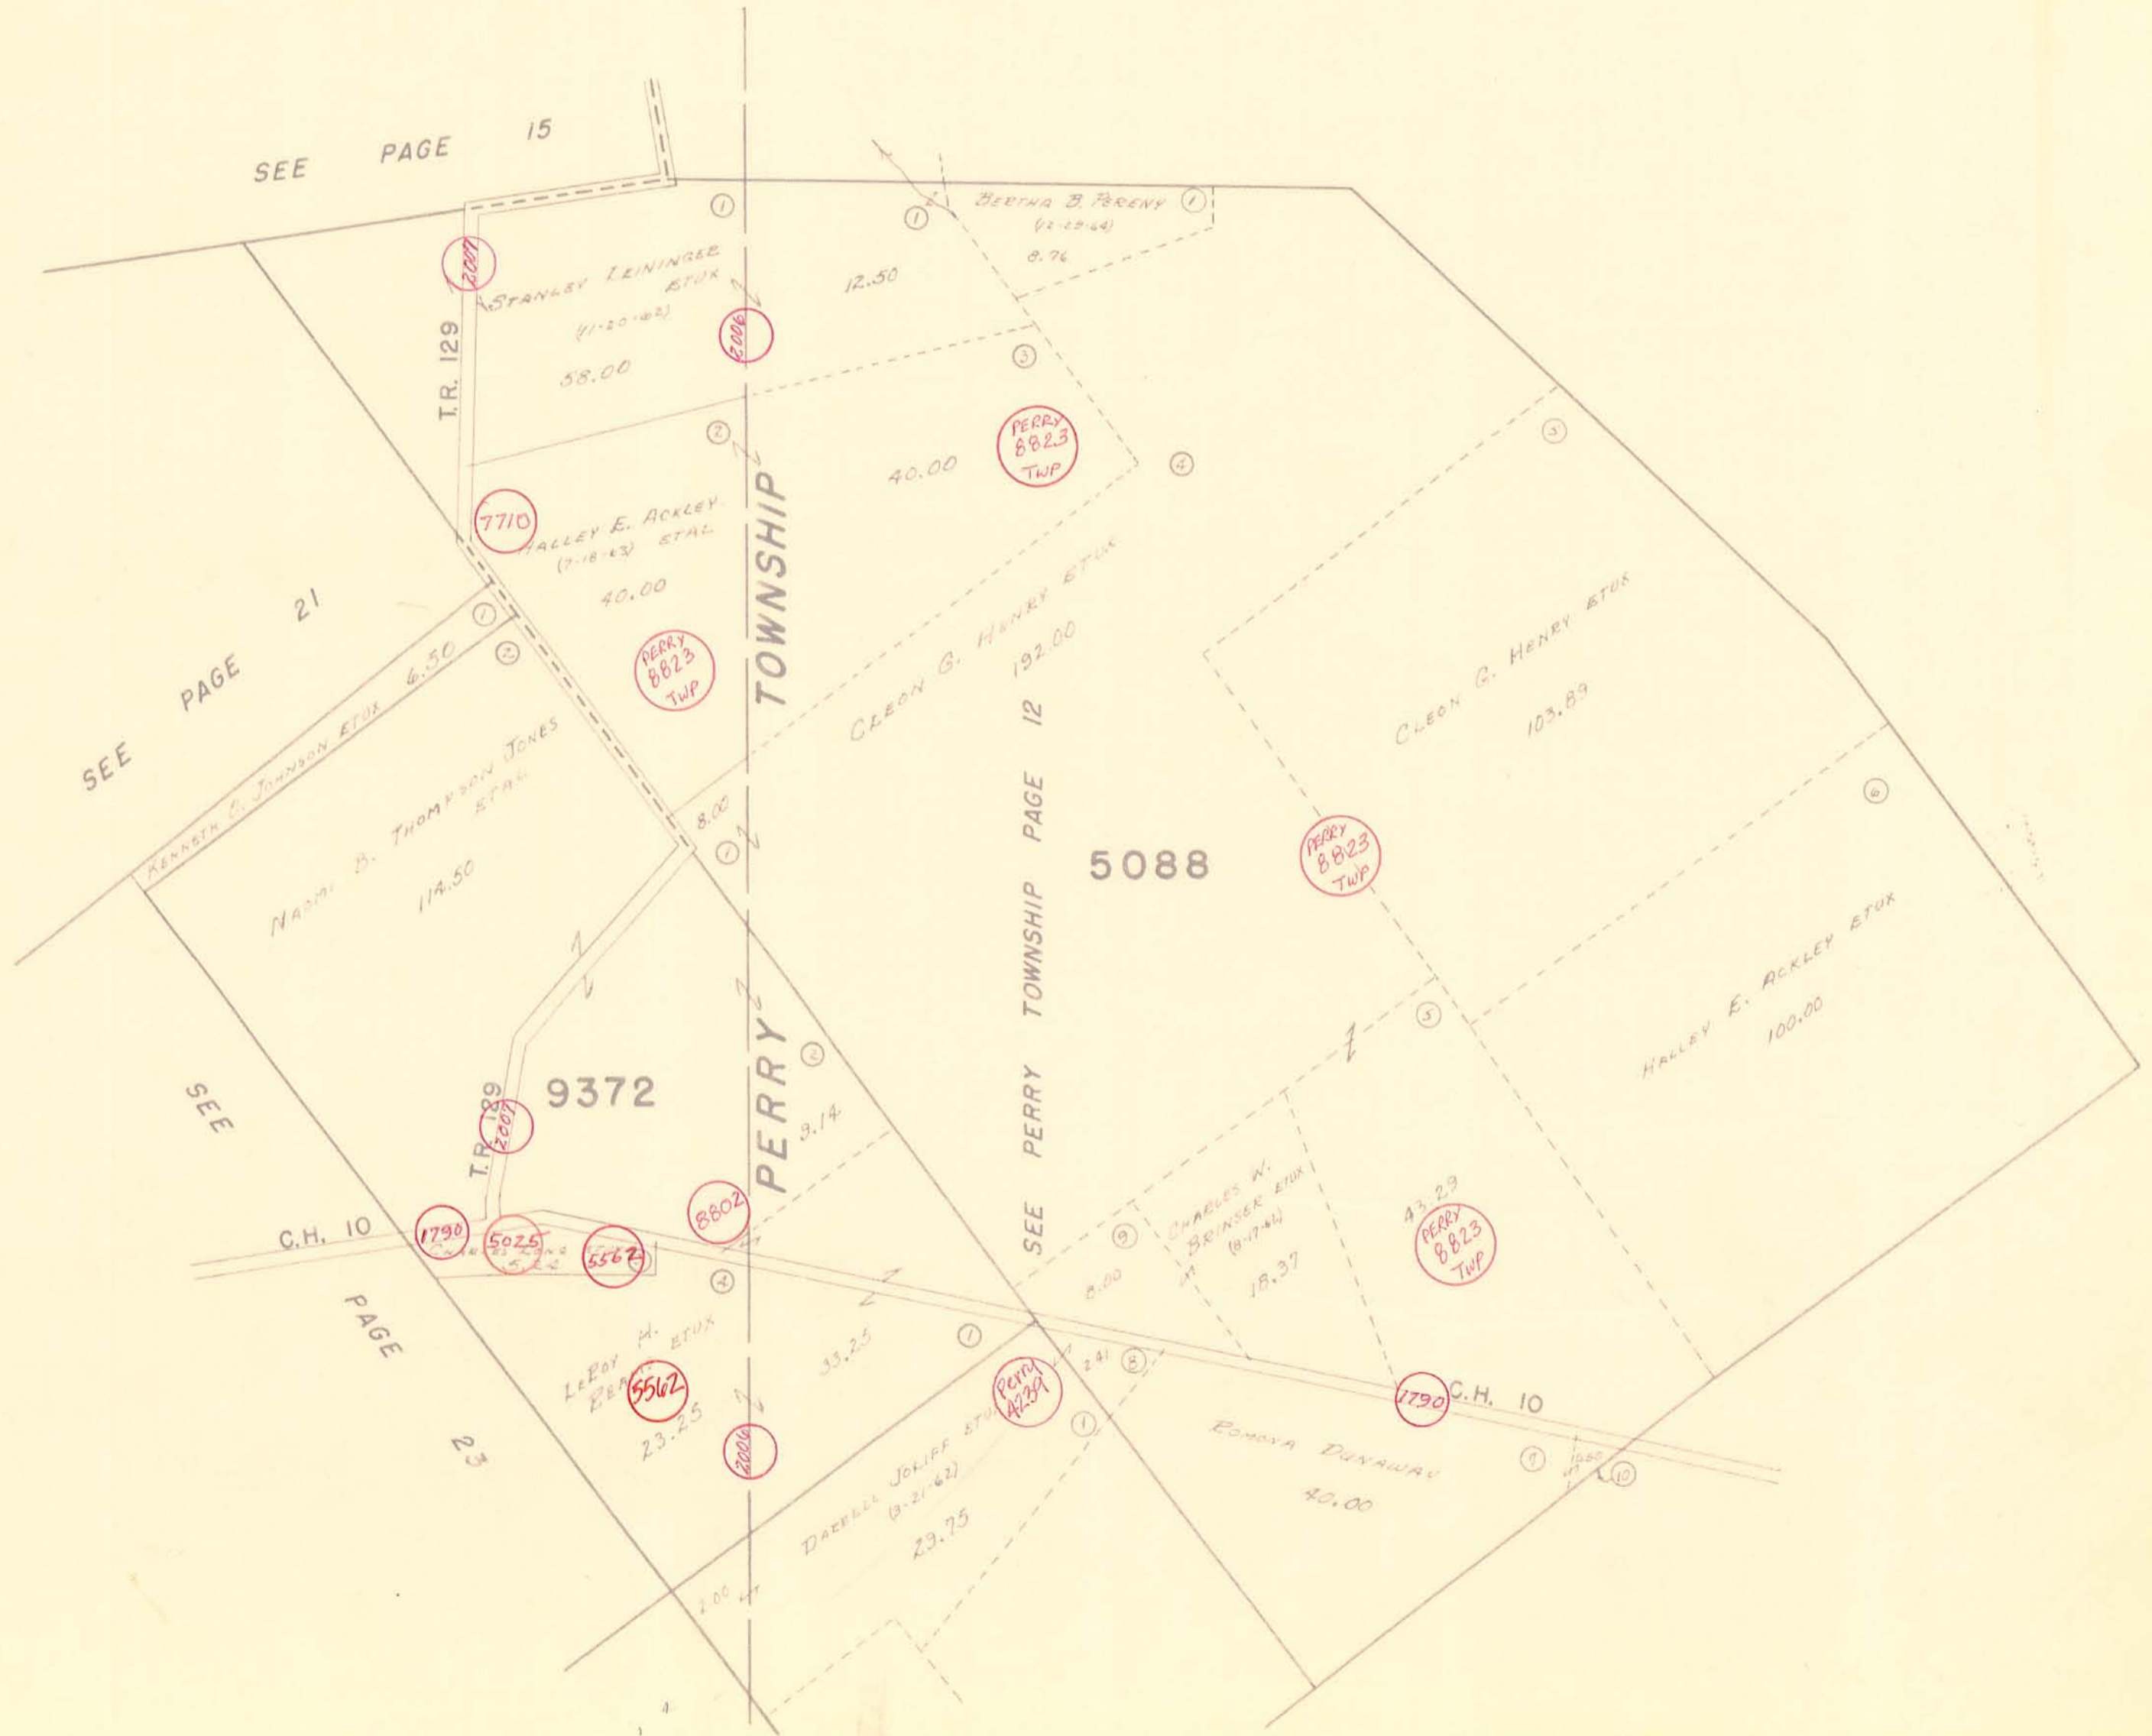

Drawn June 17, 1963
By D.E.G.
From Aerial Photo