



SECTION 27 TOWN 5 RANGE 13

SCALE 10 CHAINS TO THE INCH

See Page 10

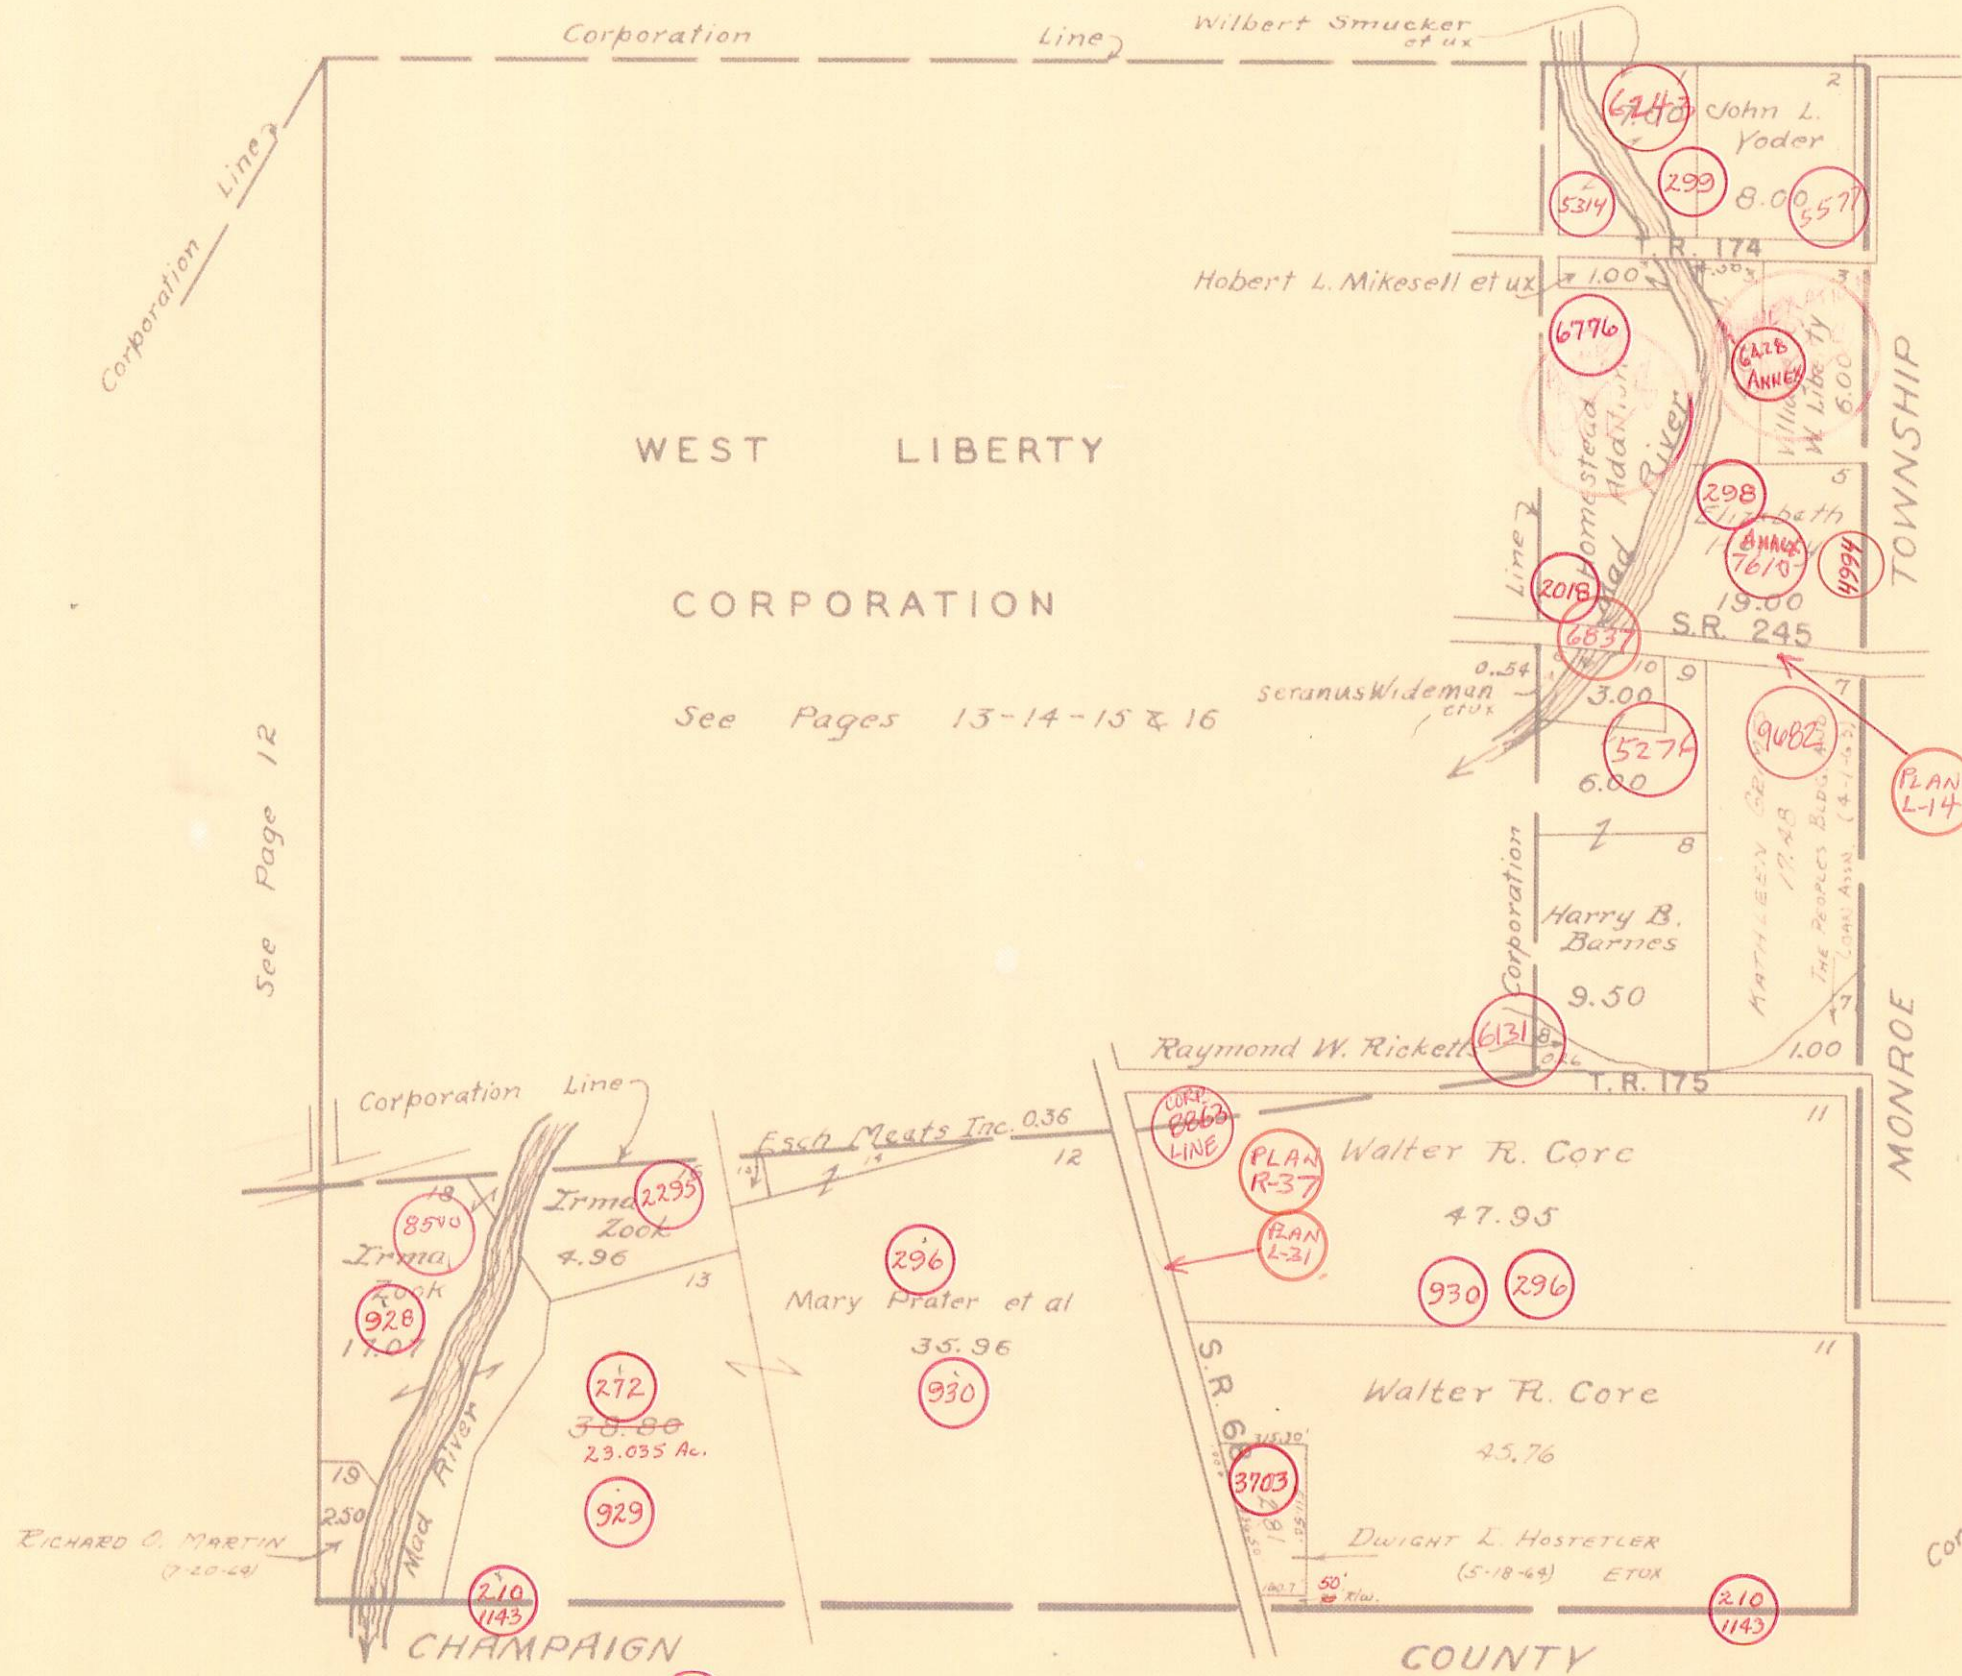

- 1700 CHAMPAIGN Co.
- 148 CHAMPAIGN Co.
- 1934 CHAMPAIGN Co.

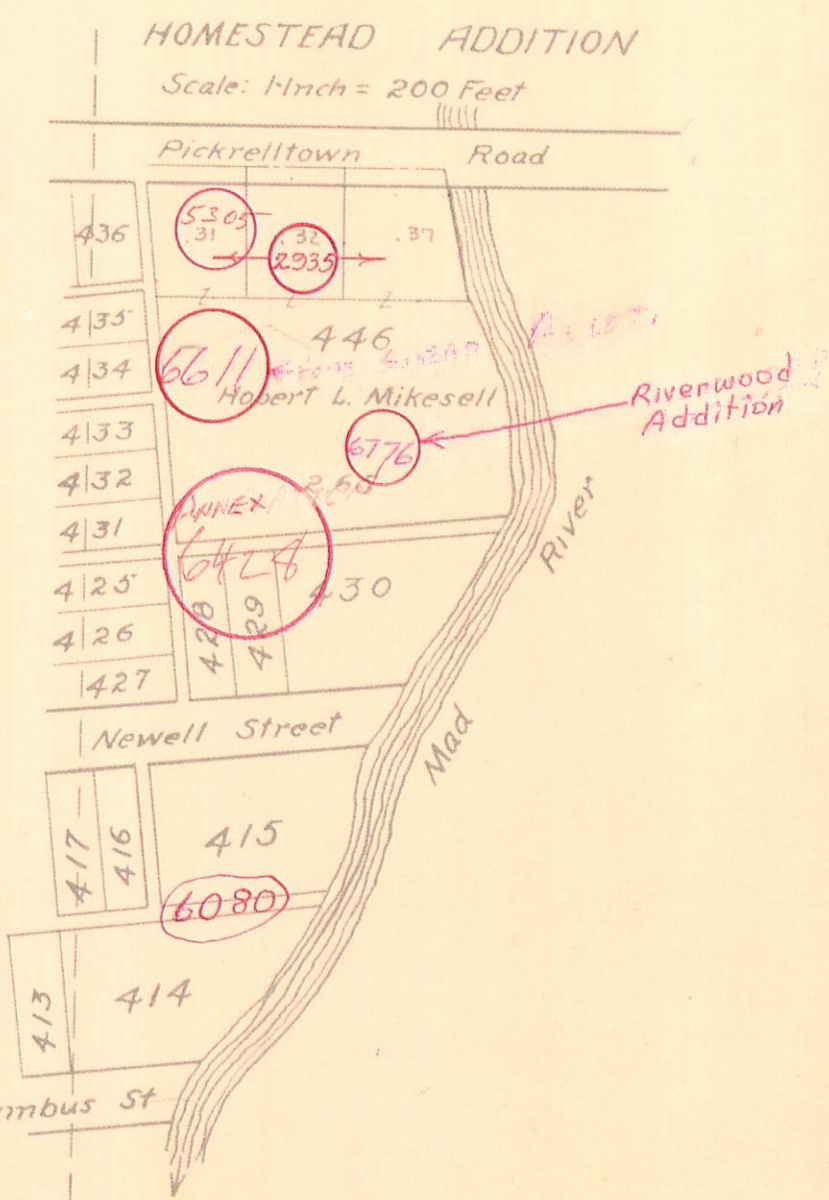

DW L. LOCKWOOD ETUX -0.80?