


VIRGINIA MILITARY SURVEY 9932

SCALE 10 CHAINS TO THE INCH

RIGHLAND TOWNSHIP Page 1

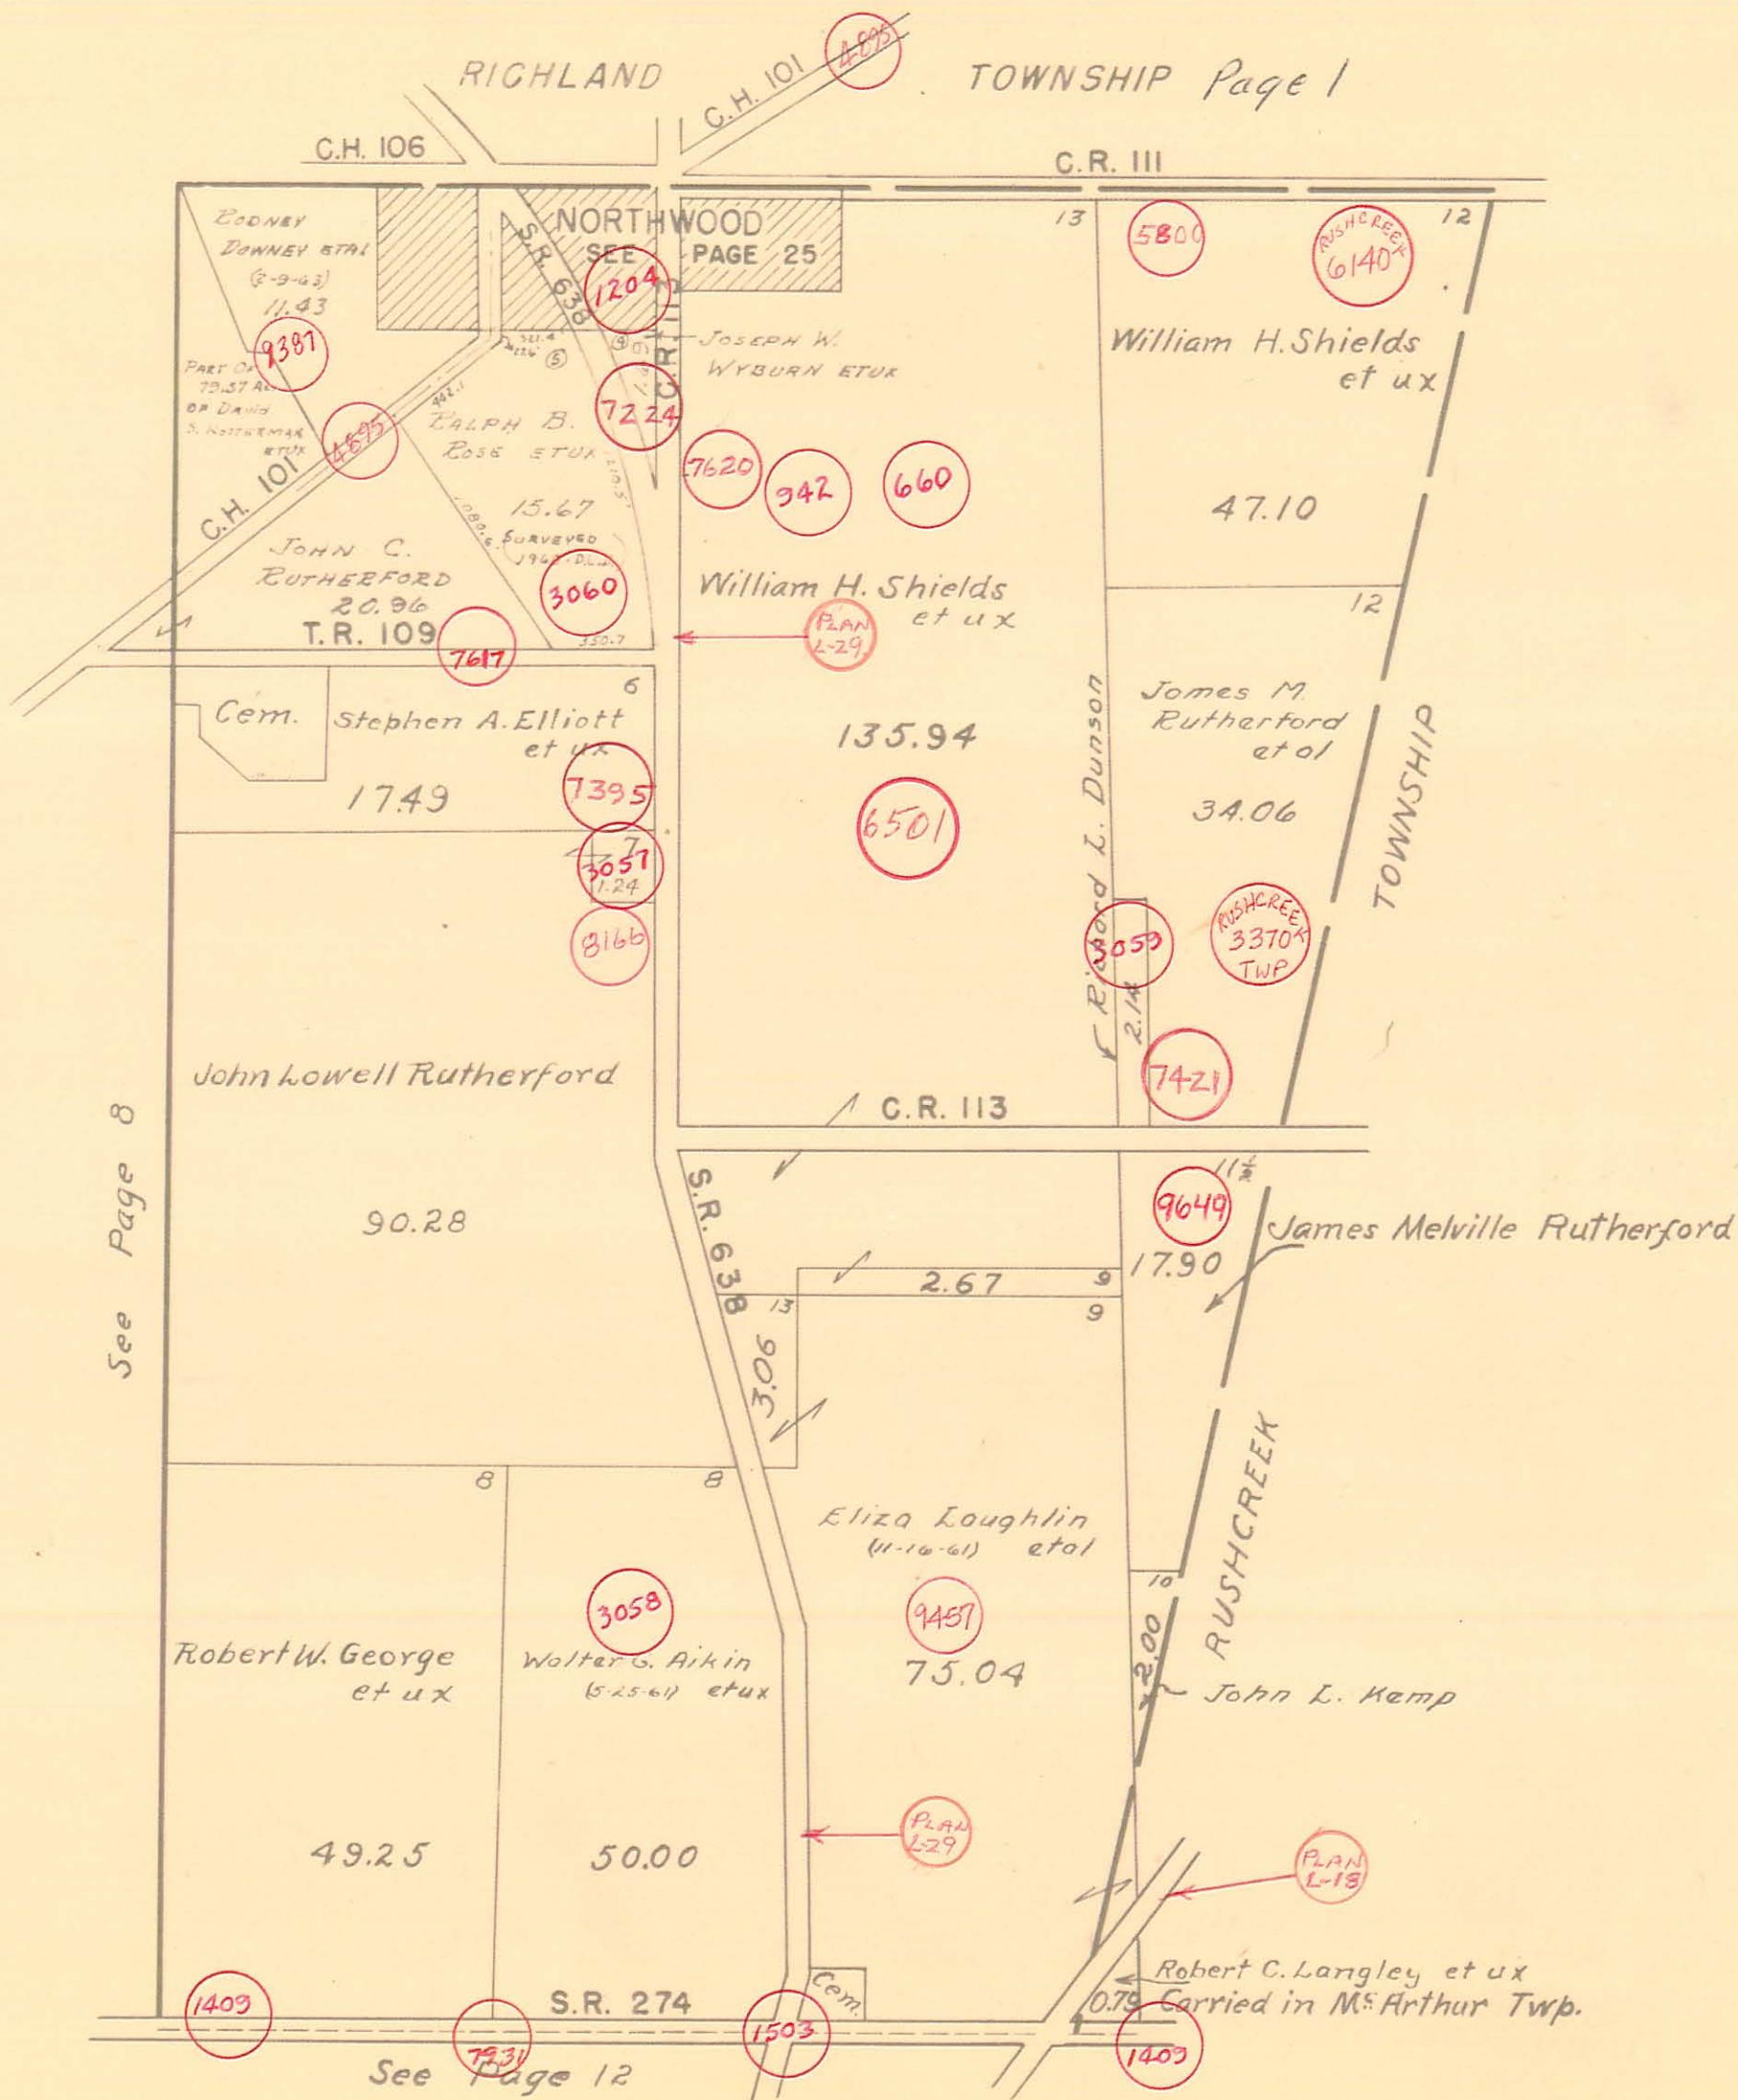

See Page 8

See Page 12