


McARTHUR TOWNSHIP
VIRGINIA MILITARY SURVEY 9907

SCALE 10 CHAINS TO THE INCH

Note: Cecil M. Connor 0.74 A.
To; State of Ohio; By Perpetual
Easement dated November-13-1941
Recorders book
171 Page 86

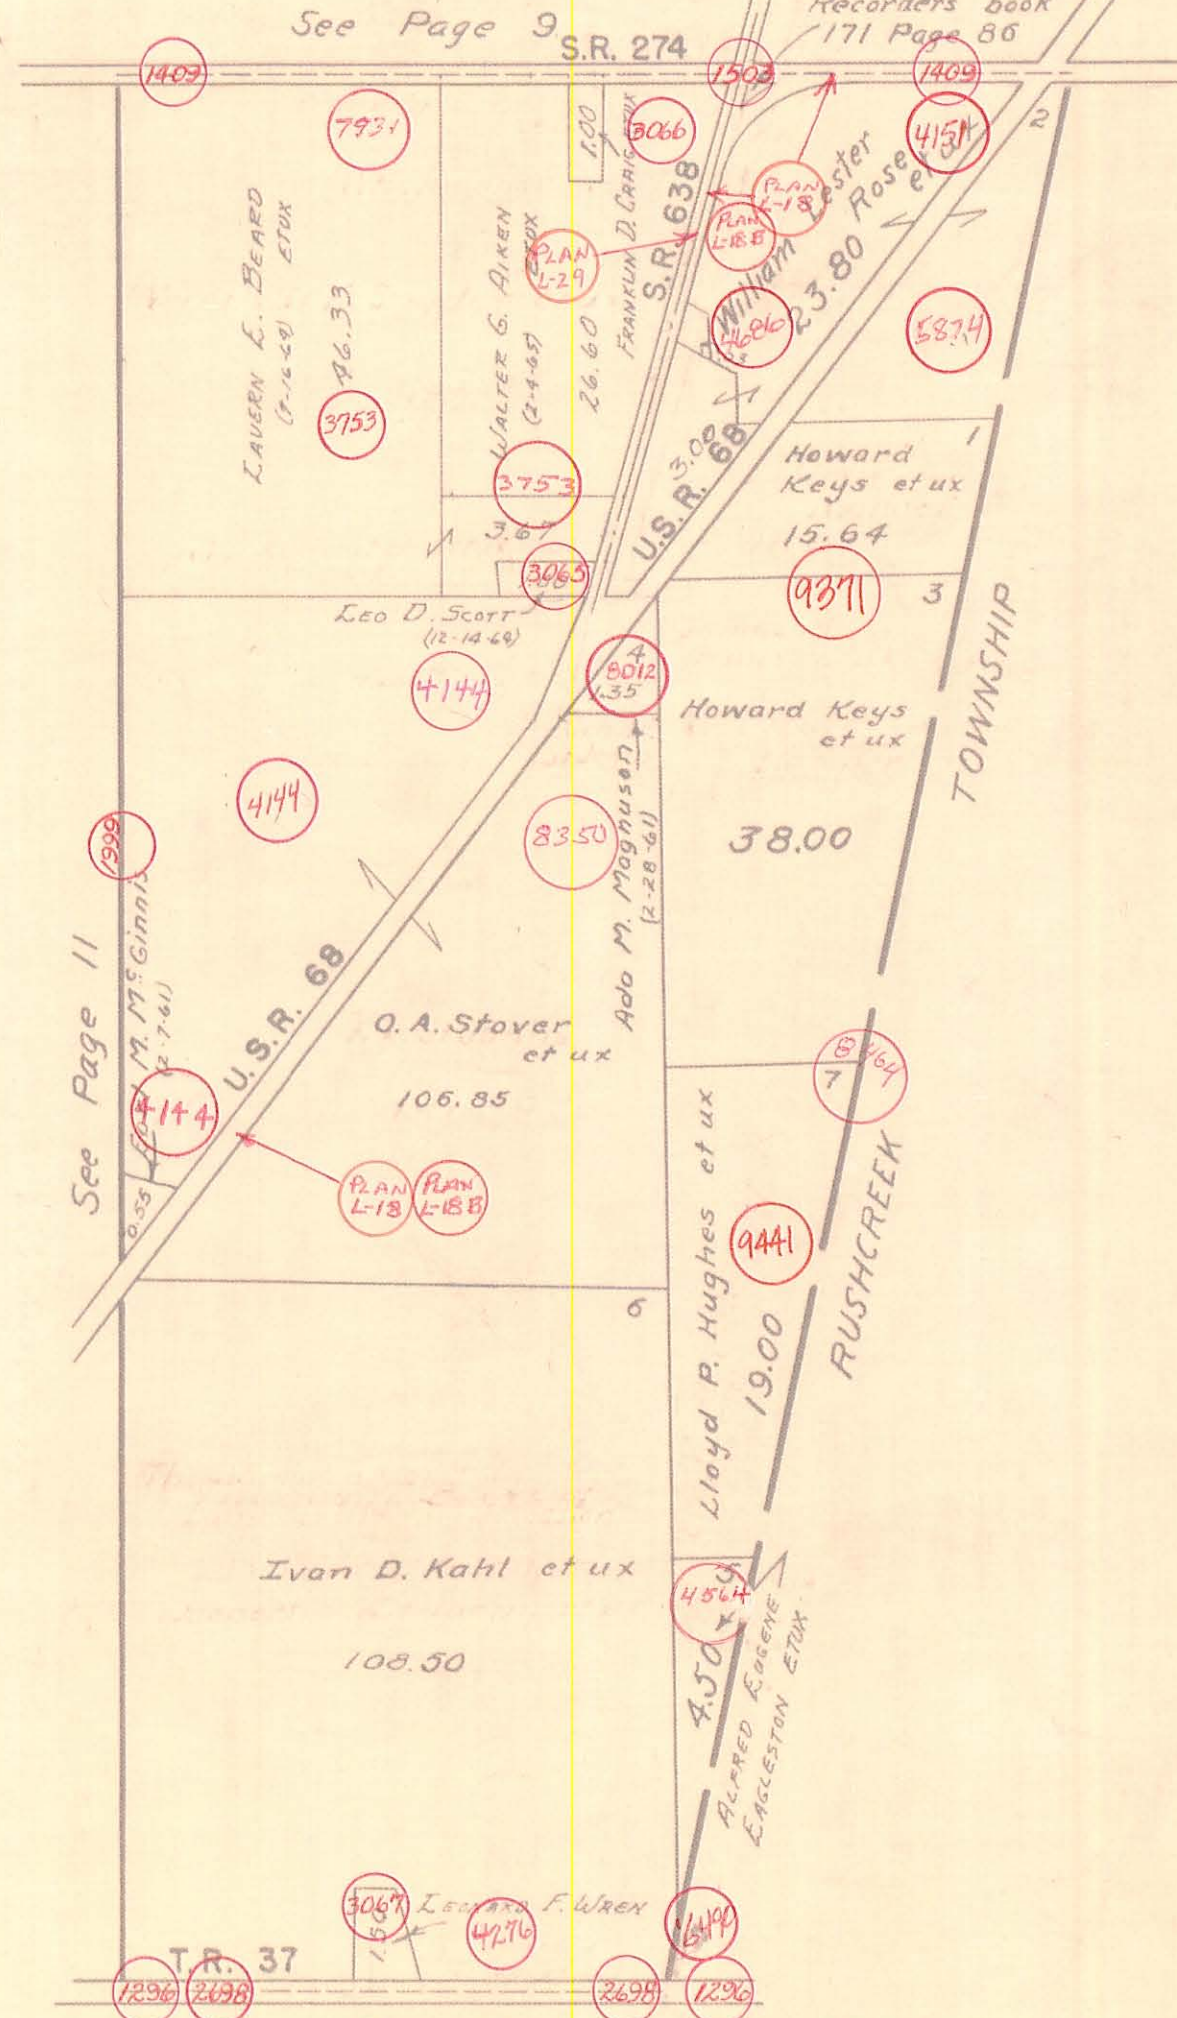

See Page 9

See Page 11

See Page 21