


MIAMI TOWNSHIP
SECTION 23 TOWN 3 RANGE 13
SECTION 24 TOWN 3 RANGE 13

SCALE 10 CHAINS TO THE INCH

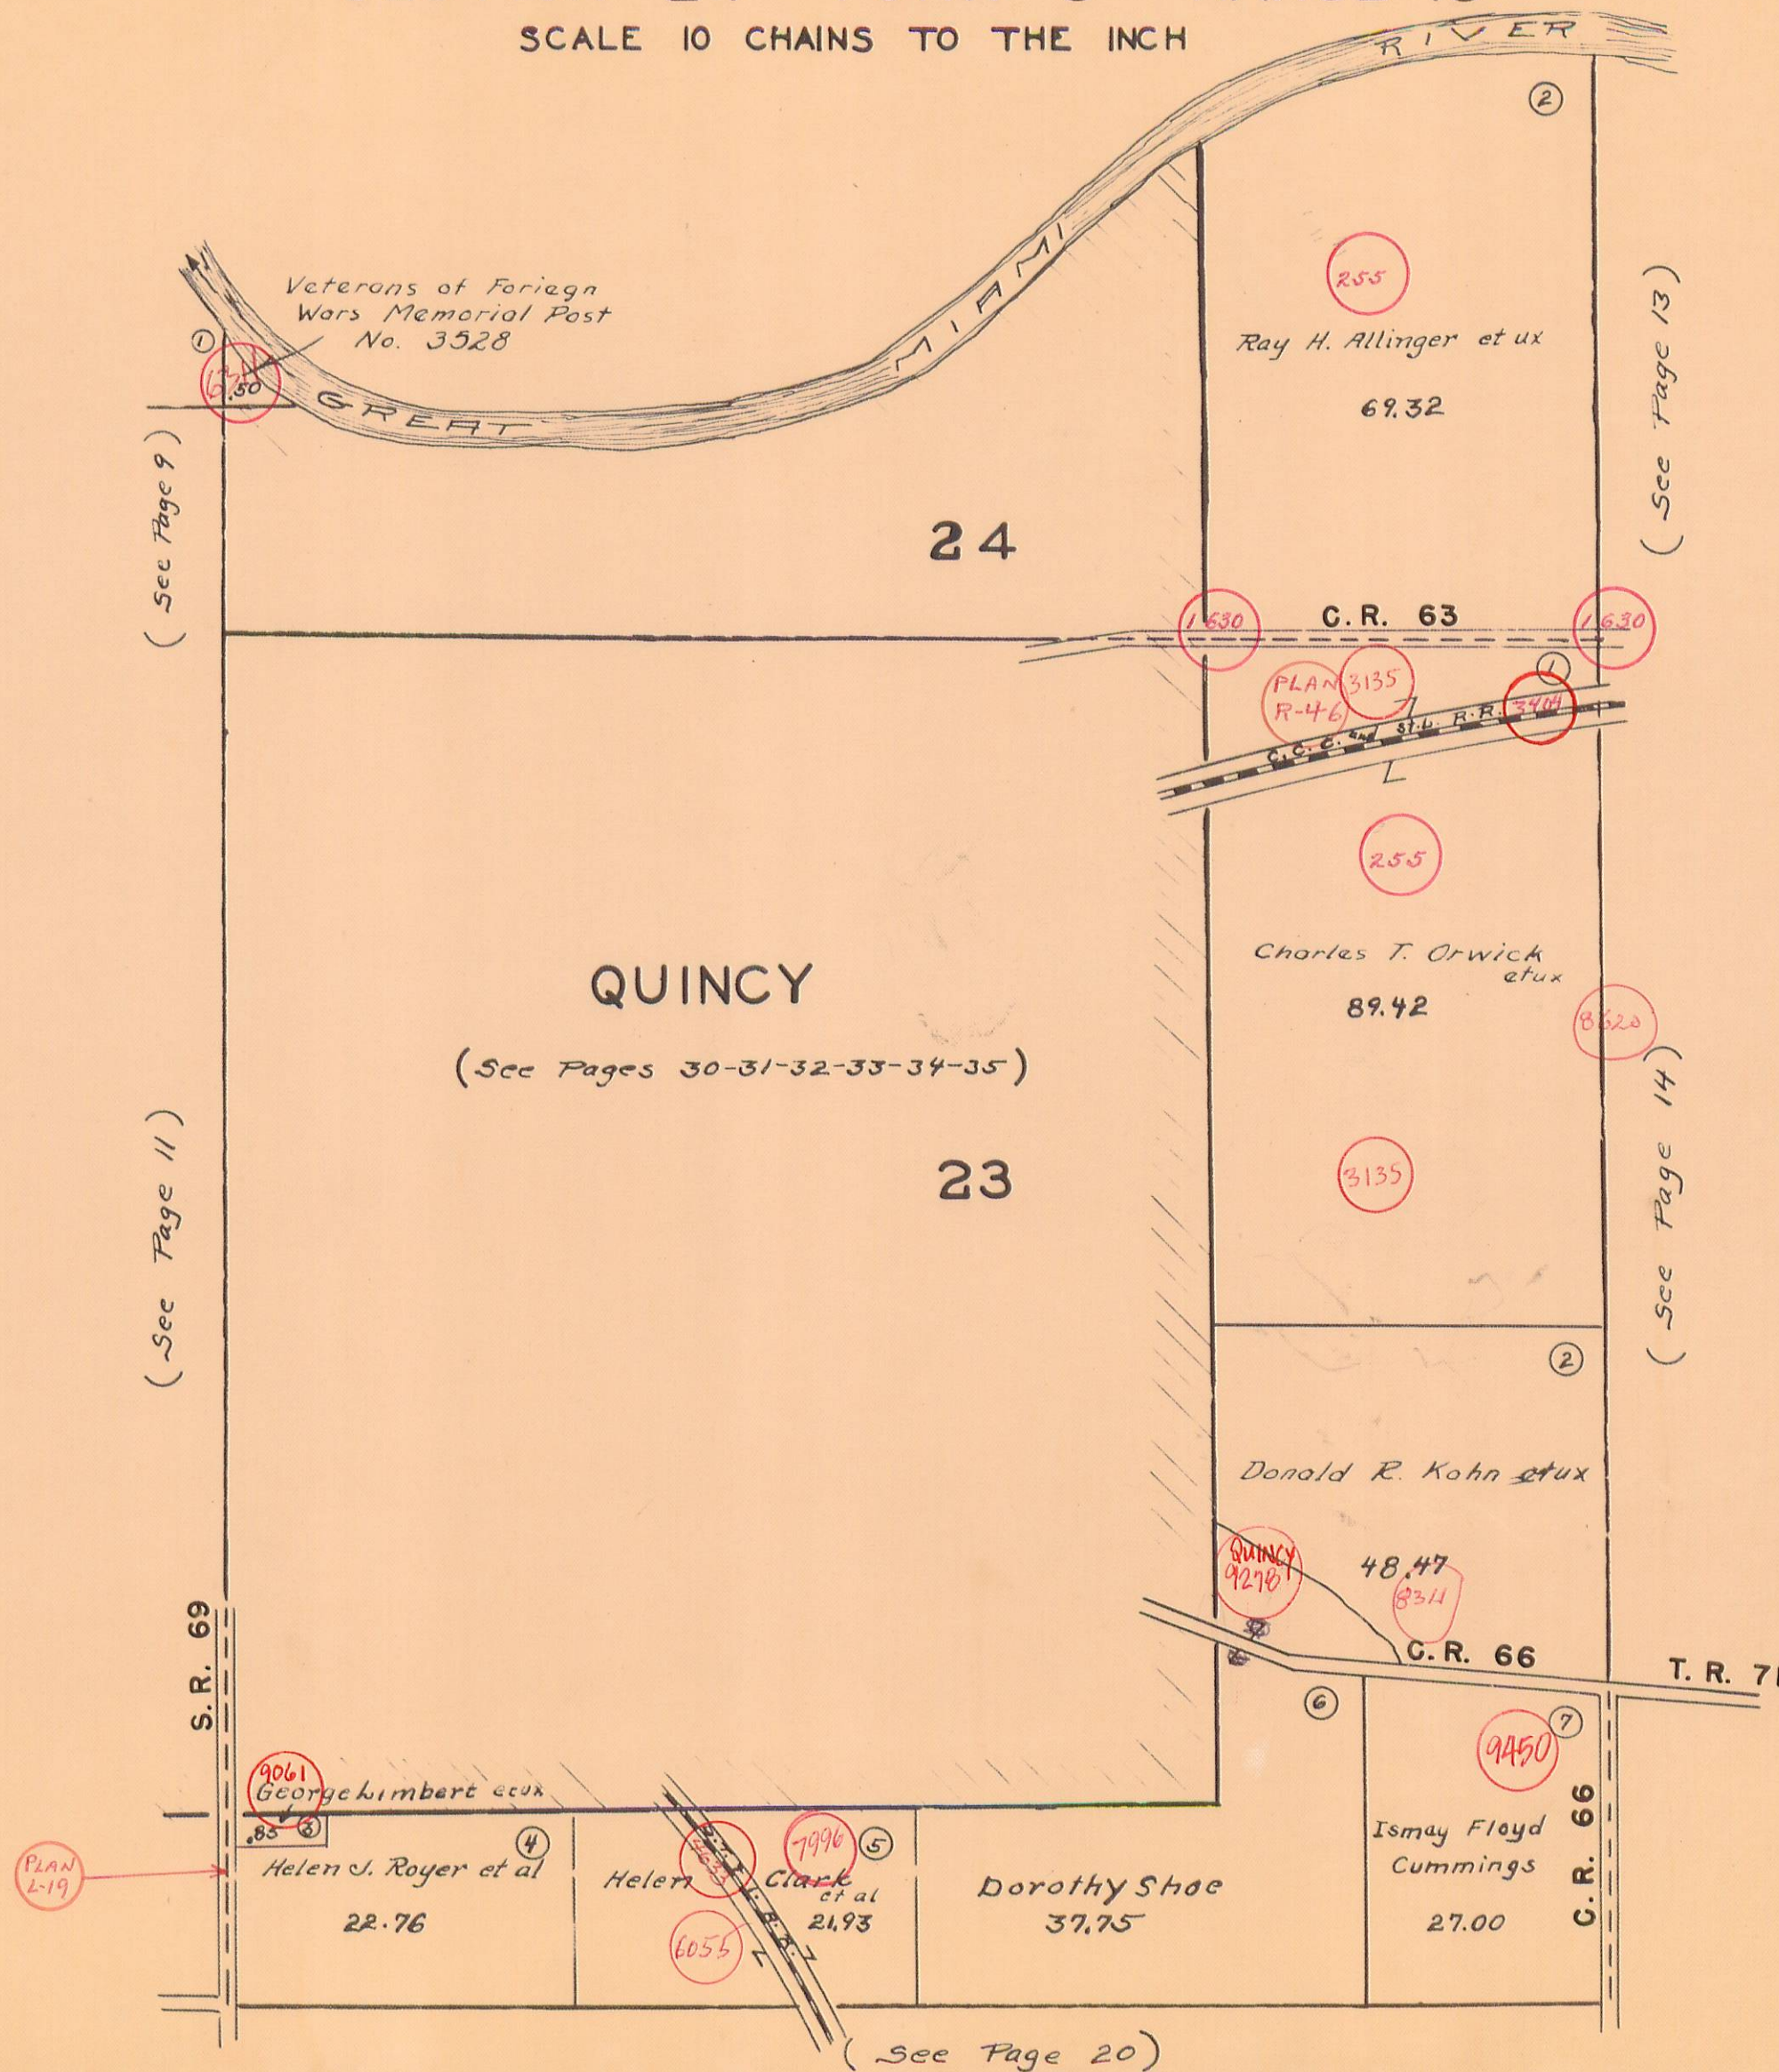

F.F.W.
1932
C.H.V.
1942