
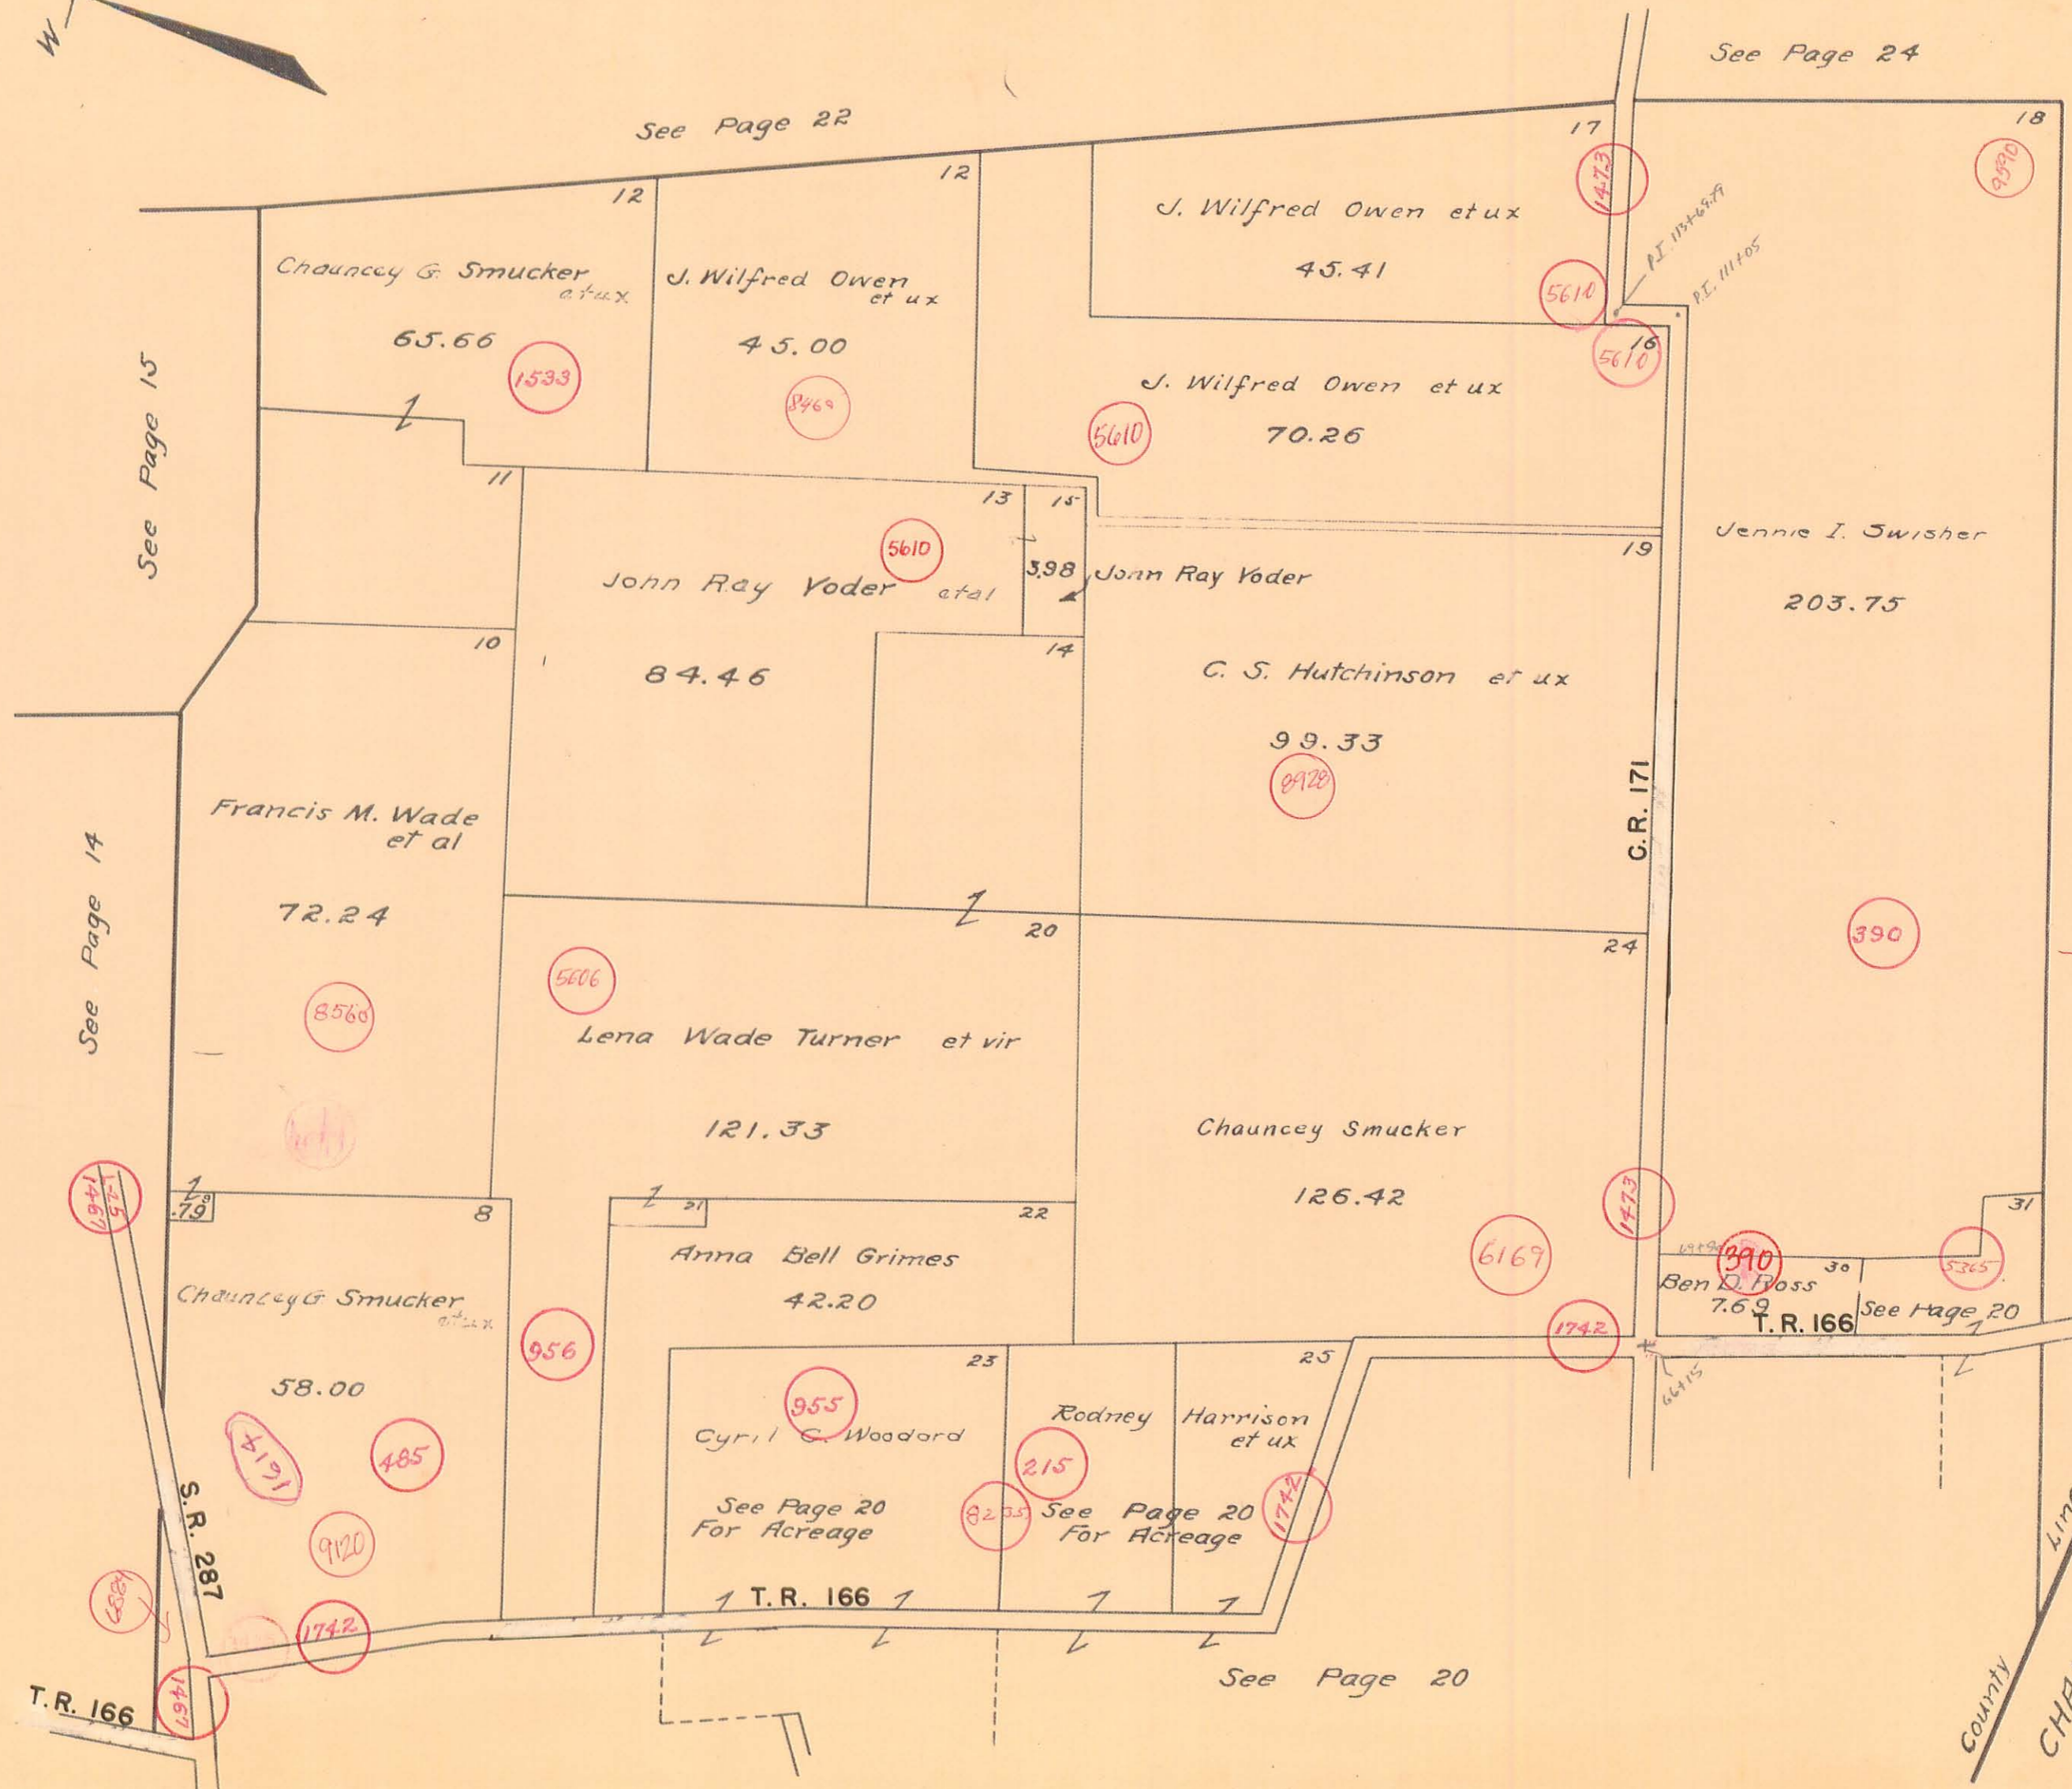


MONROE TOWNSHIP  
VIRGINIA MILITARY SURVEY E. PART 4492

SCALE 10 CHAINS TO THE INCH

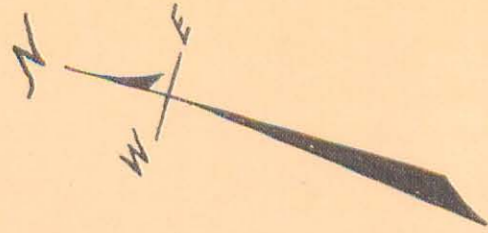

County Line  
CHAMPAIGN COUNTY