


PLEASANT TOWNSHIP

SECTION 16 TOWN 2 RANGE 14  
SECTION 10 TOWN 2 RANGE 14

SCALE 10 CHAINS TO THE INCH

WASHINGTON TOWNSHIP

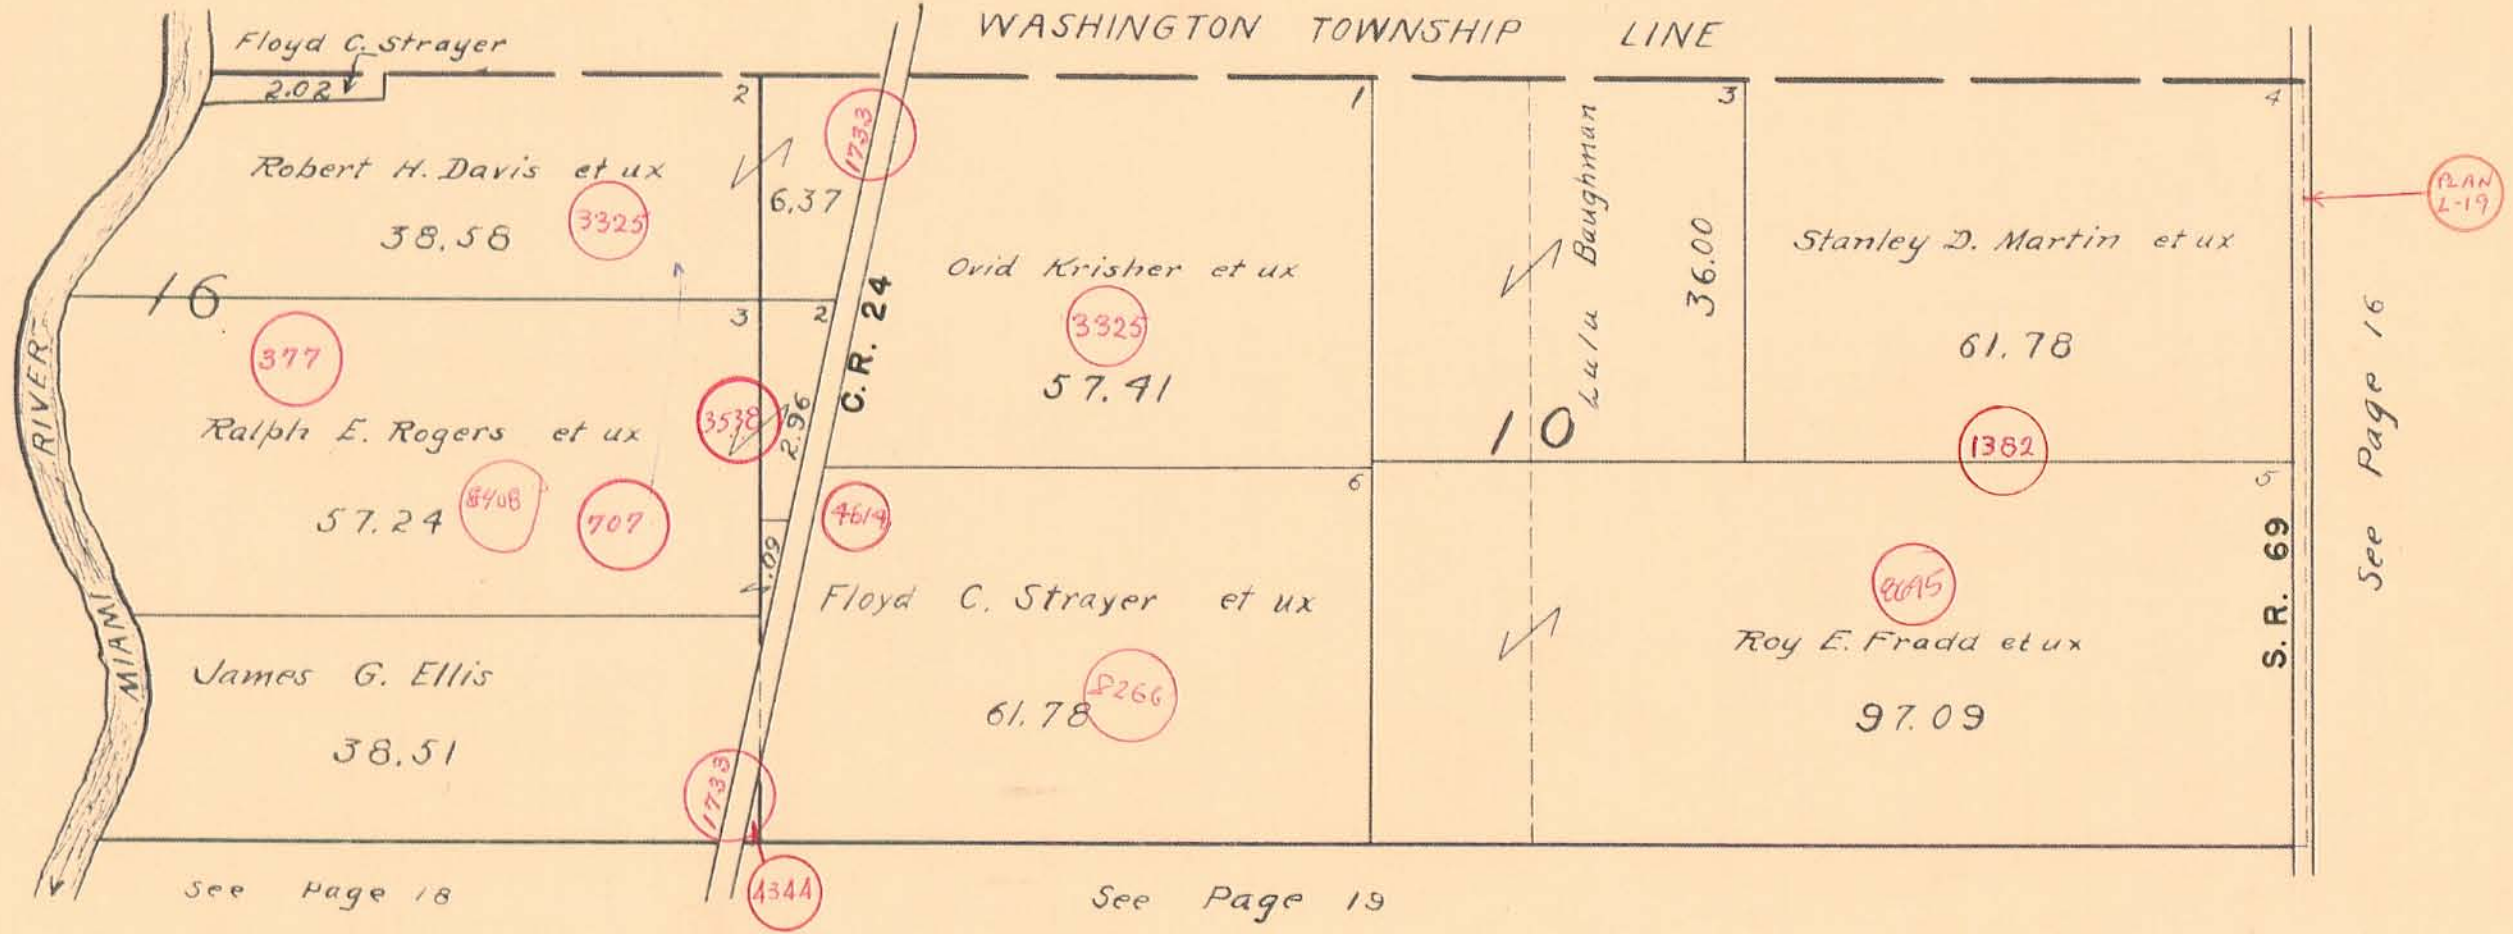

See Page 18

See Page 19

See Page 16