
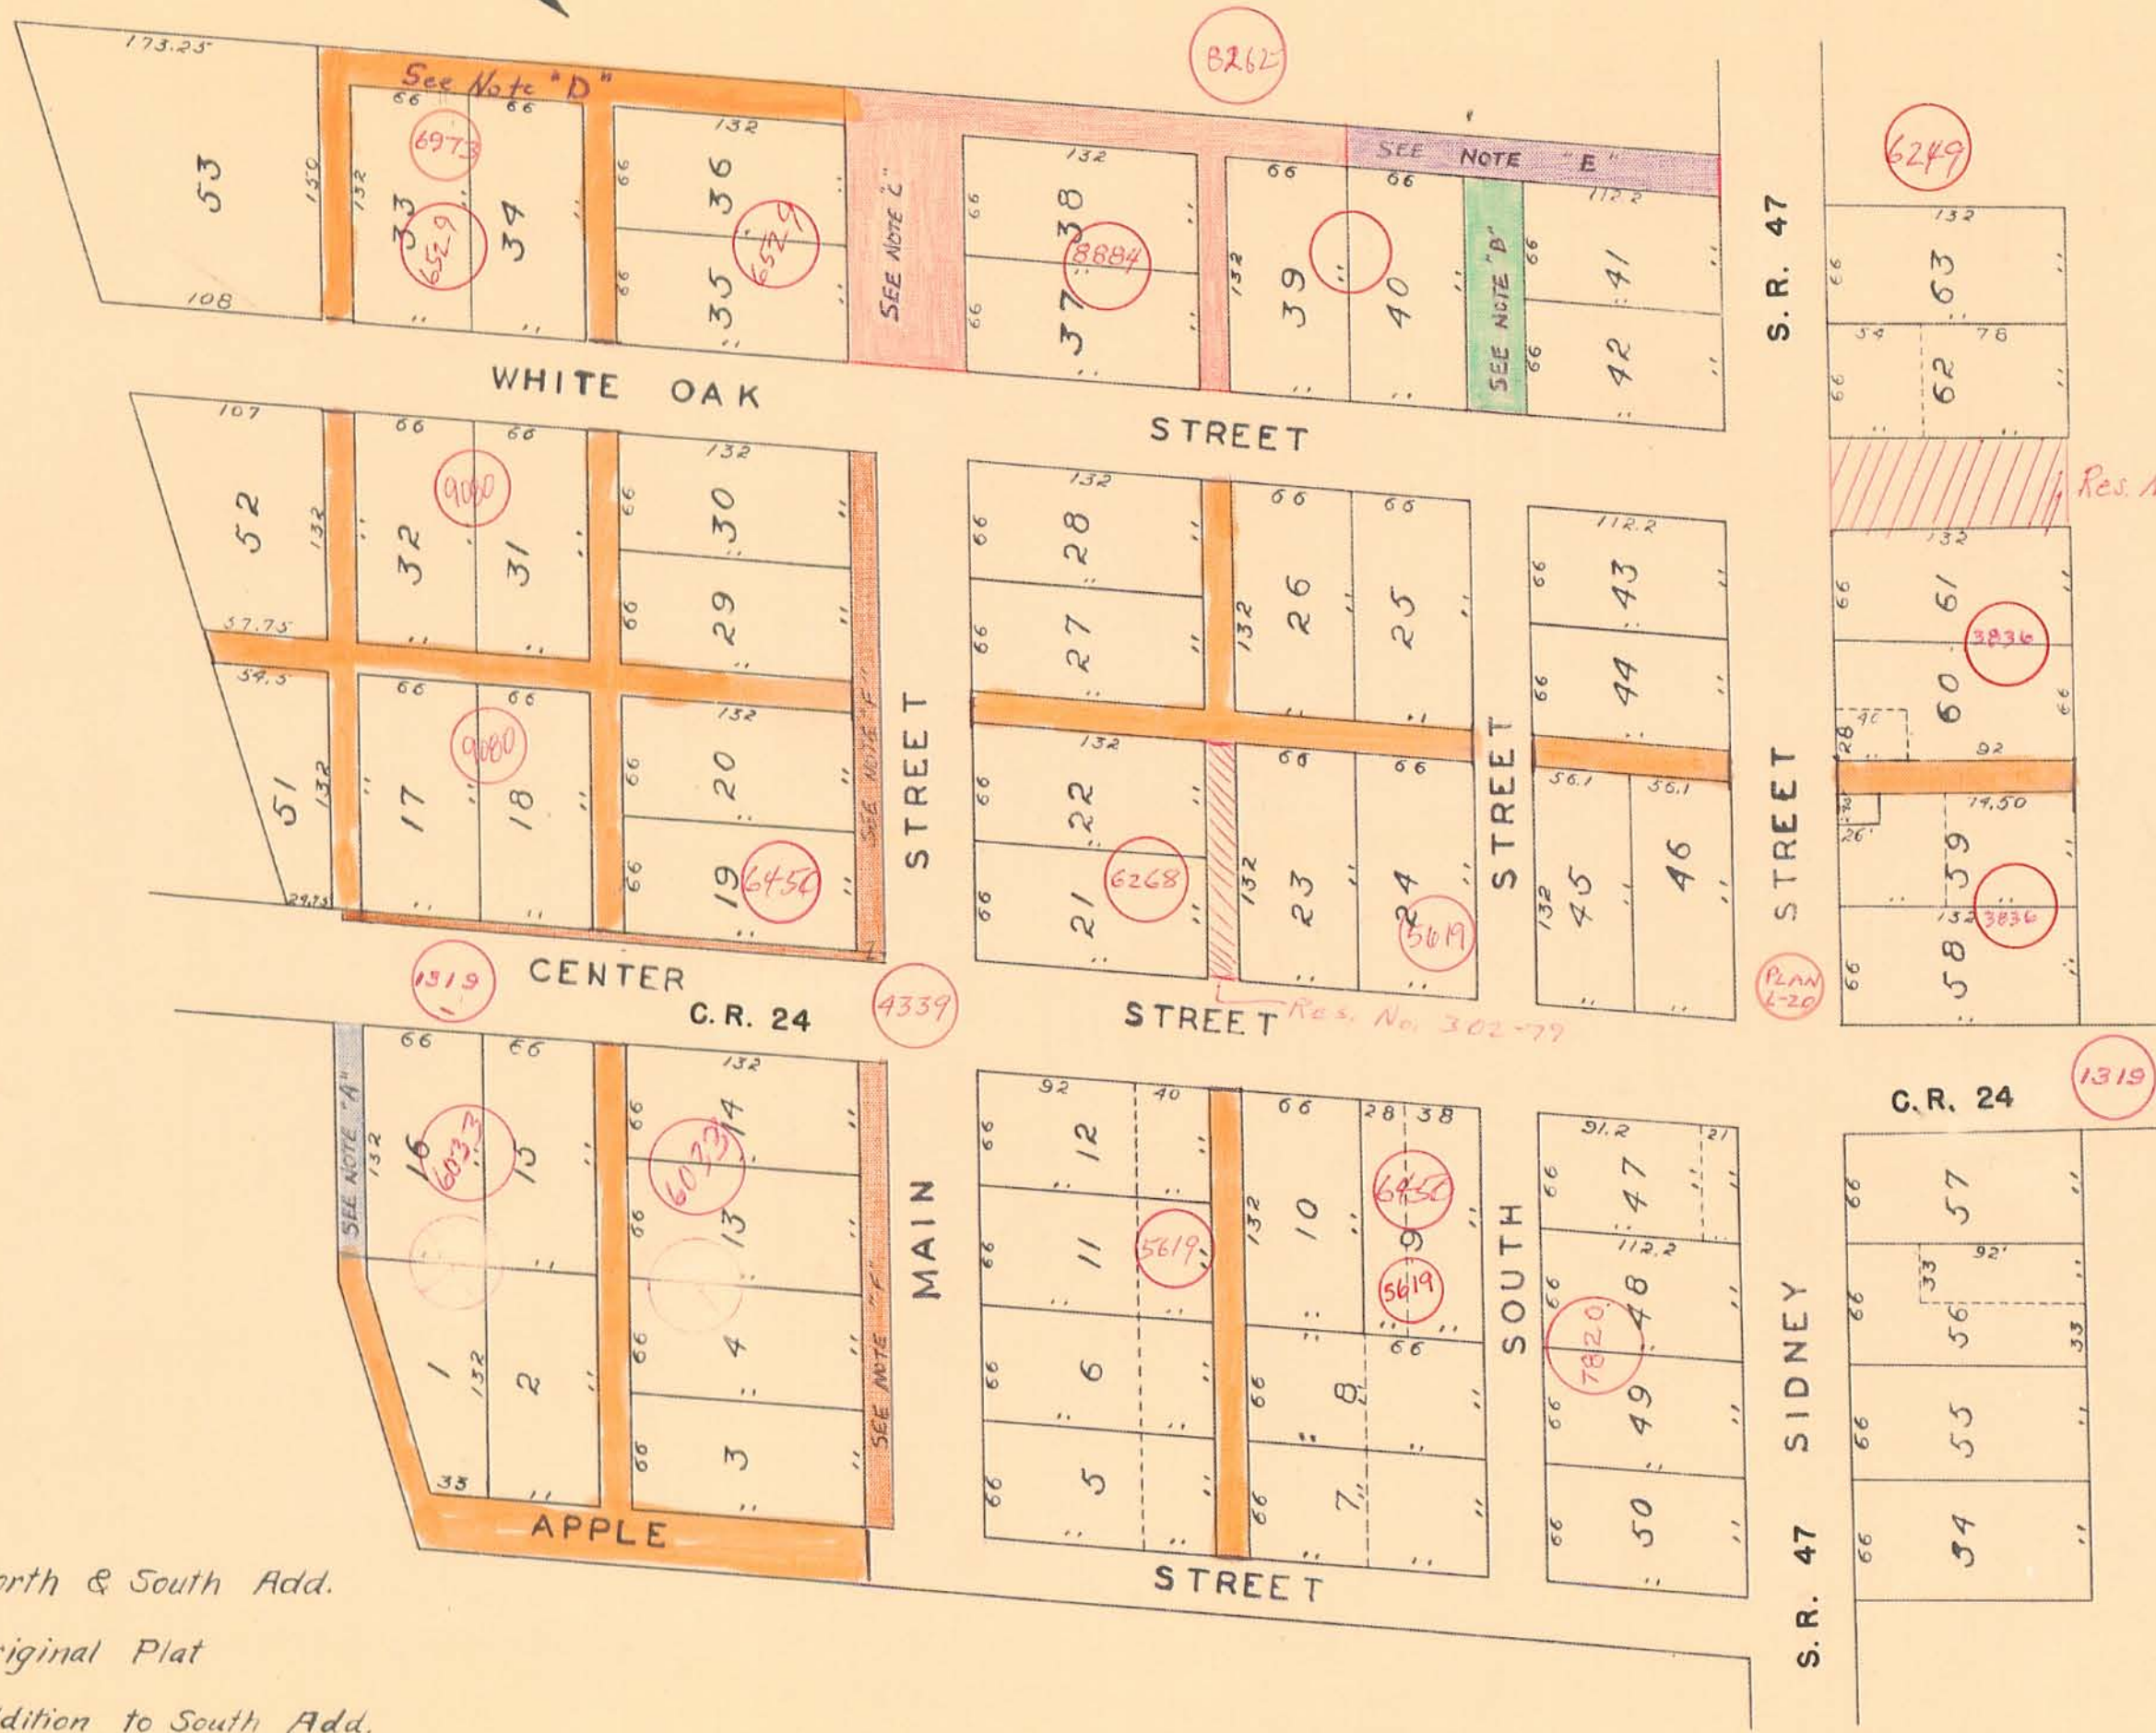


PLEASANT TOWNSHIP LOGANSVILLE

SCALE 100 FEET TO THE INCH

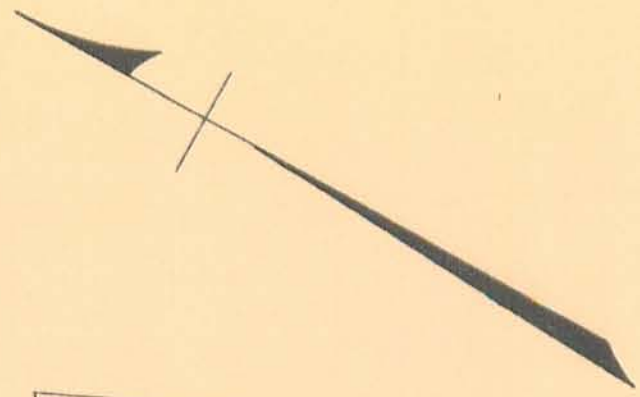

- 41 to 53 North & South Add.
- 1 to 40 Original Plat
- 54 to 63 Addition to South Add.