


RICHLAND TOWNSHIP
VIRGINIA MILITARY SURVEY 13393 PART
INDIAN LAKE SHORES ALLOTMENTS AND VICINITY

SCALE: 1" = 100'
 SEE PAGE 32A

3957
 STREET
 5631
 DEMONSTRATION

ALLOTMENT NO. 1
 LOTS 91 TO 180 INCL.
 (SEE J-137)

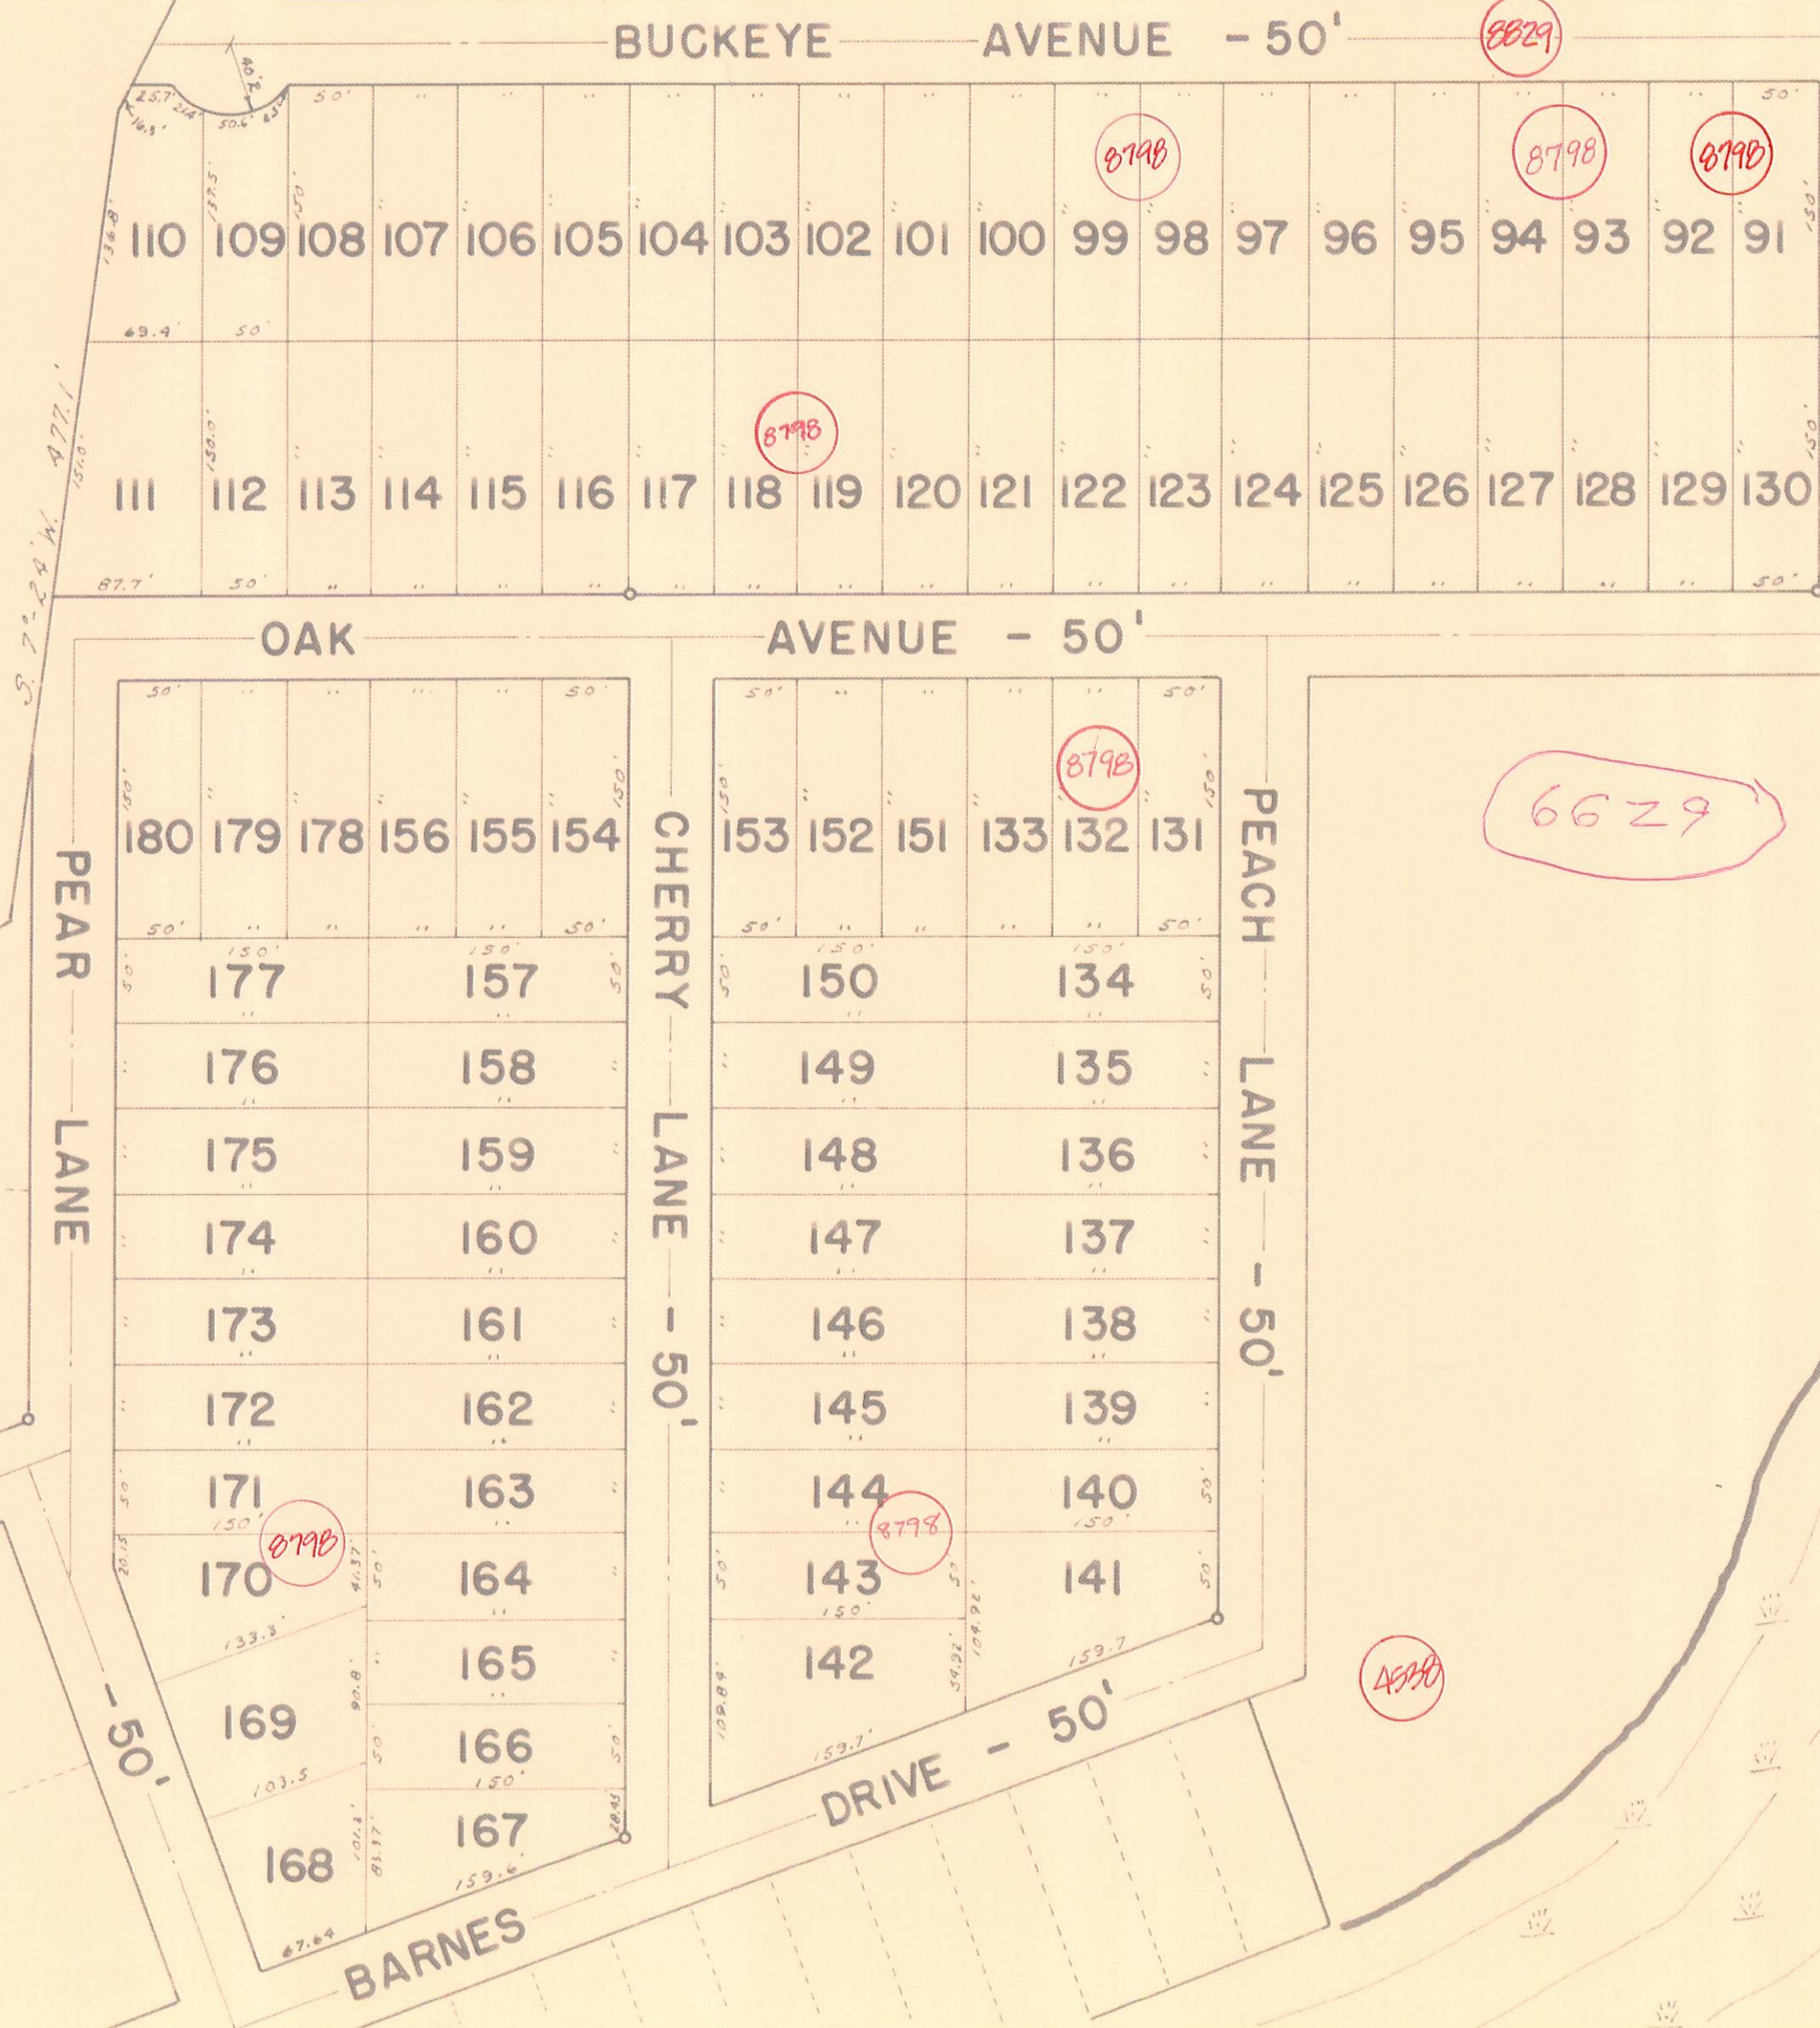

SEE PAGE 32 F

SEE PAGE 32 C