

RICHLAND TOWNSHIP
VIRGINIA MILITARY SURVEY 13393 PART
INDIAN LAKE SHORES ALLOTMENTS AND VICINITY

SEE PAGE 32 E.

SCALE: 1" = 100'


OAK AVENUE - 50'

ALLOTMENT NO. 1
LOT 181 TO 193 INCL.
(SEE J-137)

PEACH LANE - 50'

DRIVE - 50'

BARNES

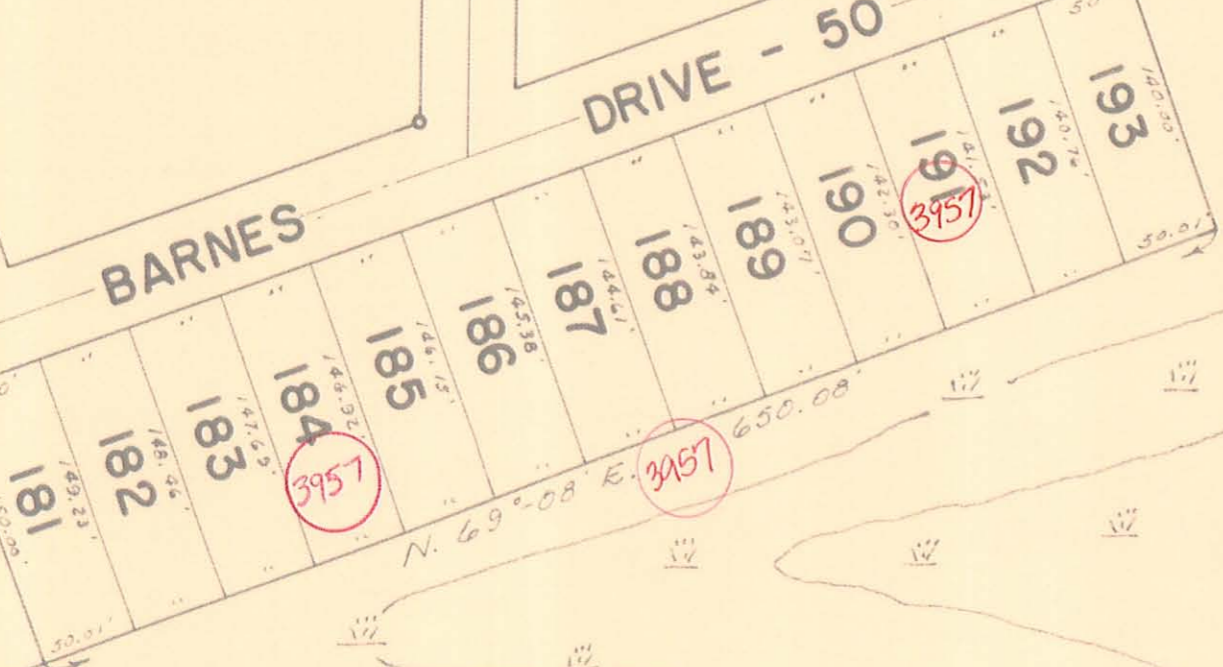

SWAMPY WATER

CHANNEL

6629

4638

3957

3957

3957

3957

SECRET
5631
DECLASSIFIED

SEE PAGE 32 C

SEE PAGE 32 B

SEE PAGE 32 F