


STOKES TOWNSHIP
VIRGINIA MILITARY SURVEY 12276
LAKERIDGE SUBDIVISION

SCALE: 1 INCH = 200 FEET

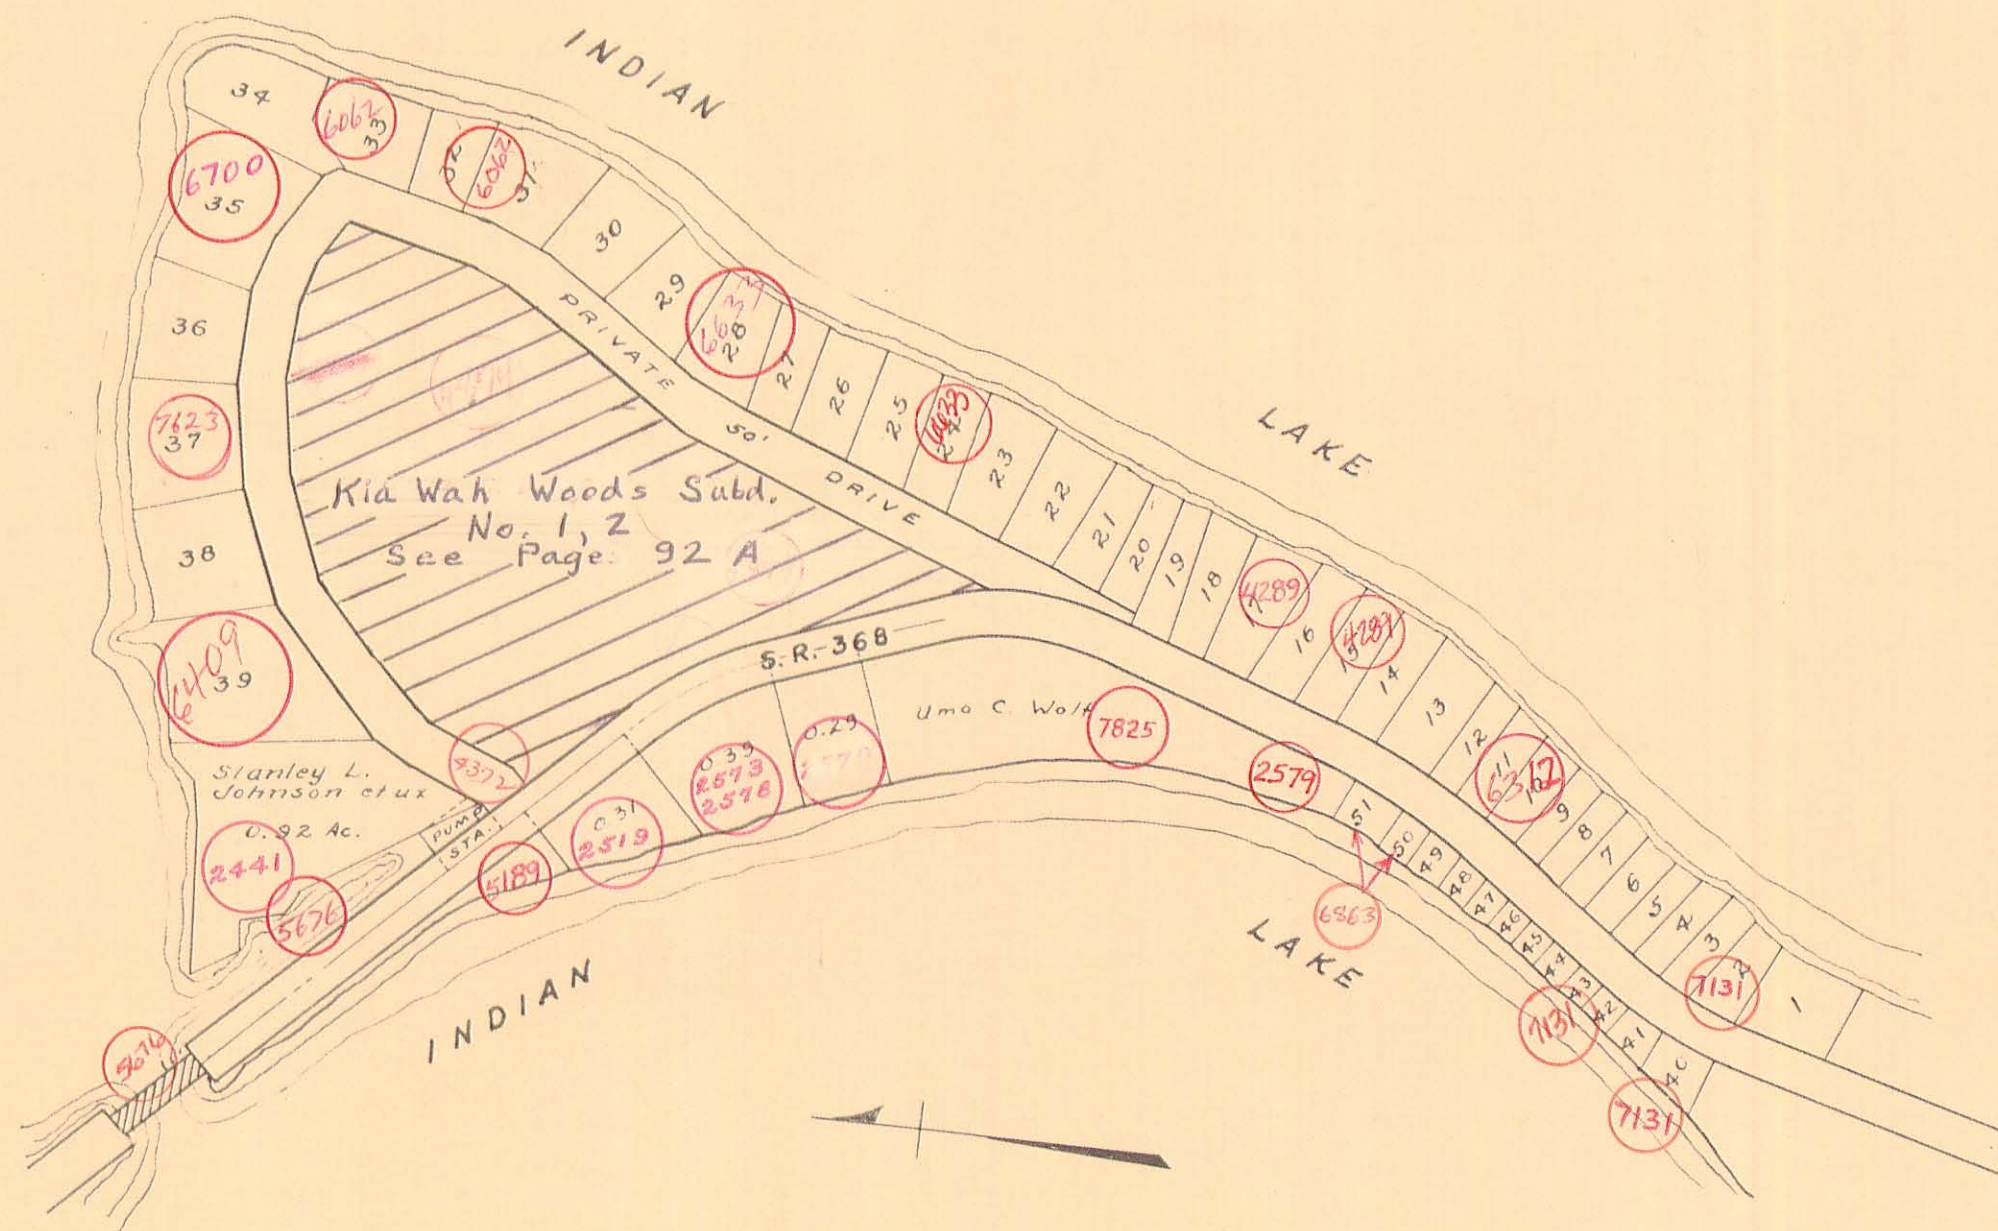

Lots 40 To 51 not to scale