

ZANE TOWNSHIP
VIRGINIA MILITARY SURVEYS

3163
3681
4880

SCALE 10 CHAINS TO THE INCH


(See Page 9)

① Bernard G. Boston et ux

C.R. 44

(See Page 17)

C.R. 153

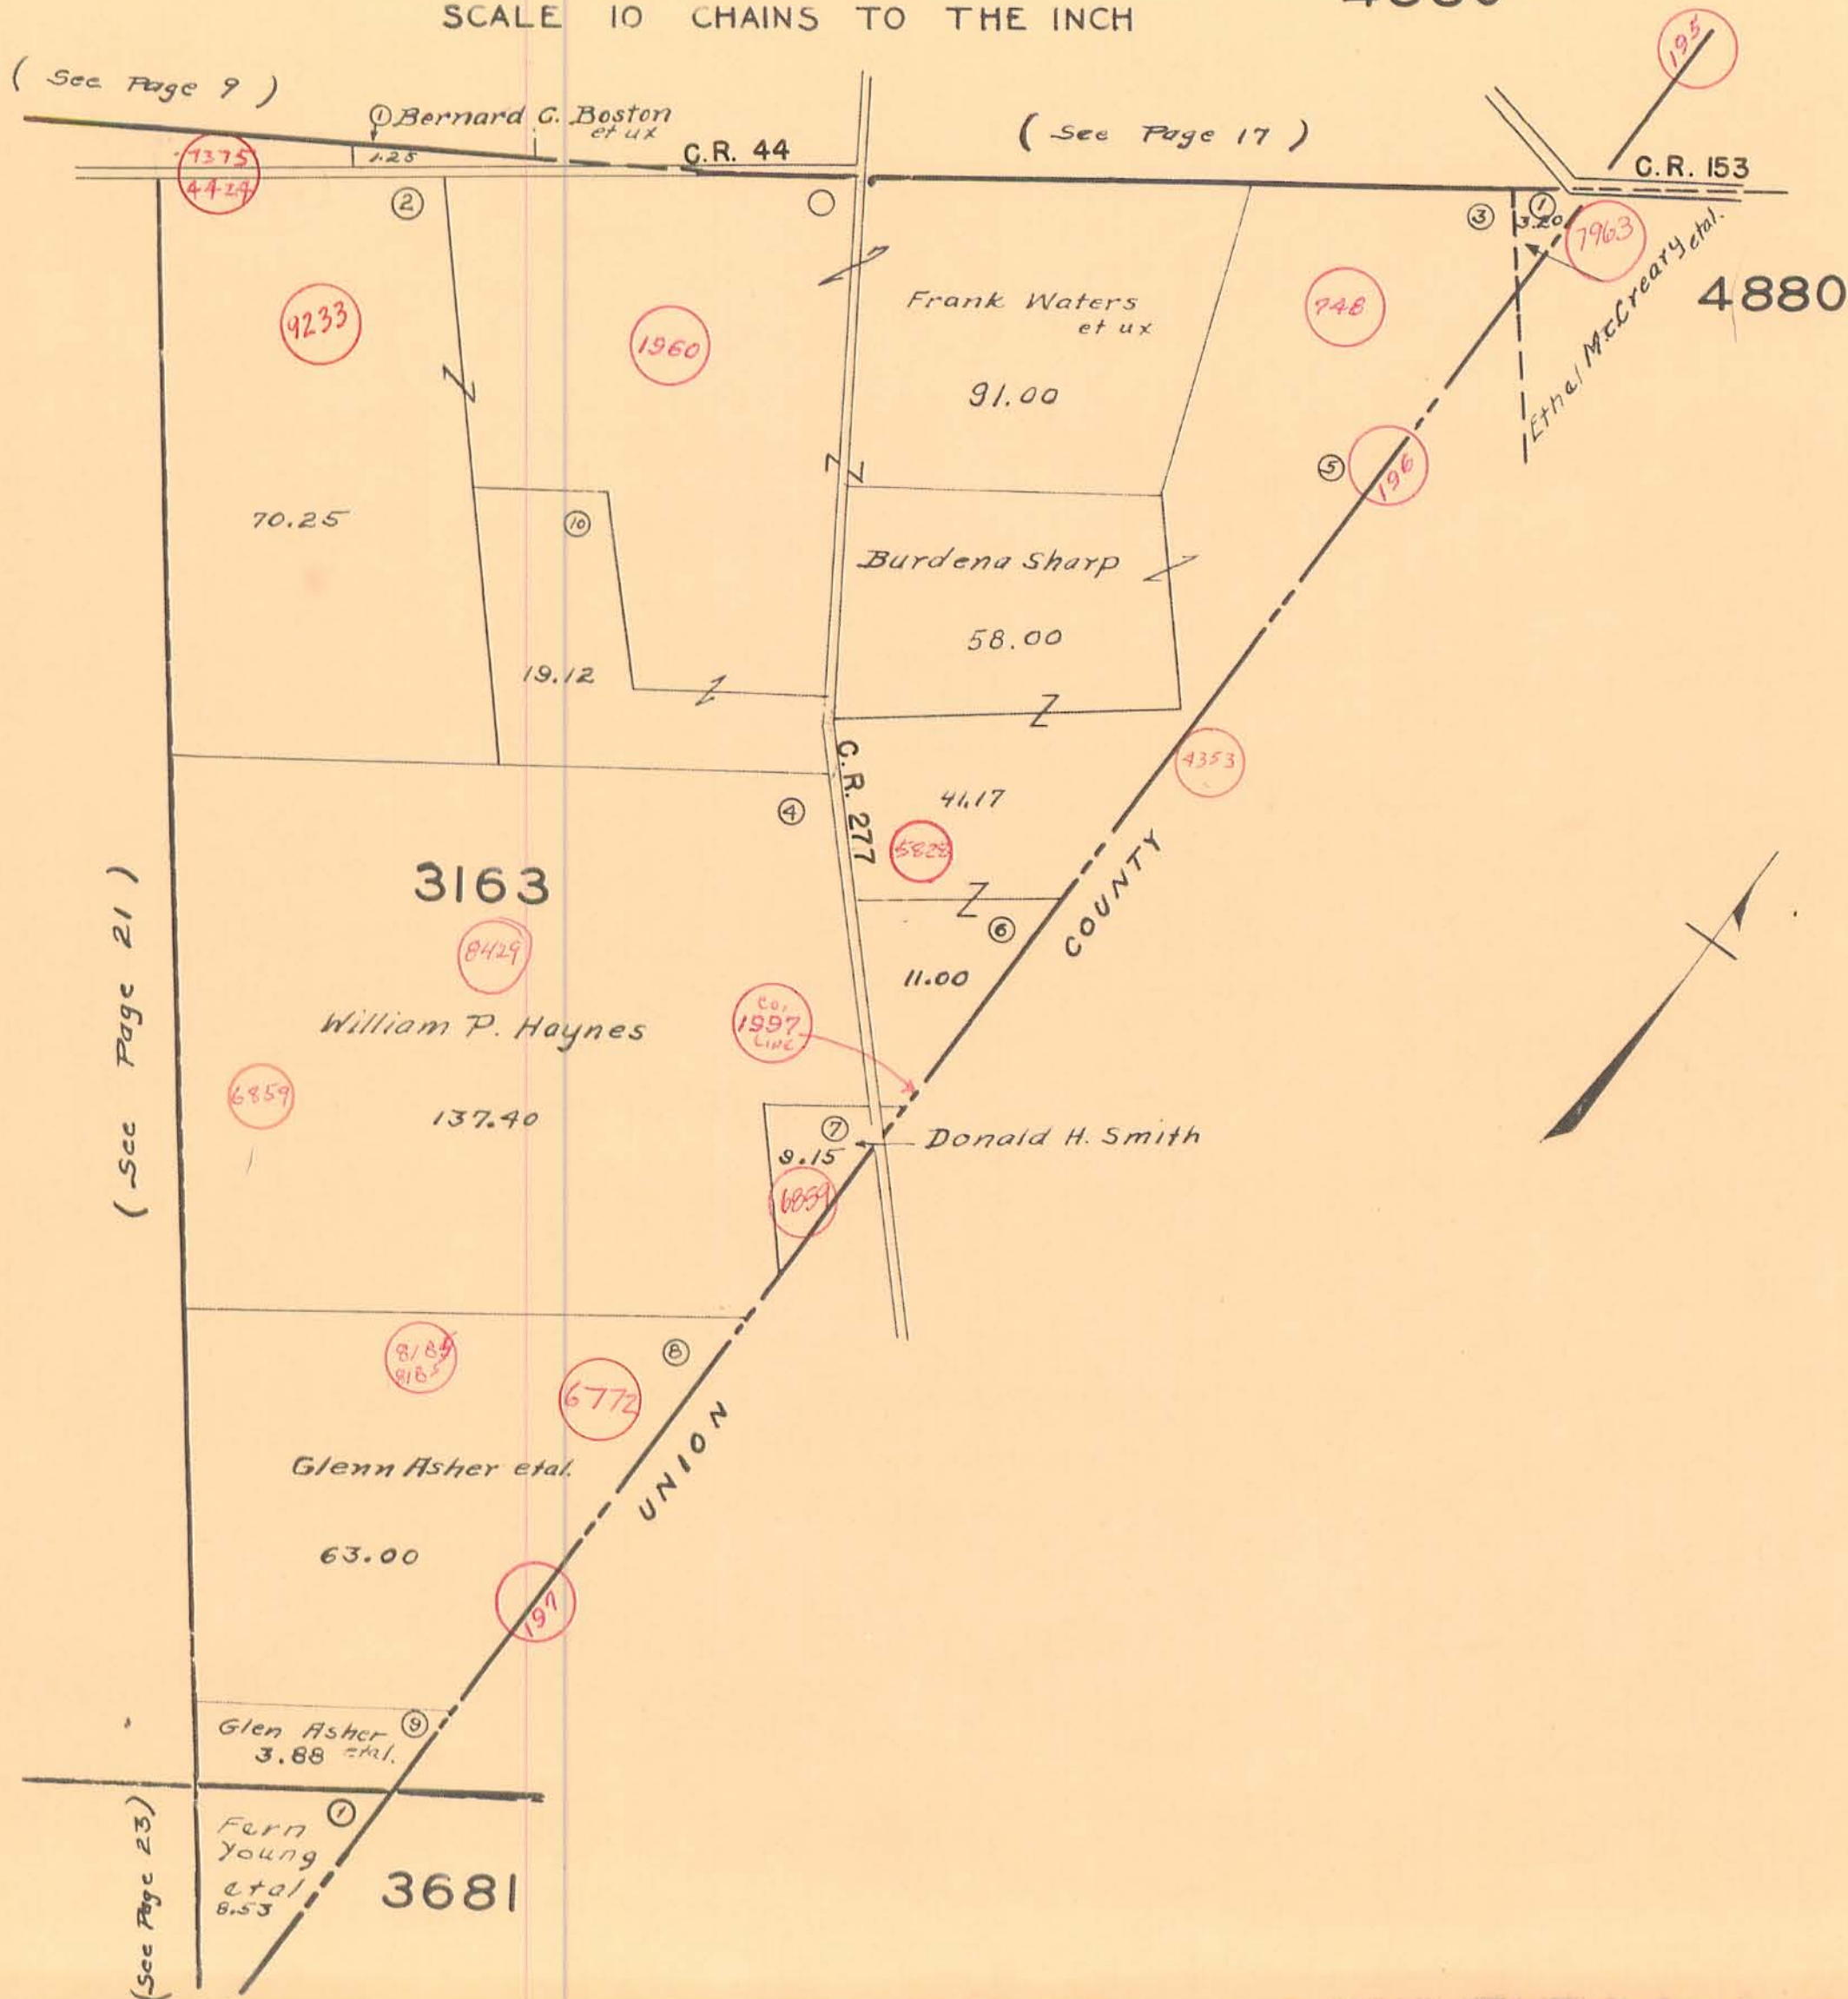

(See Page 21)

(See Page 23)

3163

3681

