

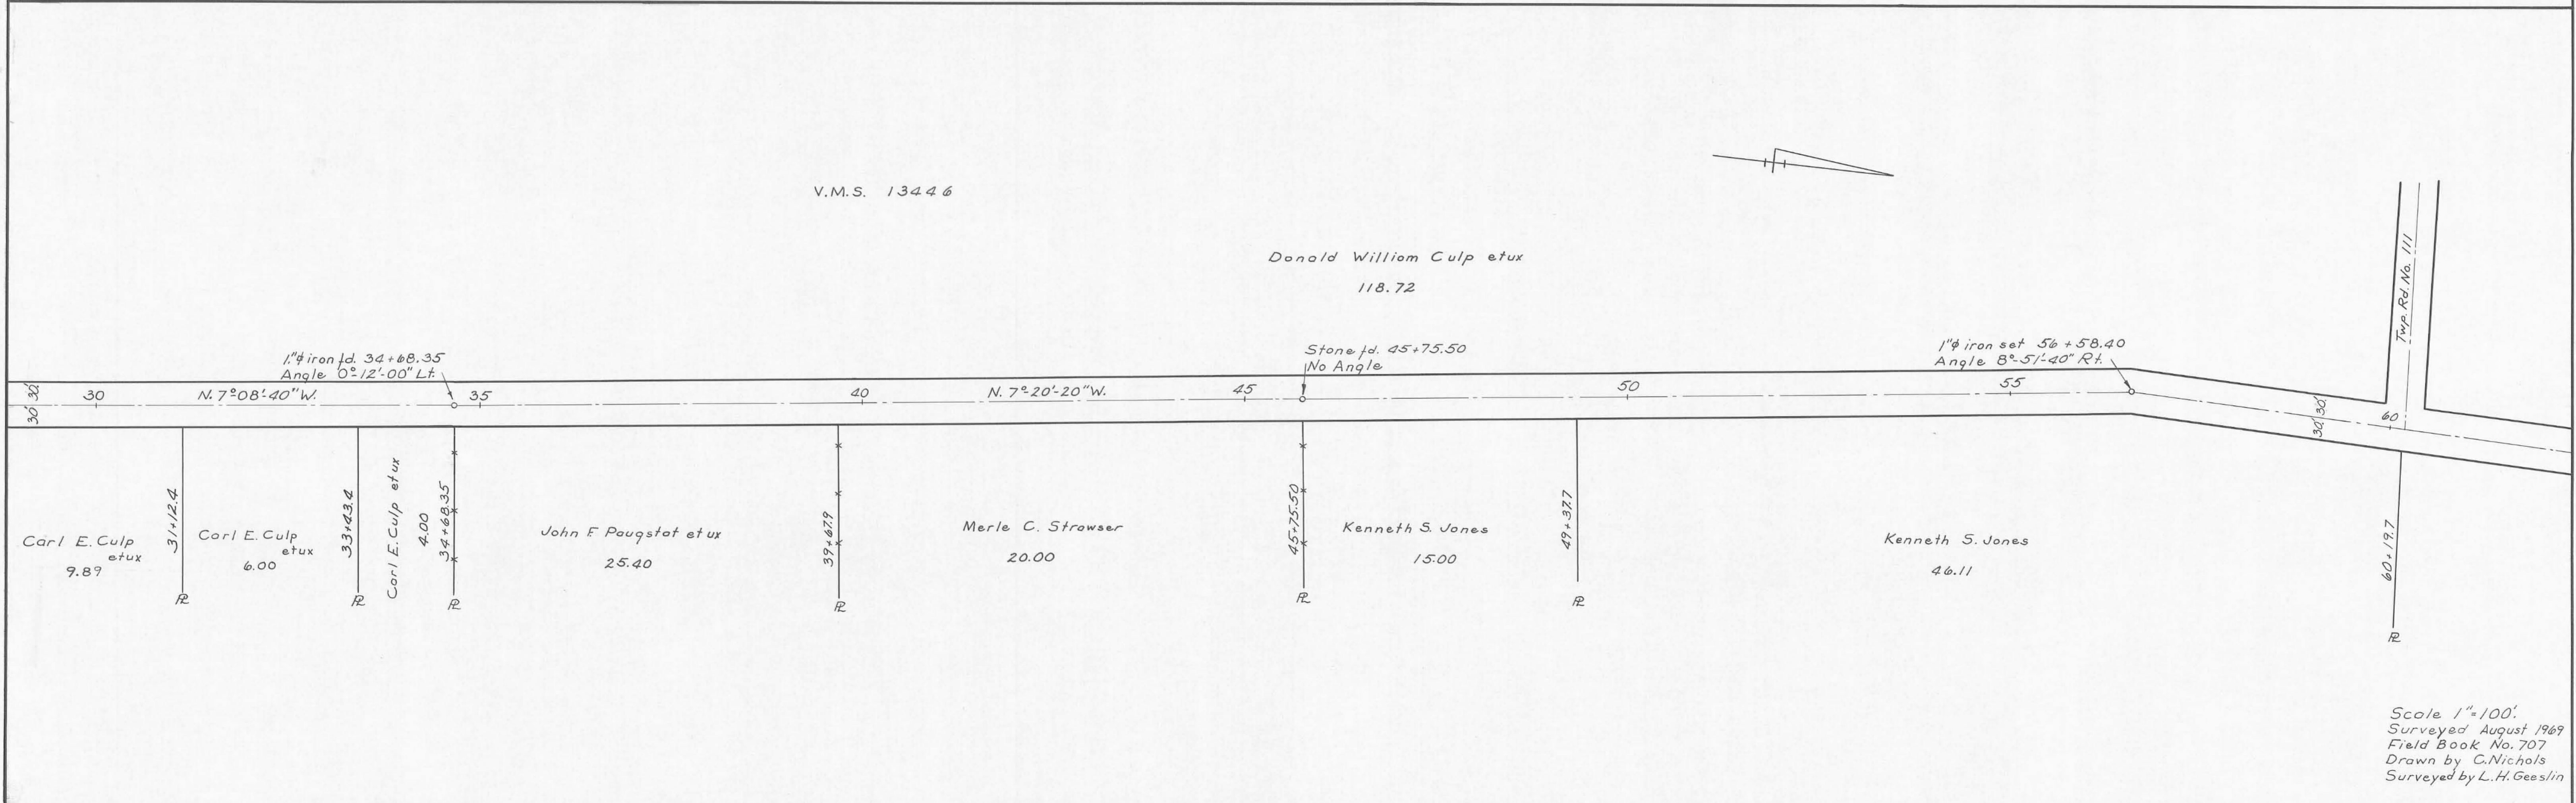


60.' Right of Way
1836 Commissioners
Journal No. 5, page 5.

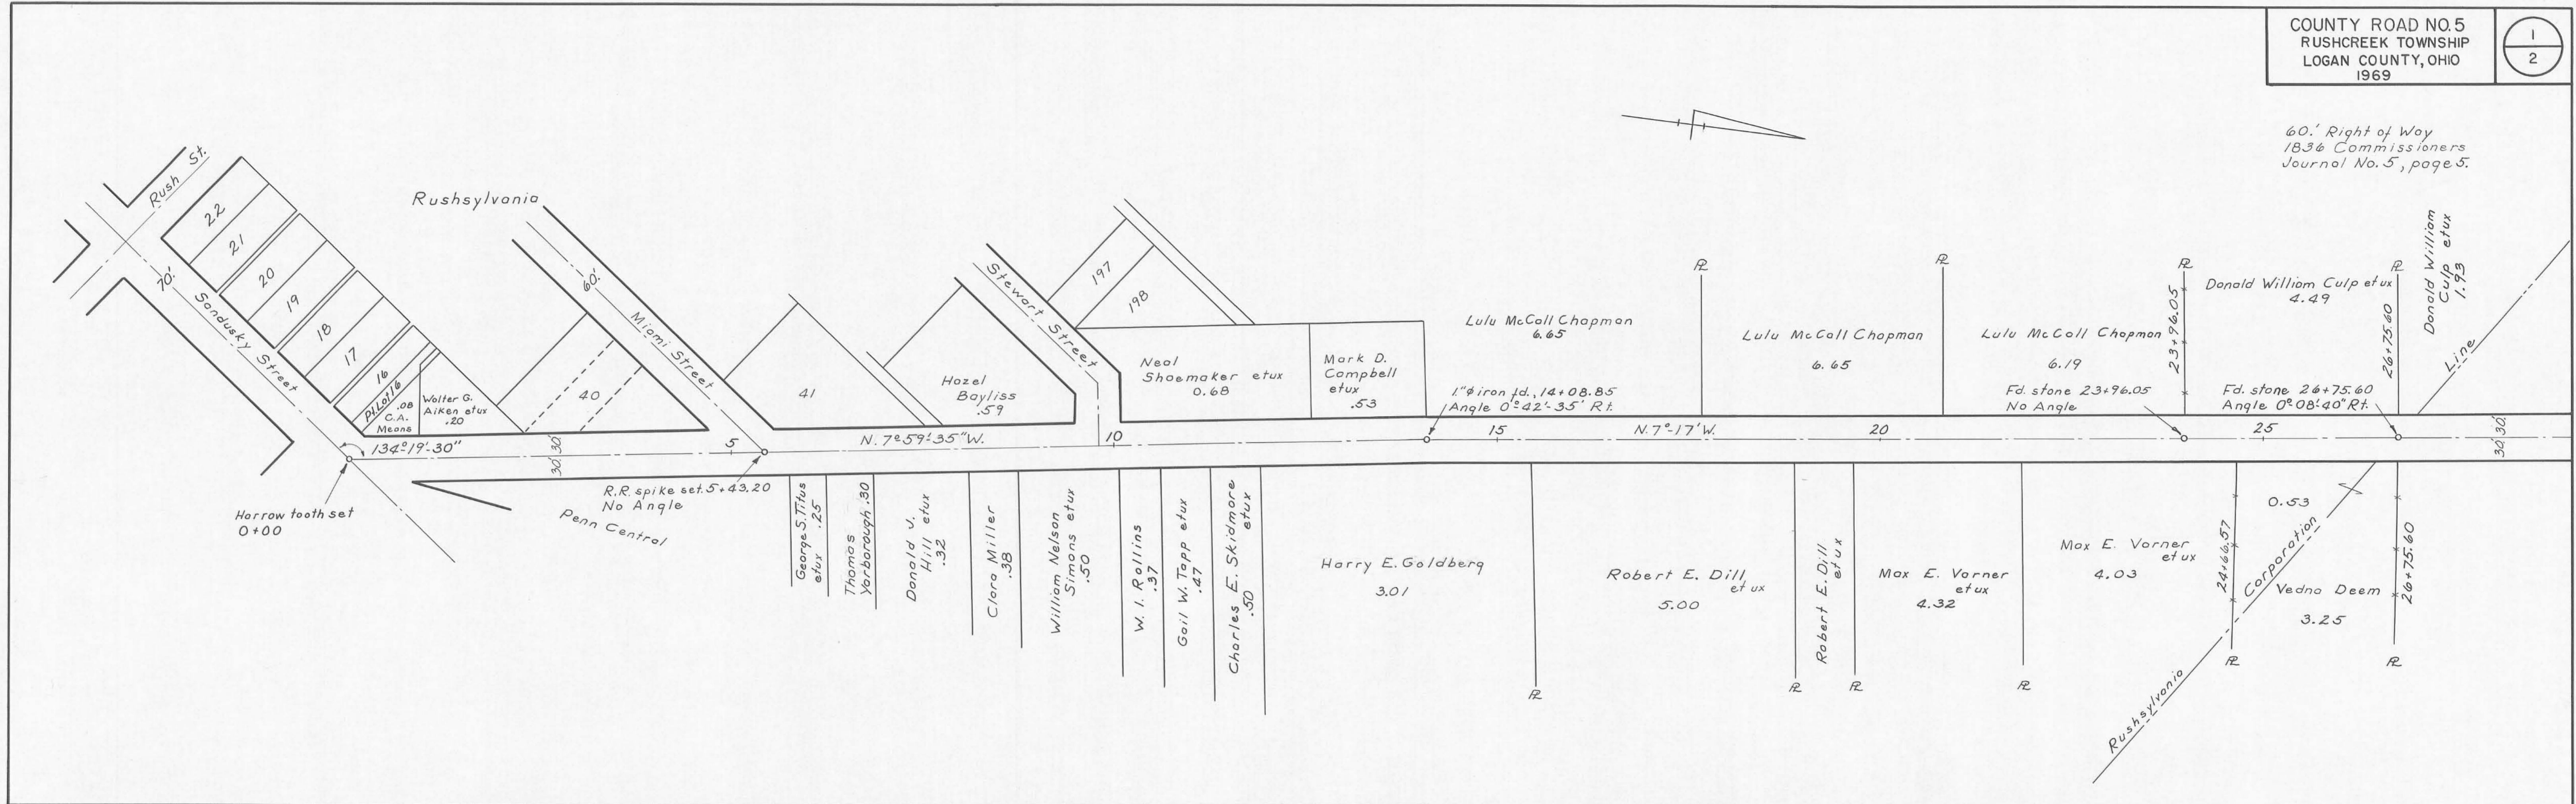


Scale 1"=100'.
 Surveyed August 1969
 Field Book No. 707
 Drawn by C. Nichols
 Surveyed by L.H. Geeslin

V. M. S. 9954

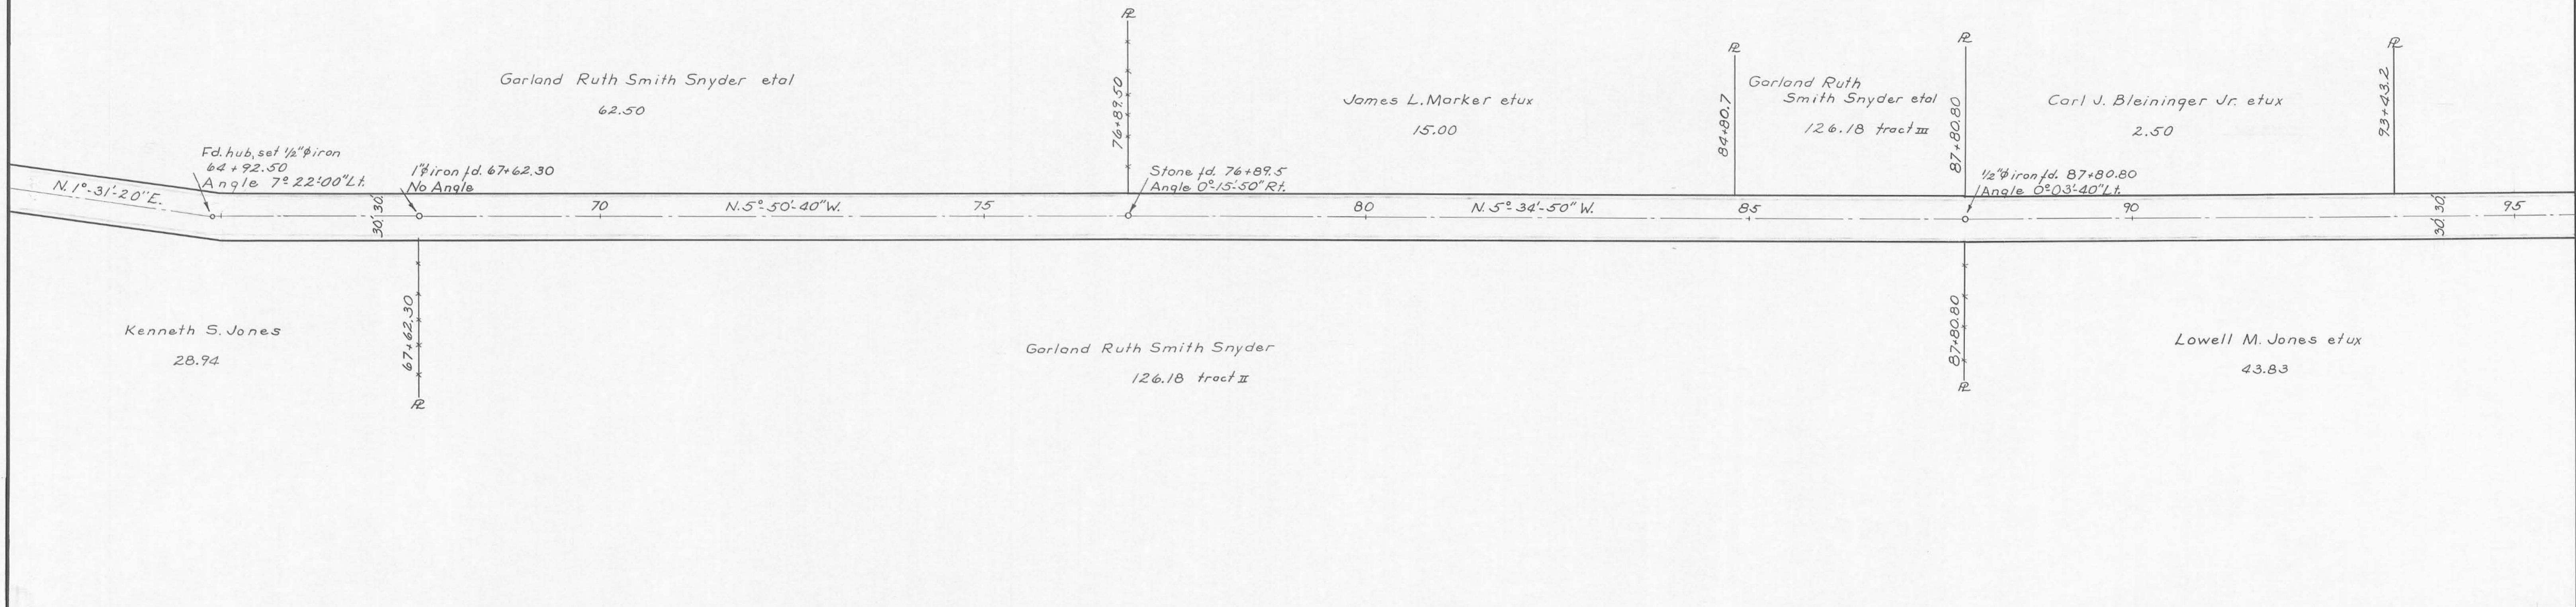

V. M. S. 9954

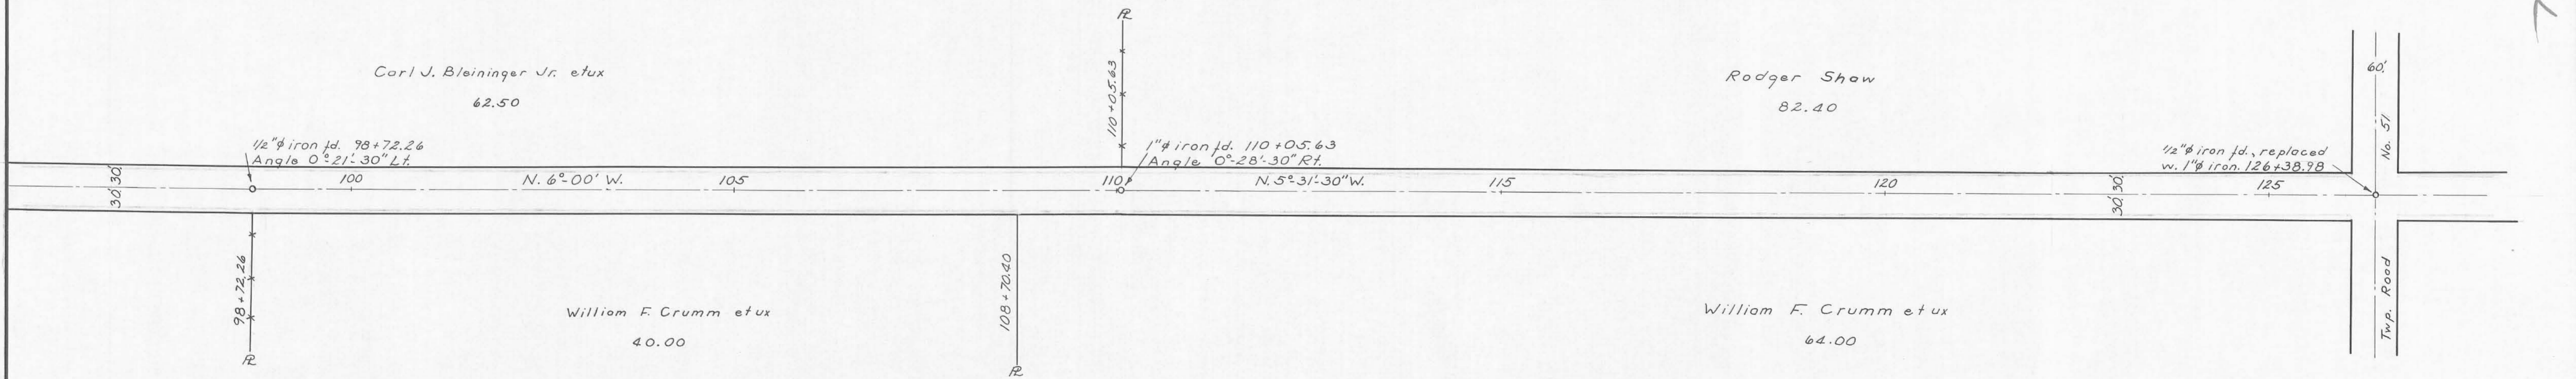

Scale 1" = 100'
Surveyed August 1969
Field Book No. 707
Drawn by C. Nichols
Surveyed by L. H. Geeslin