


Survey Notes in Logan County  
Surveyors Book 560 Pages 77 to 79  
Bellefontaine - Rushsylvania Pike 60'  
Free Turnpike Record No. 3 Page 360

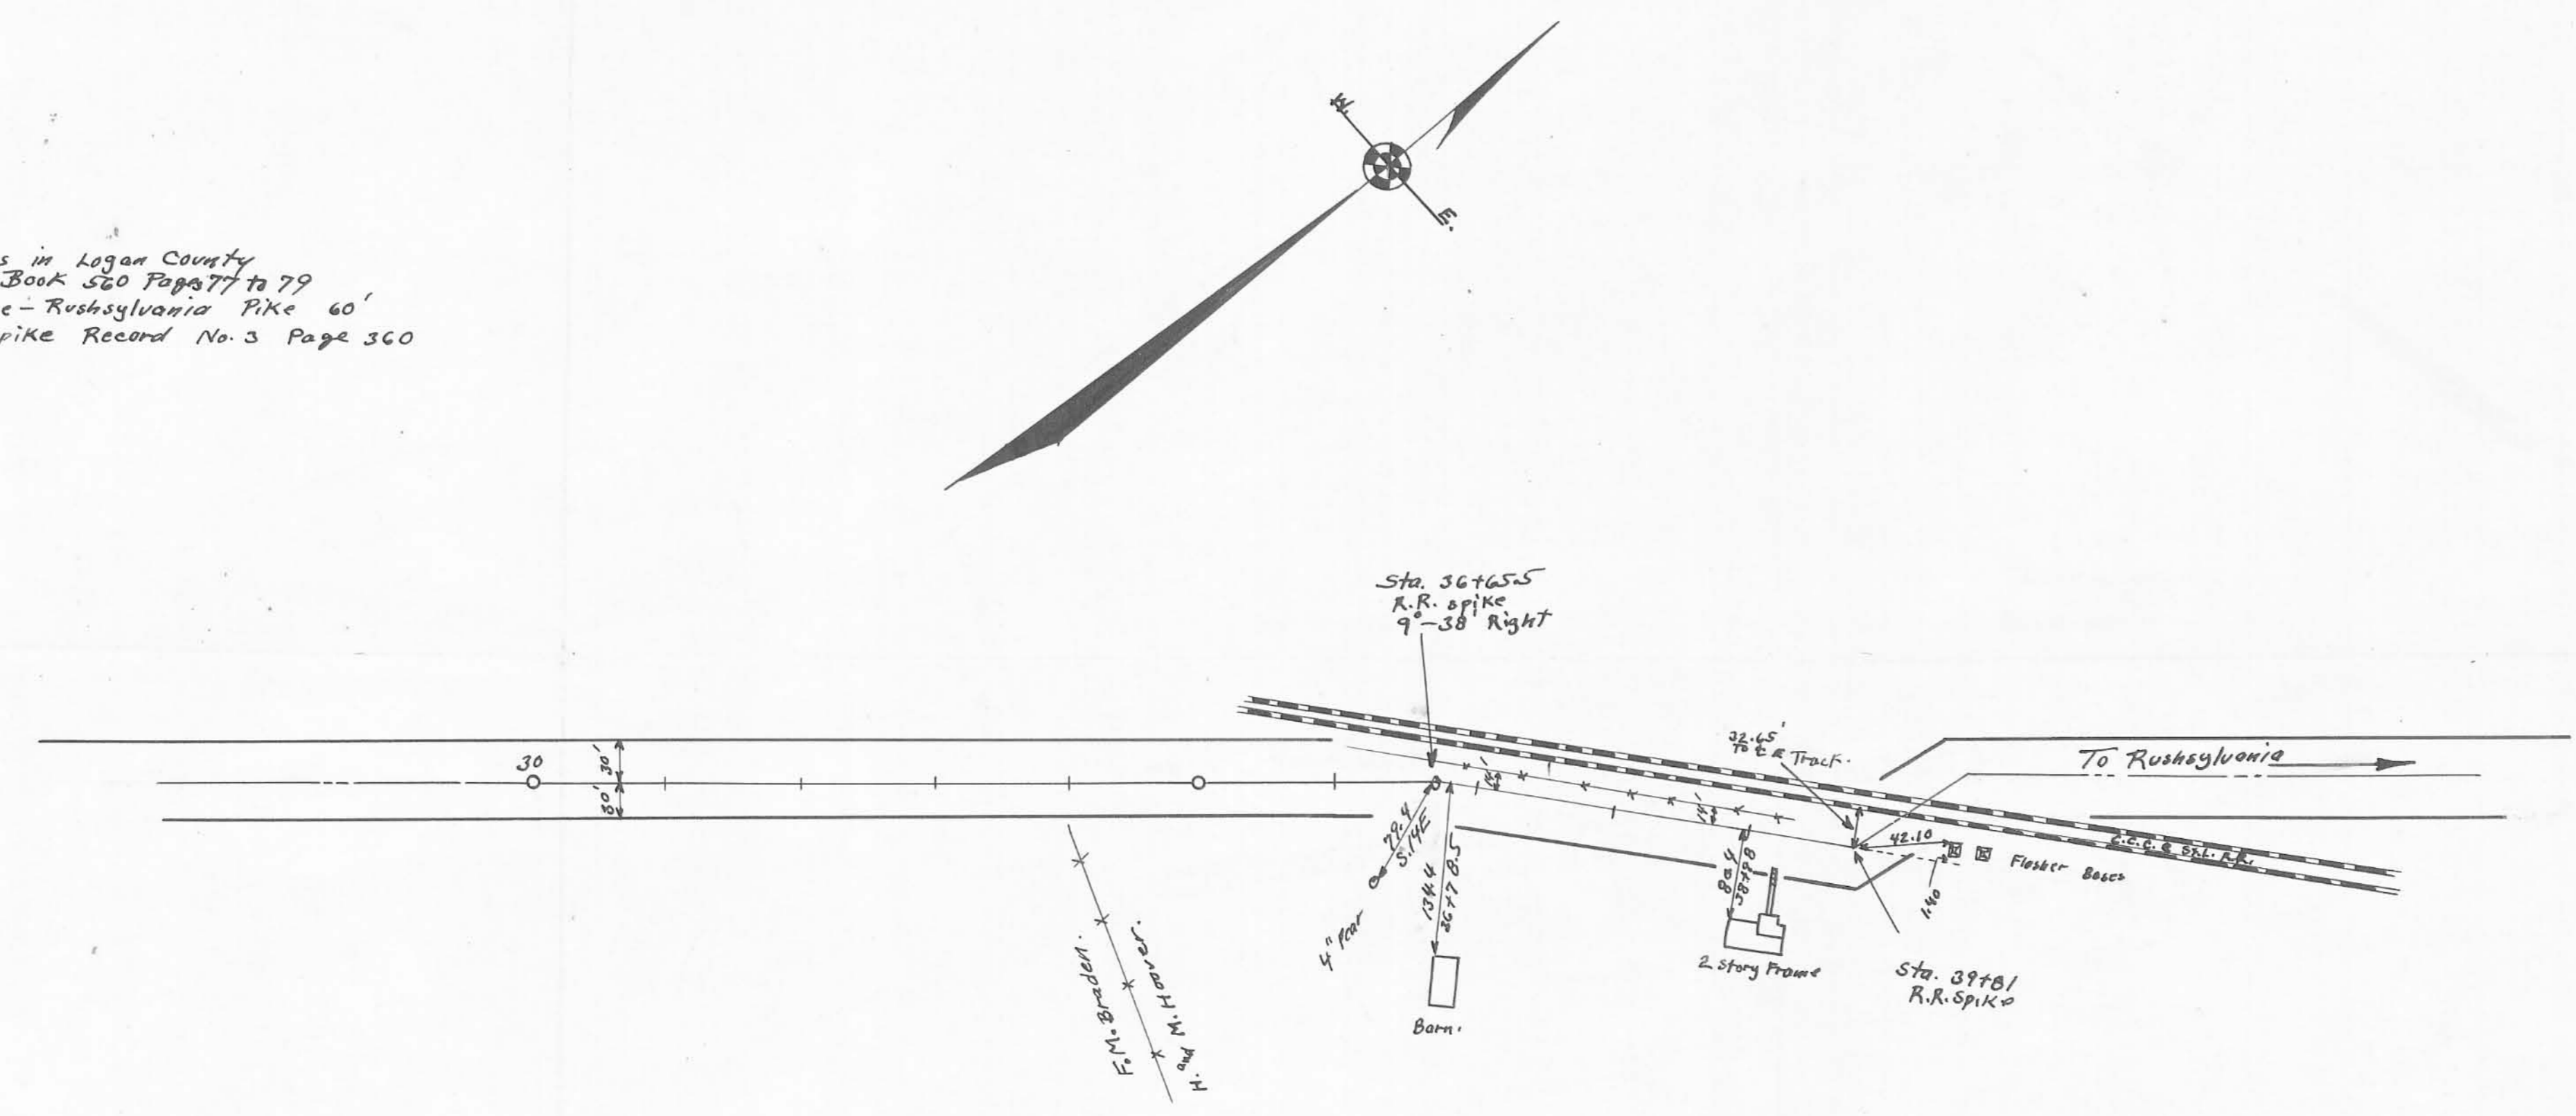

Drawn by  
F. F. O'Keefe

INDEXED ON MAP