
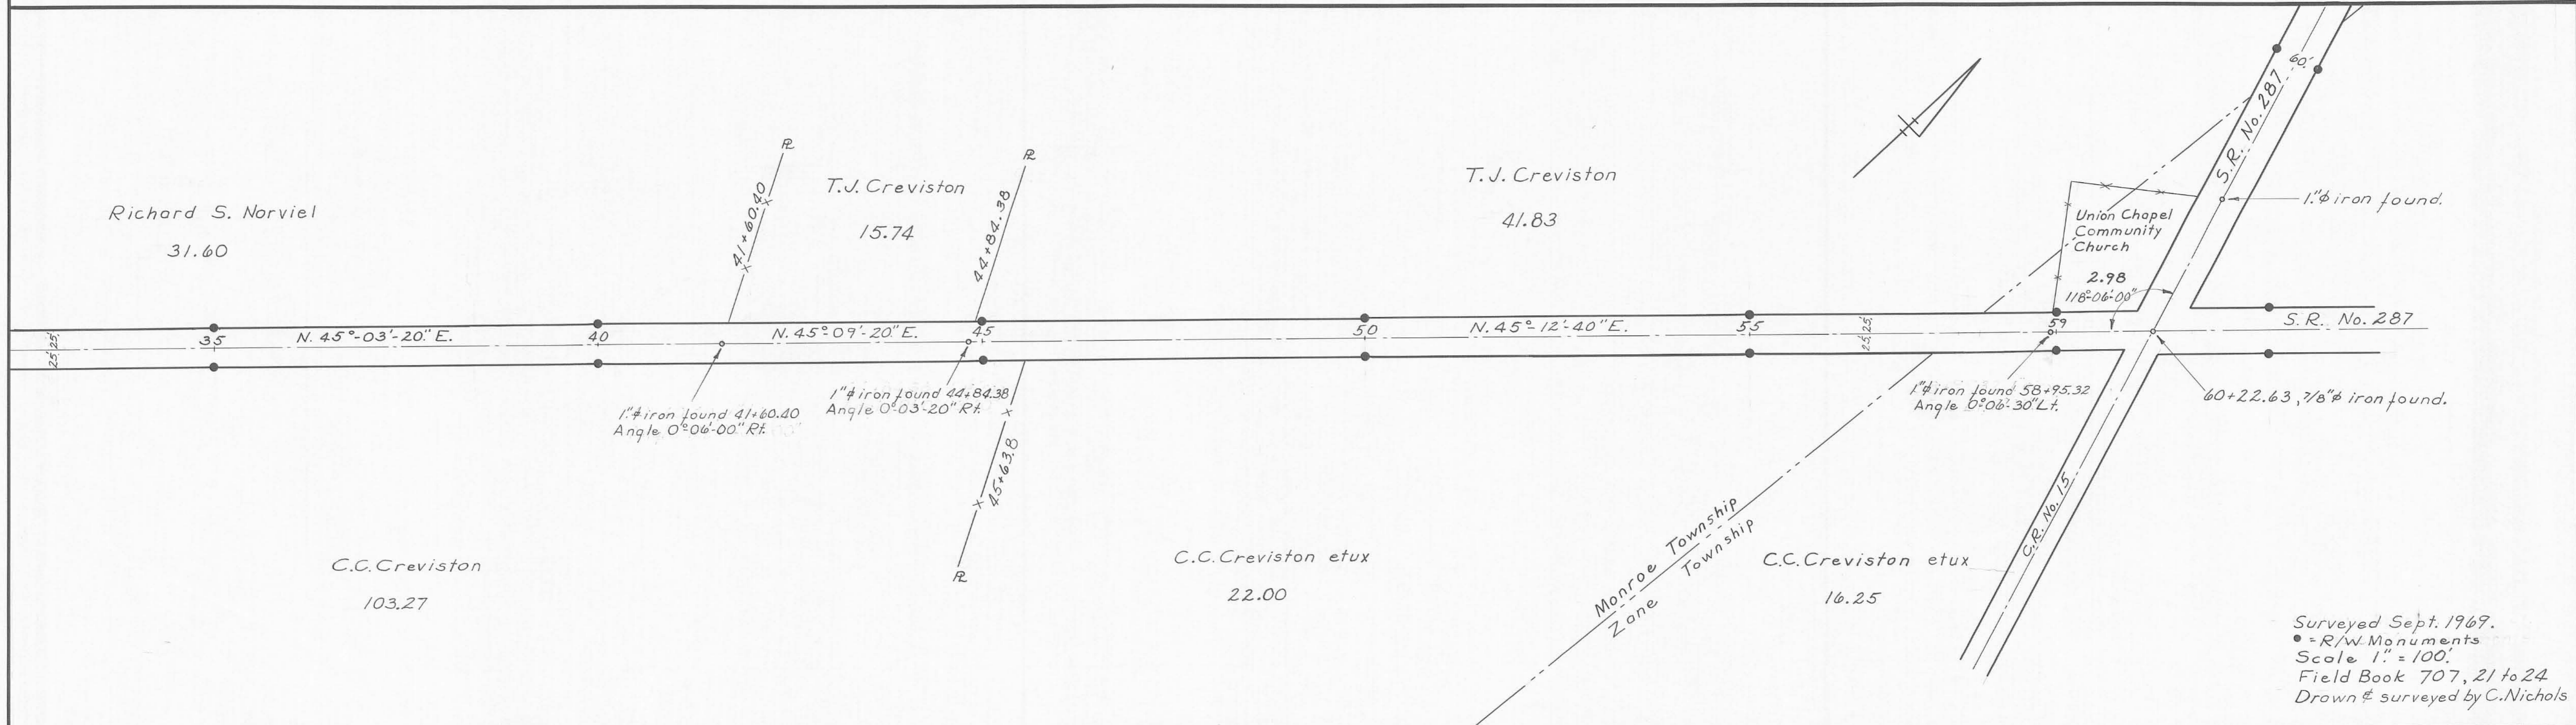


50' Right of way  
 1880 Free Turnpike Record 5,  
 pages 379, 380, & 392  
 1930 Commissioners Journal X,  
 page 398. Designated S.H. 607.

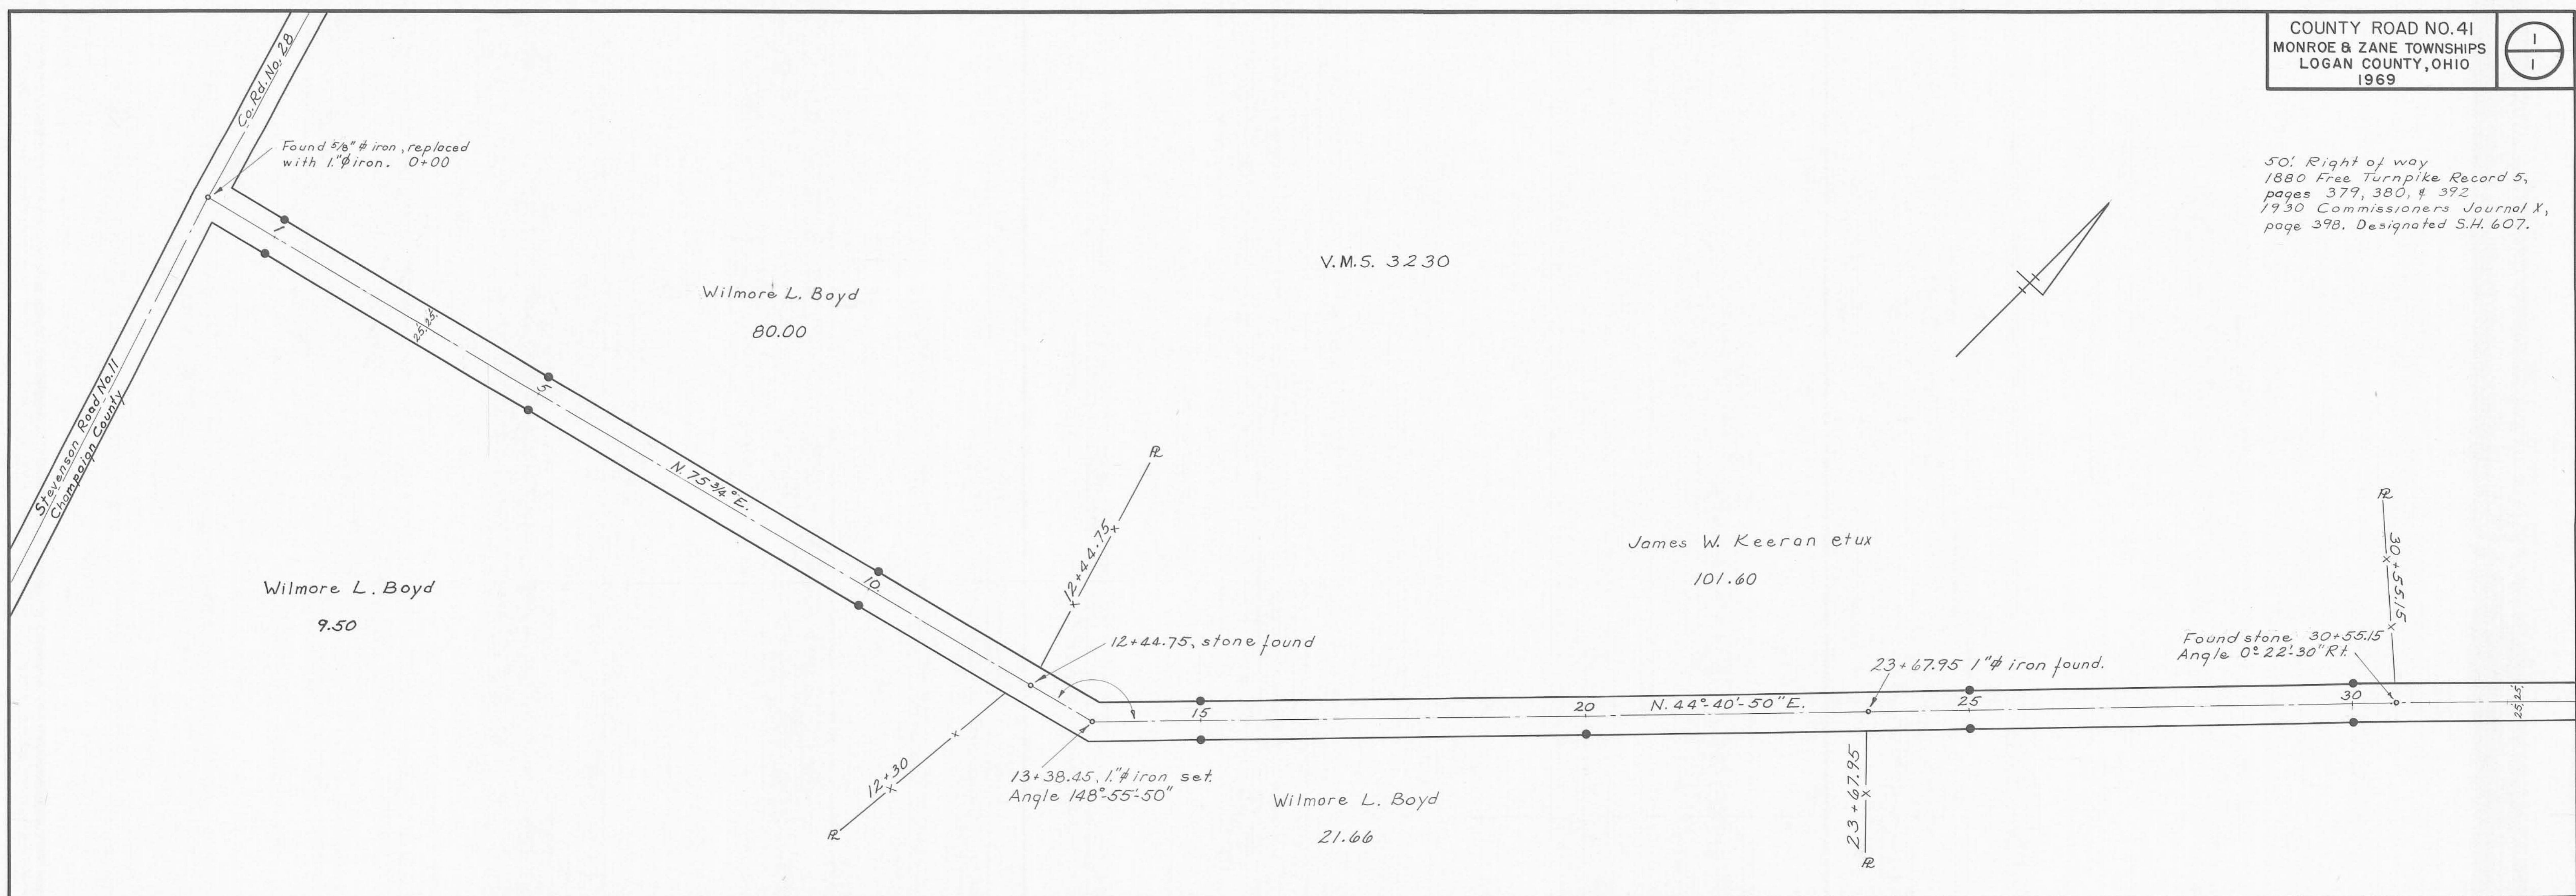

Surveyed Sept. 1967.  
 • = R/W Monuments  
 Scale 1" = 100'.  
 Field Book 707, 21 to 24.  
 Drawn & surveyed by C. Nichols