





40' Road - Dague & Fender Pike 1915  
 First Pike Record No. 9 Page 571  
 Old Notes Book 308  
 Field Notes Book 572  
 Right of Way Concrete Posts set as shown

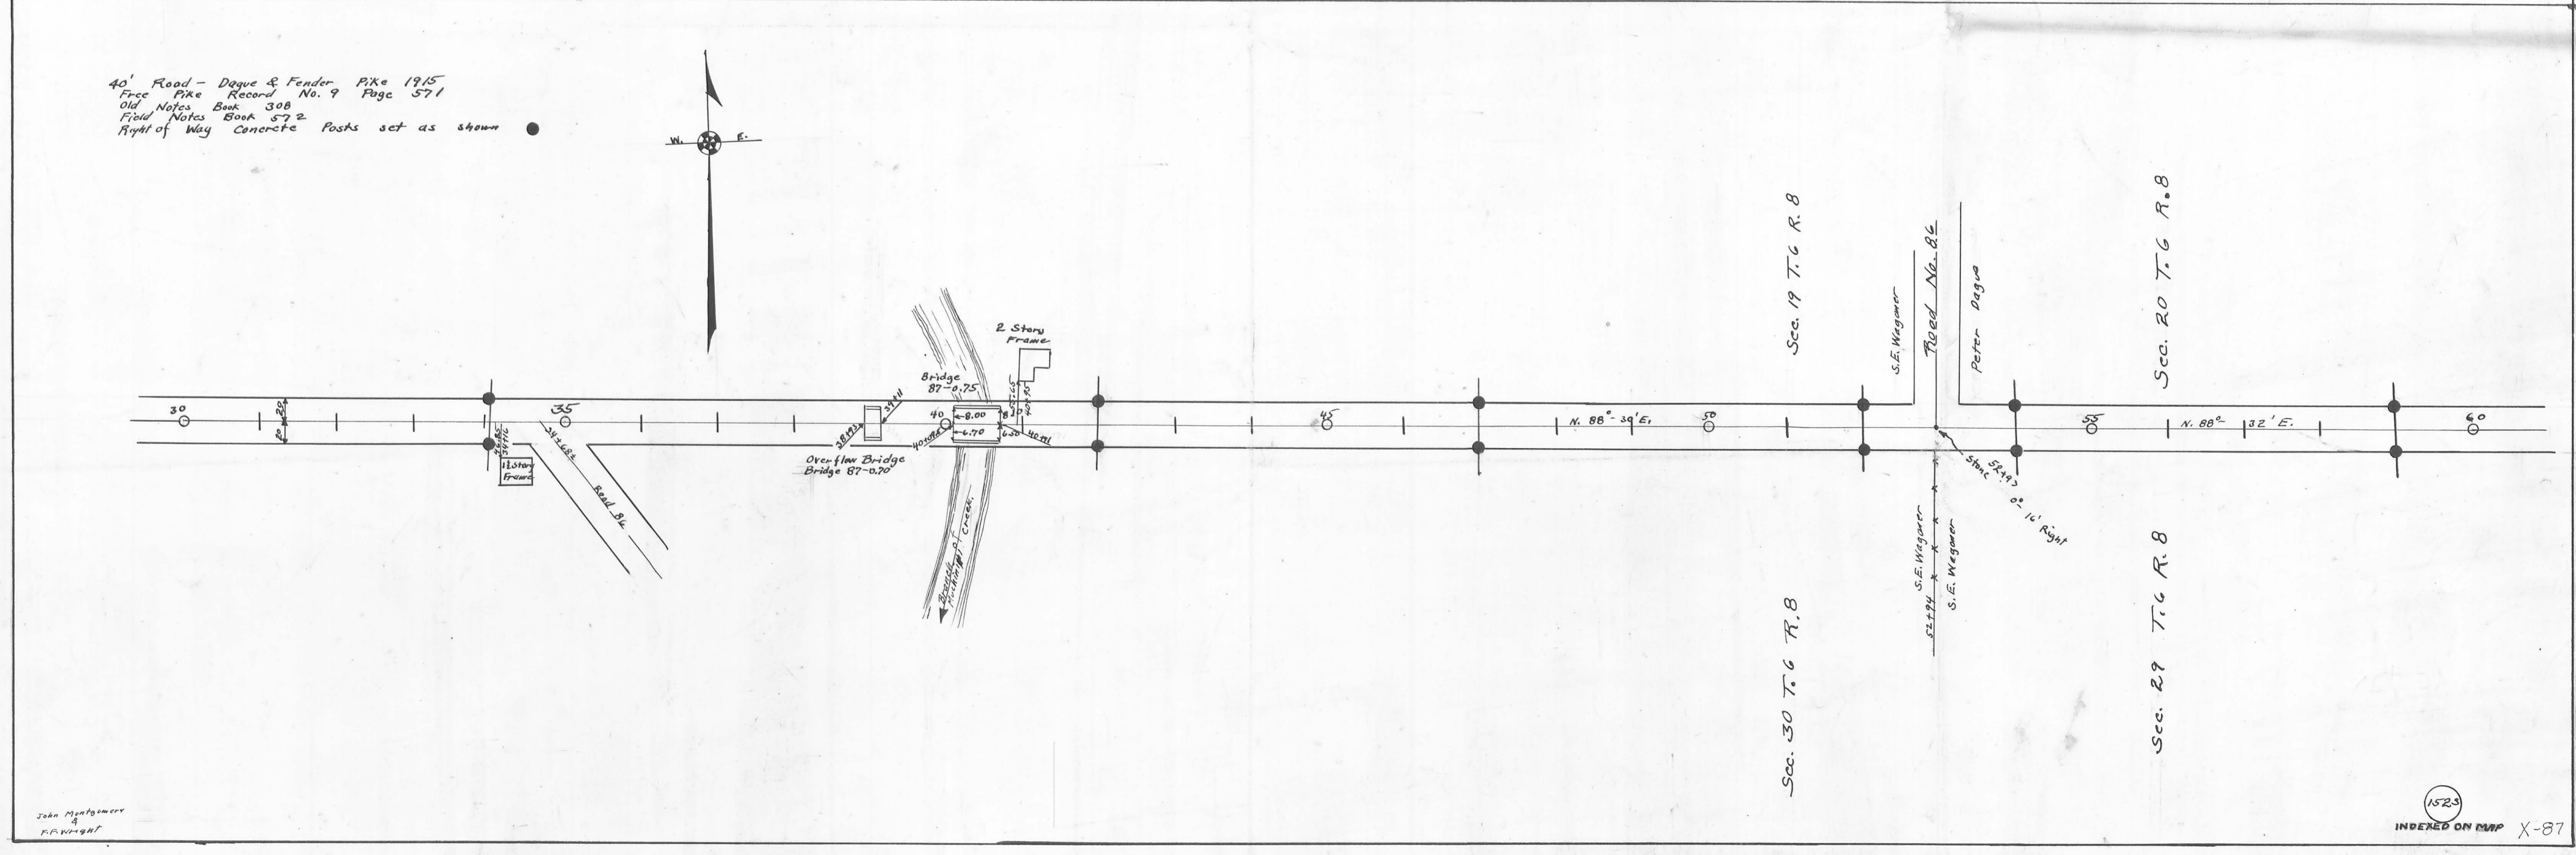

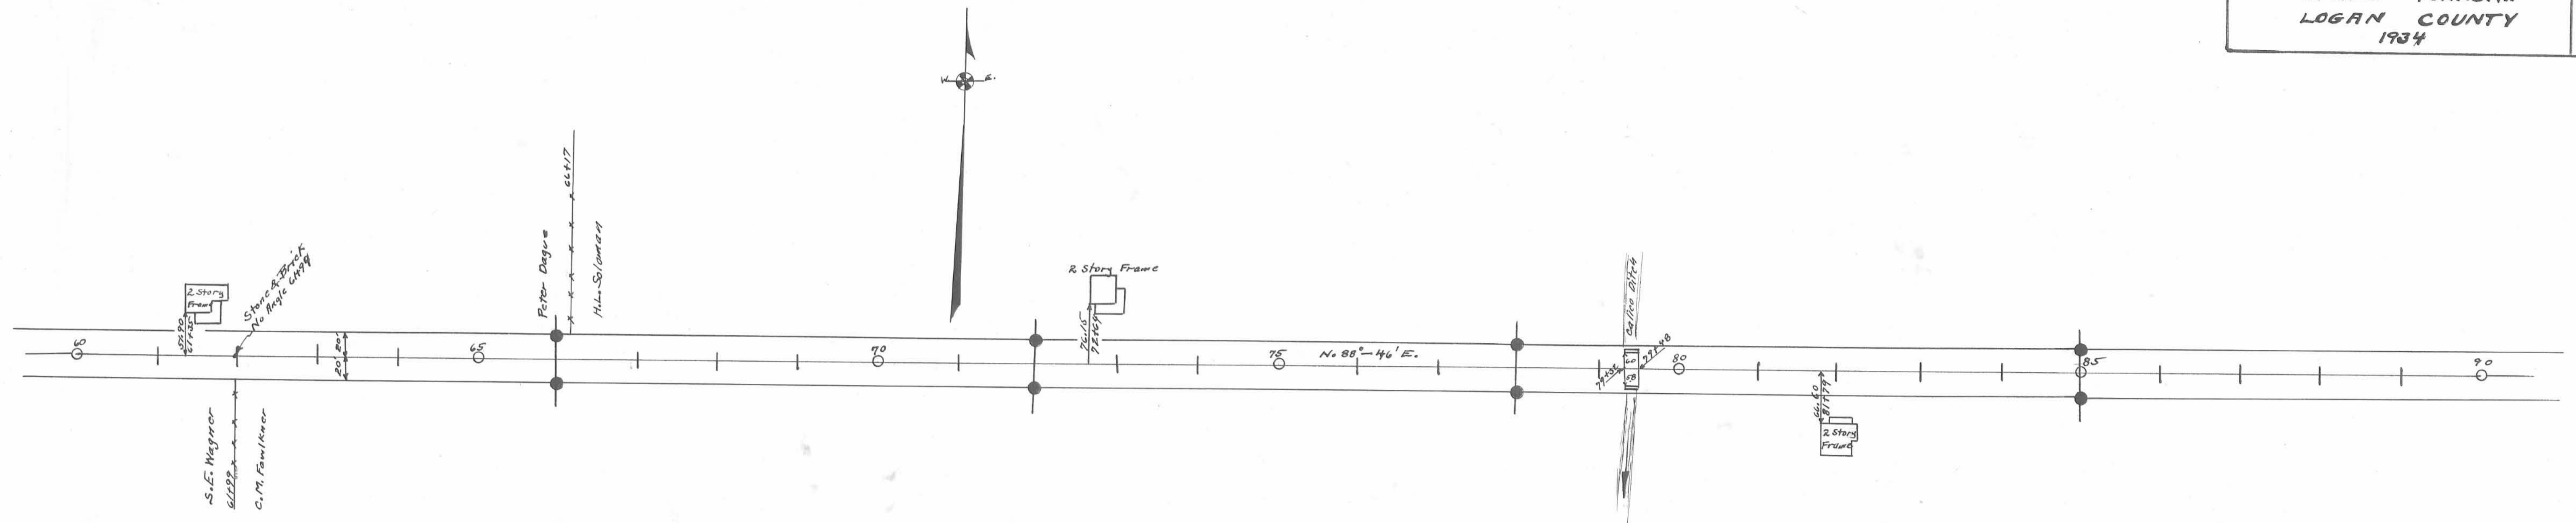


Field Notes Book 572  
Right of way Concrete Posts set as shown.

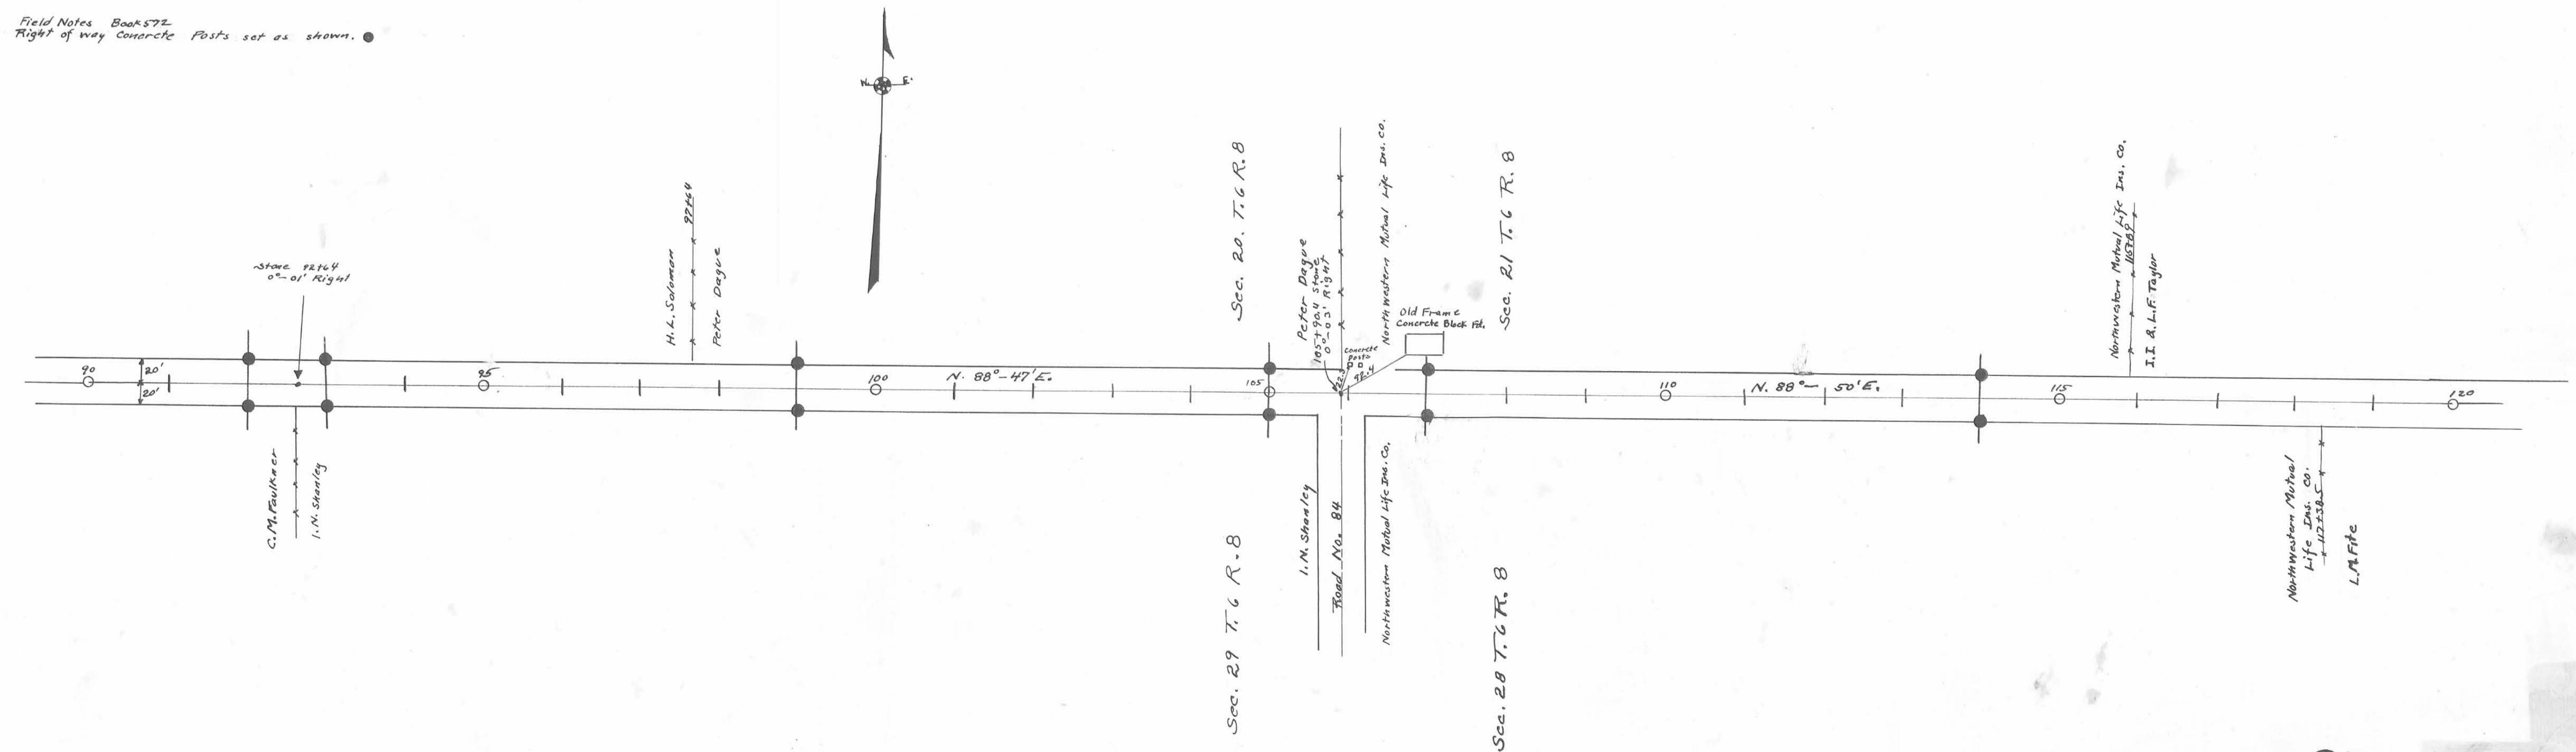


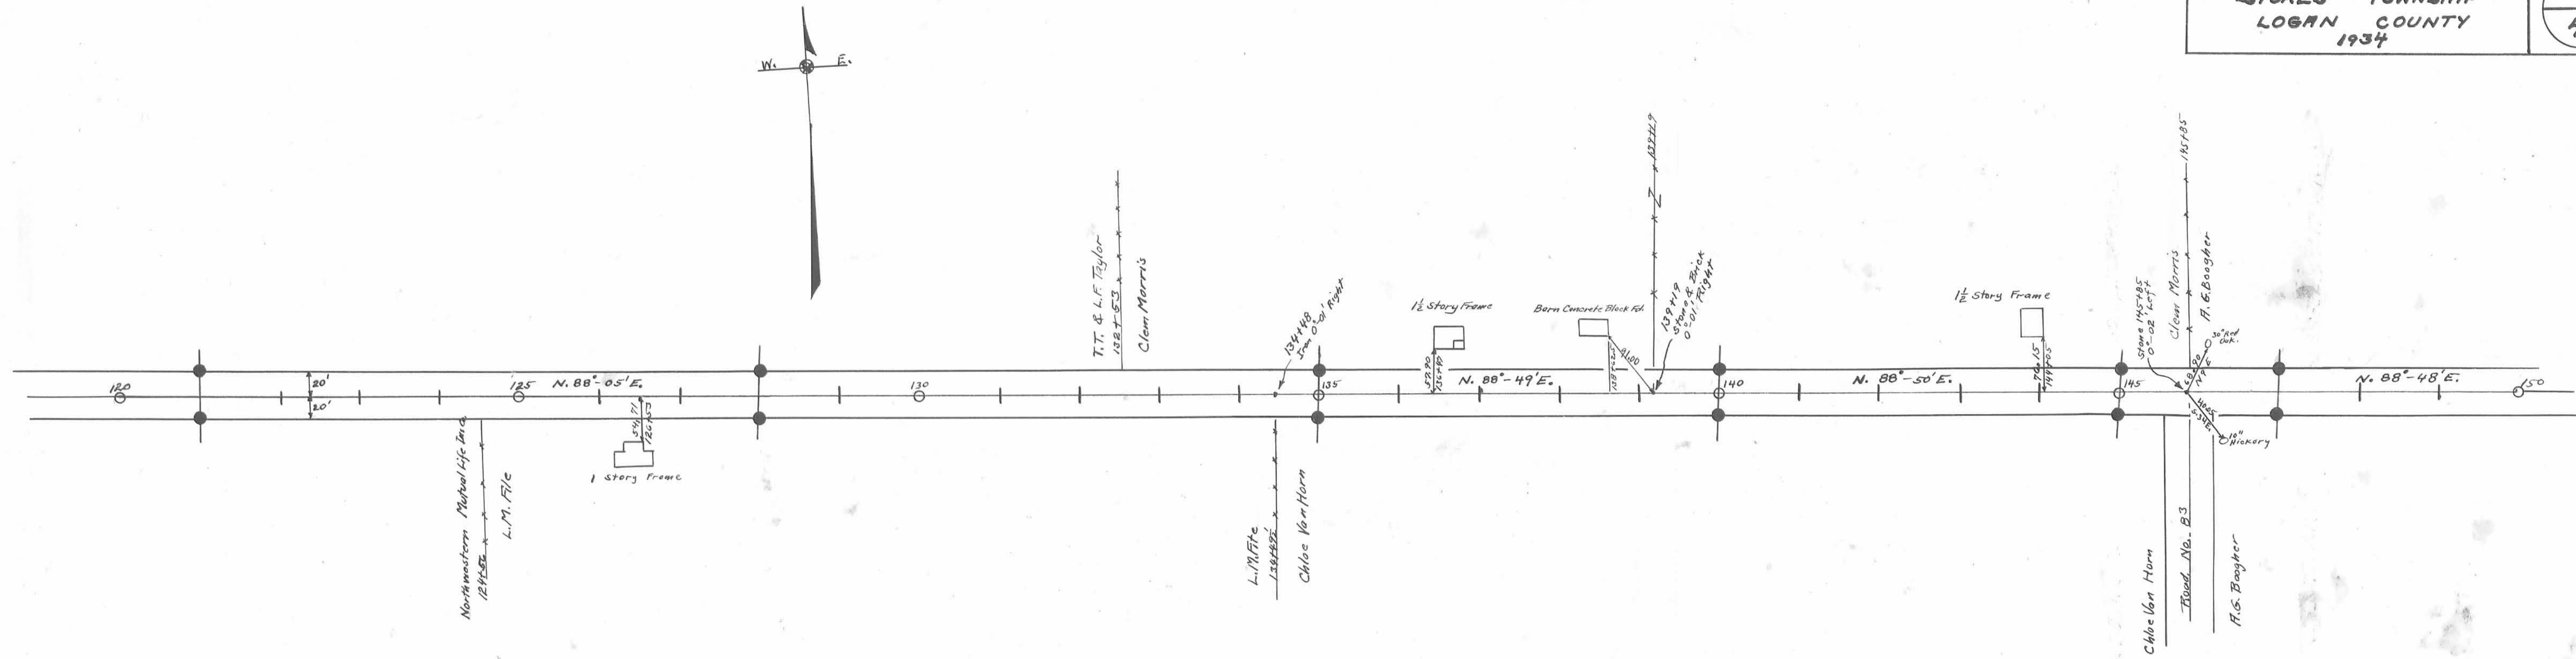

Field Notes Book 572  
 Right of way Concrete Posts set as shown

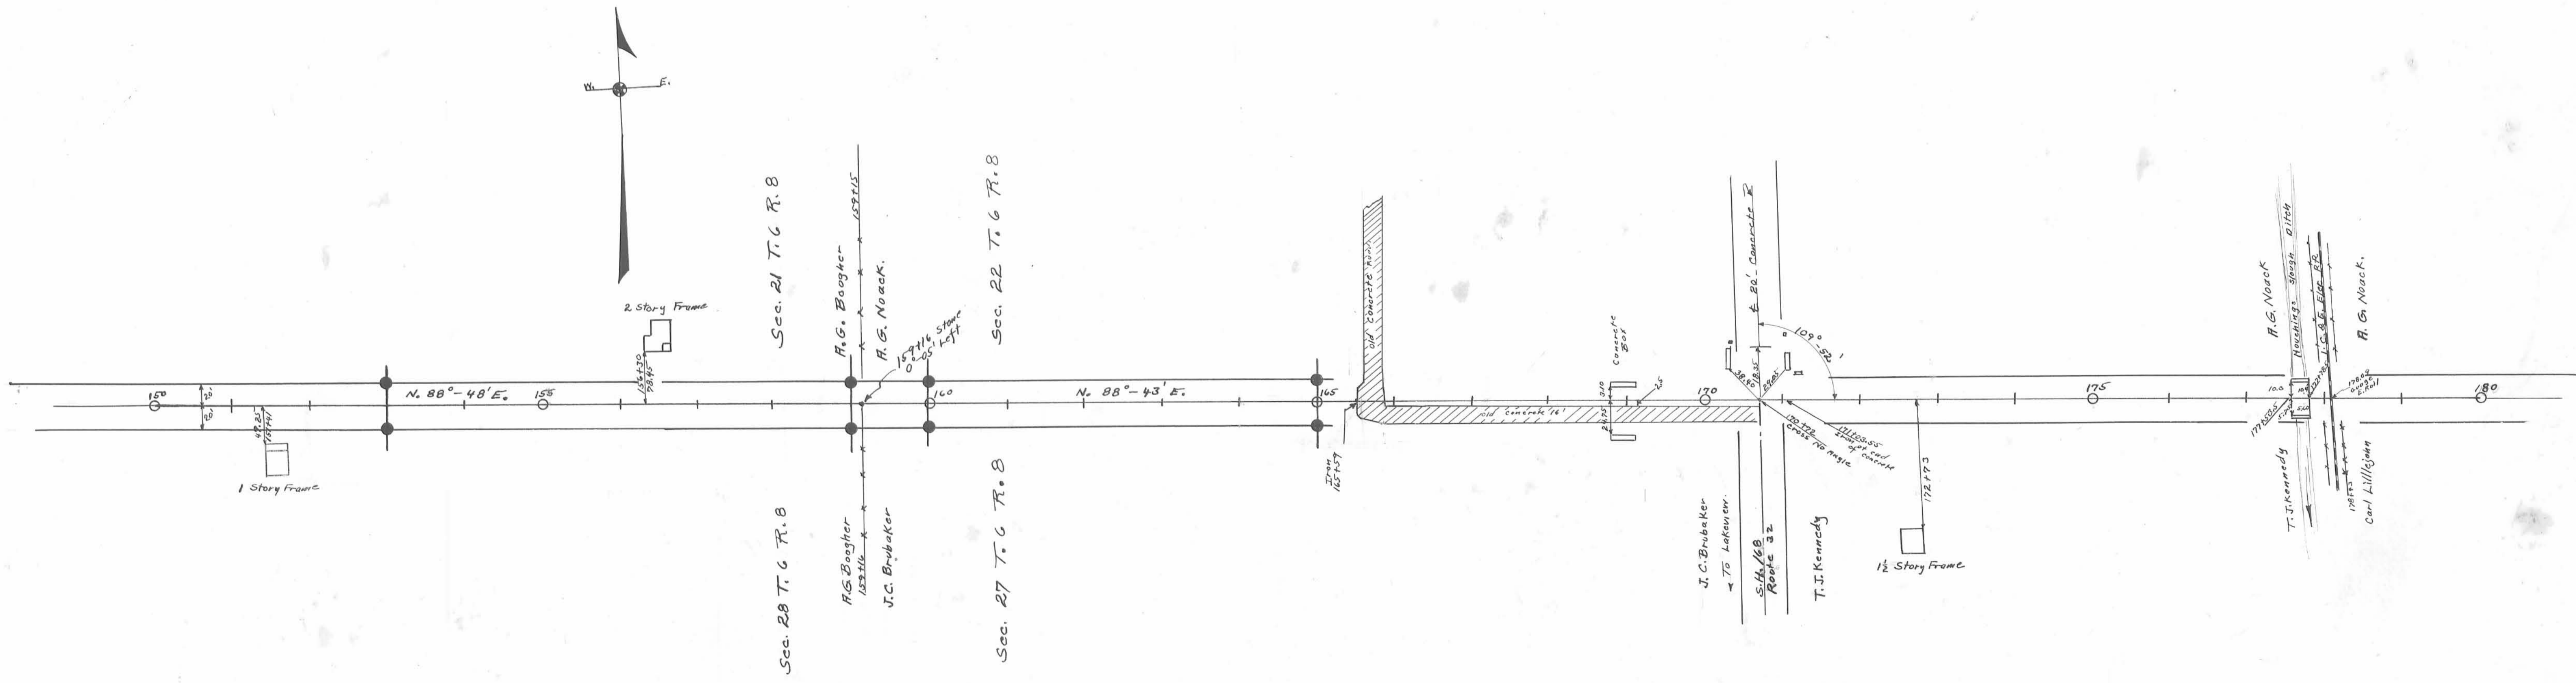

Length 20953 Feet  
 Length 3.97 Miles

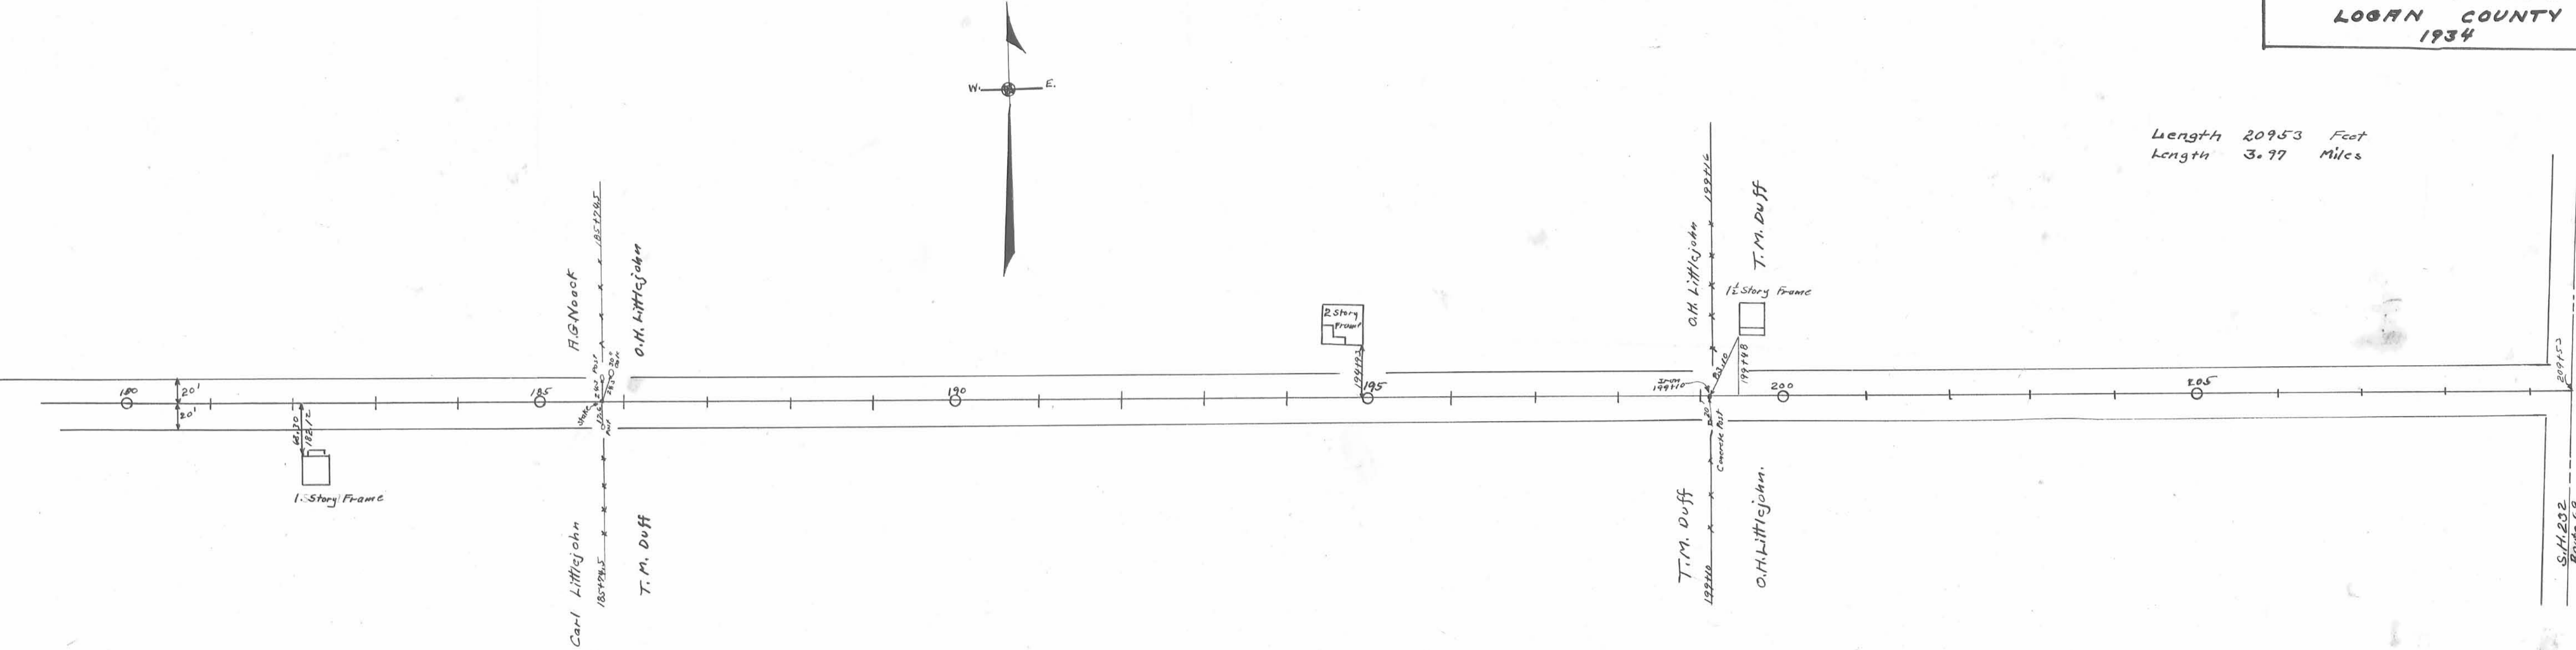

Field Notes Book 57L  
 Right-of-Way Concrete Posts Set as Shown