


Survey Notes in Logan County
 Surveyors Book 560 Page 32 to 36

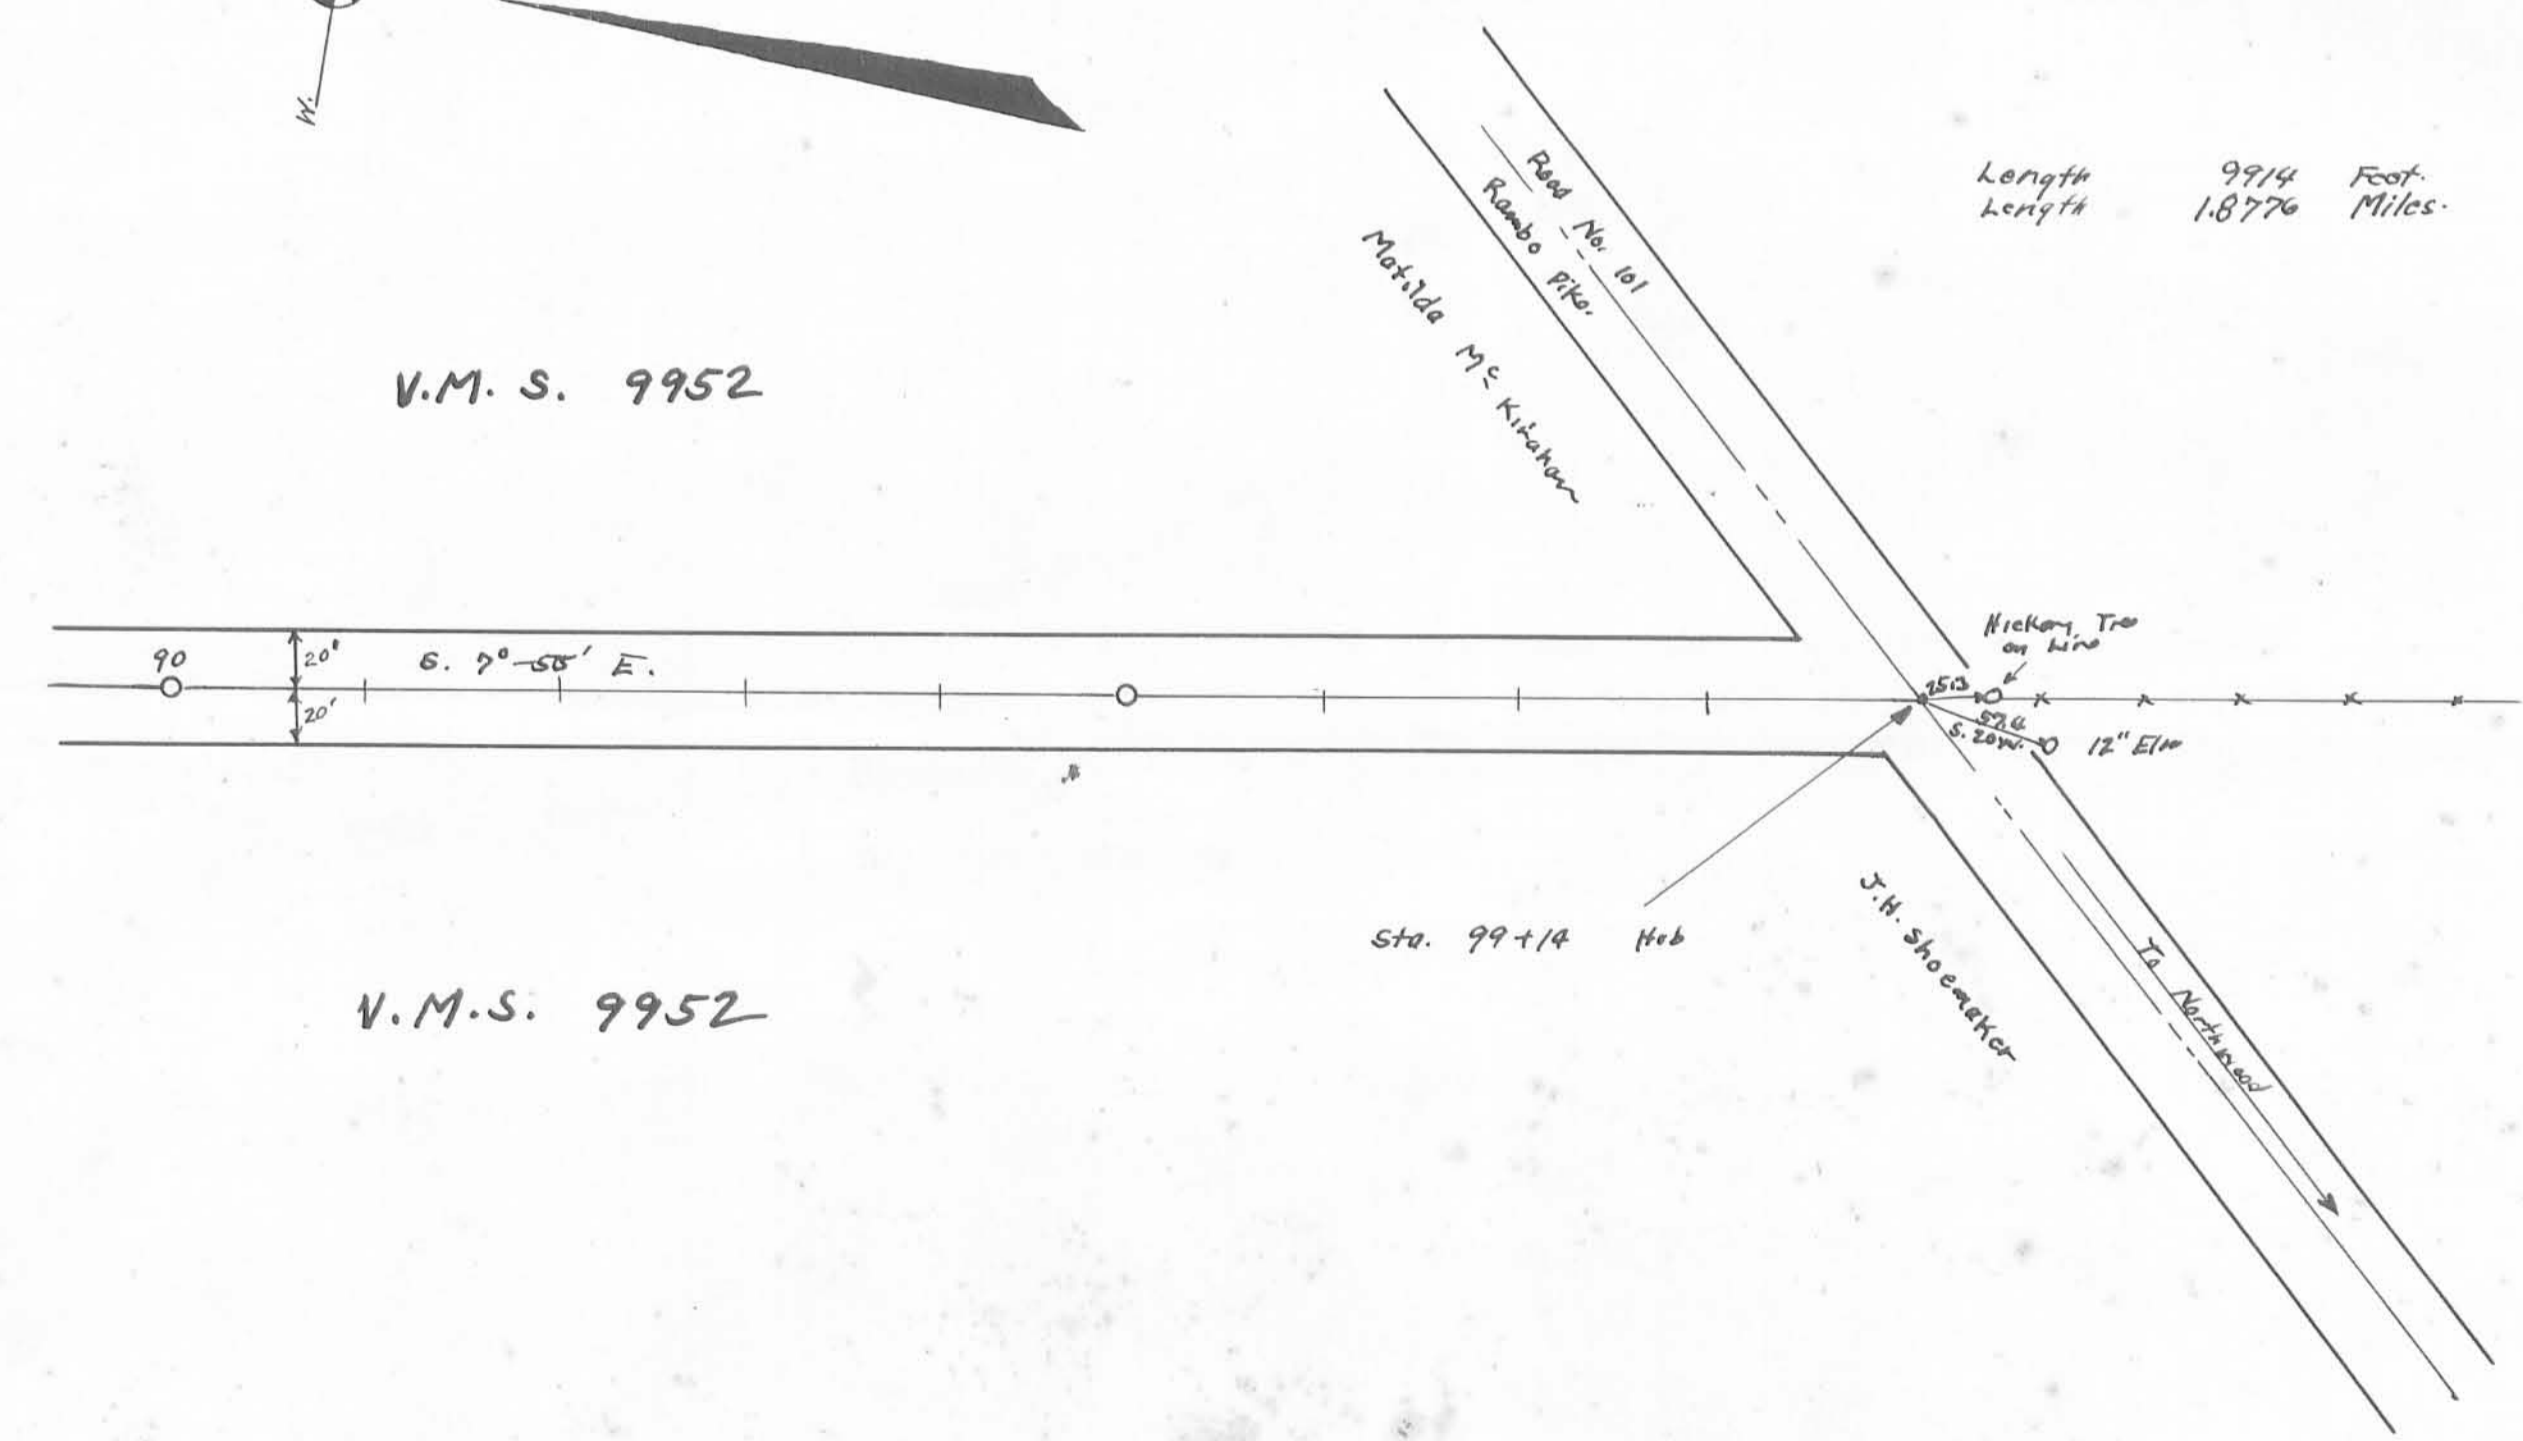

Length 9914 Feet.
 Length 1.8776 Miles.

V.M.S. 9952

V.M.S. 9952

Drawn by
 P. O. W. [unclear]