

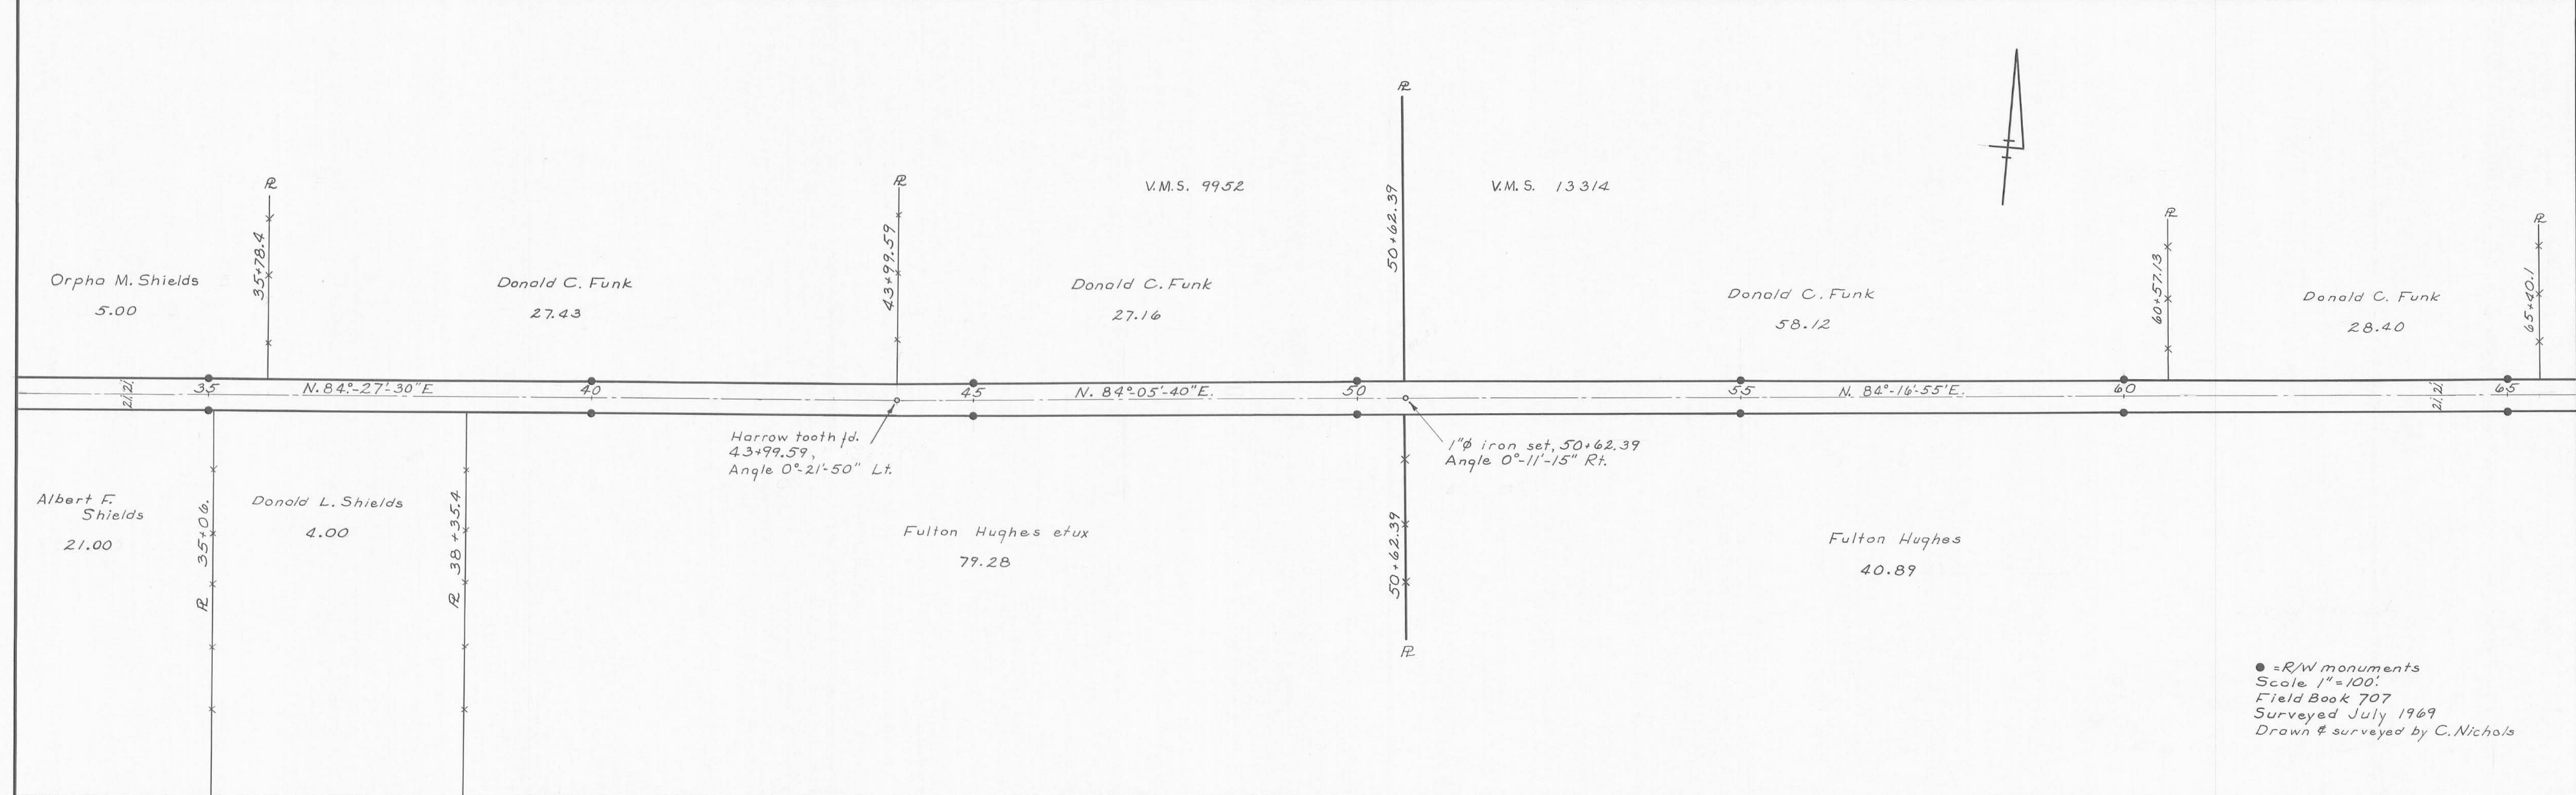


42' Right of way
 1880 Free Turnpike
 Record 5, page 554

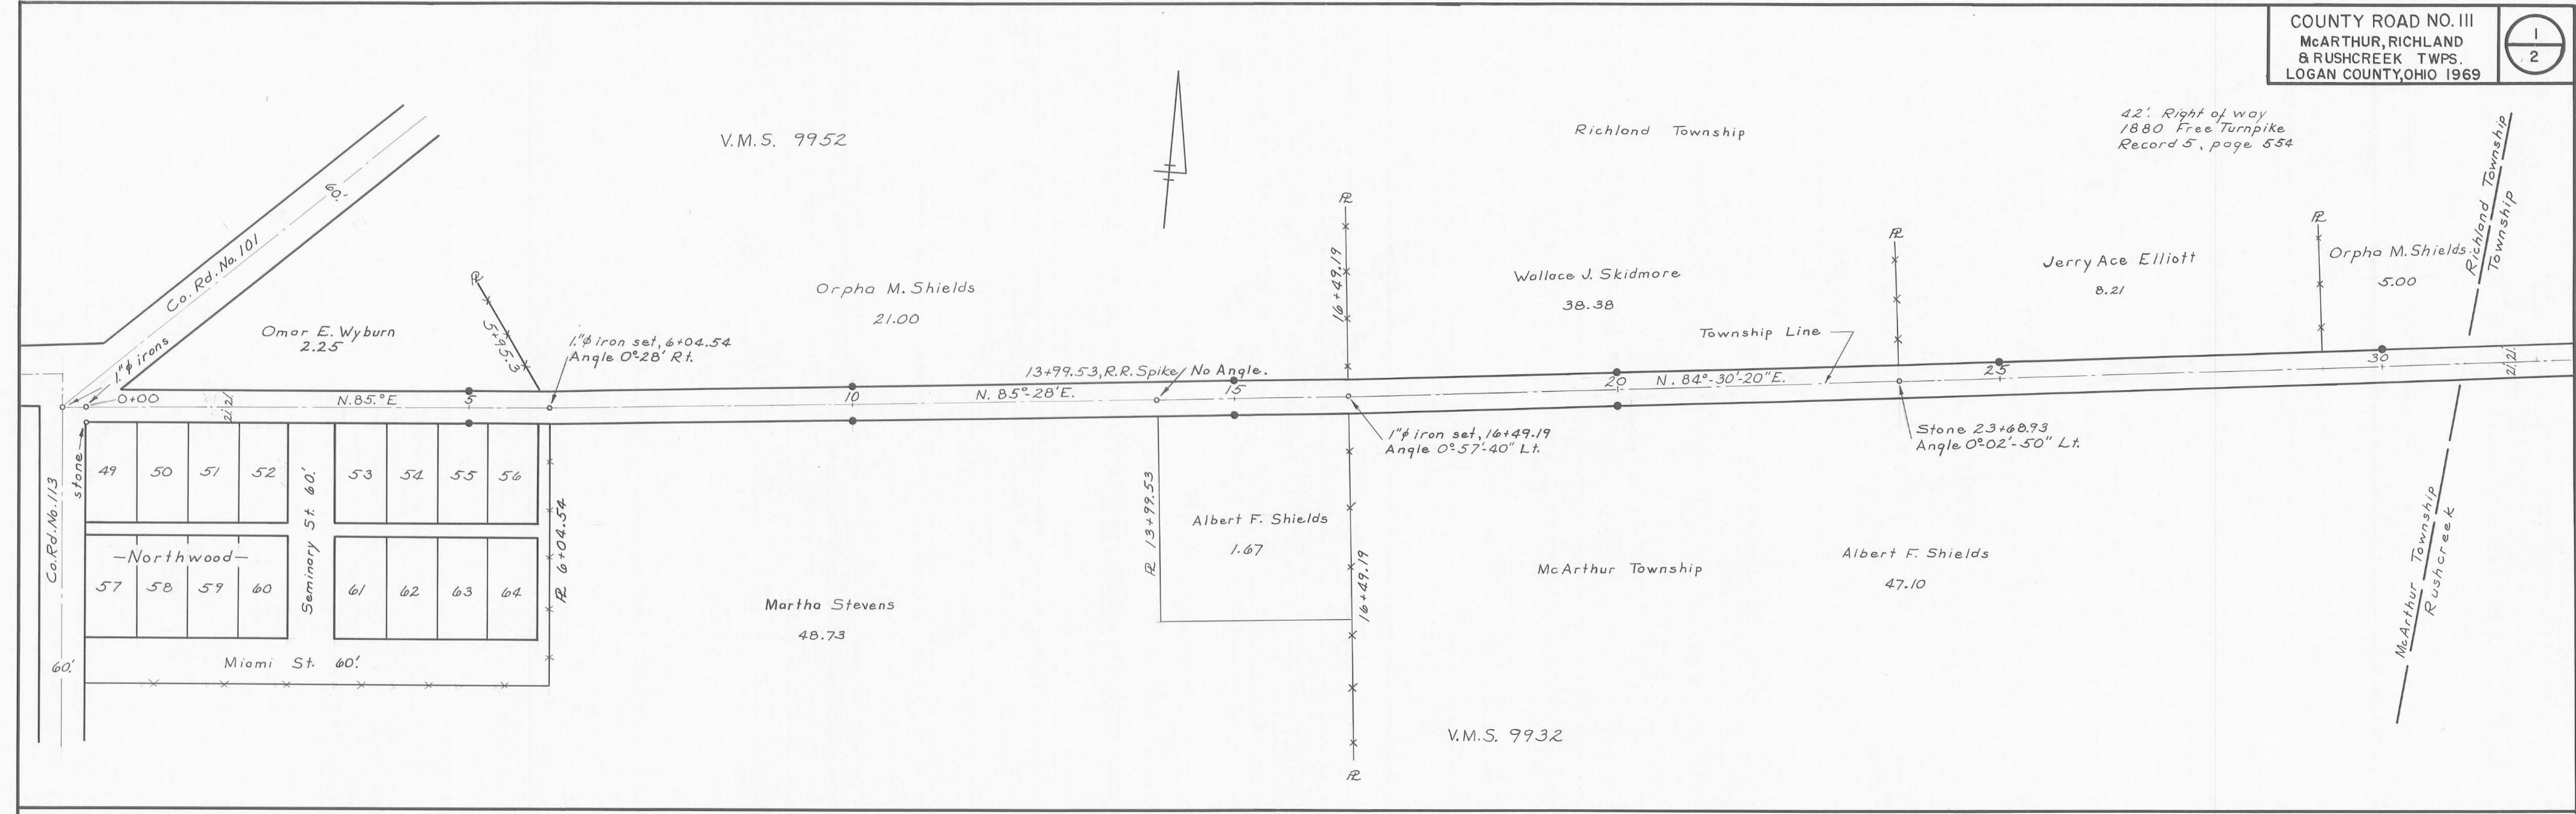

● = R/W monuments
 Scale 1" = 100'
 Field Book 707
 Surveyed July 1969
 Drawn & surveyed by C. Nichols

50' Right of way
 1890 Free Turnpike Record B,
 page 215.

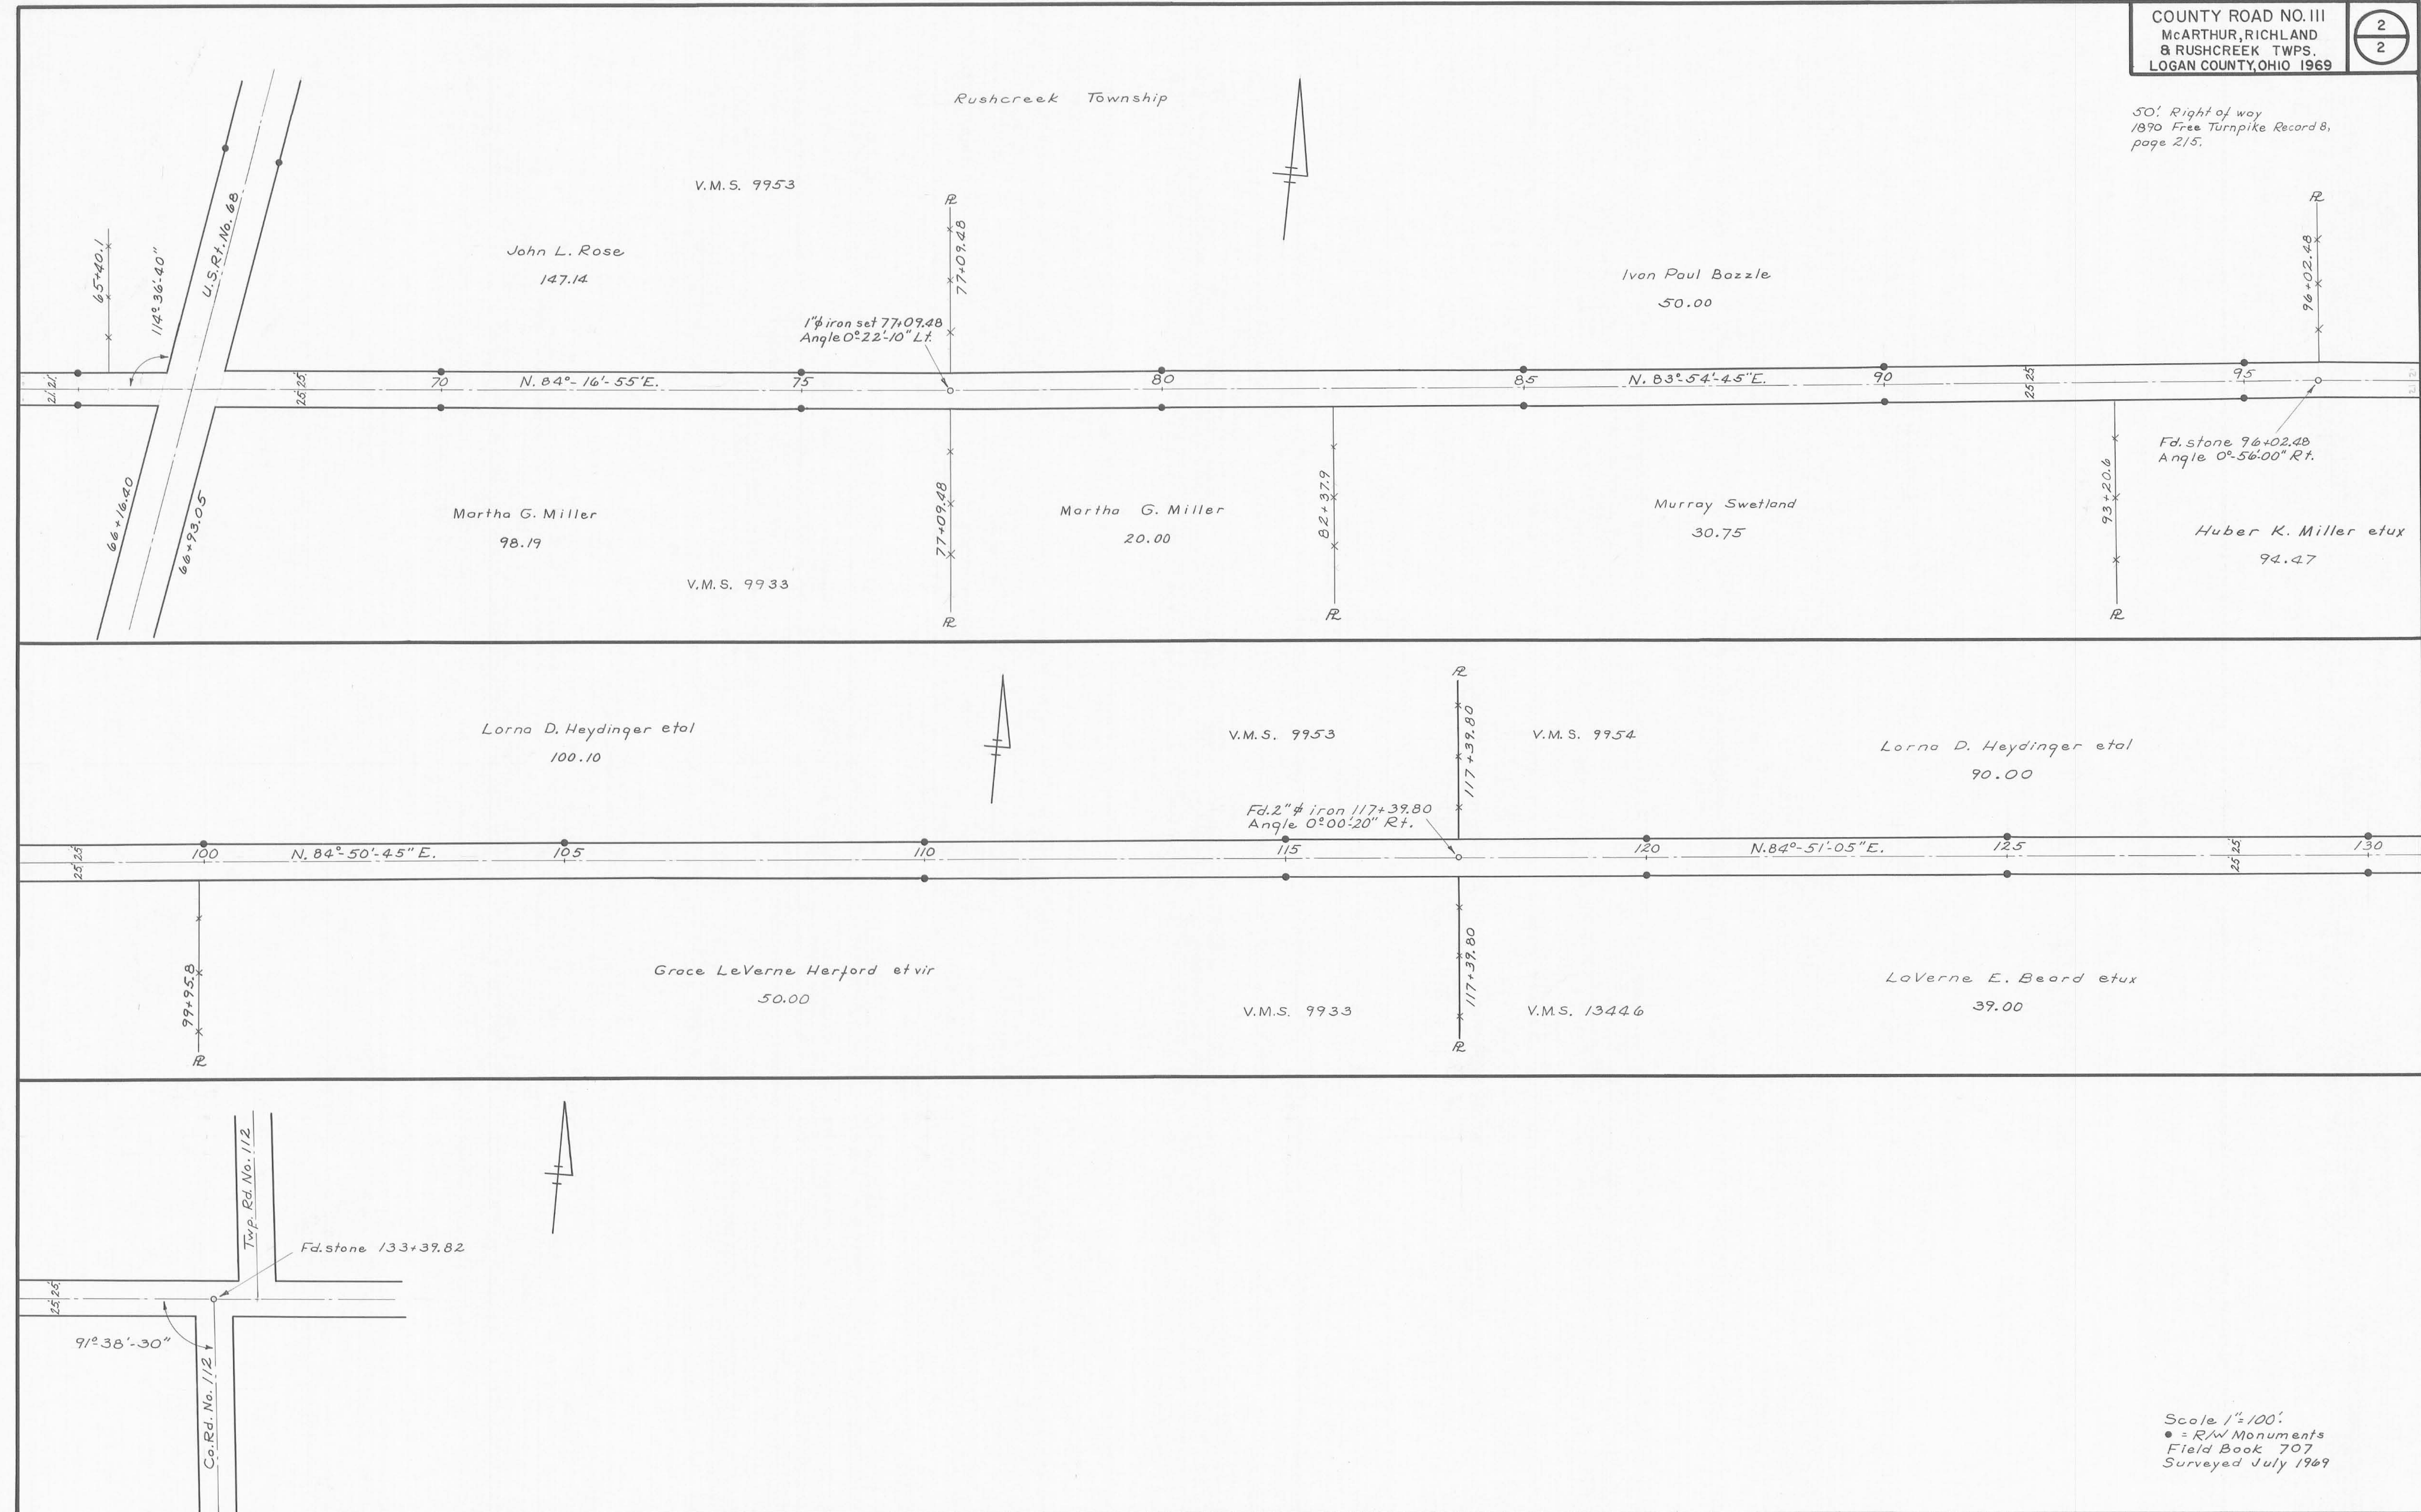

Scale 1"=100'
 • = R/W Monuments
 Field Book 707
 Surveyed July 1969