
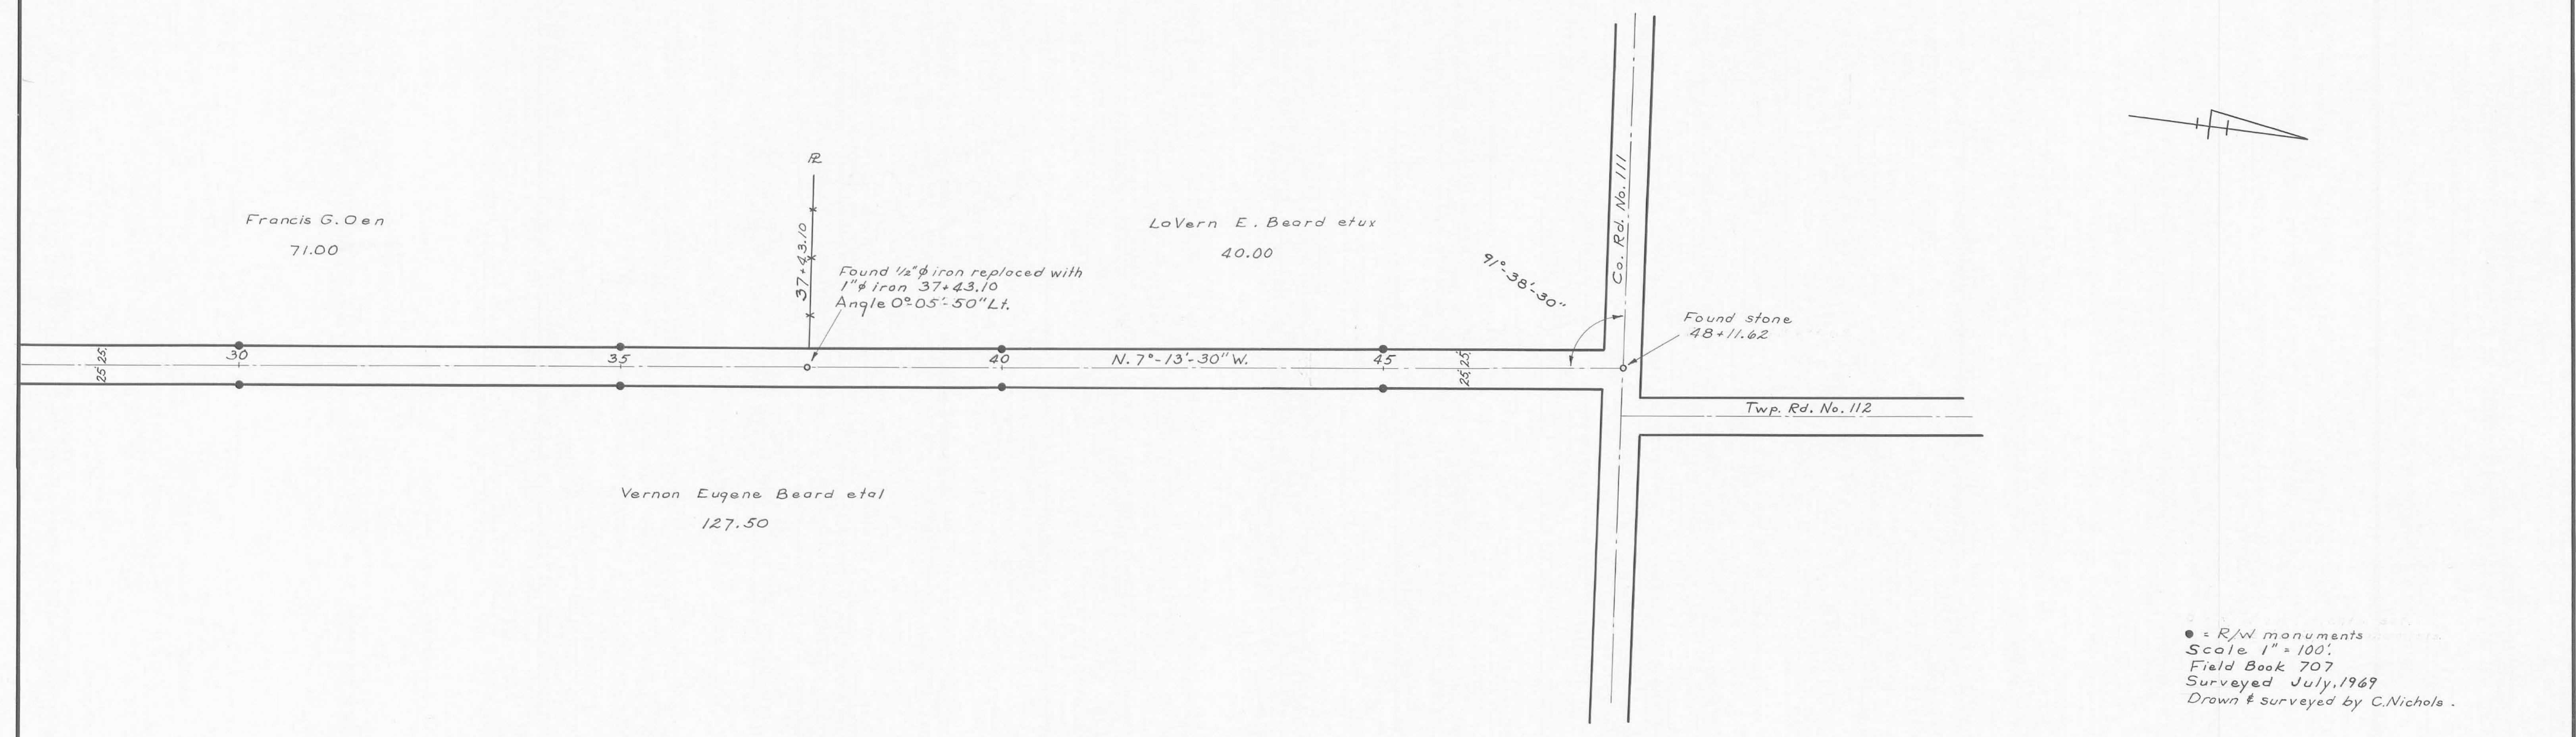


50' Right of Way
 1890 Free Turnpike Record B,
 page 215.

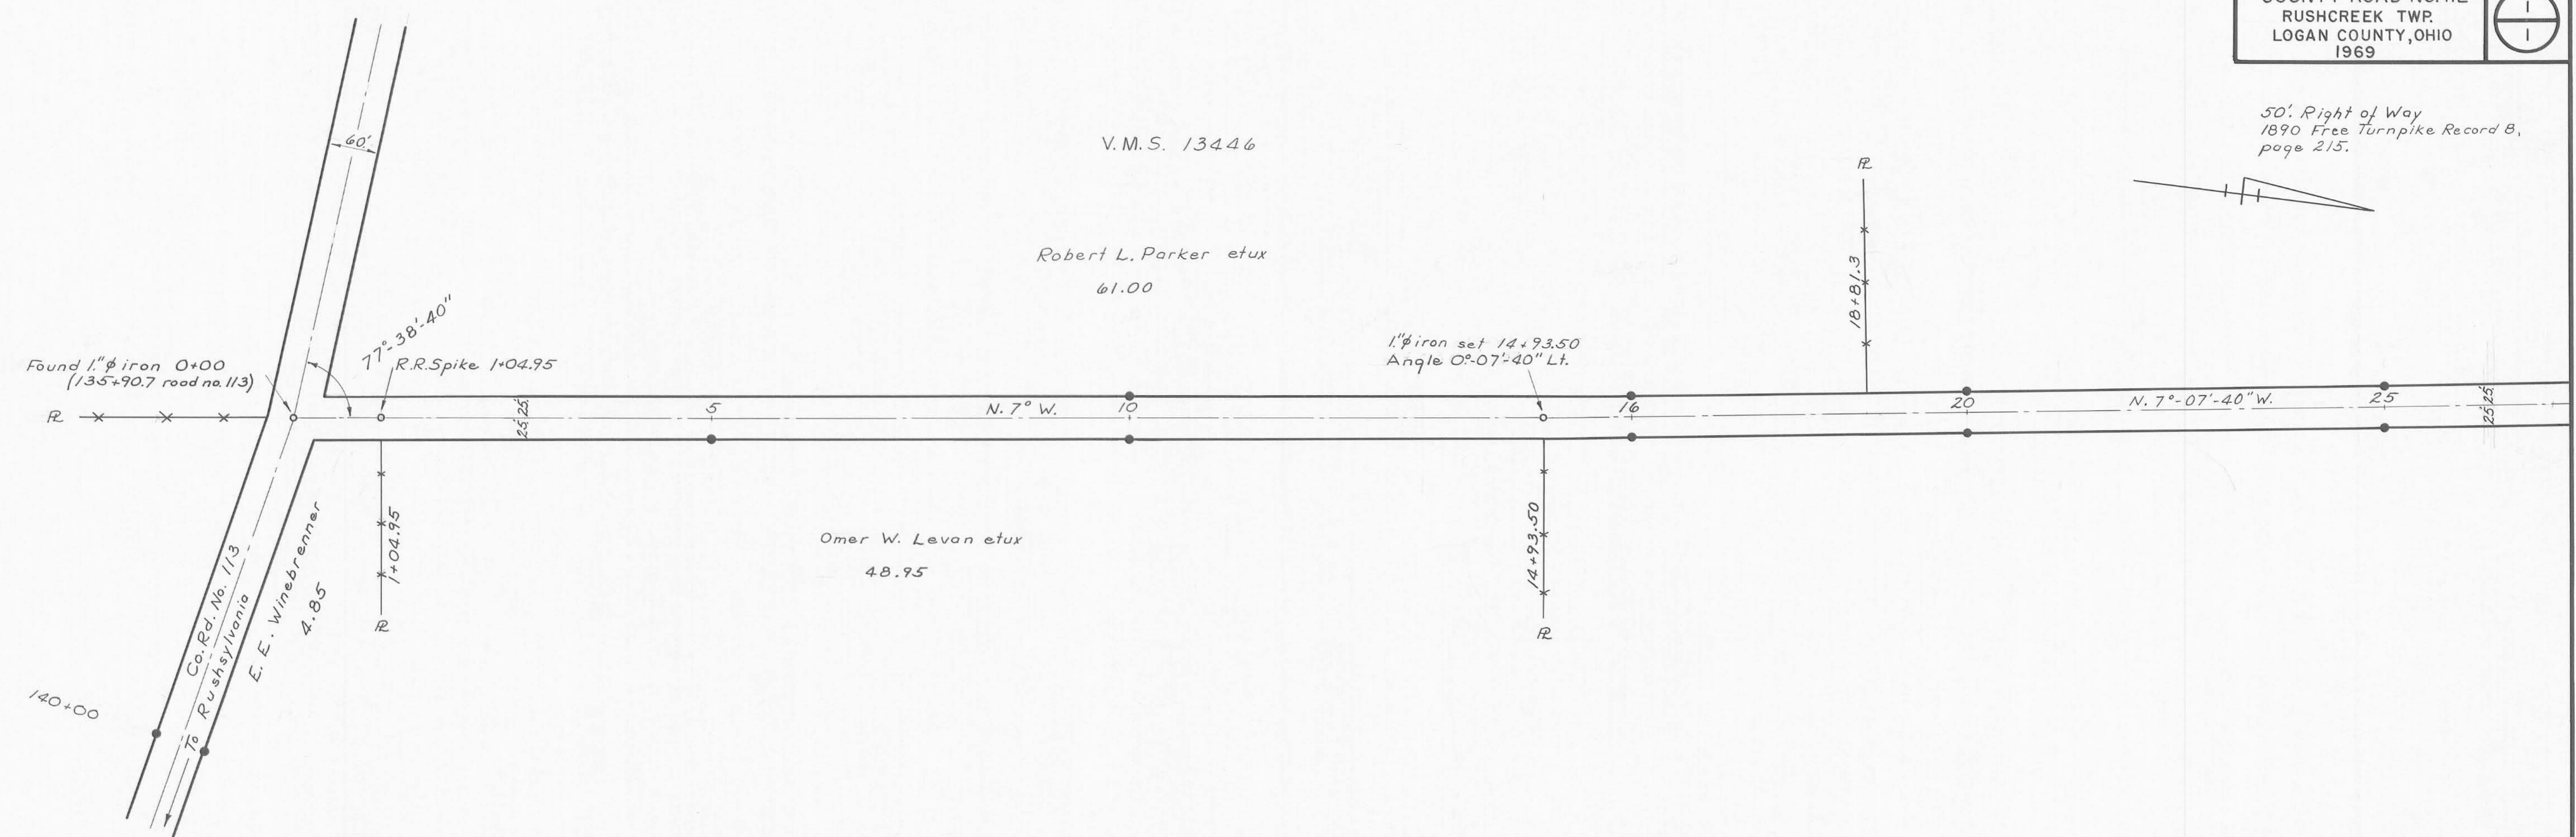

● = R/W monuments
 Scale 1" = 100'
 Field Book 707
 Surveyed July, 1969
 Drawn & surveyed by C. Nichols.