



● Indicates Concrete Right-of-Way Posts

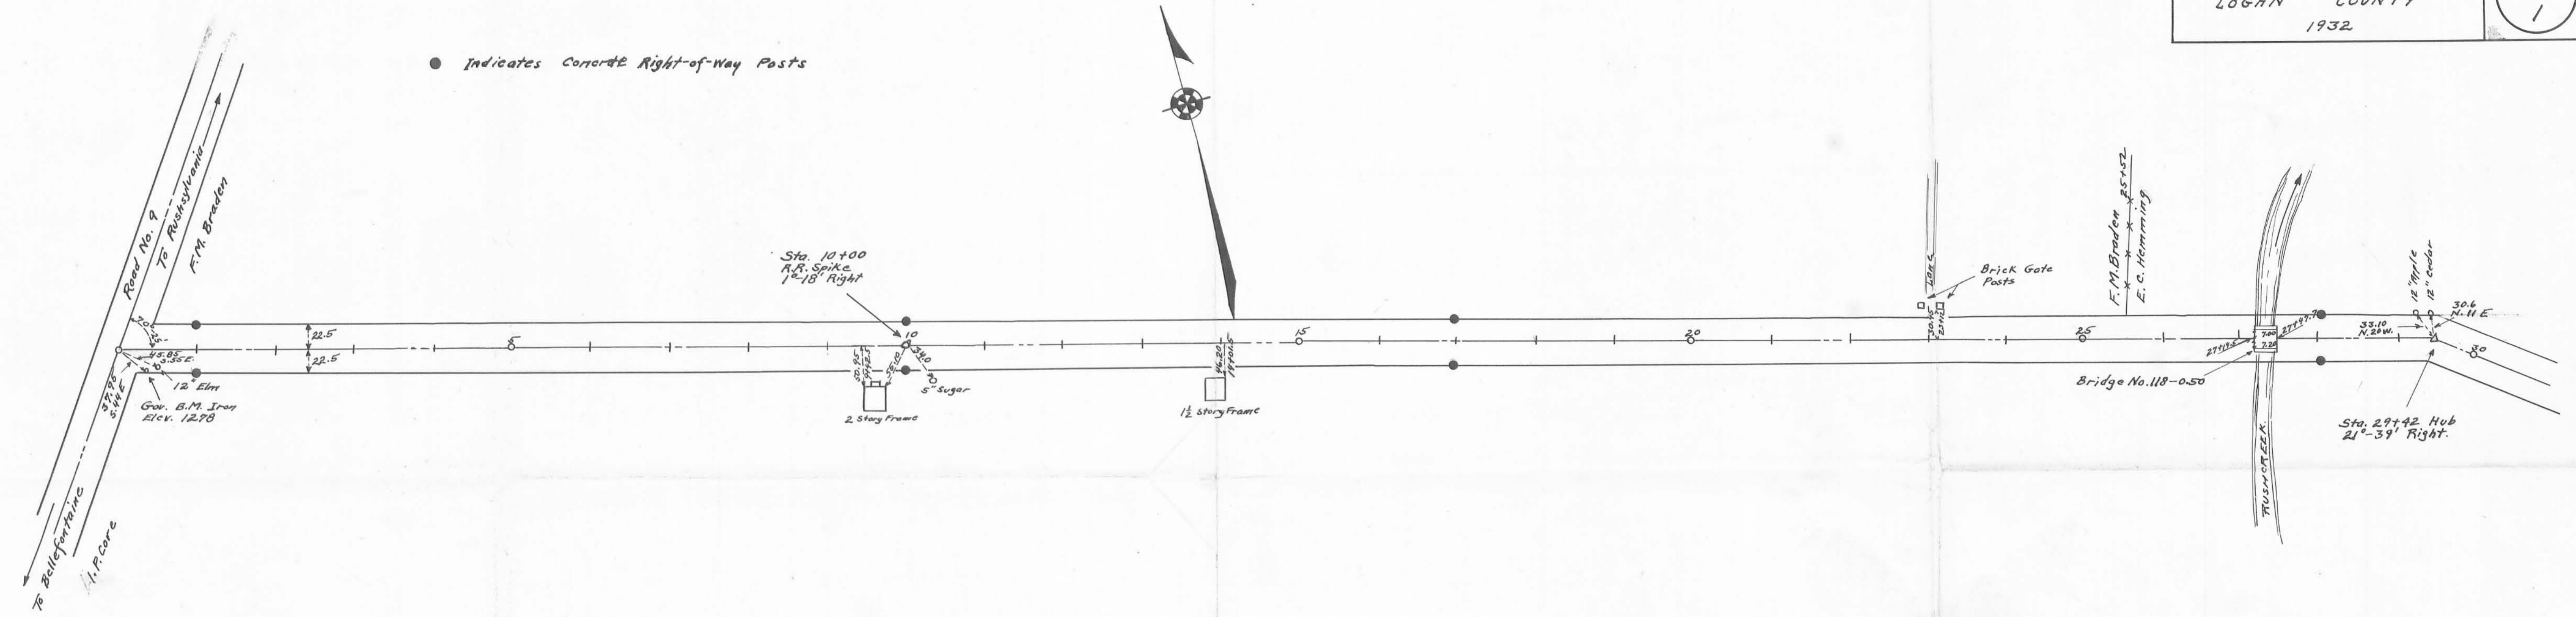

Field Notes in Logan County  
Surveyors Book No. 580 Page 57  
Pugh road See Commissioners Journal  
Vol. 11 Page 209, 75' Road 9 to Road 20  
Remains 40'

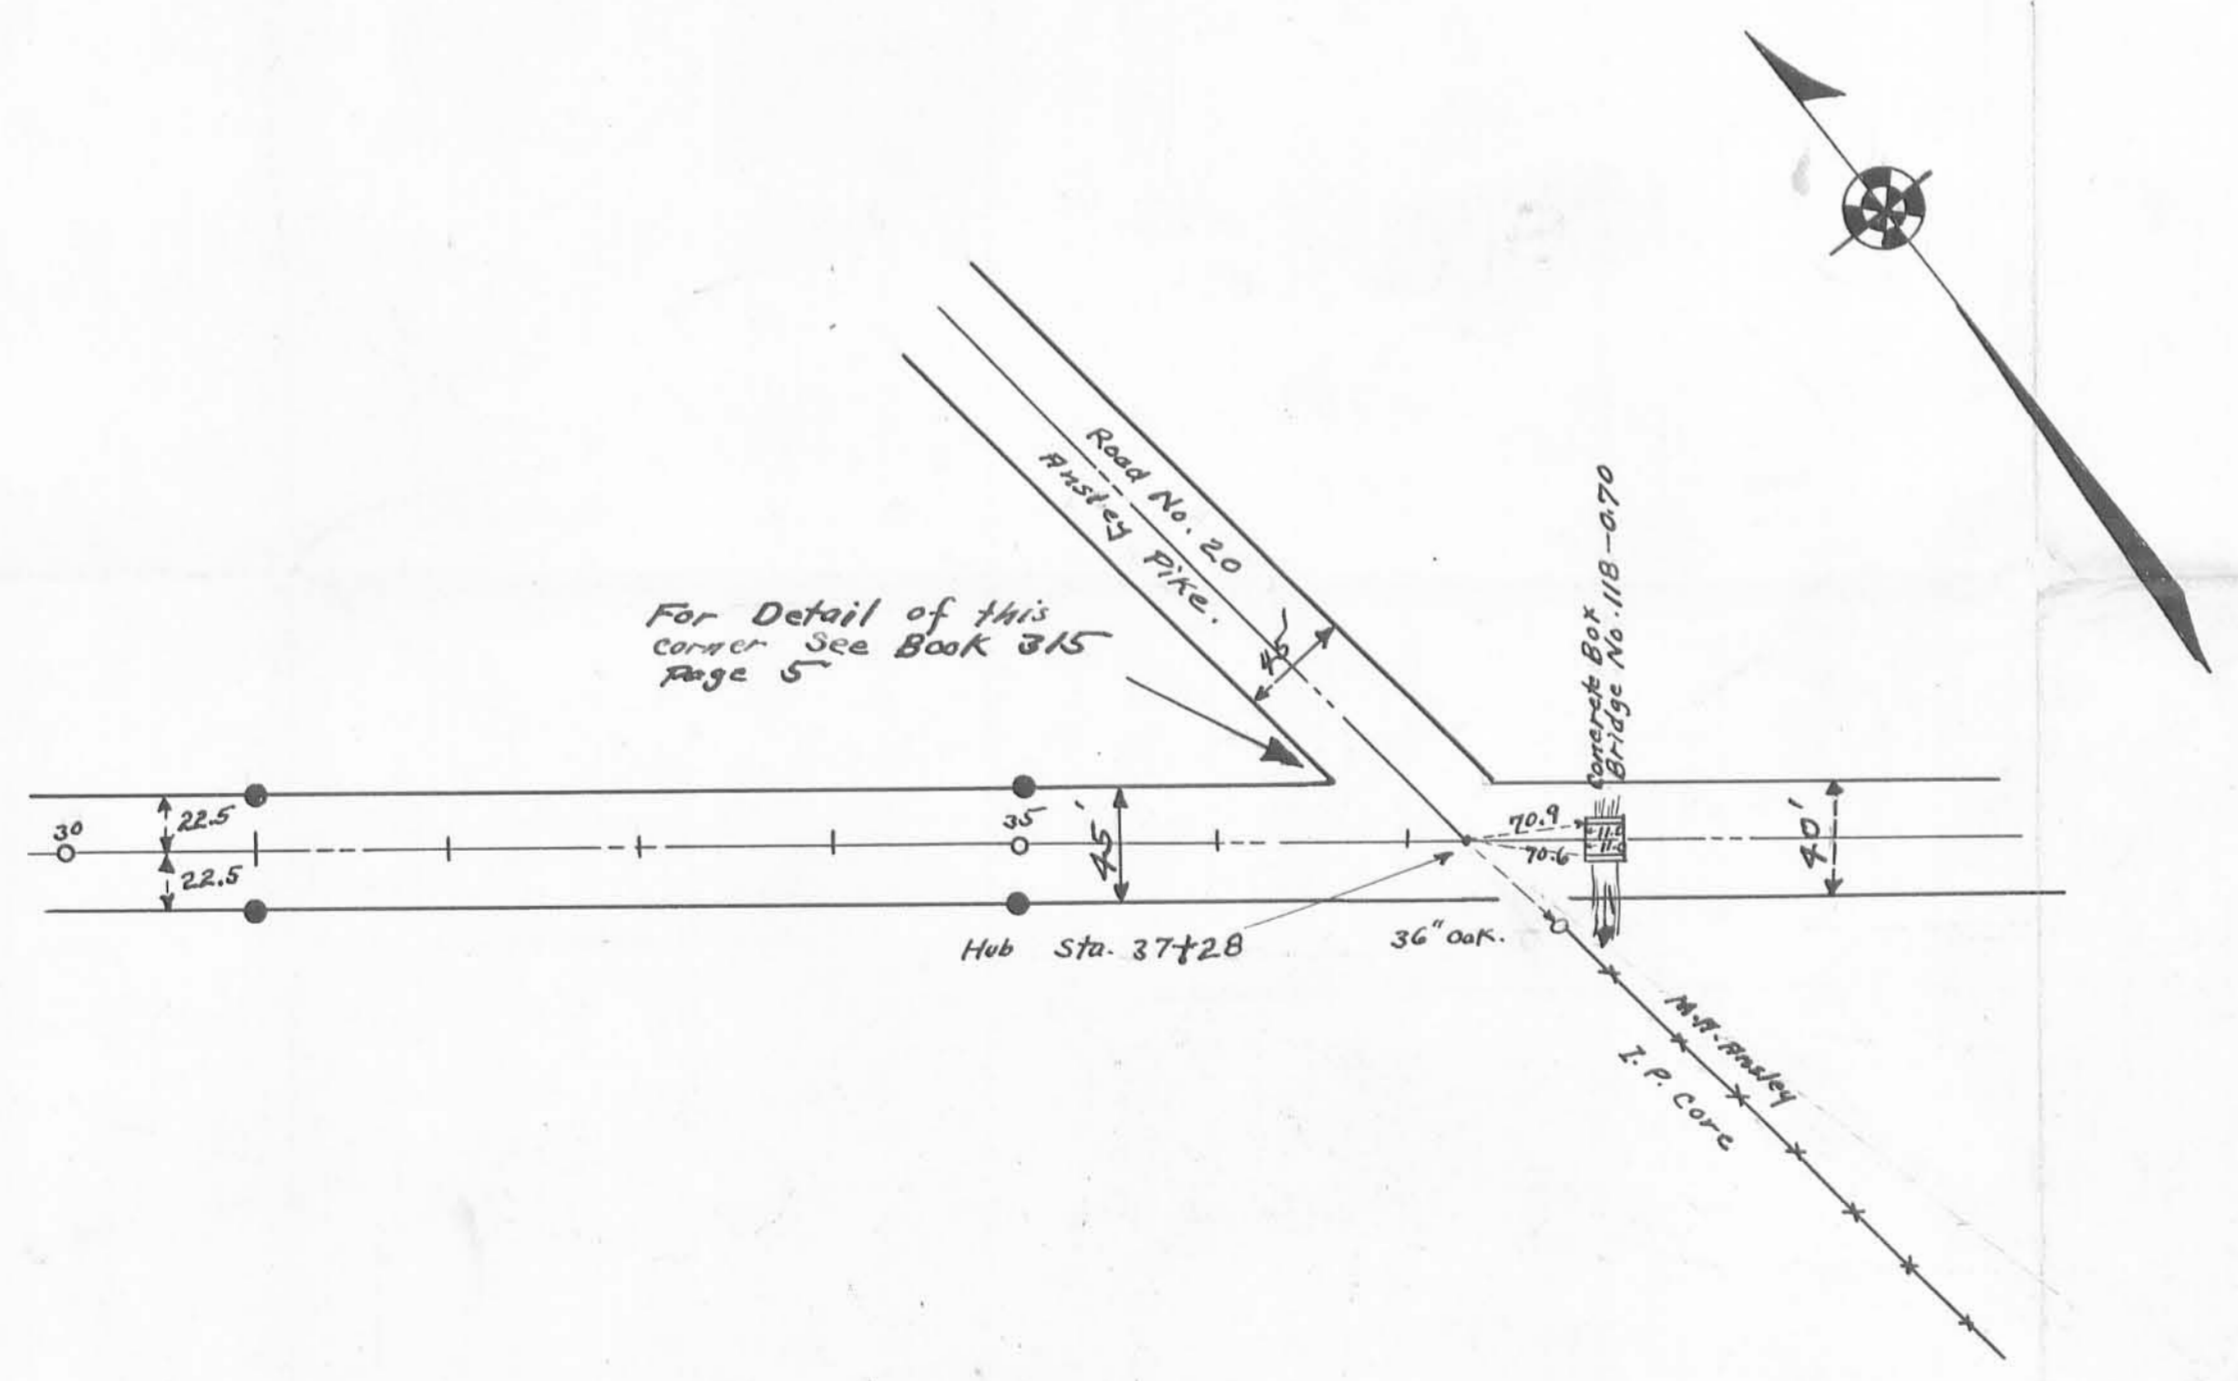

For Detail of this  
corner See Book 315  
Page 5