


JEFFERSON TOWNSHIP INDEX MAP

Scale: 1 inch = 1/2 mile

RED FIGURES REFER TO PAGES

Corrected to
April-12-92


RUSHCREEK TP.

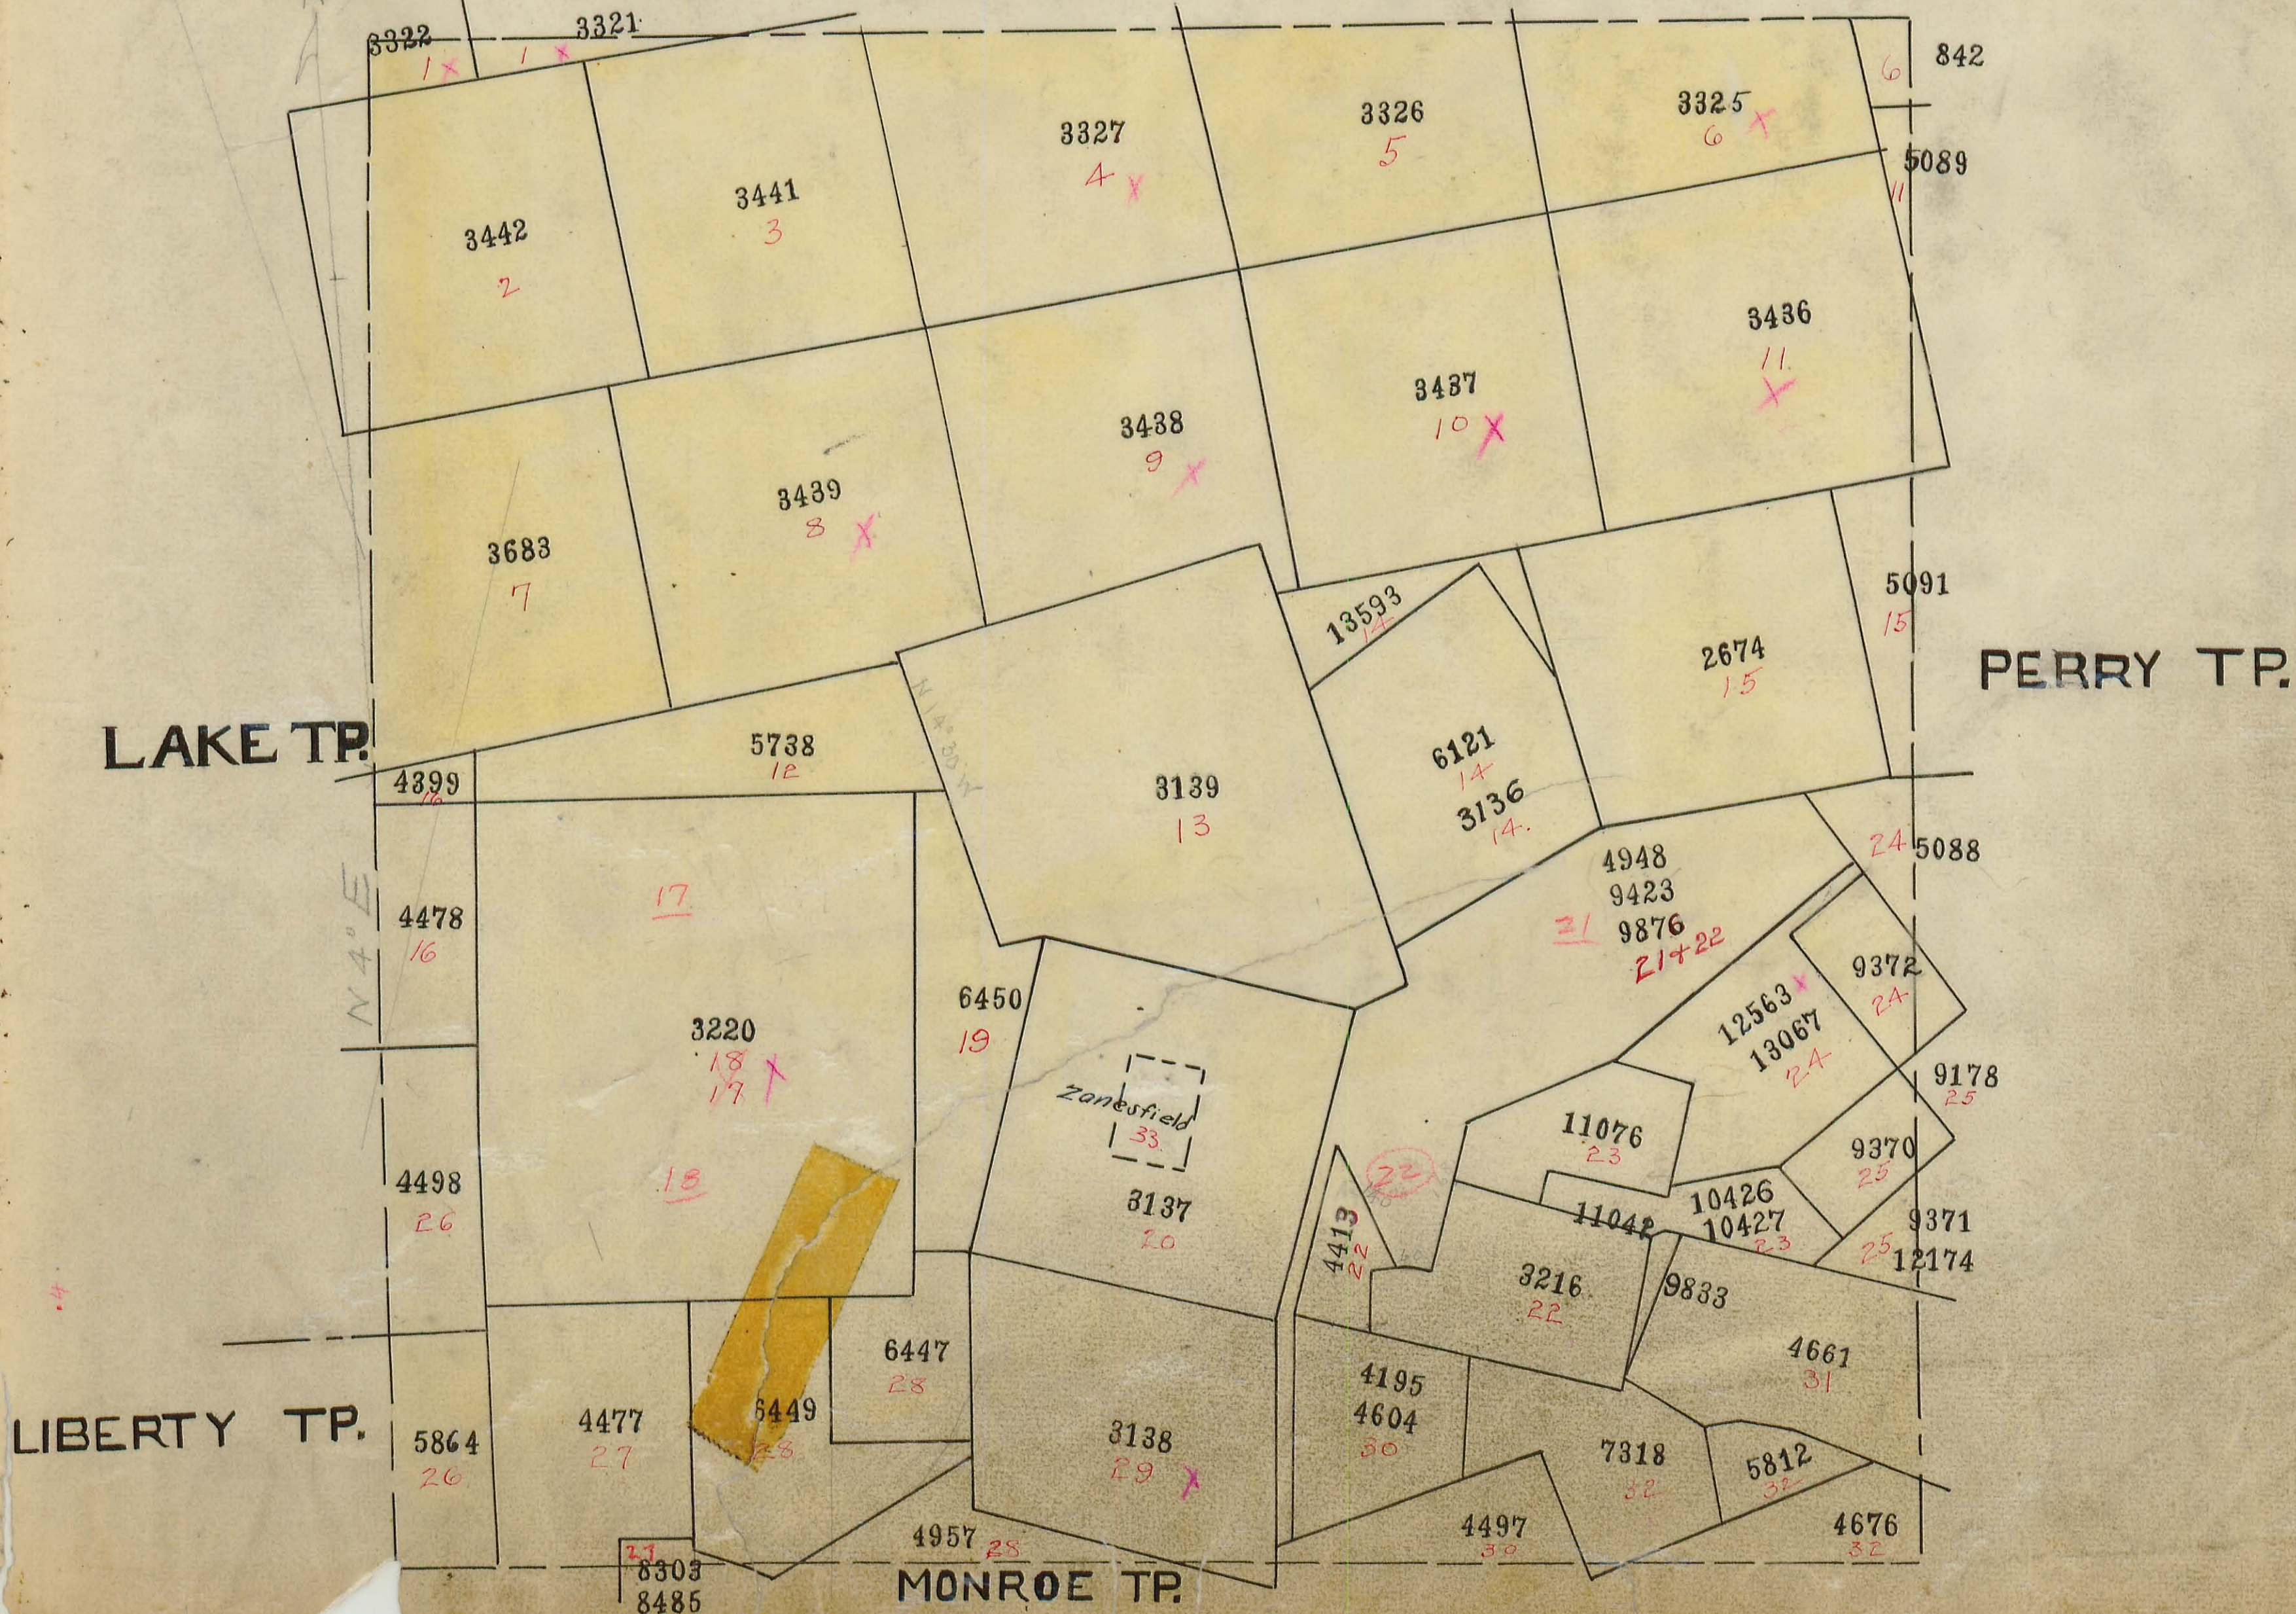

JEFFERSON TOWNSHIP.

Plat of Virginia Military Survey No. ³³²¹ 3322


Scale: 1 inch = 10 chains.

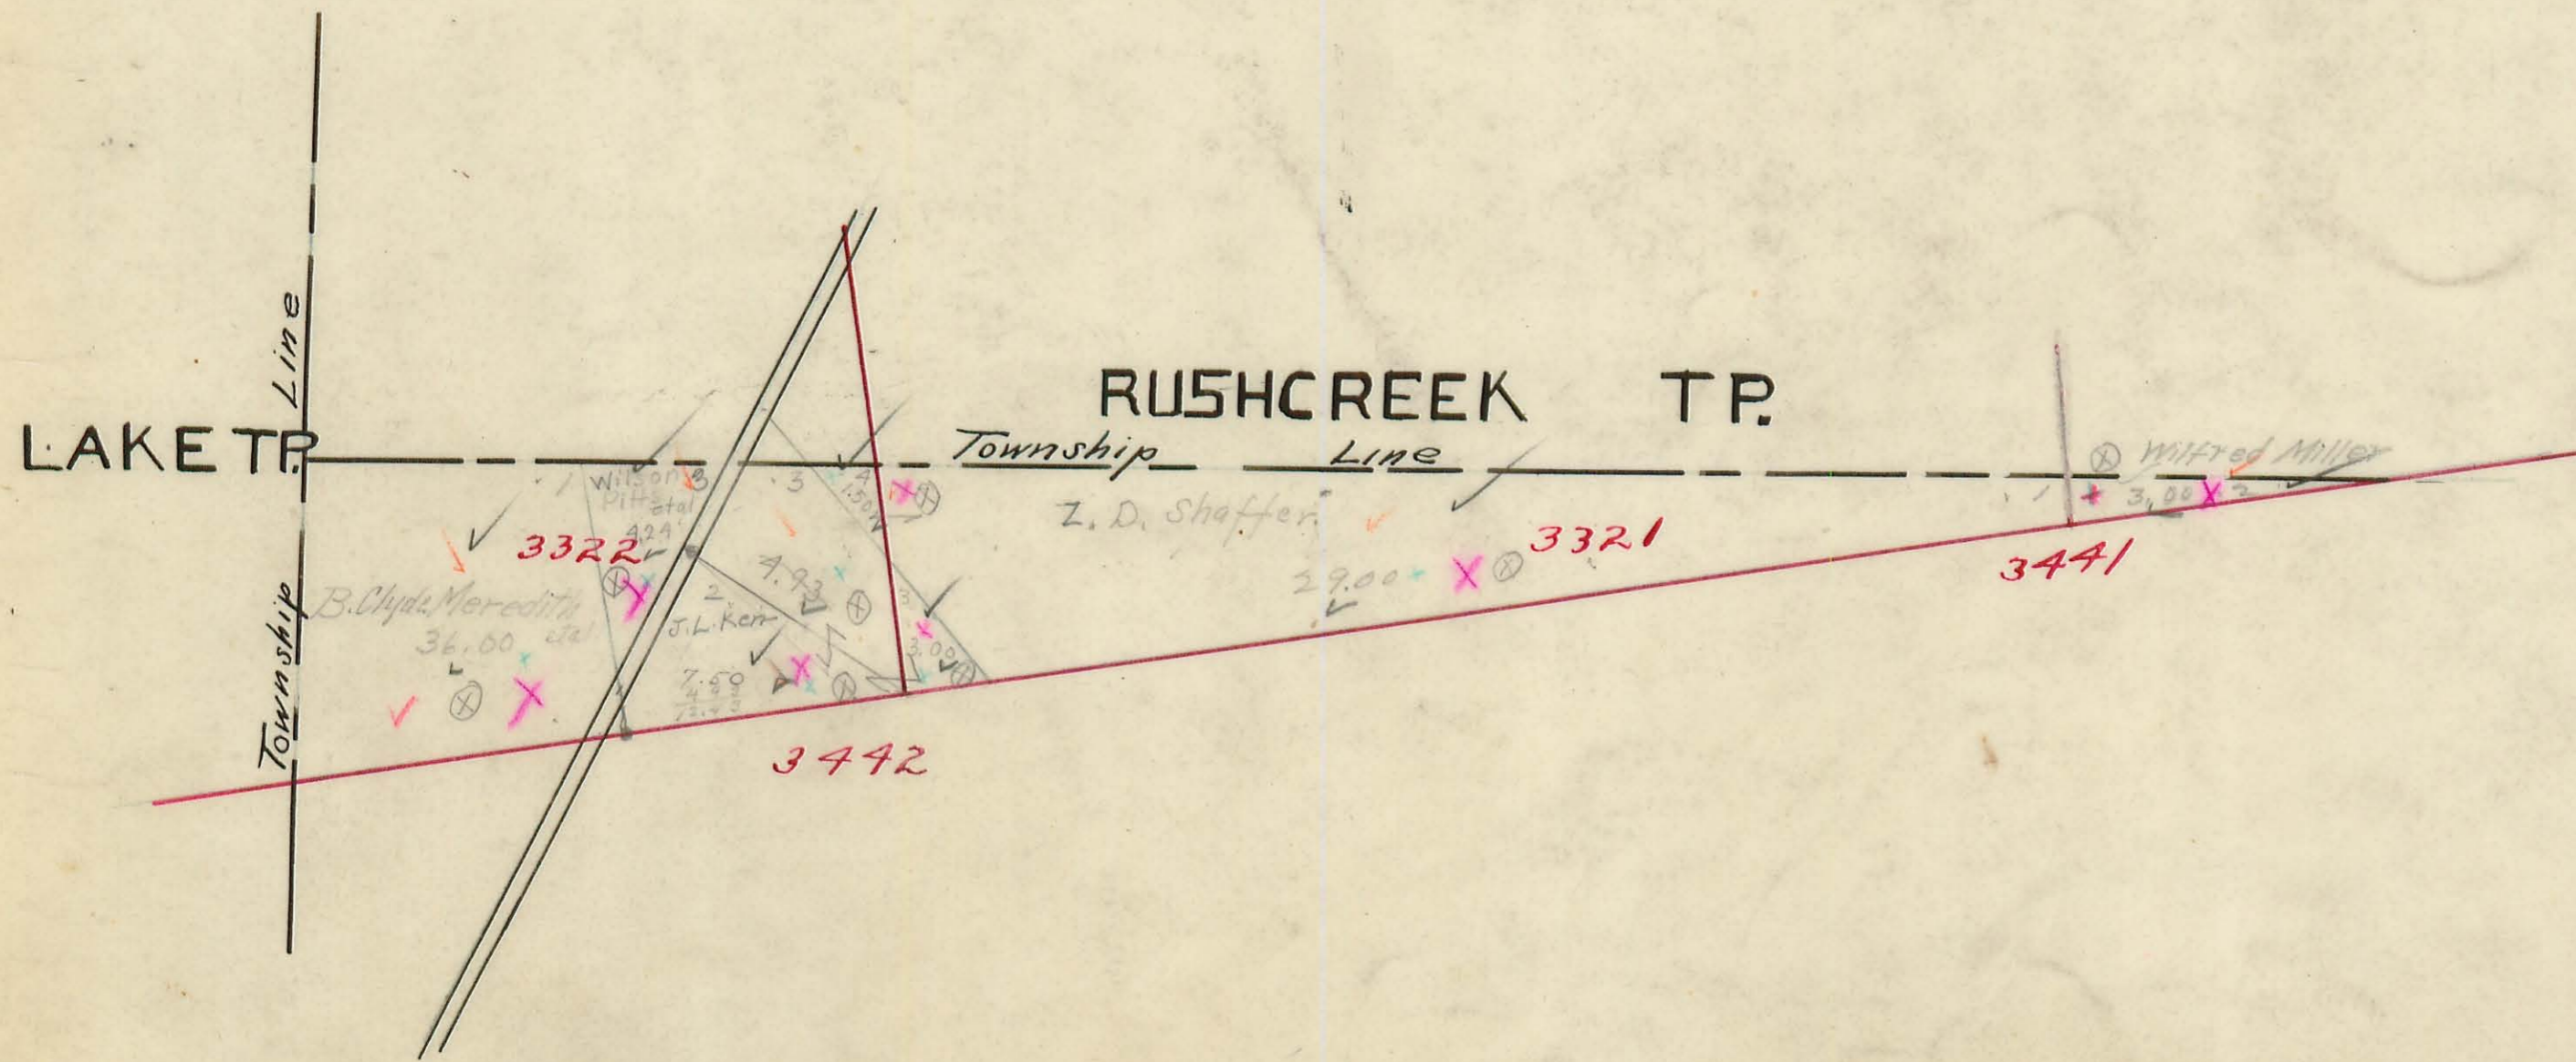

JEFFERSON TOWNSHIP.

Plat of Virginia Military Survey No. 3442

Scale: 1 inch = 10 chains.

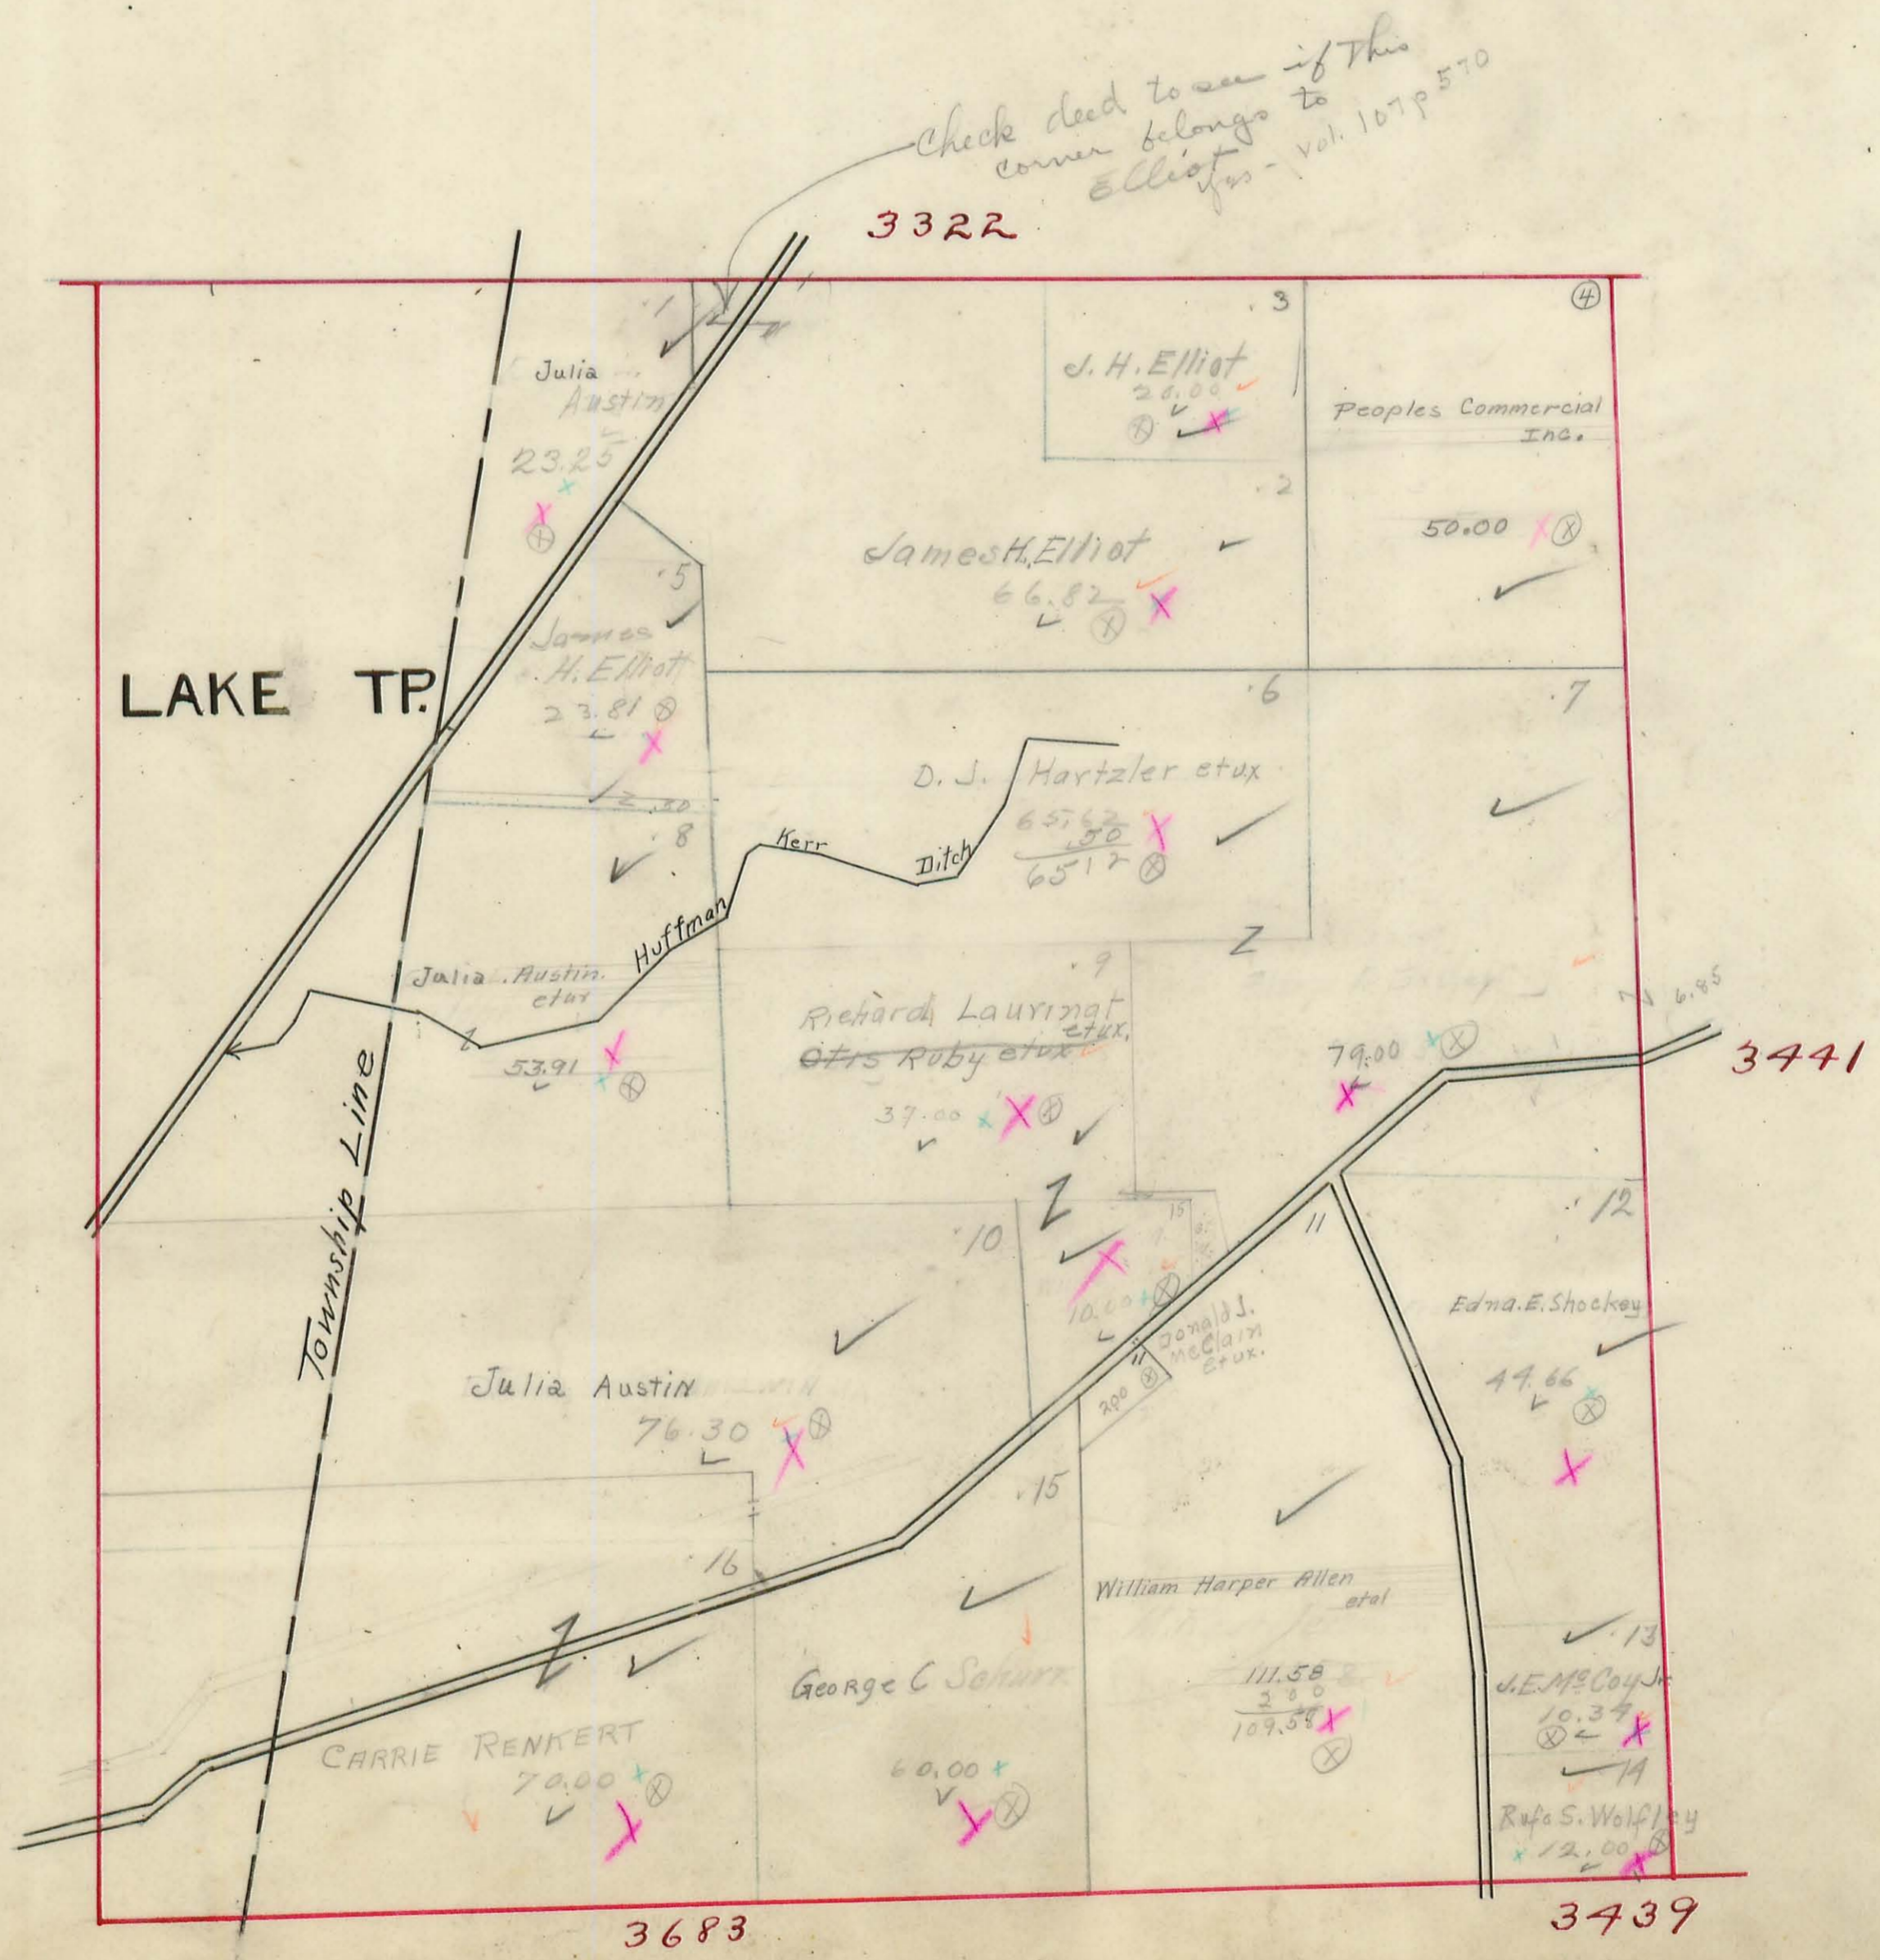


JEFFERSON TOWNSHIP.

Plat of Virginia Military Survey No. 3441

Scale: 1 inch = 10 chains.

RUSHCREEK TP.

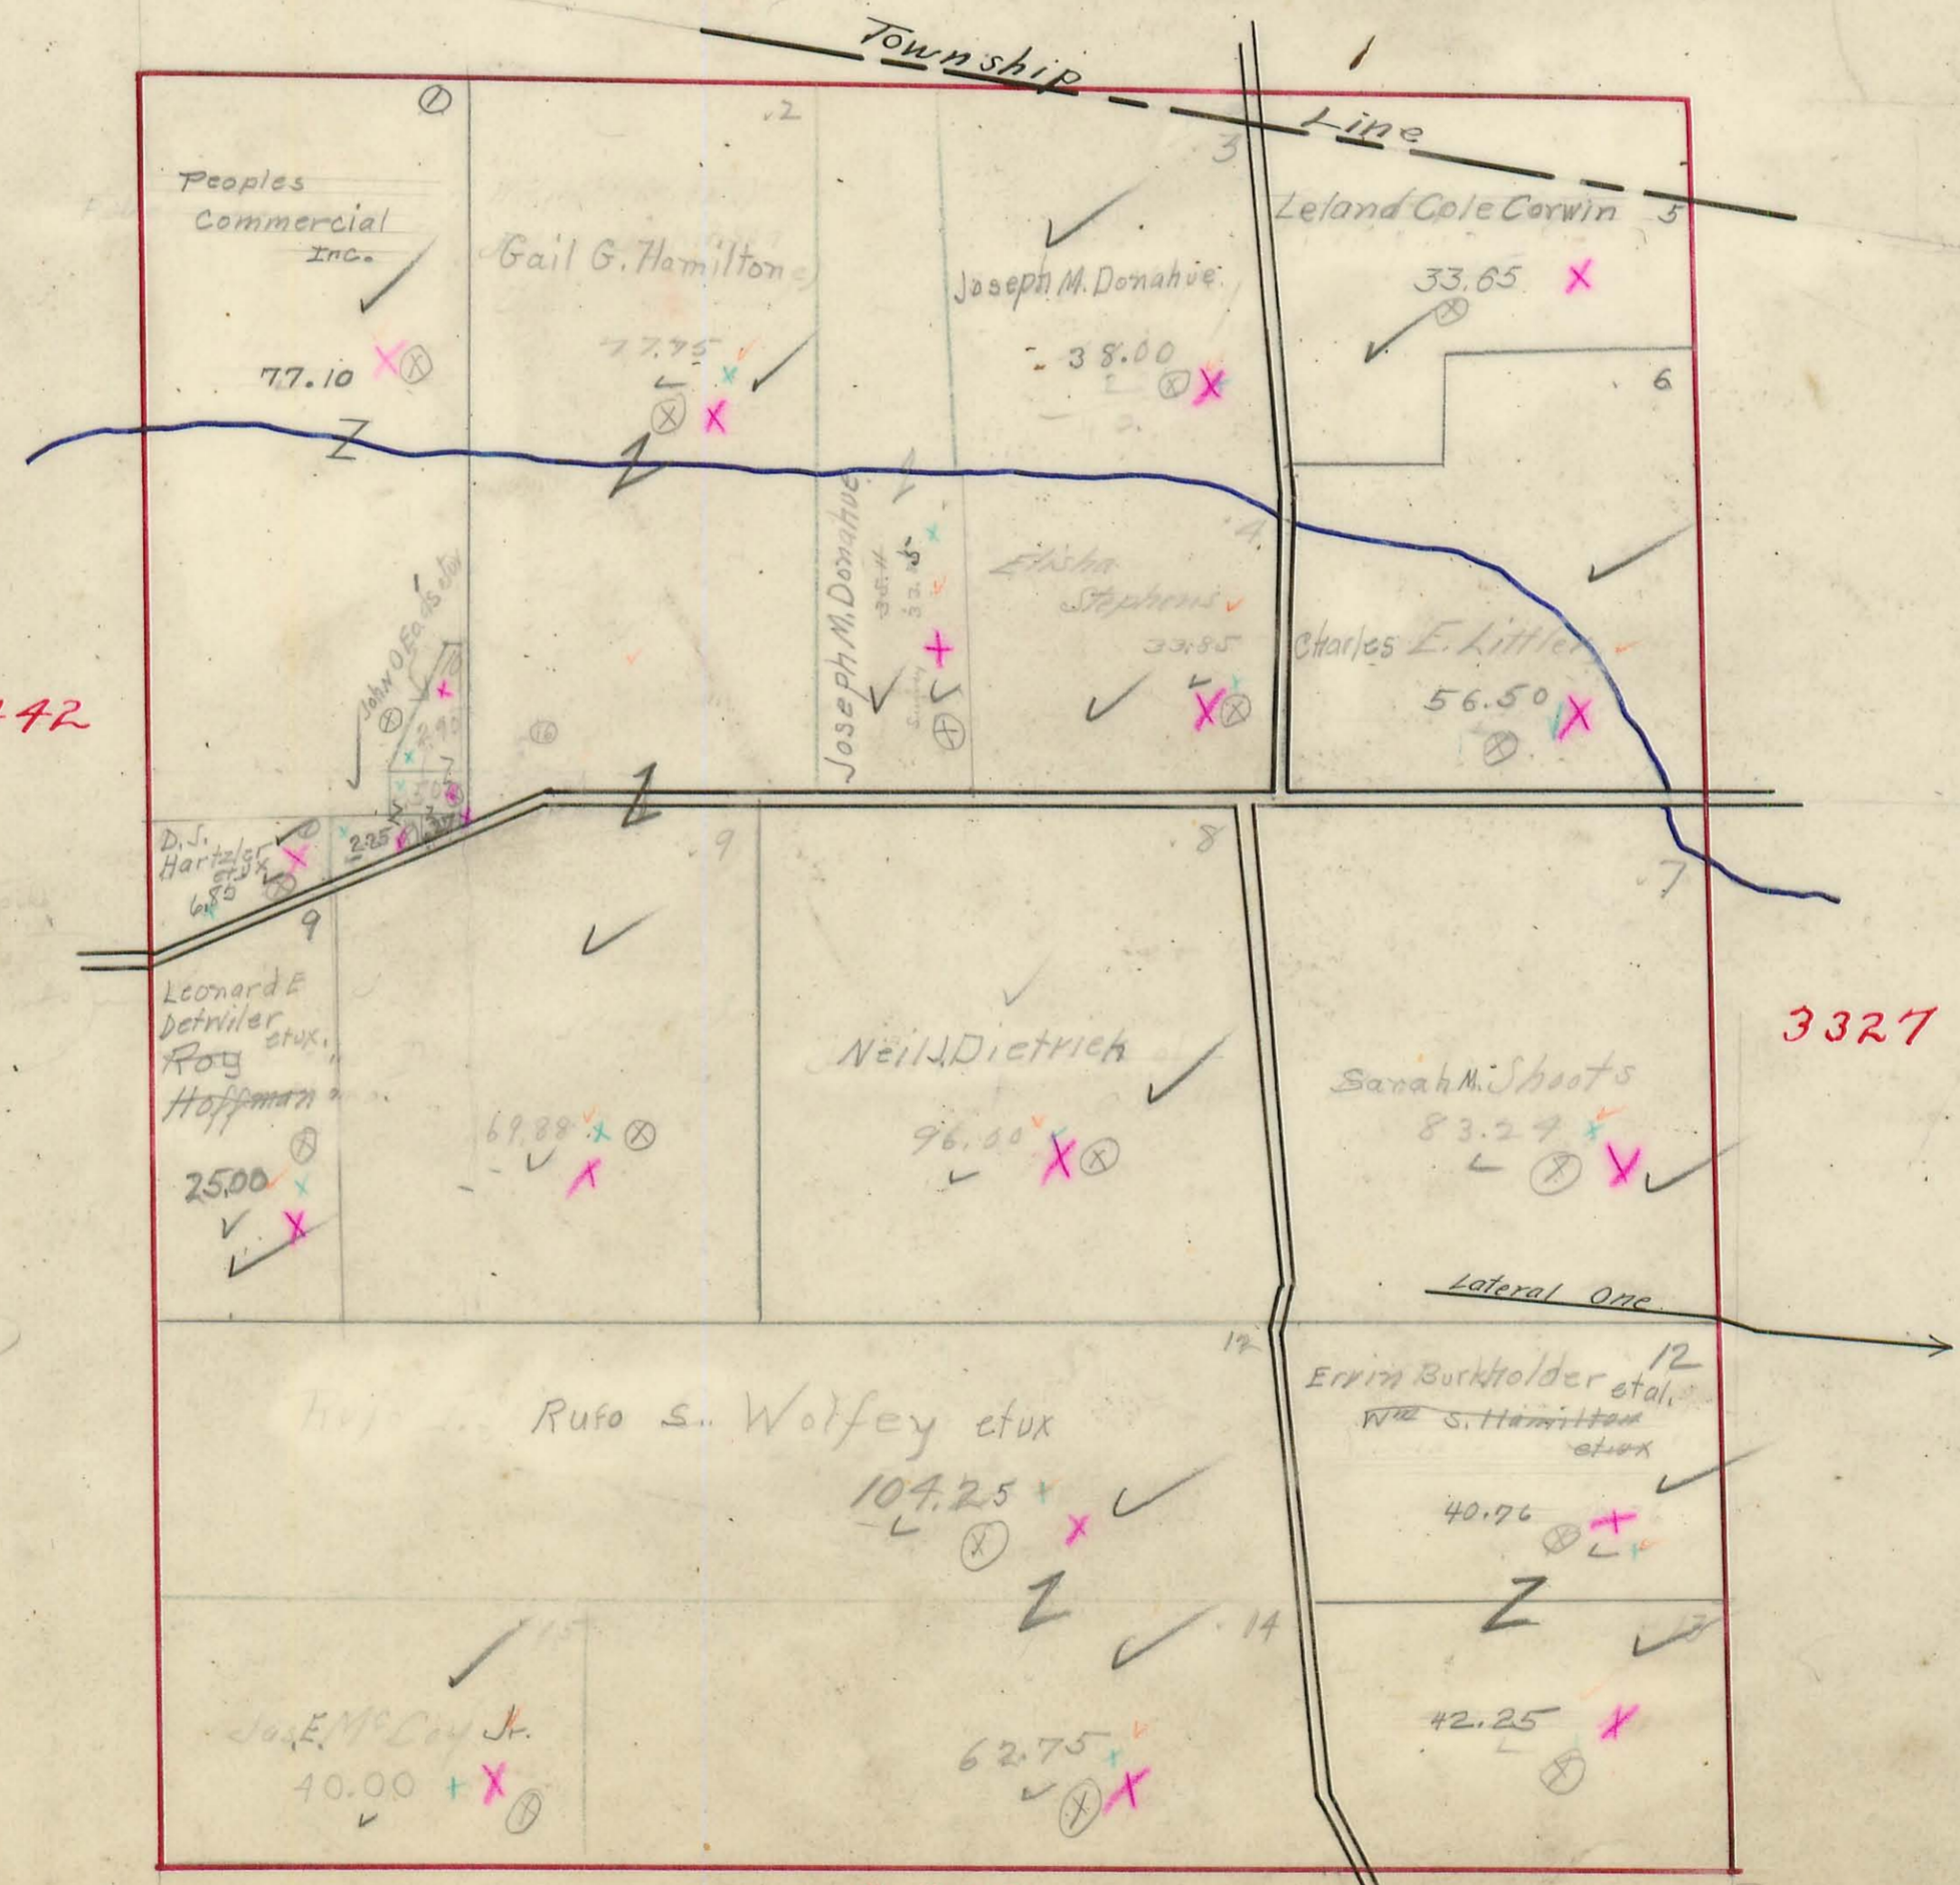

3442

3327

3439

662
83
462
495

290
83
27
425
583


165
495
23
623

16
20
24
25

JEFFERSON TOWNSHIP.

Plat of Virginia Military Survey No. 3326

Scale: 1 inch = 10 chains.

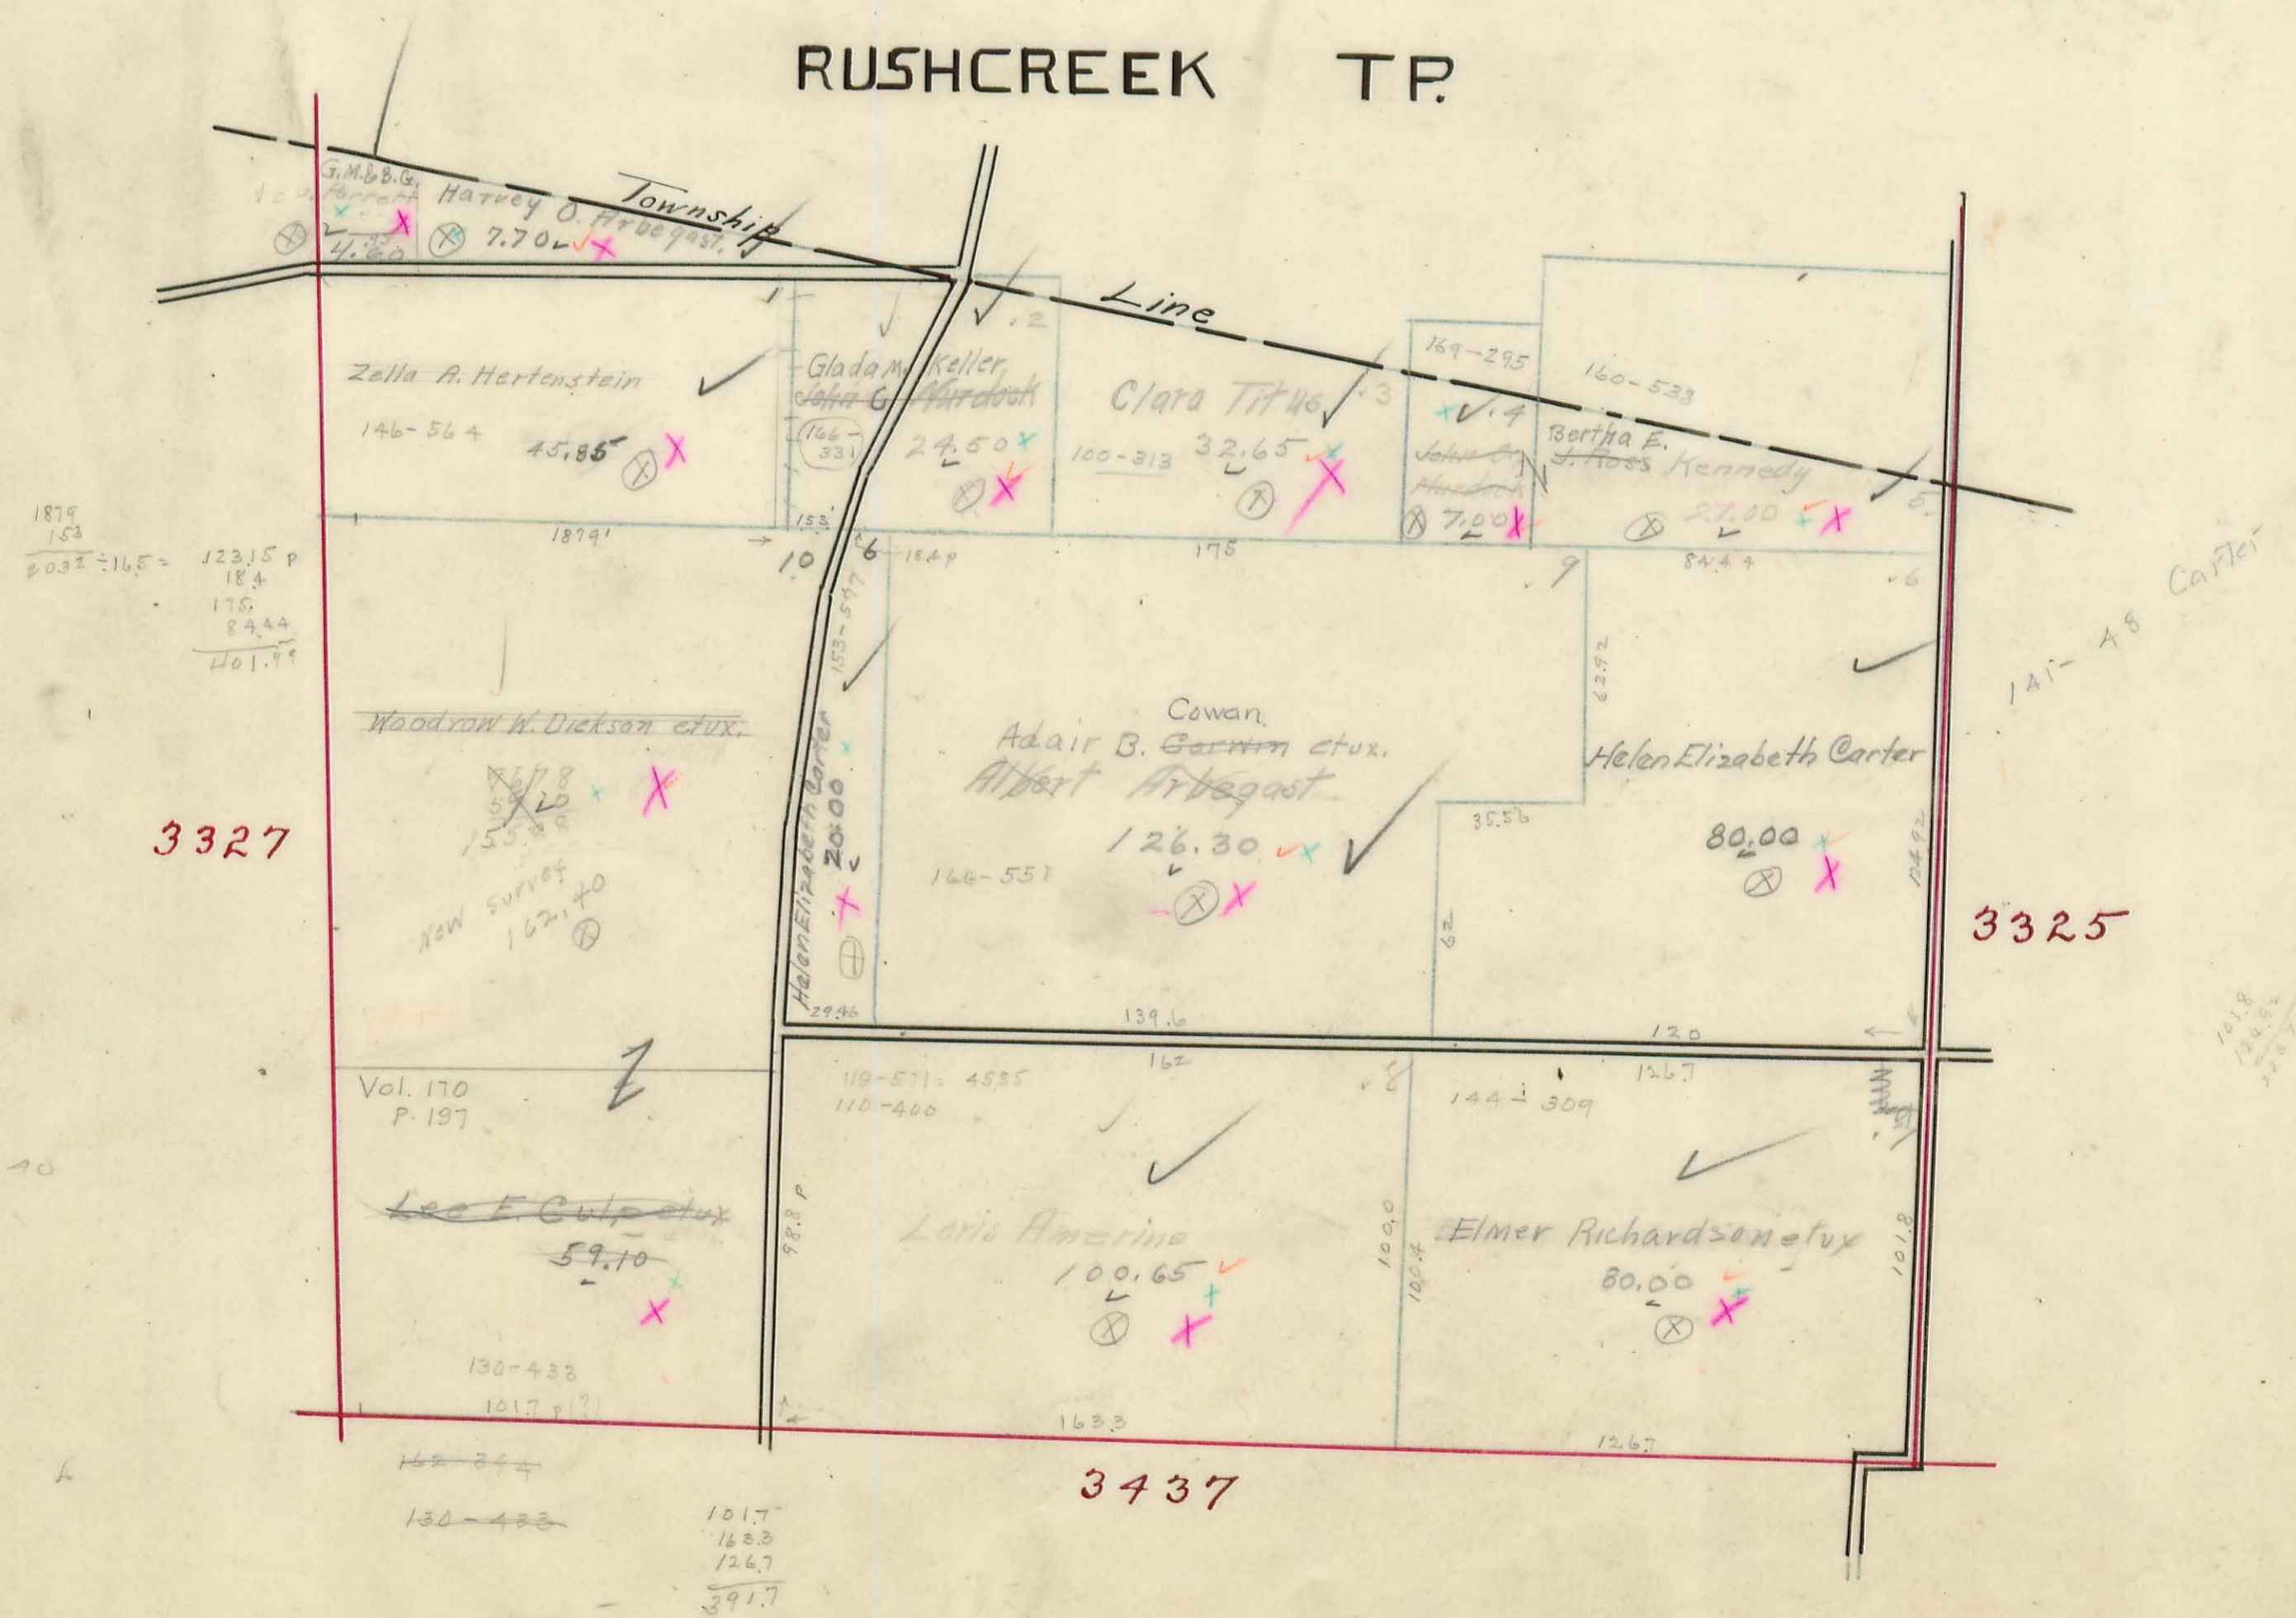


JEFFERSON TOWNSHIP.

Plat of Virginia Military Survey No. ⁸⁴² 3325

Scale: 1 inch = 10 chains.

RUSHCREEK TR.

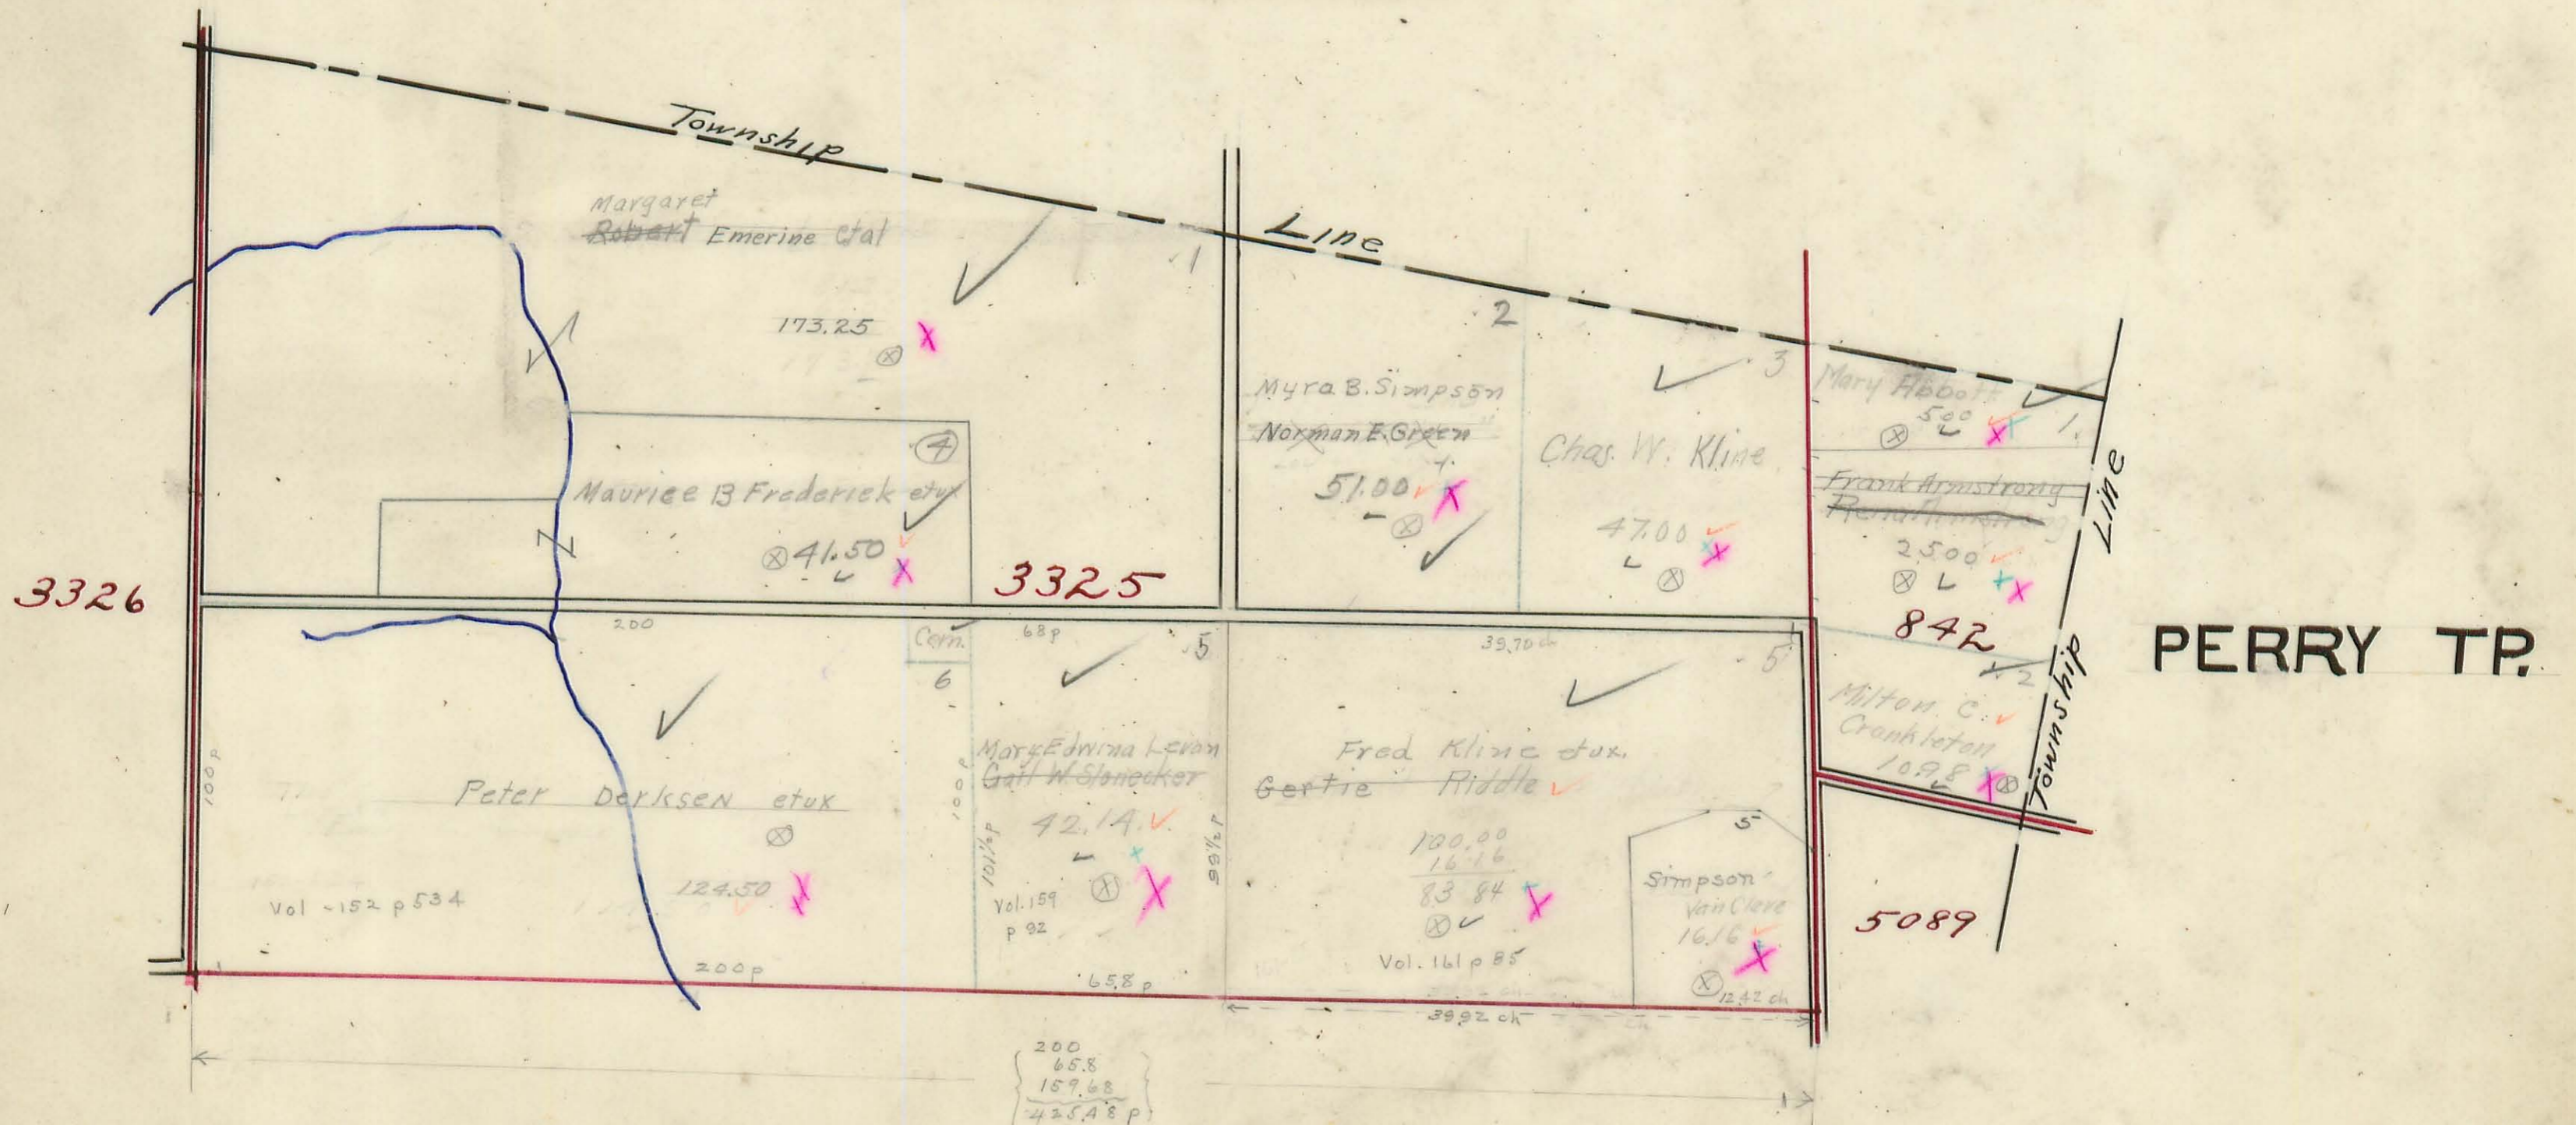

207.60
28.50
173.25
408.75
409.75

200
68
159.68
425.48


39.70
7.4
47.10

842 ch
= 159.68 P

JEFFERSON TOWNSHIP.

Plat of Virginia Military Survey No. 3439


Scale: 1 inch = 10 chains.

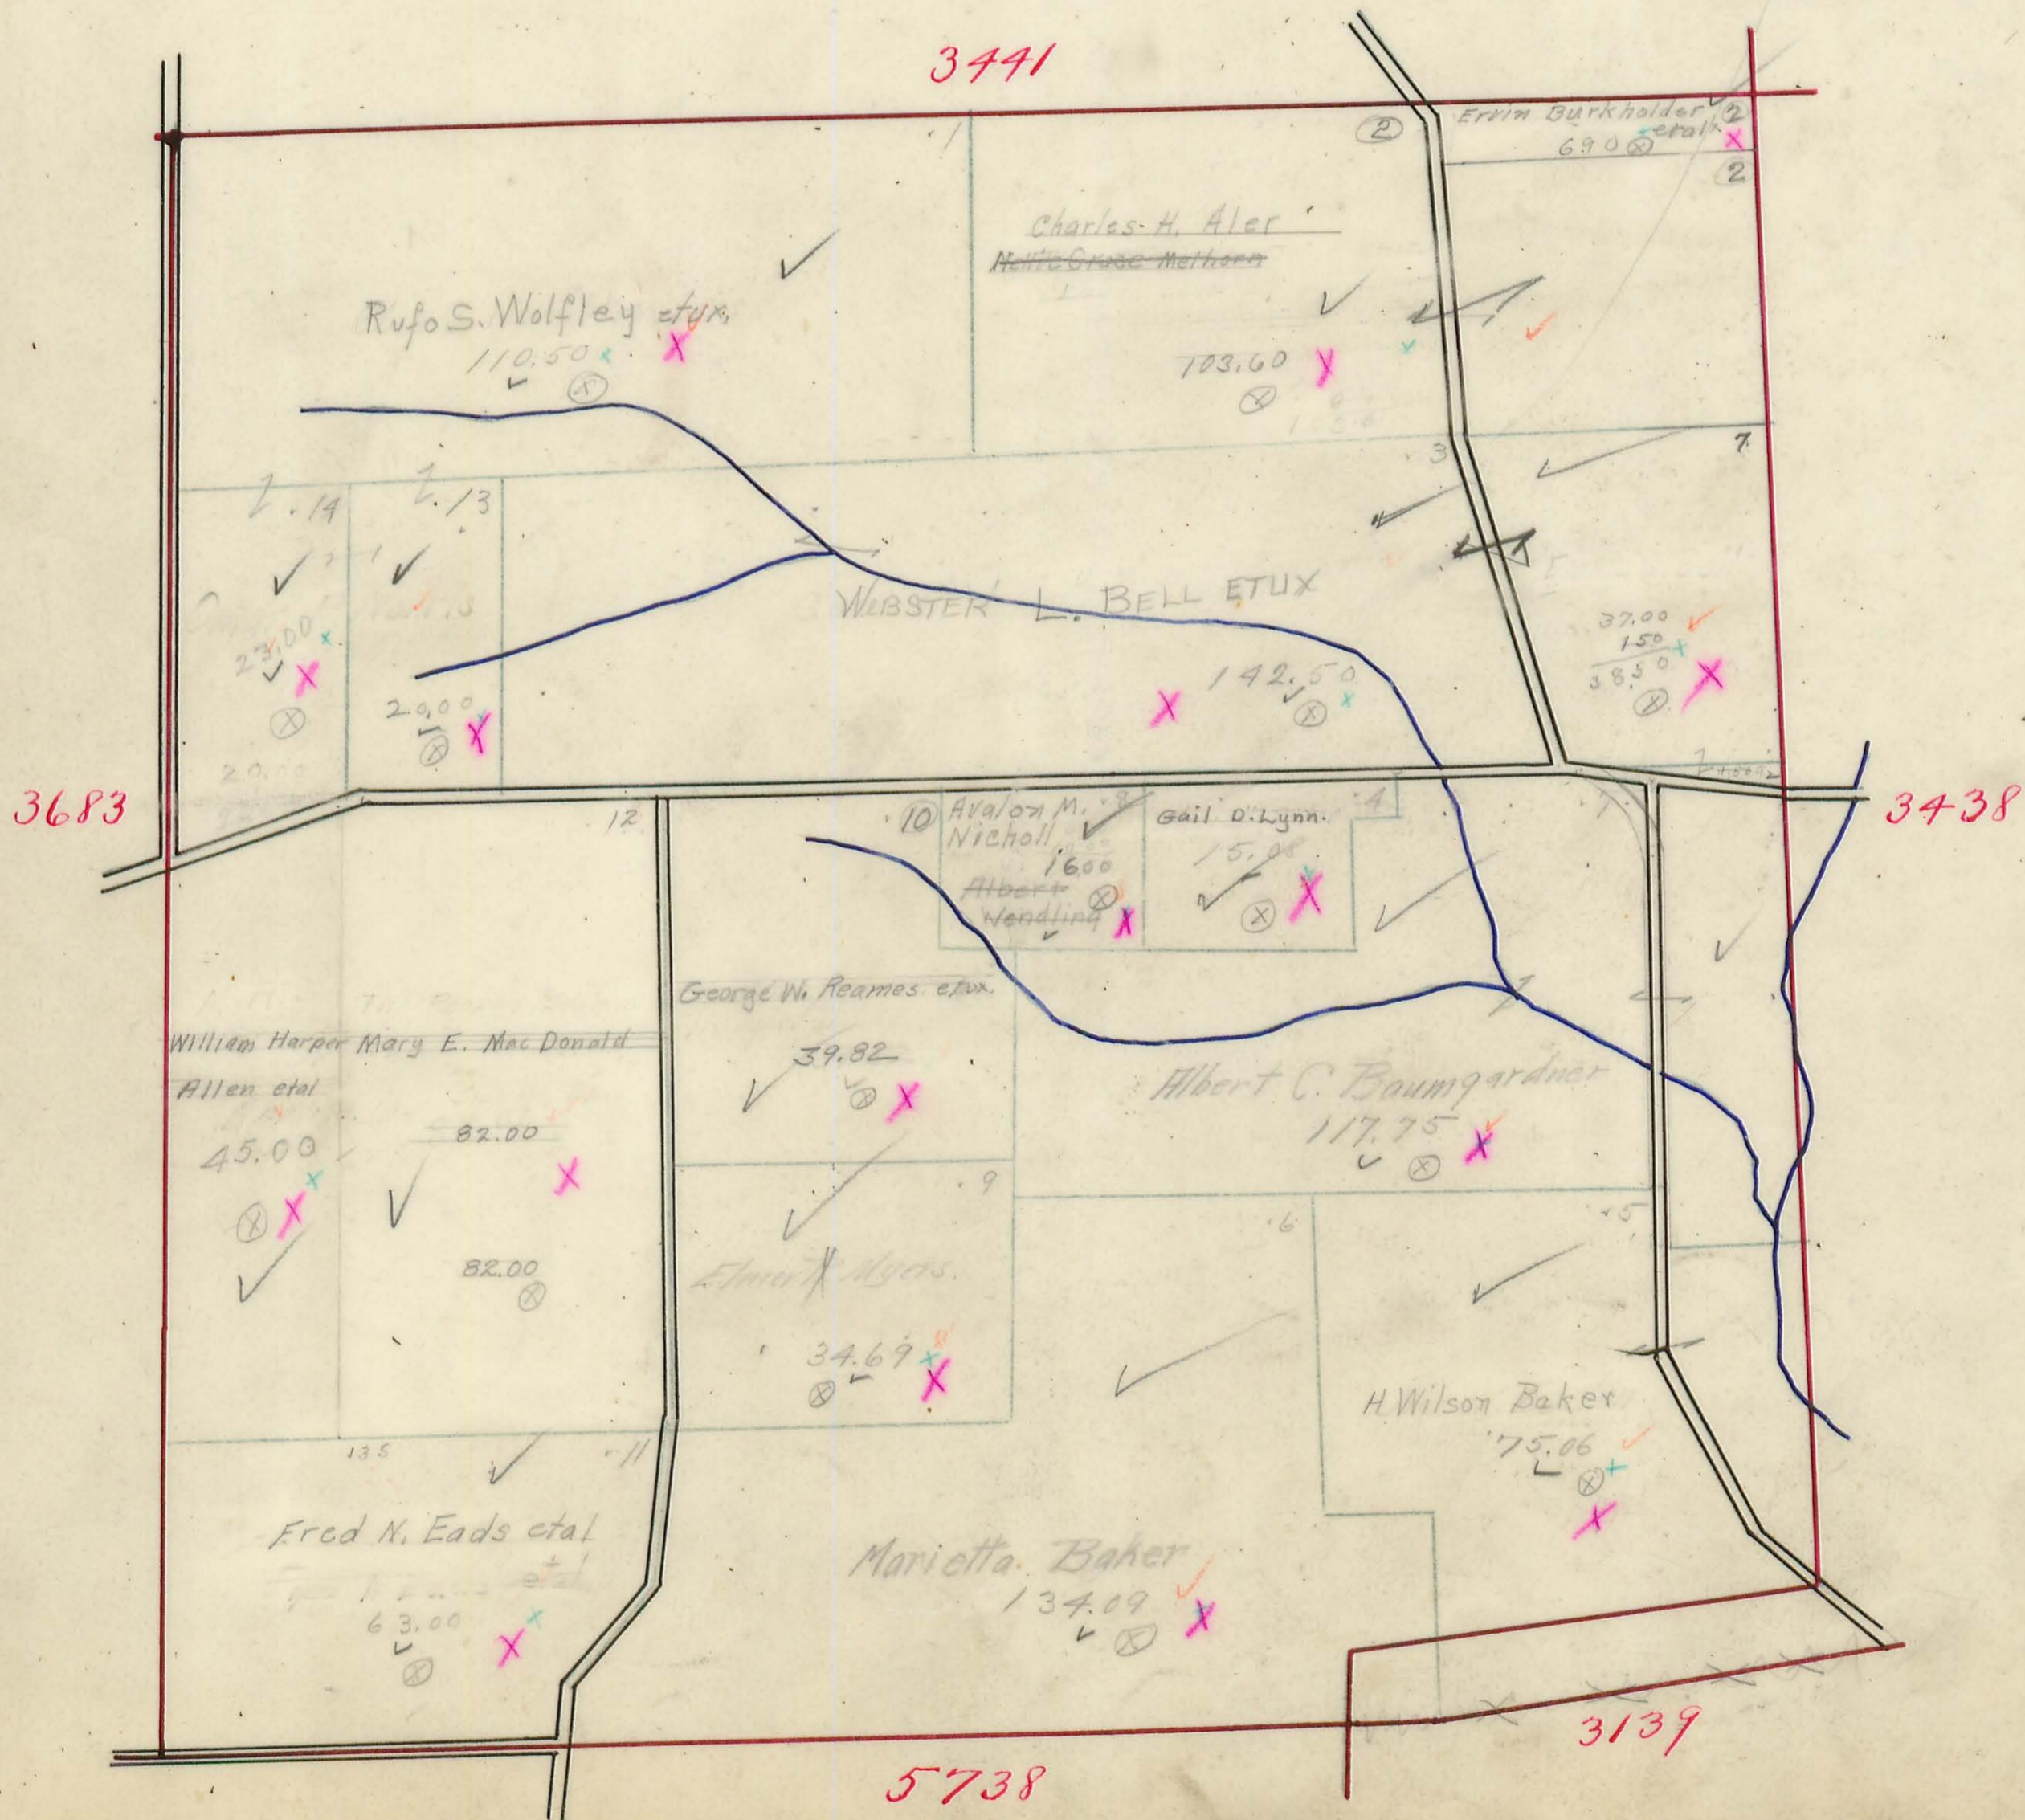

JEFFERSON TOWNSHIP.

Plat of Virginia Military Survey No. 3438


Scale: 1 inch = 10 chains.

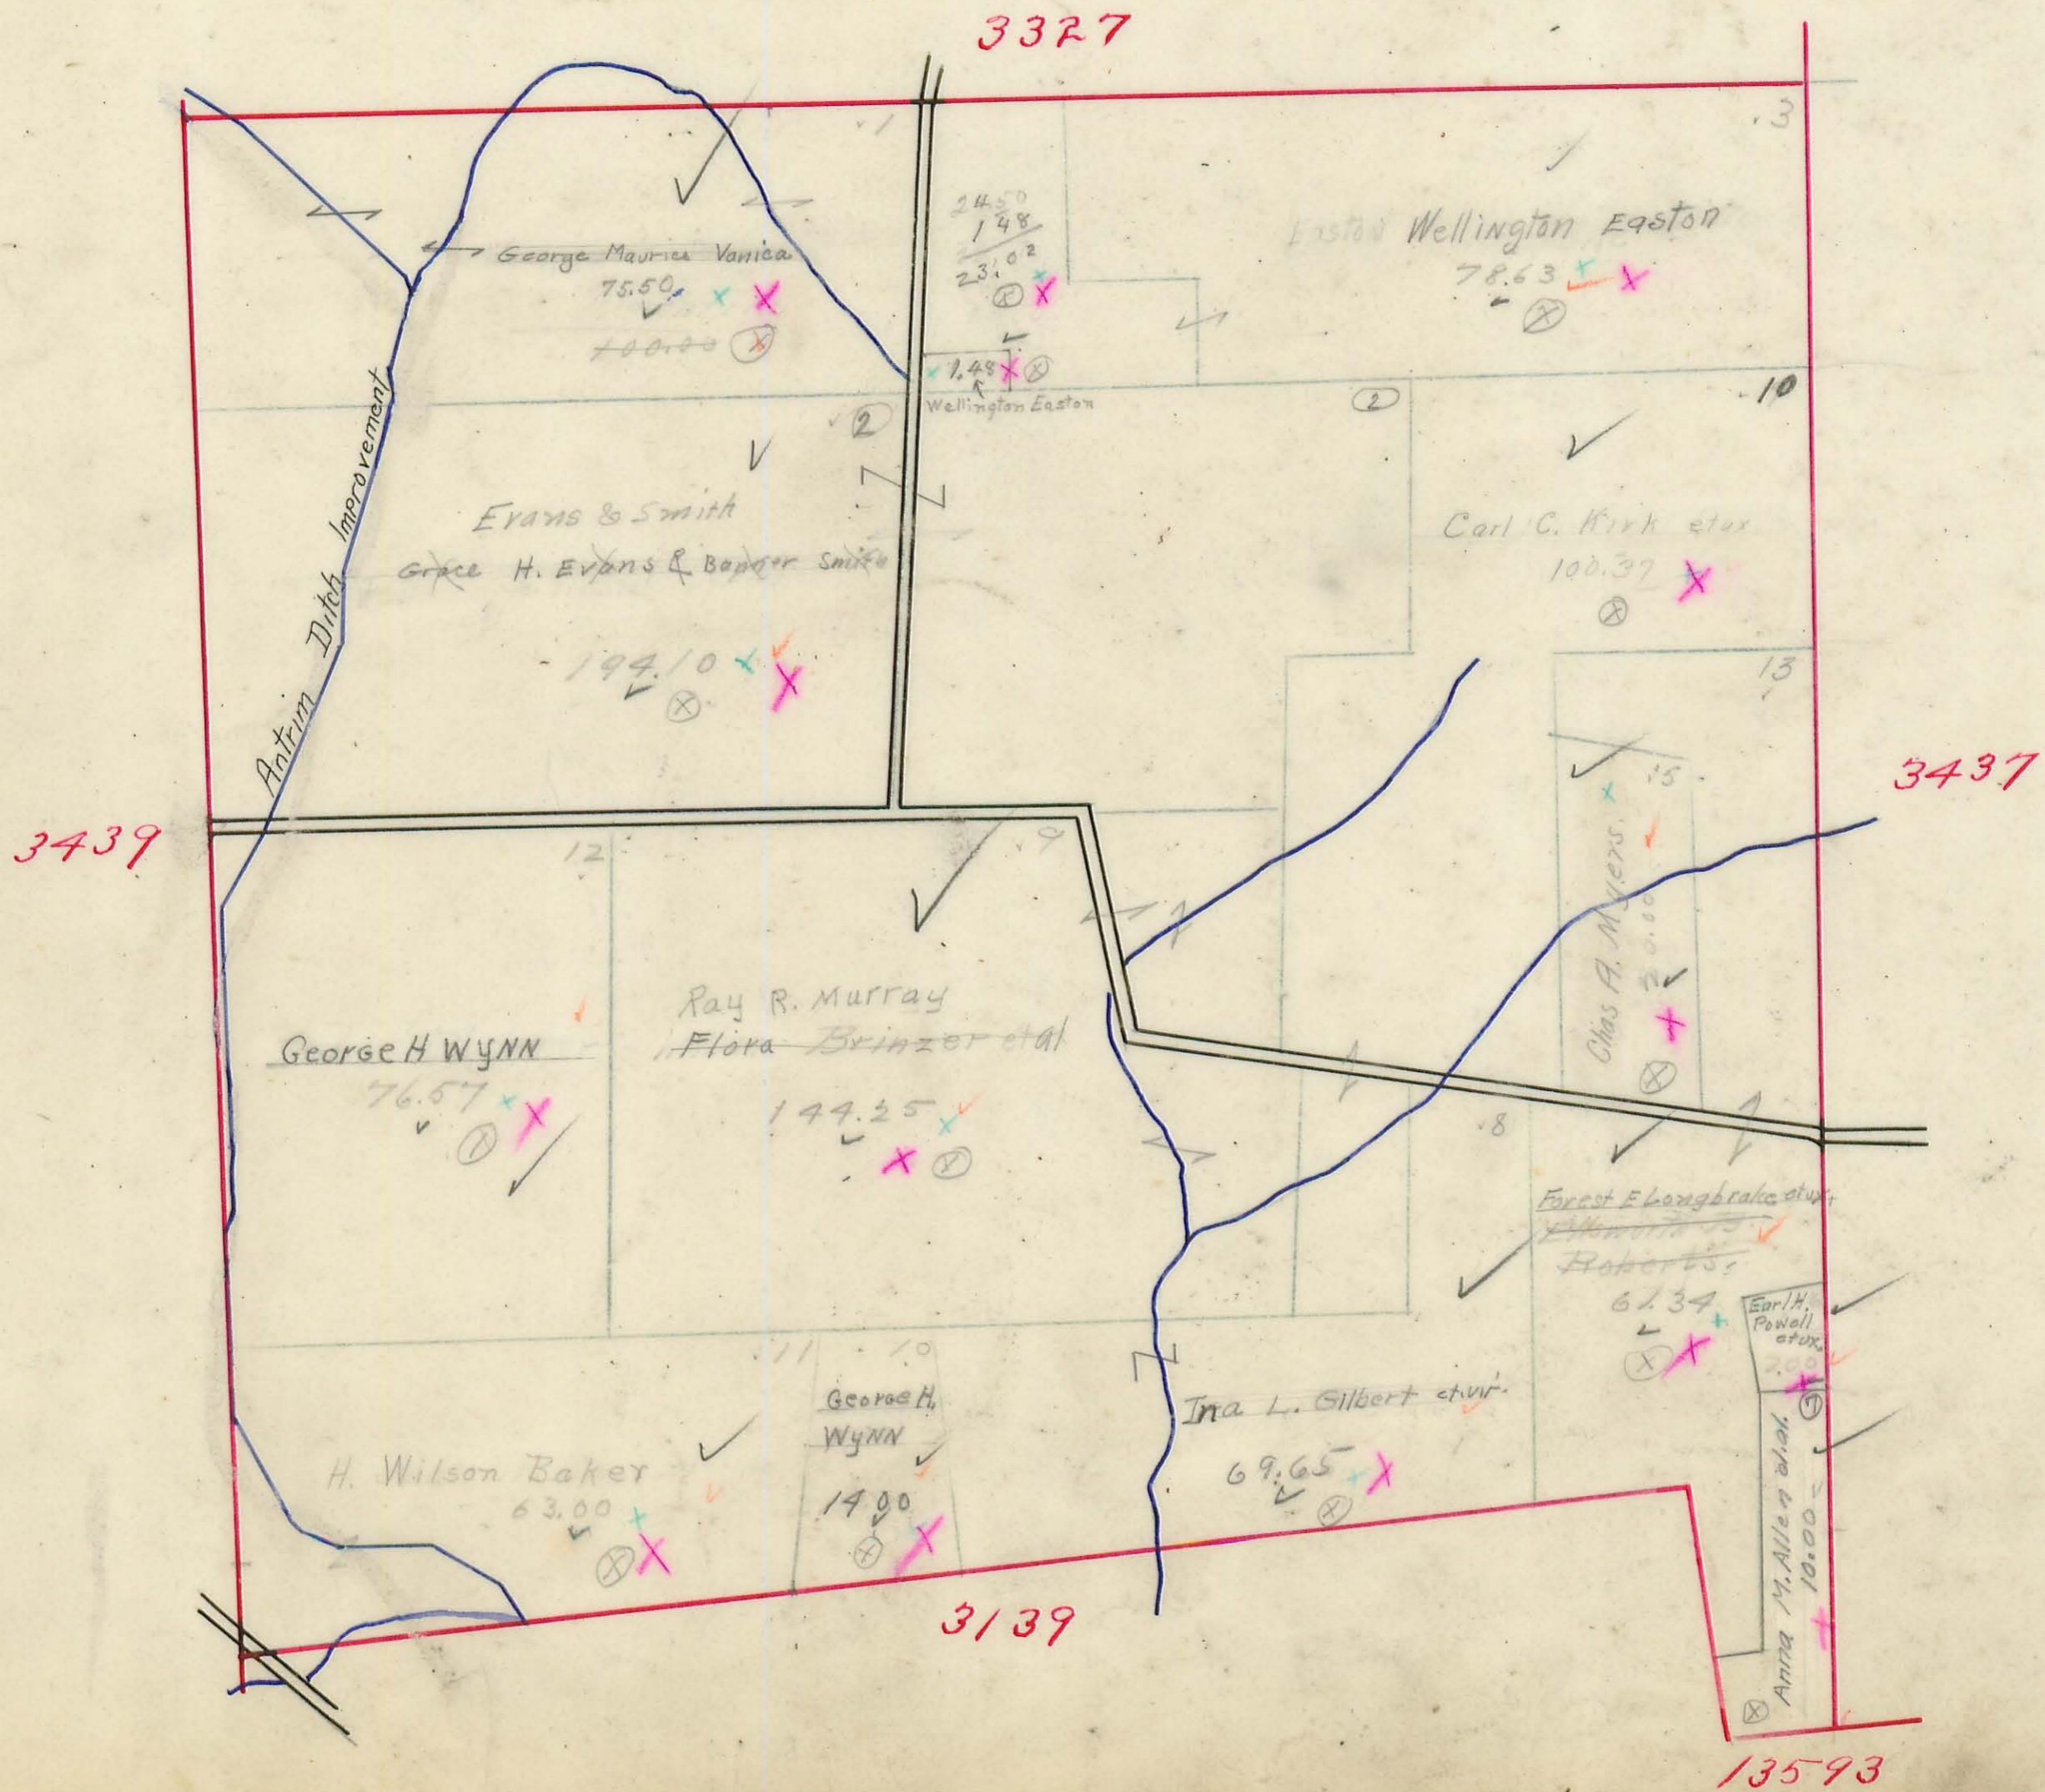

JEFFERSON TOWNSHIP.

Plat of Virginia Military Survey No. 3437


Scale: 1 inch = 10 chains.

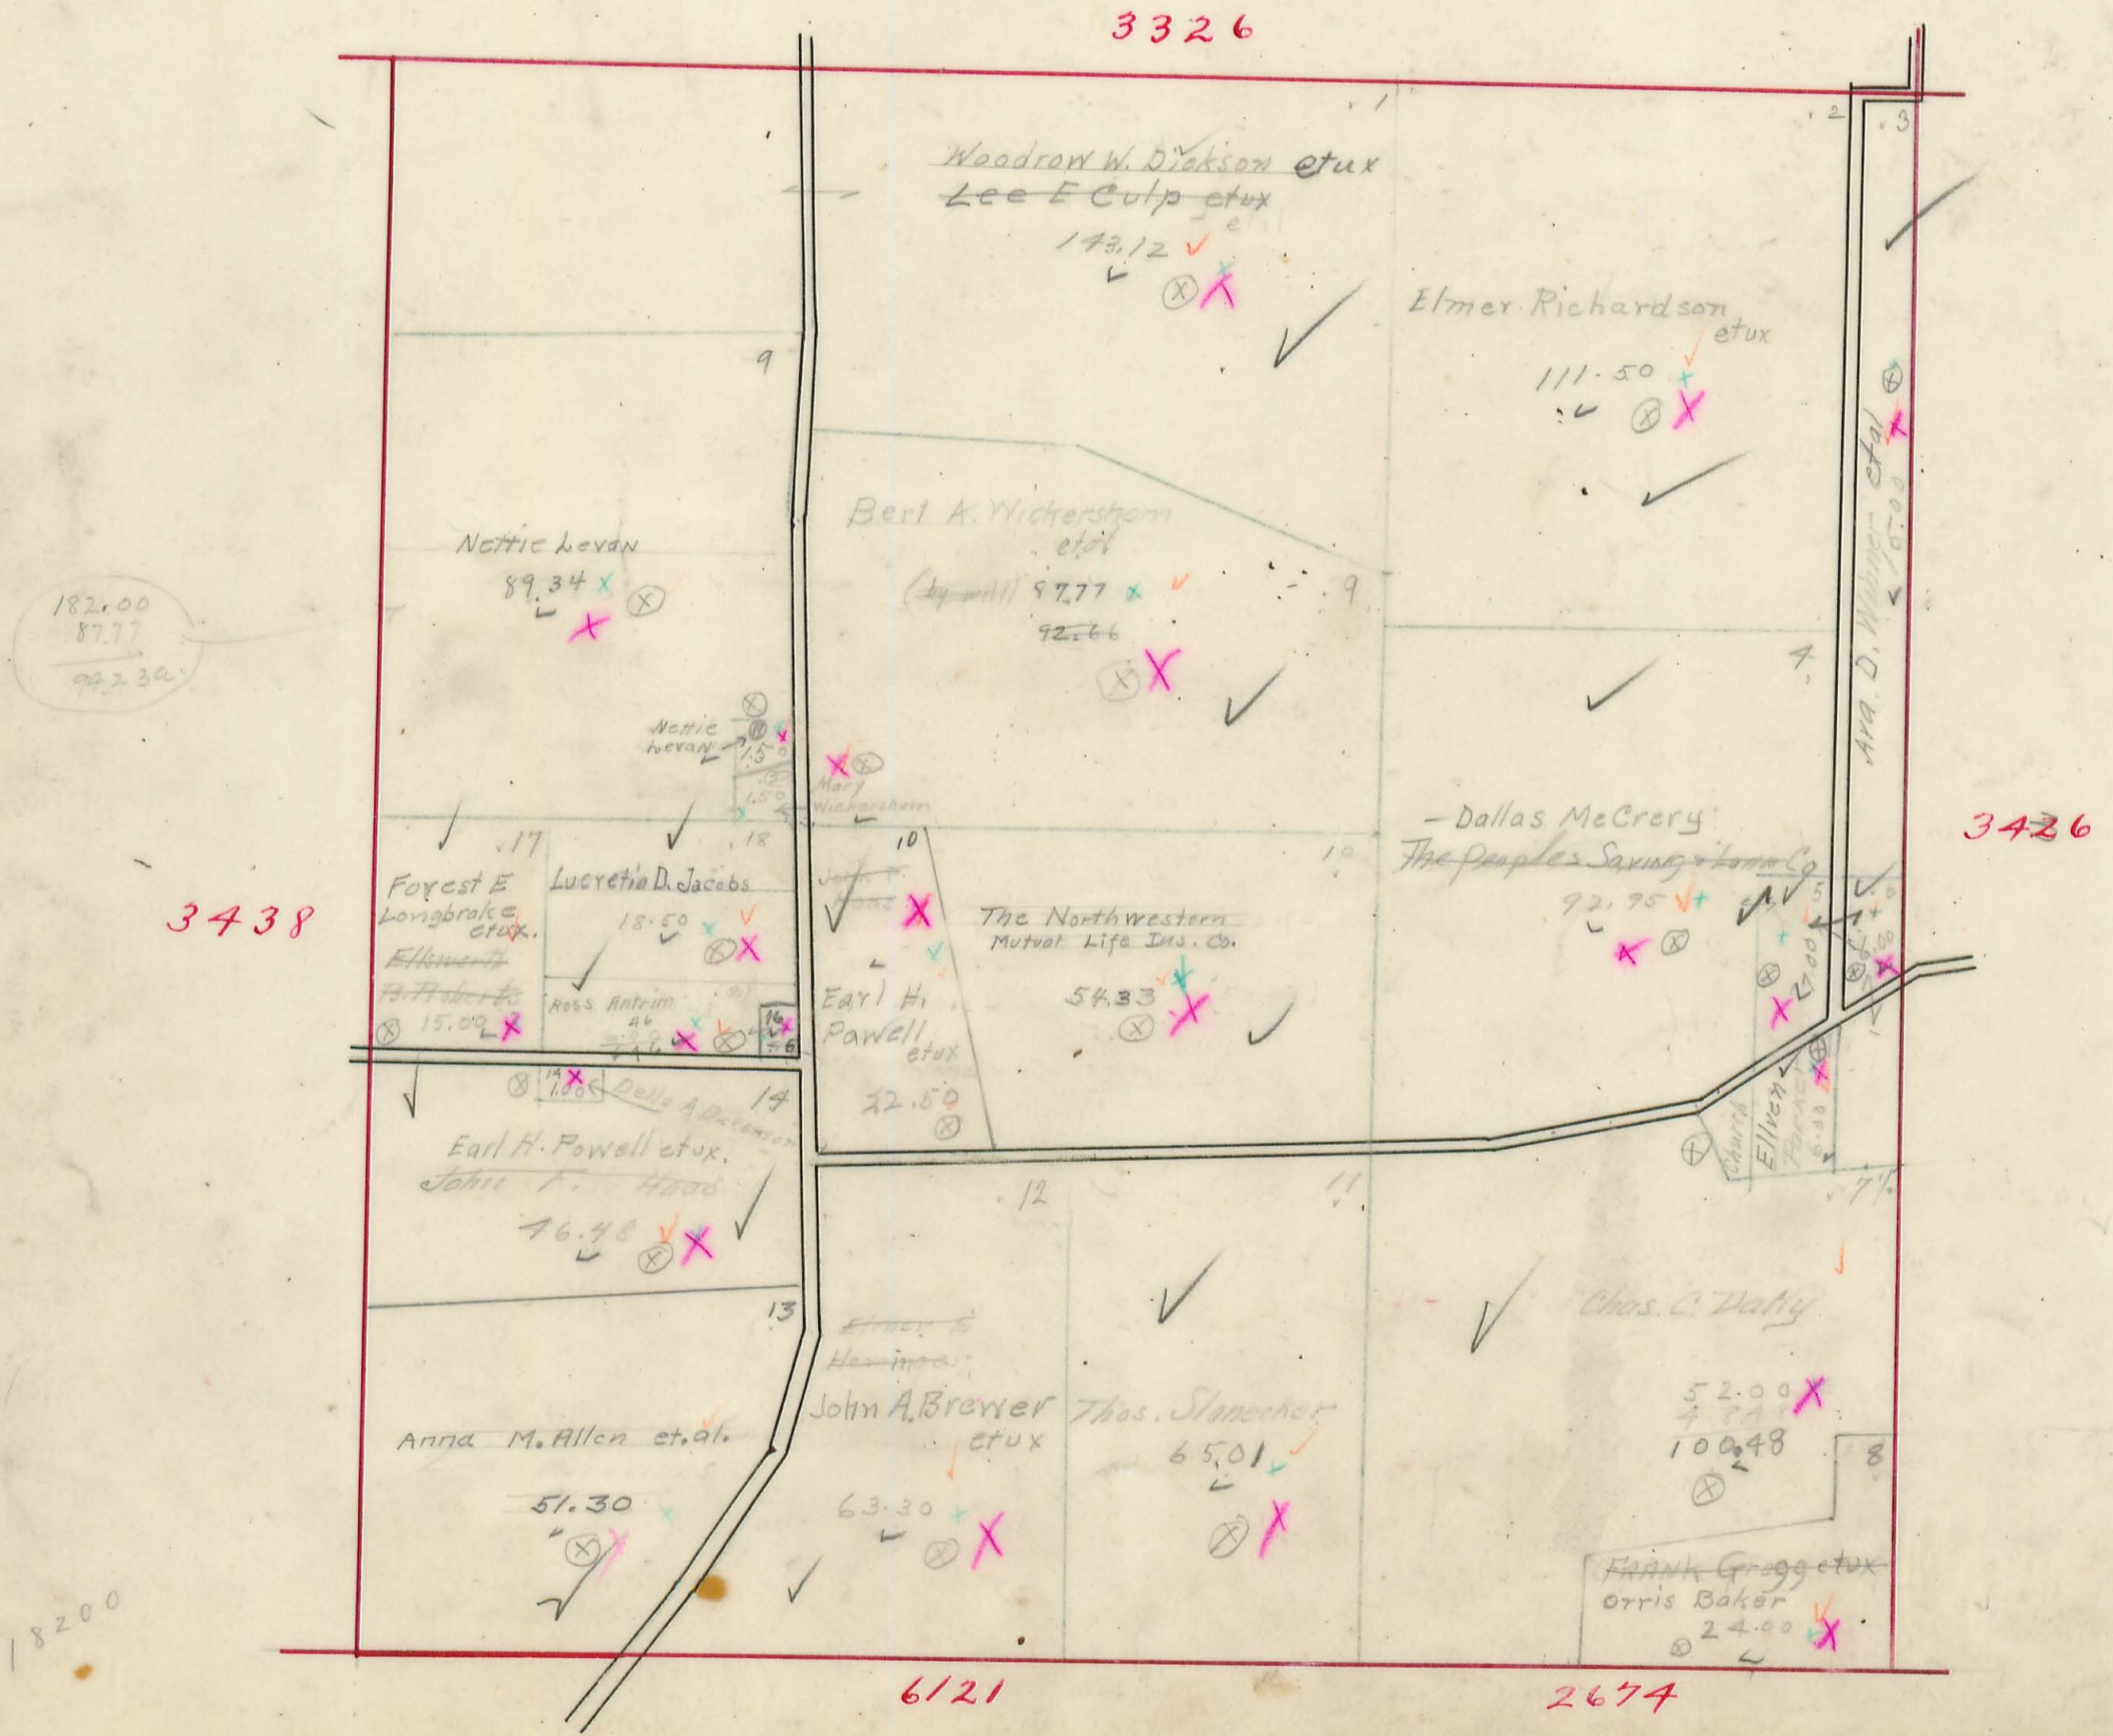

JEFFERSON TOWNSHIP.

Plat of Virginia Military Survey No. ⁵⁰⁸⁹ 3436


Scale: 1 inch = 10 chains.

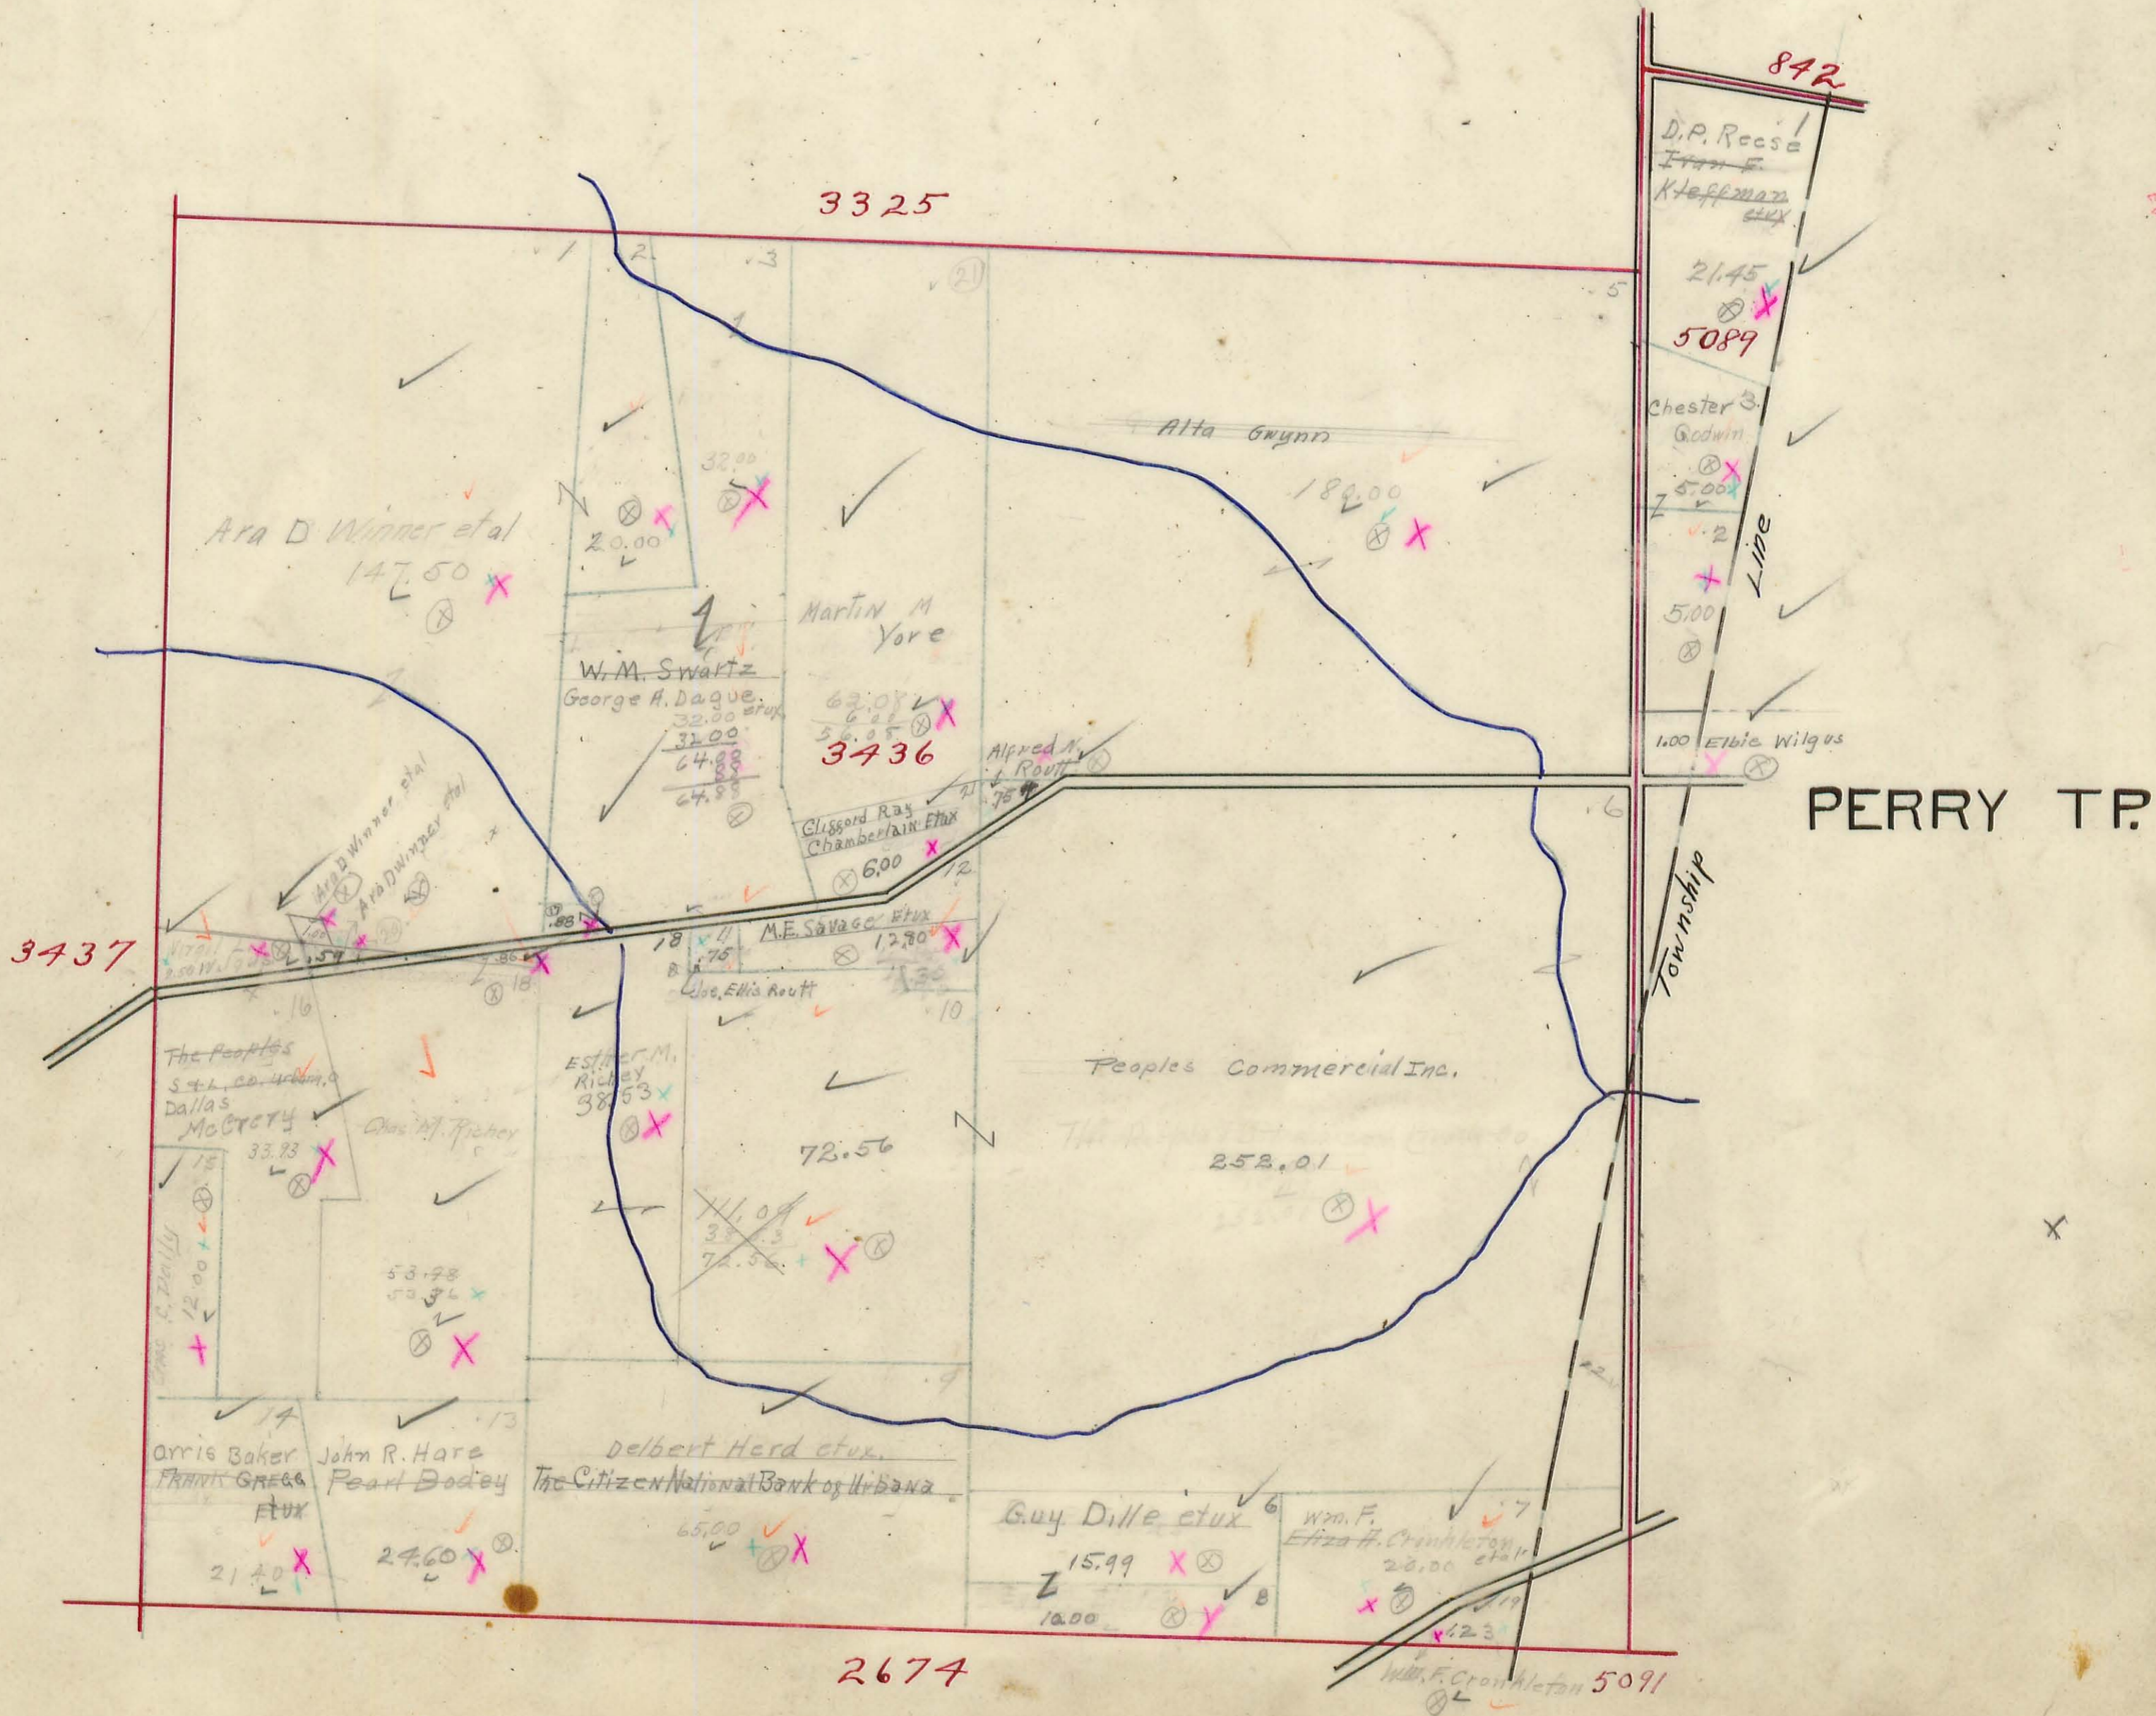

JEFFERSON TOWNSHIP.

Plat of Virginia Military Survey No. 5738


Scale: 1 inch = 10 chains.

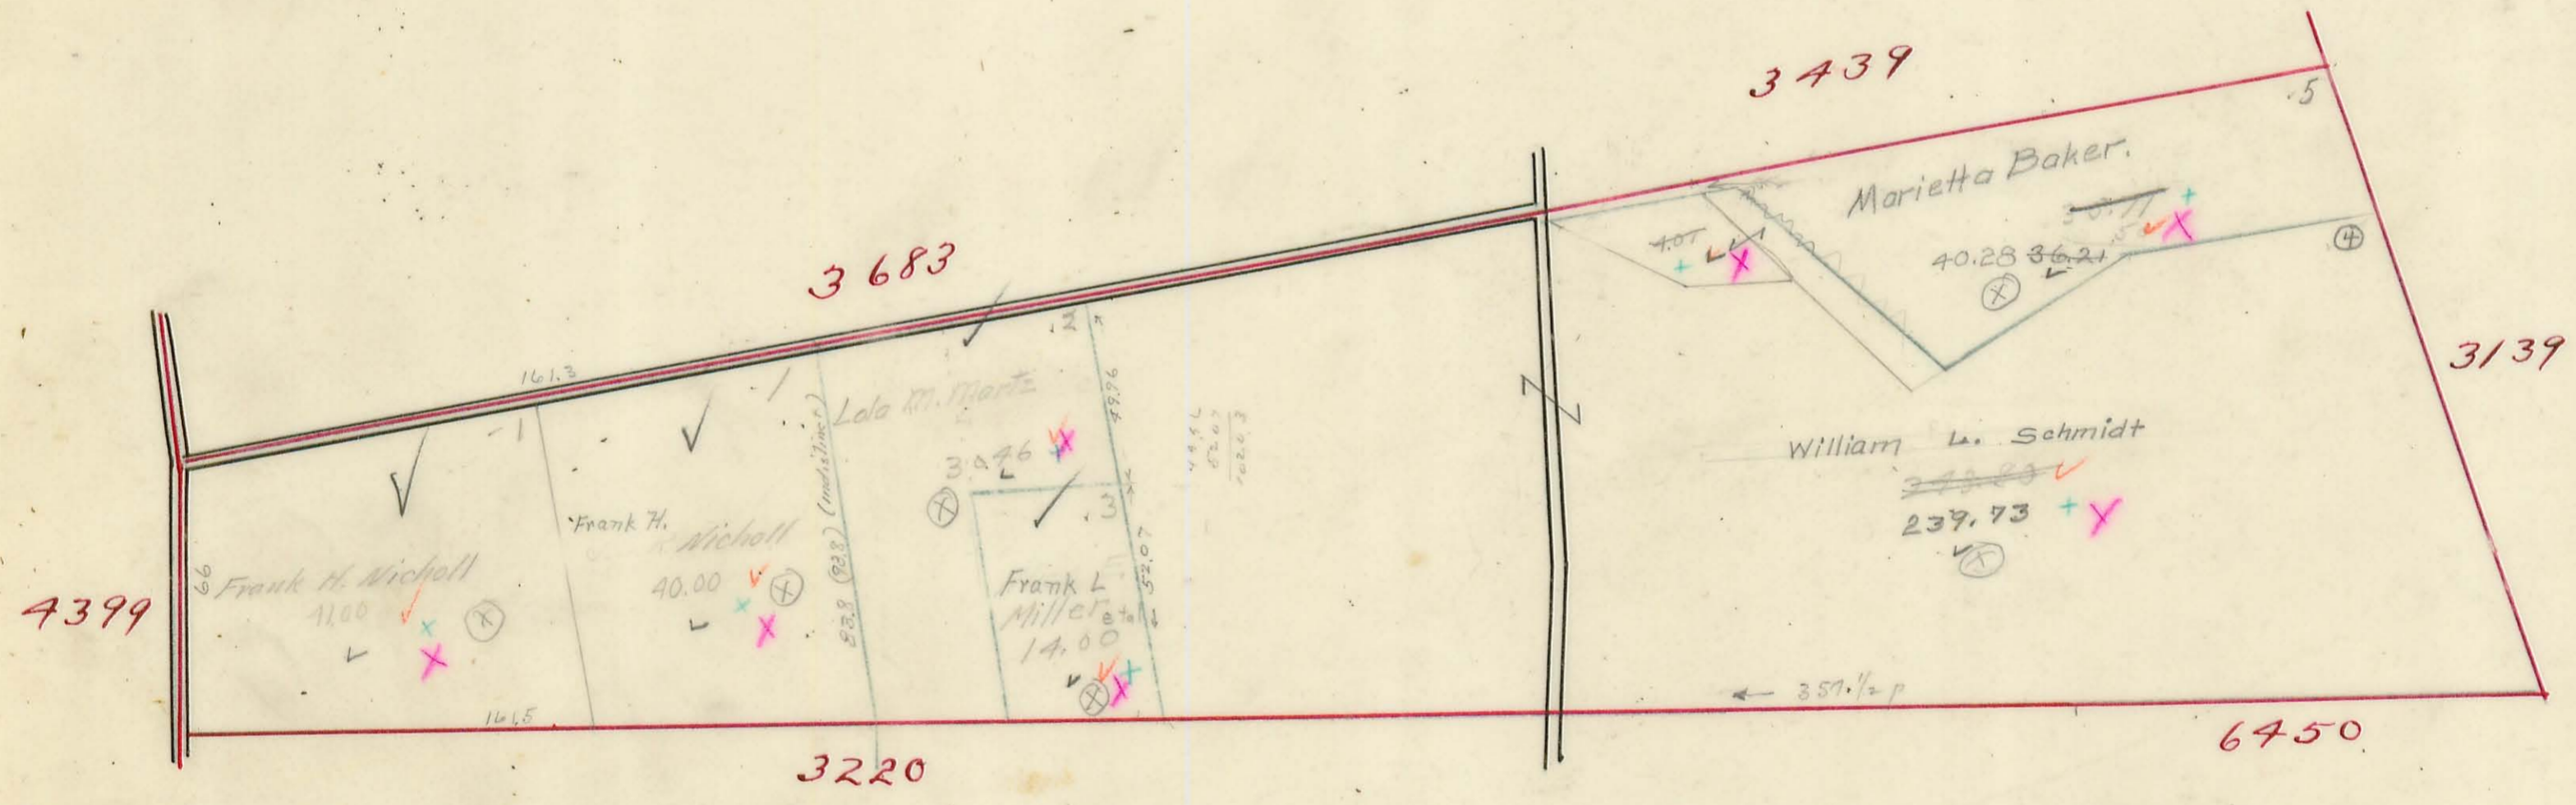

JEFFERSON TOWNSHIP.

Plat of Virginia Military Survey No. 3139

Scale: 1 inch = 10 chains.

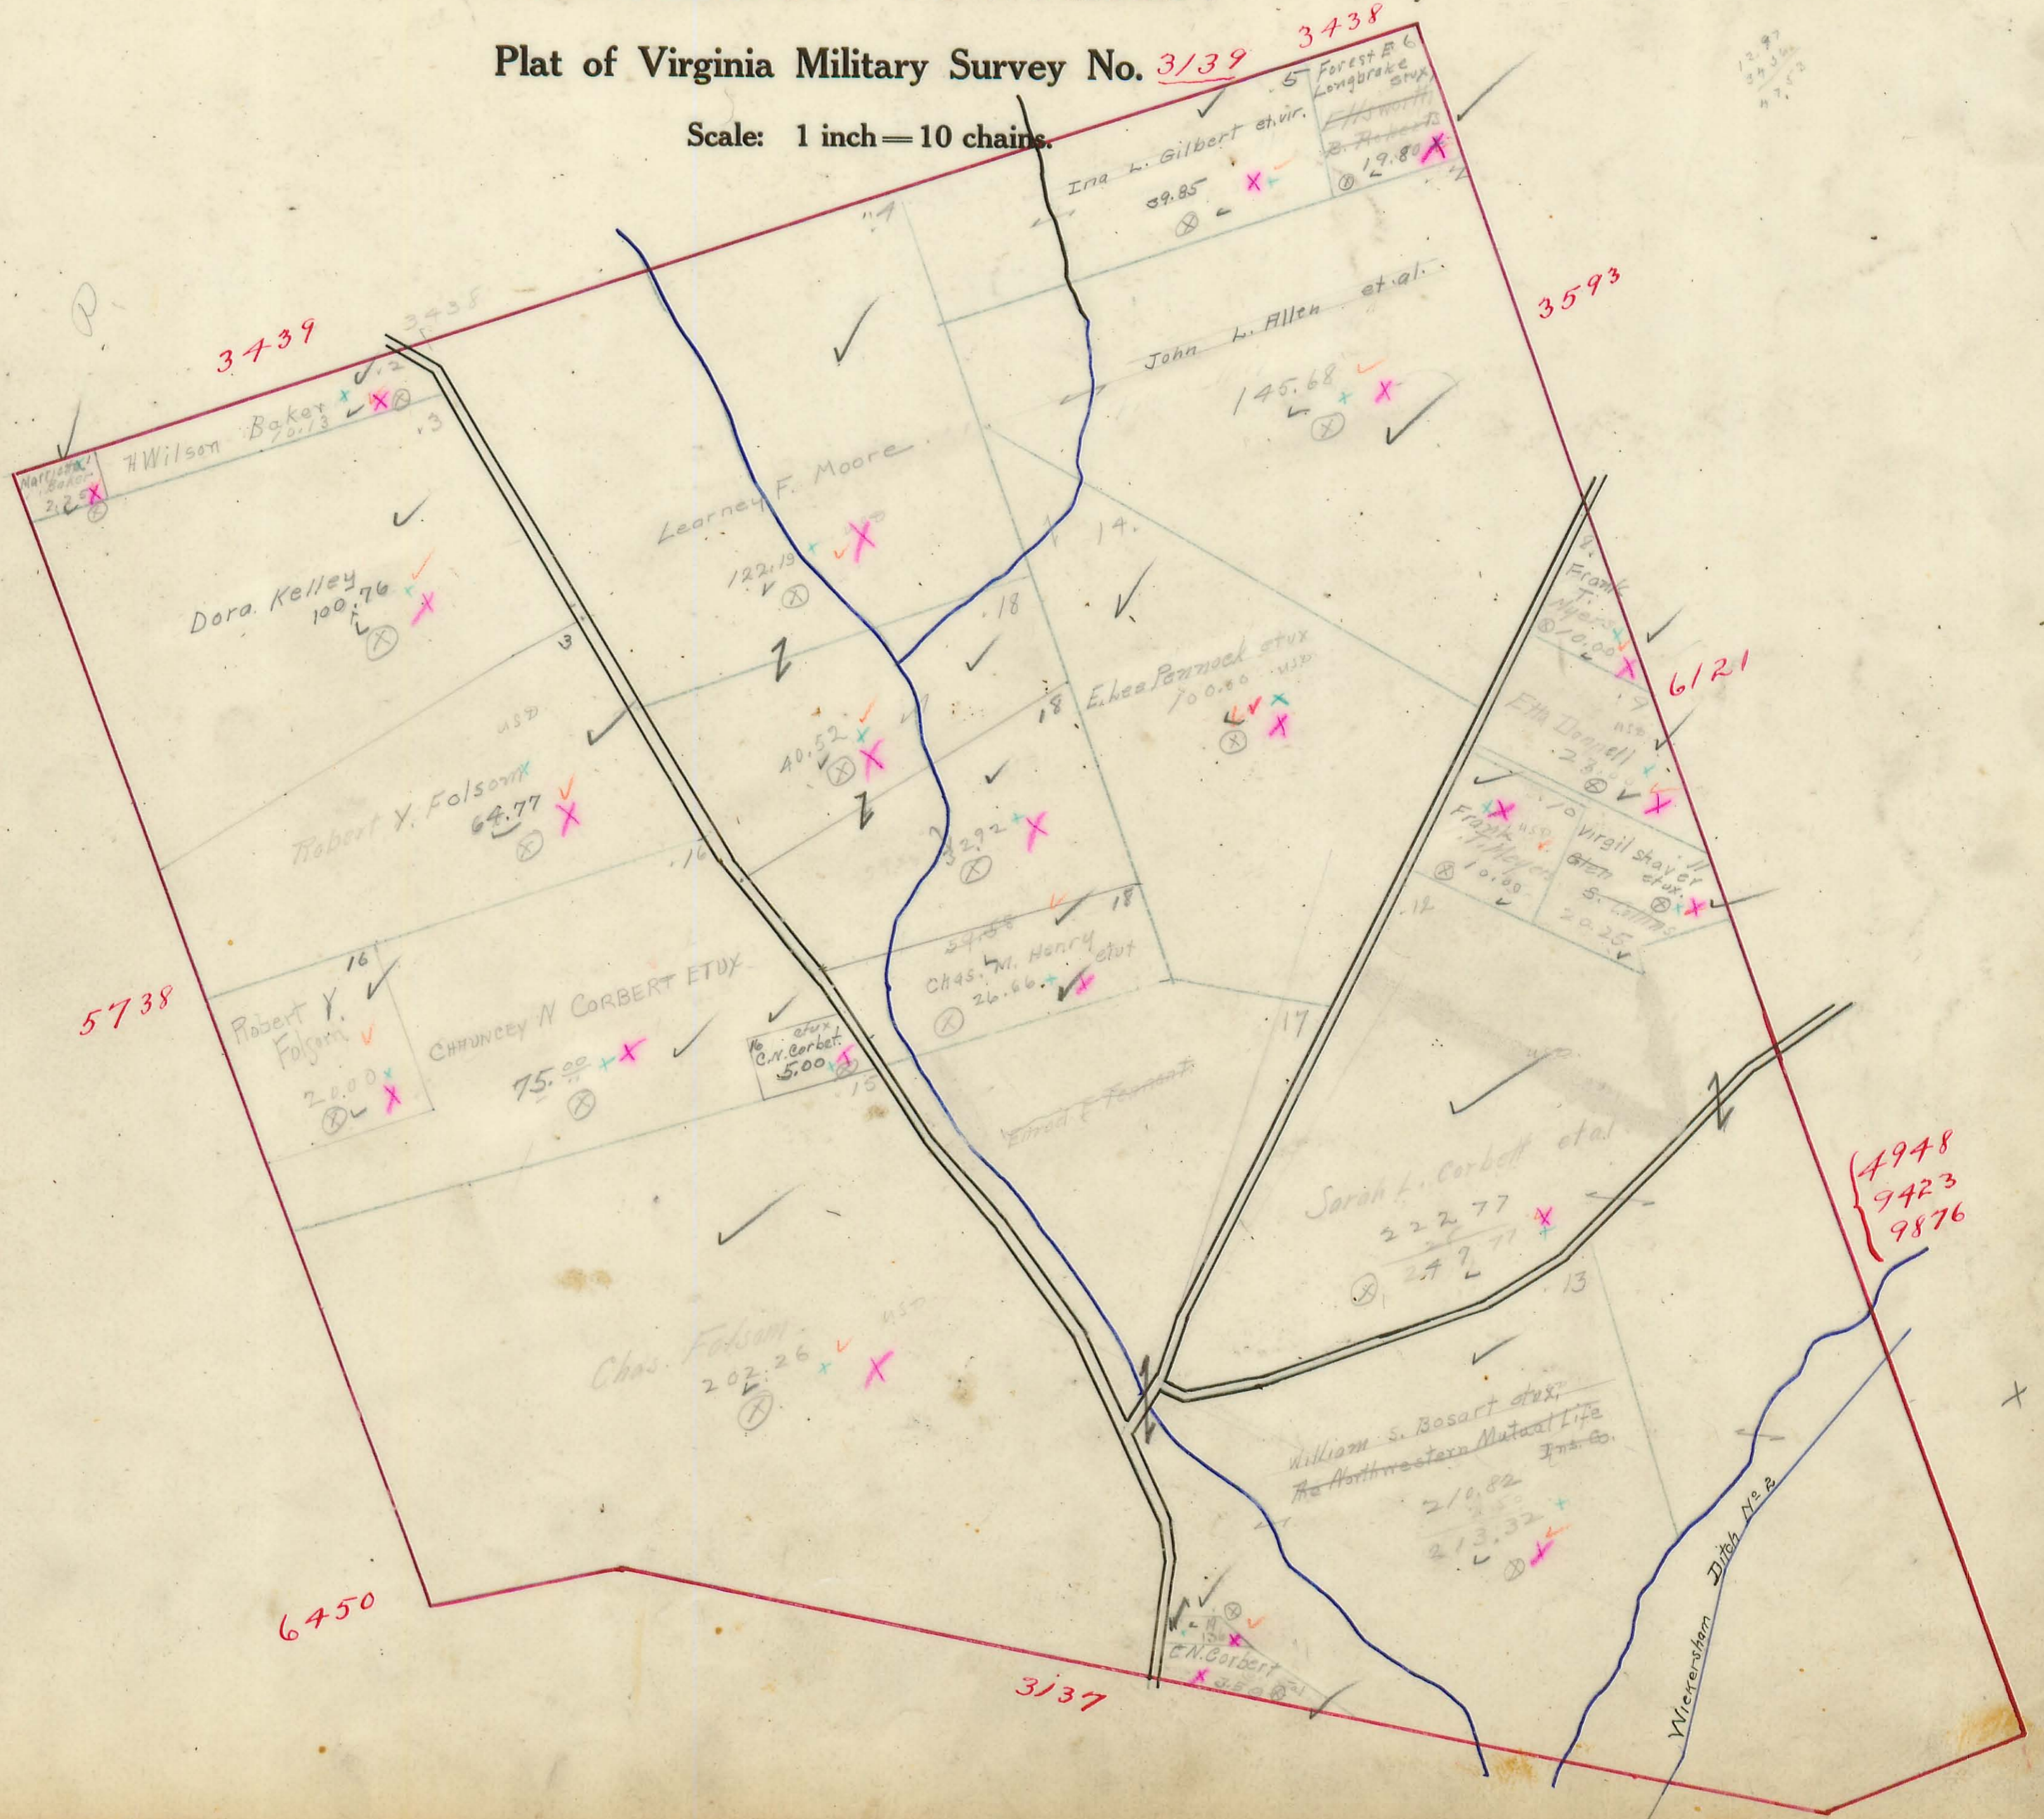


JEFFERSON TOWNSHIP.

Plat of Virginia Military Survey No. **13593**
6121
3136

Scale: 1 inch = 10 chains.

123.40
163.73
292.43

188.90
102.95
18.75
307.60

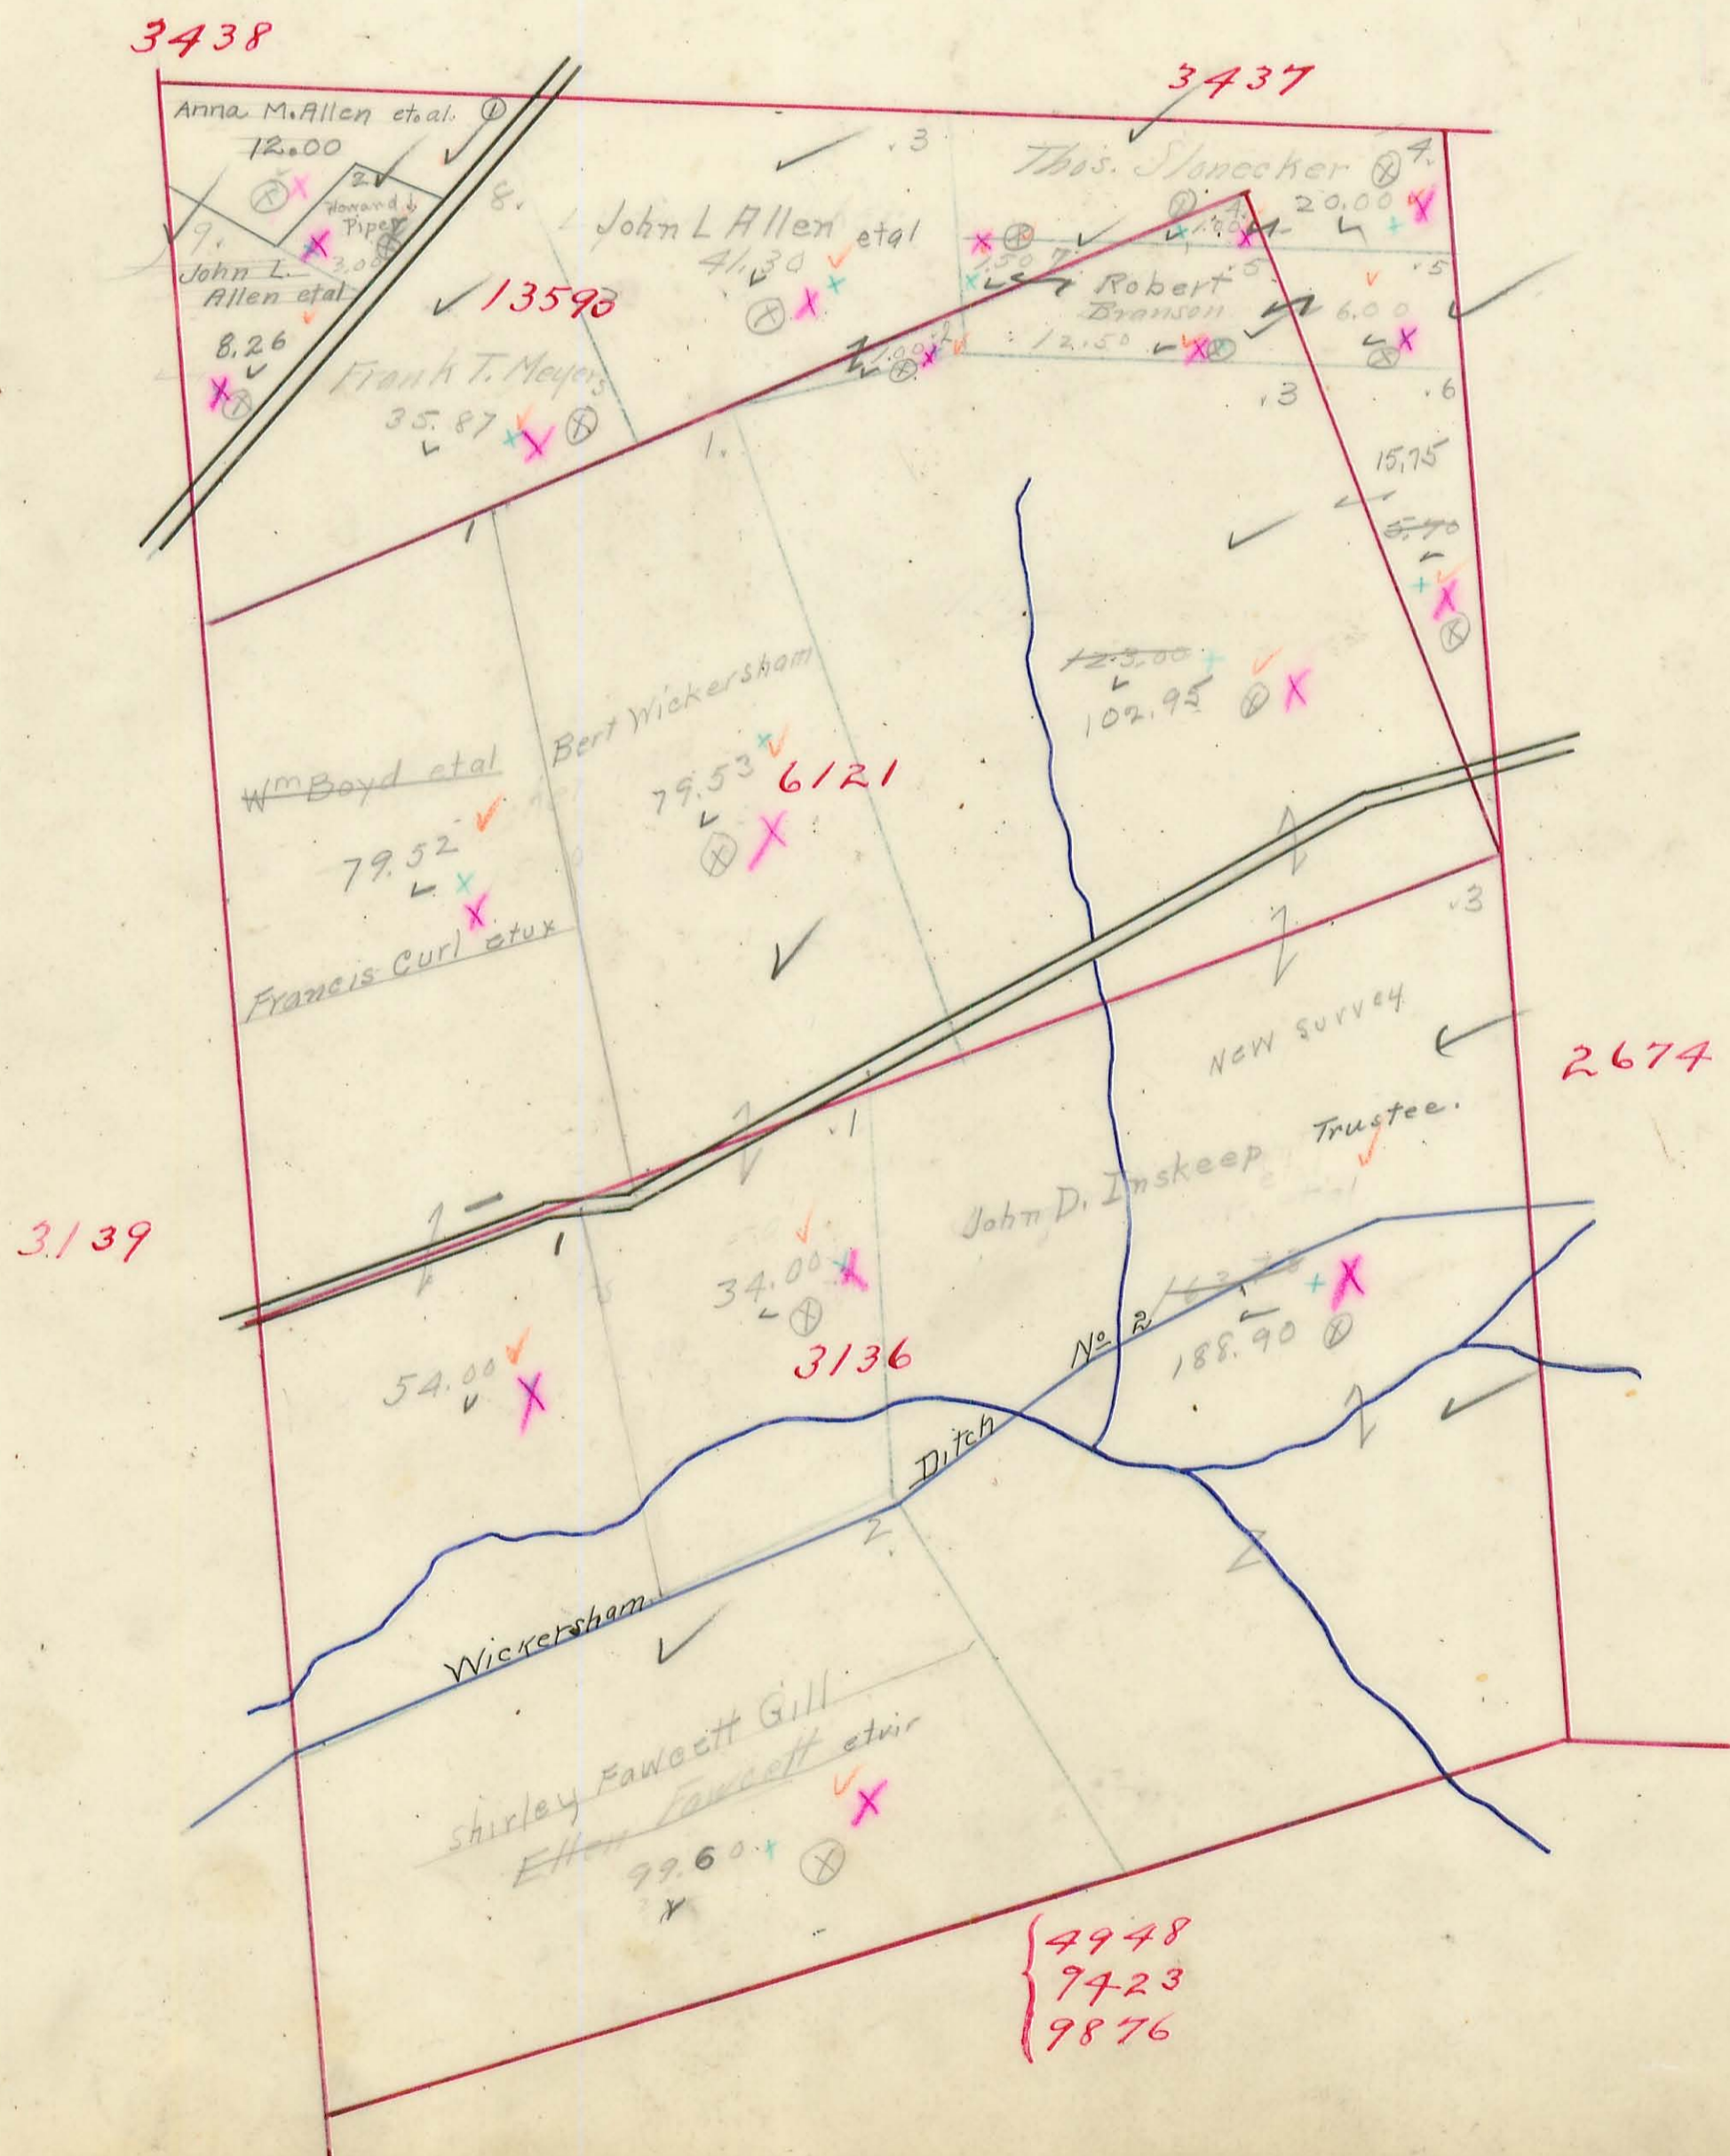


4948
7423
9876

JEFFERSON TOWNSHIP.

Plat of Virginia Military Survey No. ²⁶⁷⁴ 5091


Scale: 1 inch = 10 chains.

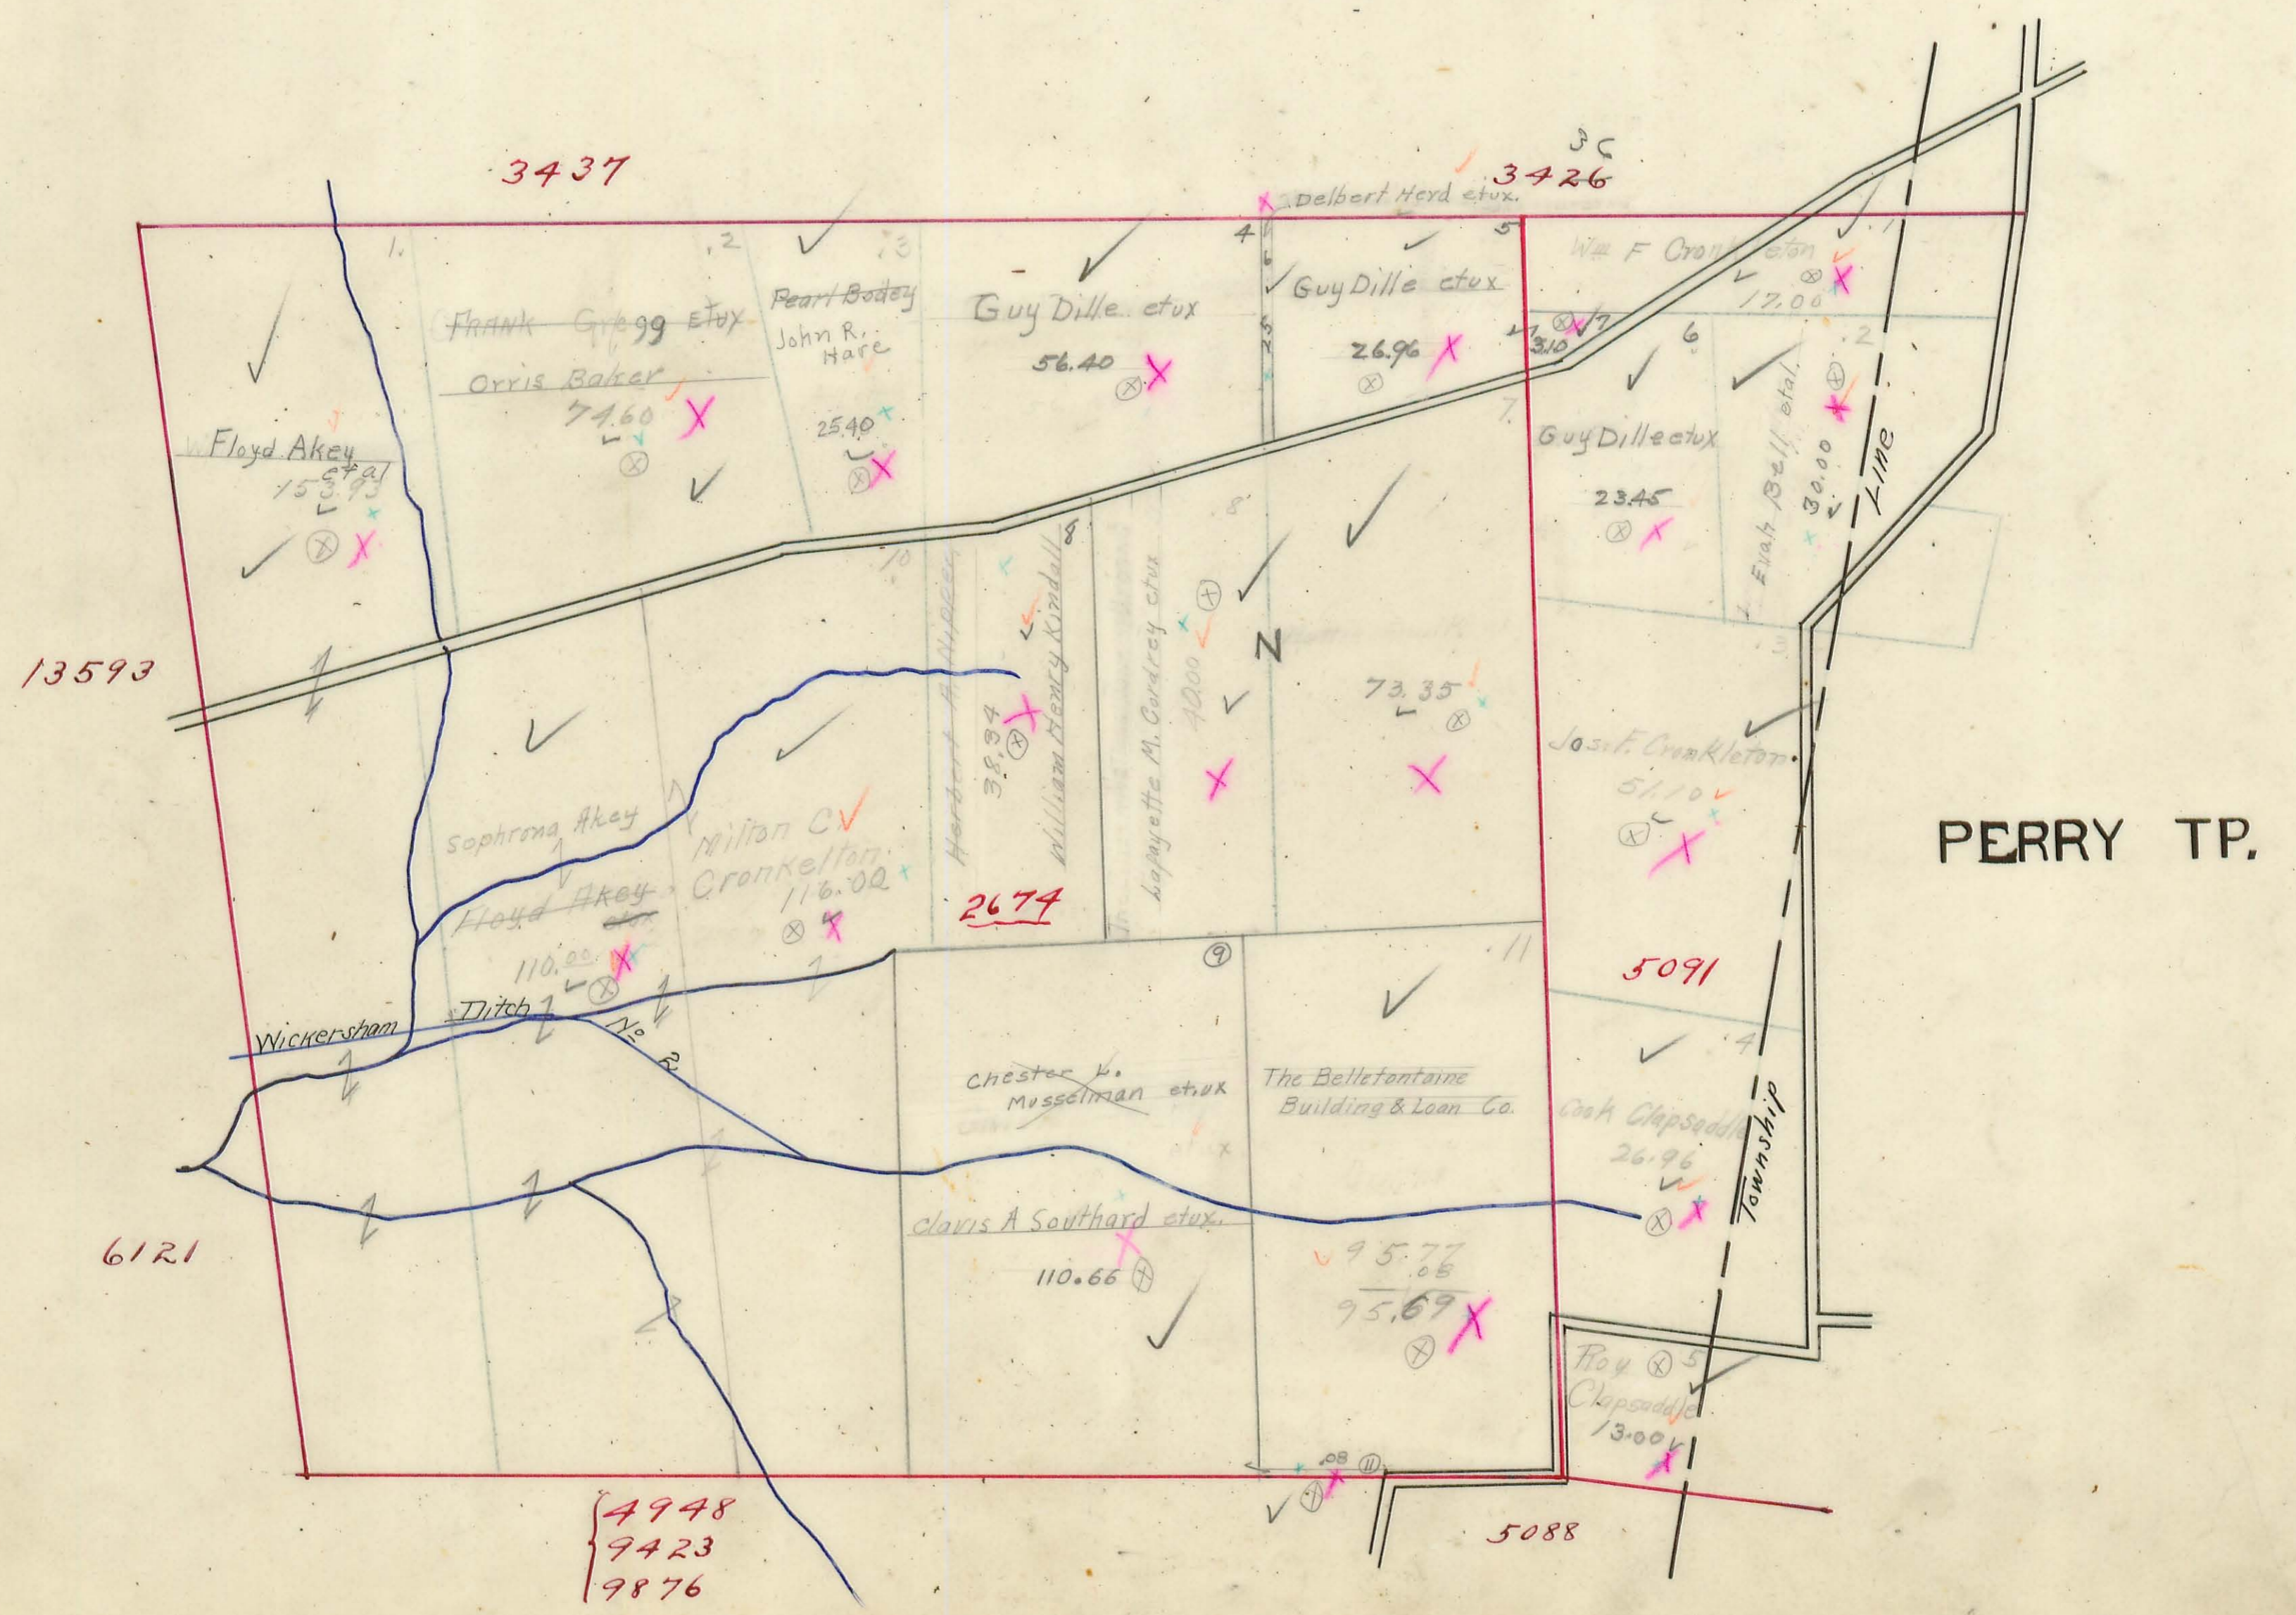

JEFFERSON TOWNSHIP.

Plat of Virginia Military Survey No. 4399
4478

Scale: 1 inch = 10 chains.

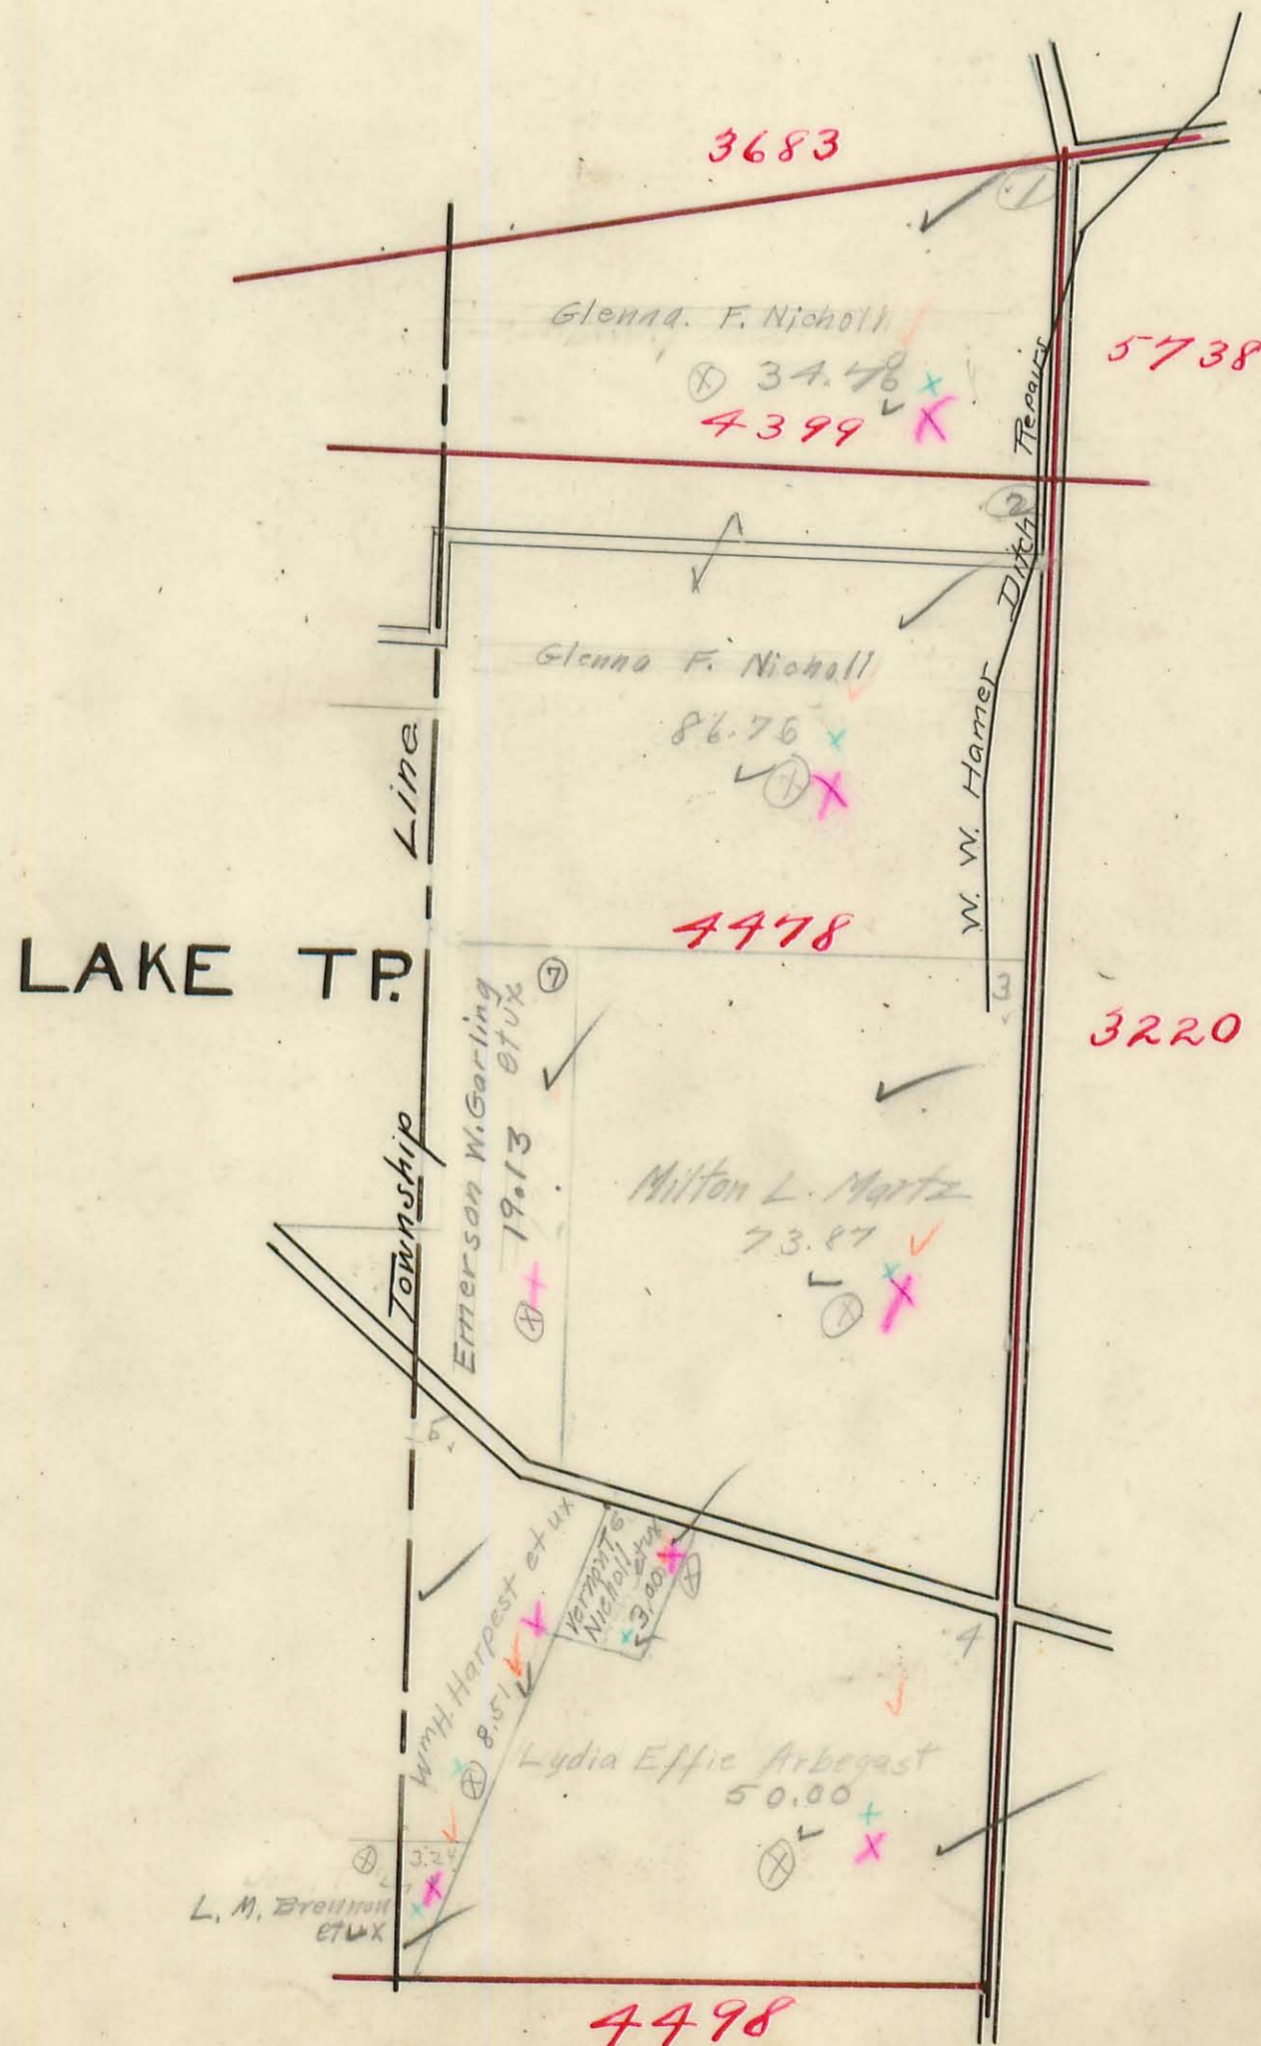


66 x 1200 (18.2)
66
528
121

95-75
11.93
8382

JEFFERSON TOWNSHIP.

Plat of Virginia Military Survey No. 3220


Scale: 1 inch = 10 chains.

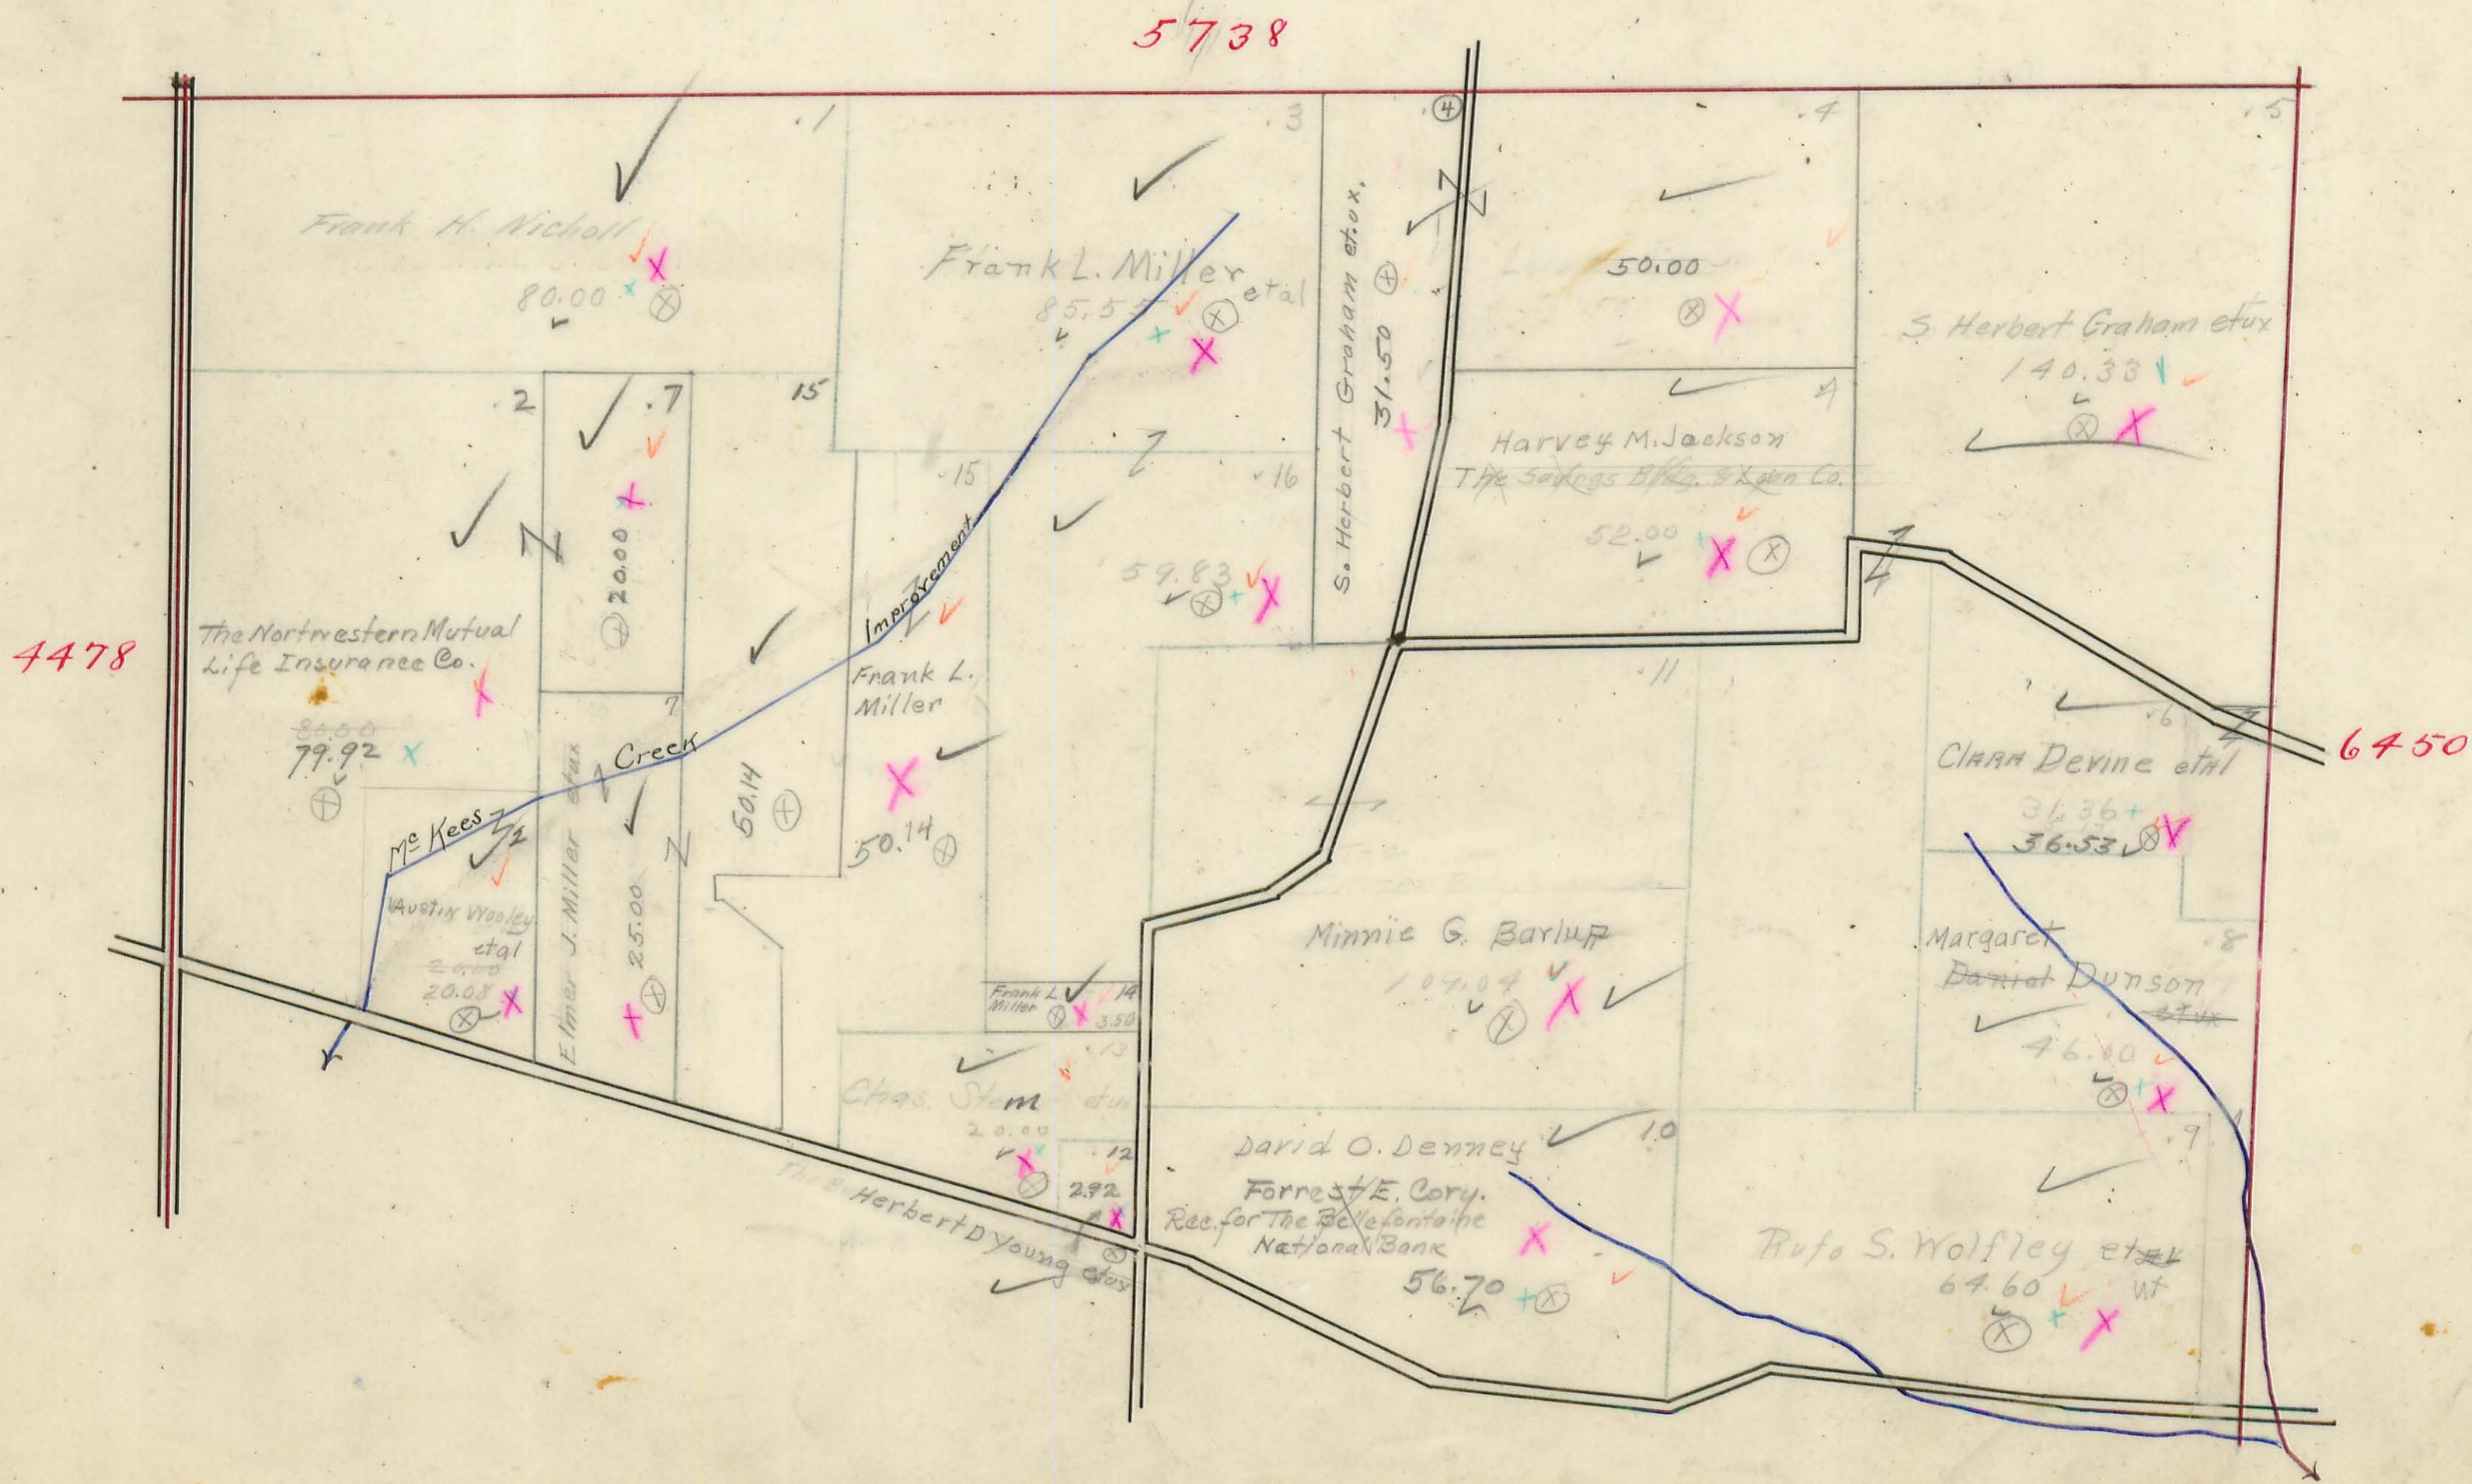

JEFFERSON TOWNSHIP.

Plat of Virginia Military Survey No. 3220


Scale: 1 inch = 10 chains.

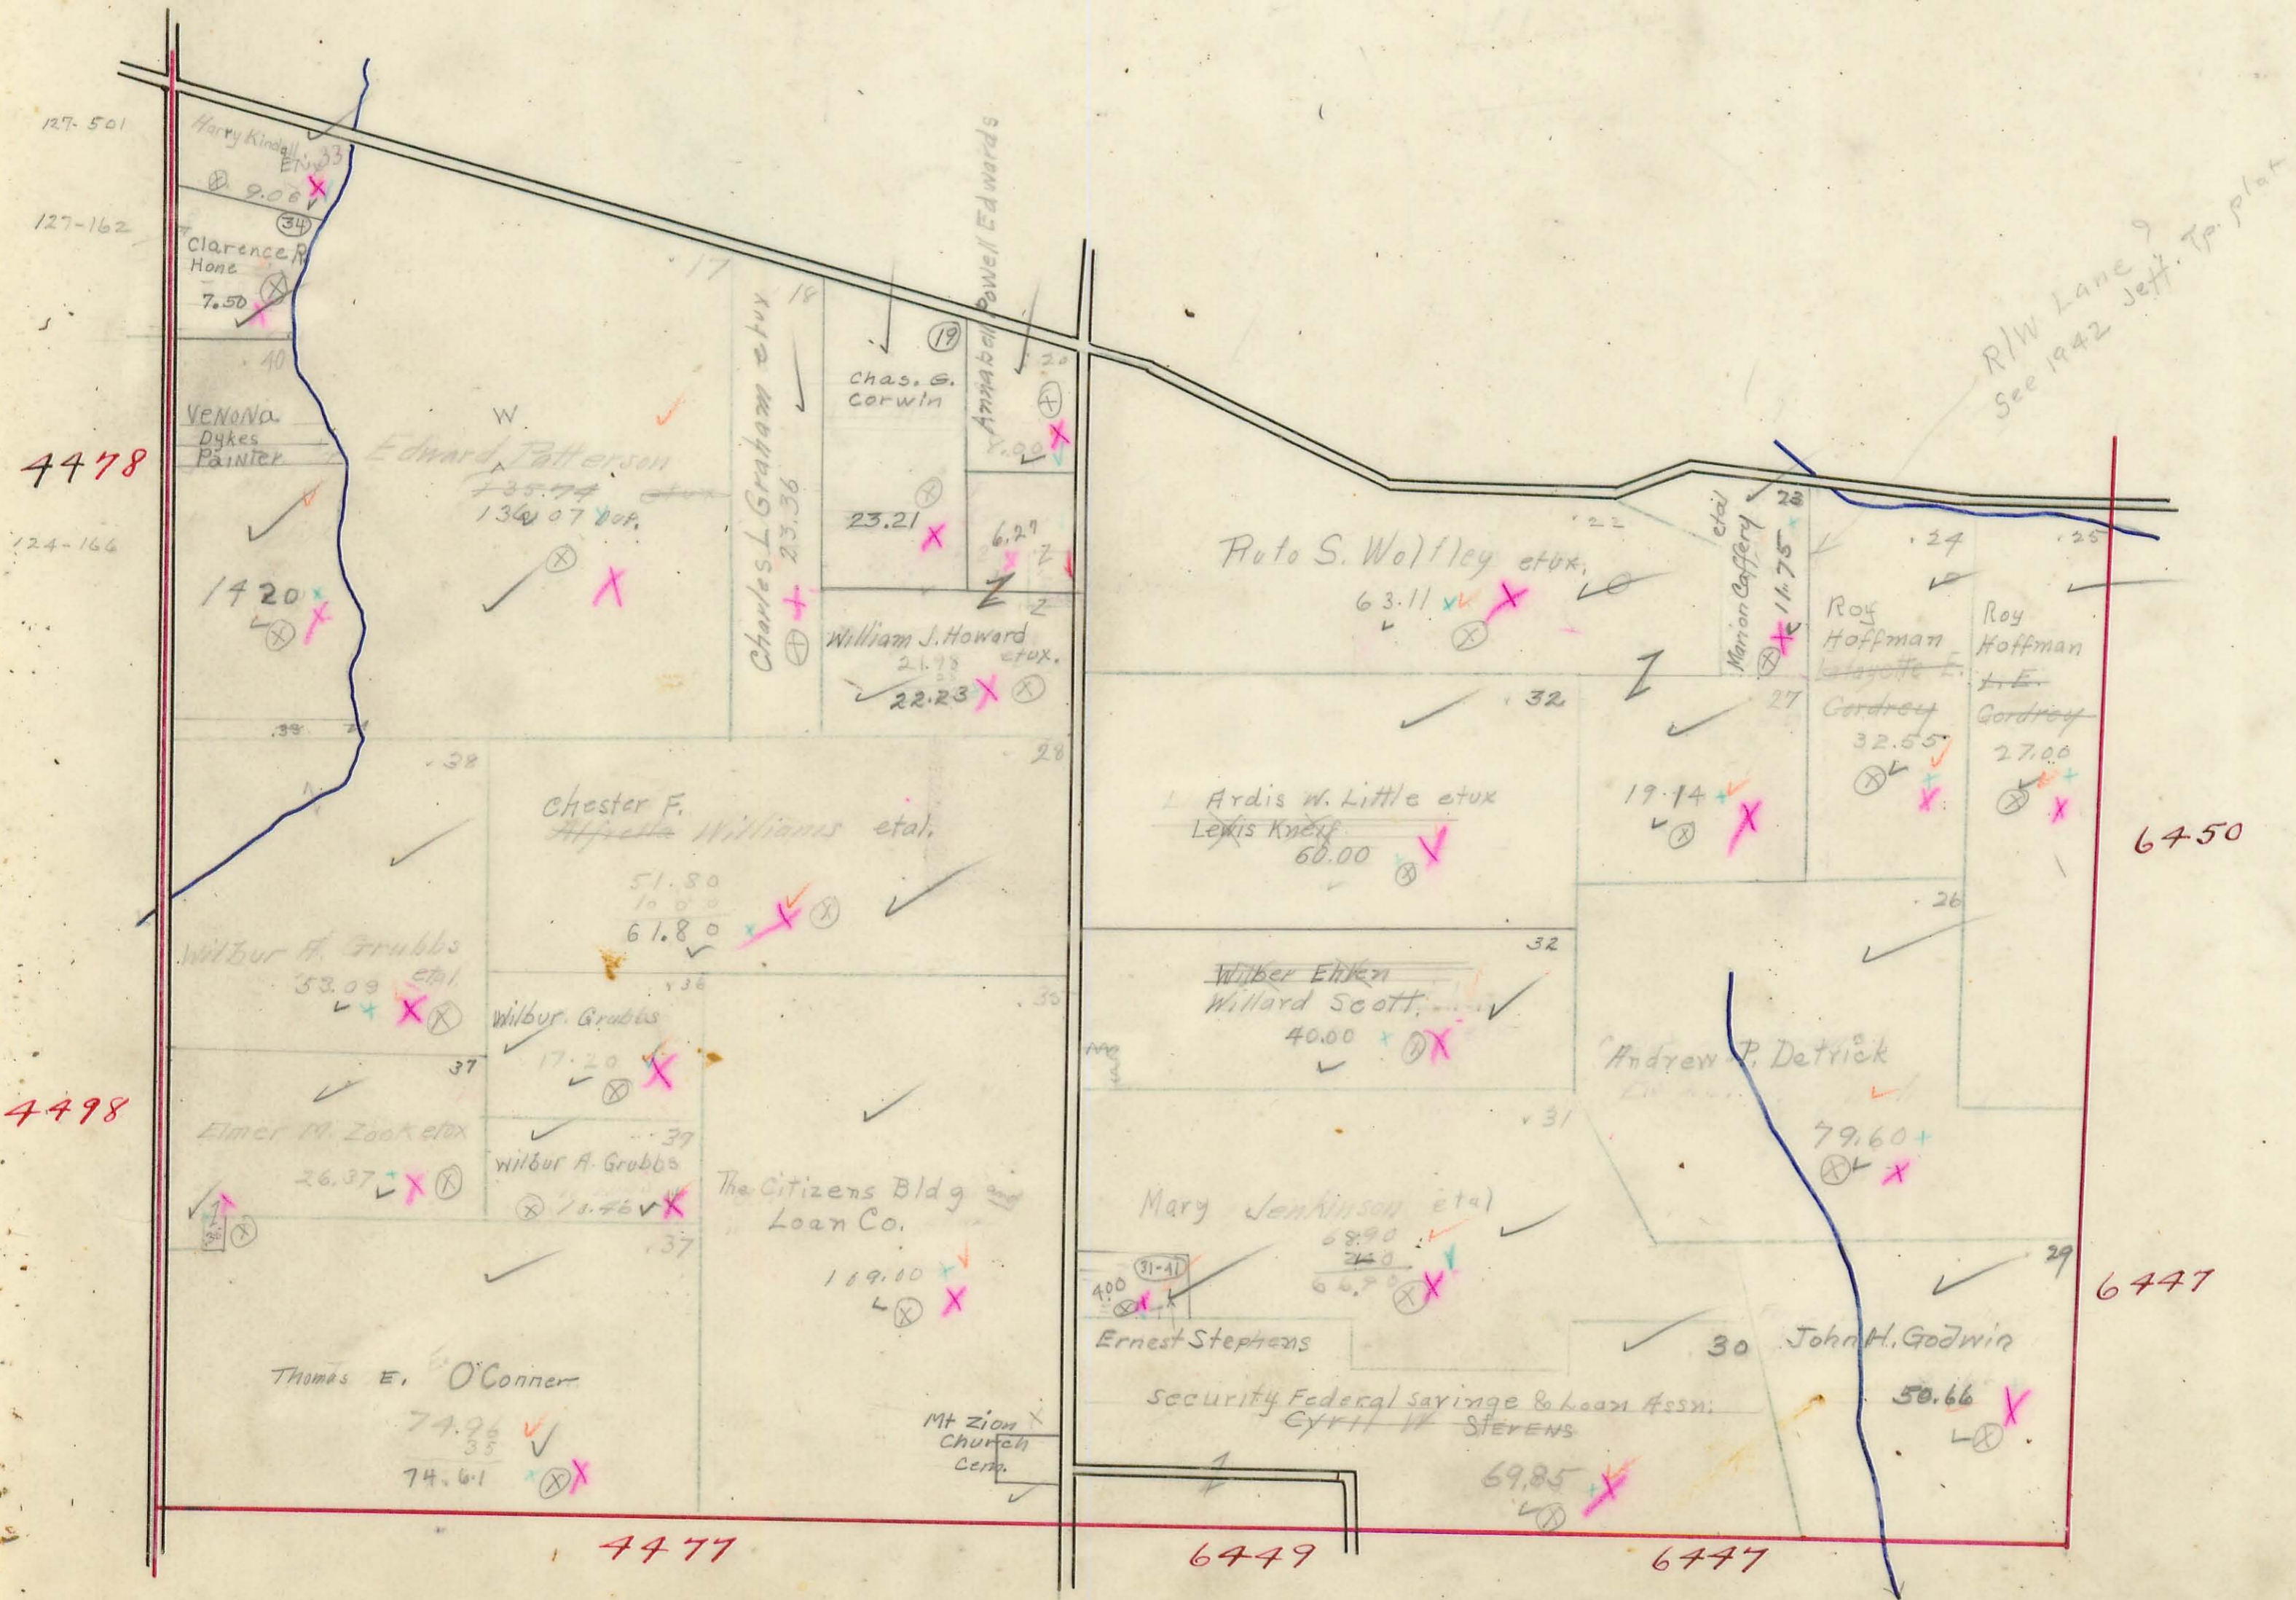

JEFFERSON TOWNSHIP.

Plat of Virginia Military Survey No. 6450

Scale: 1 inch = 10 chains.

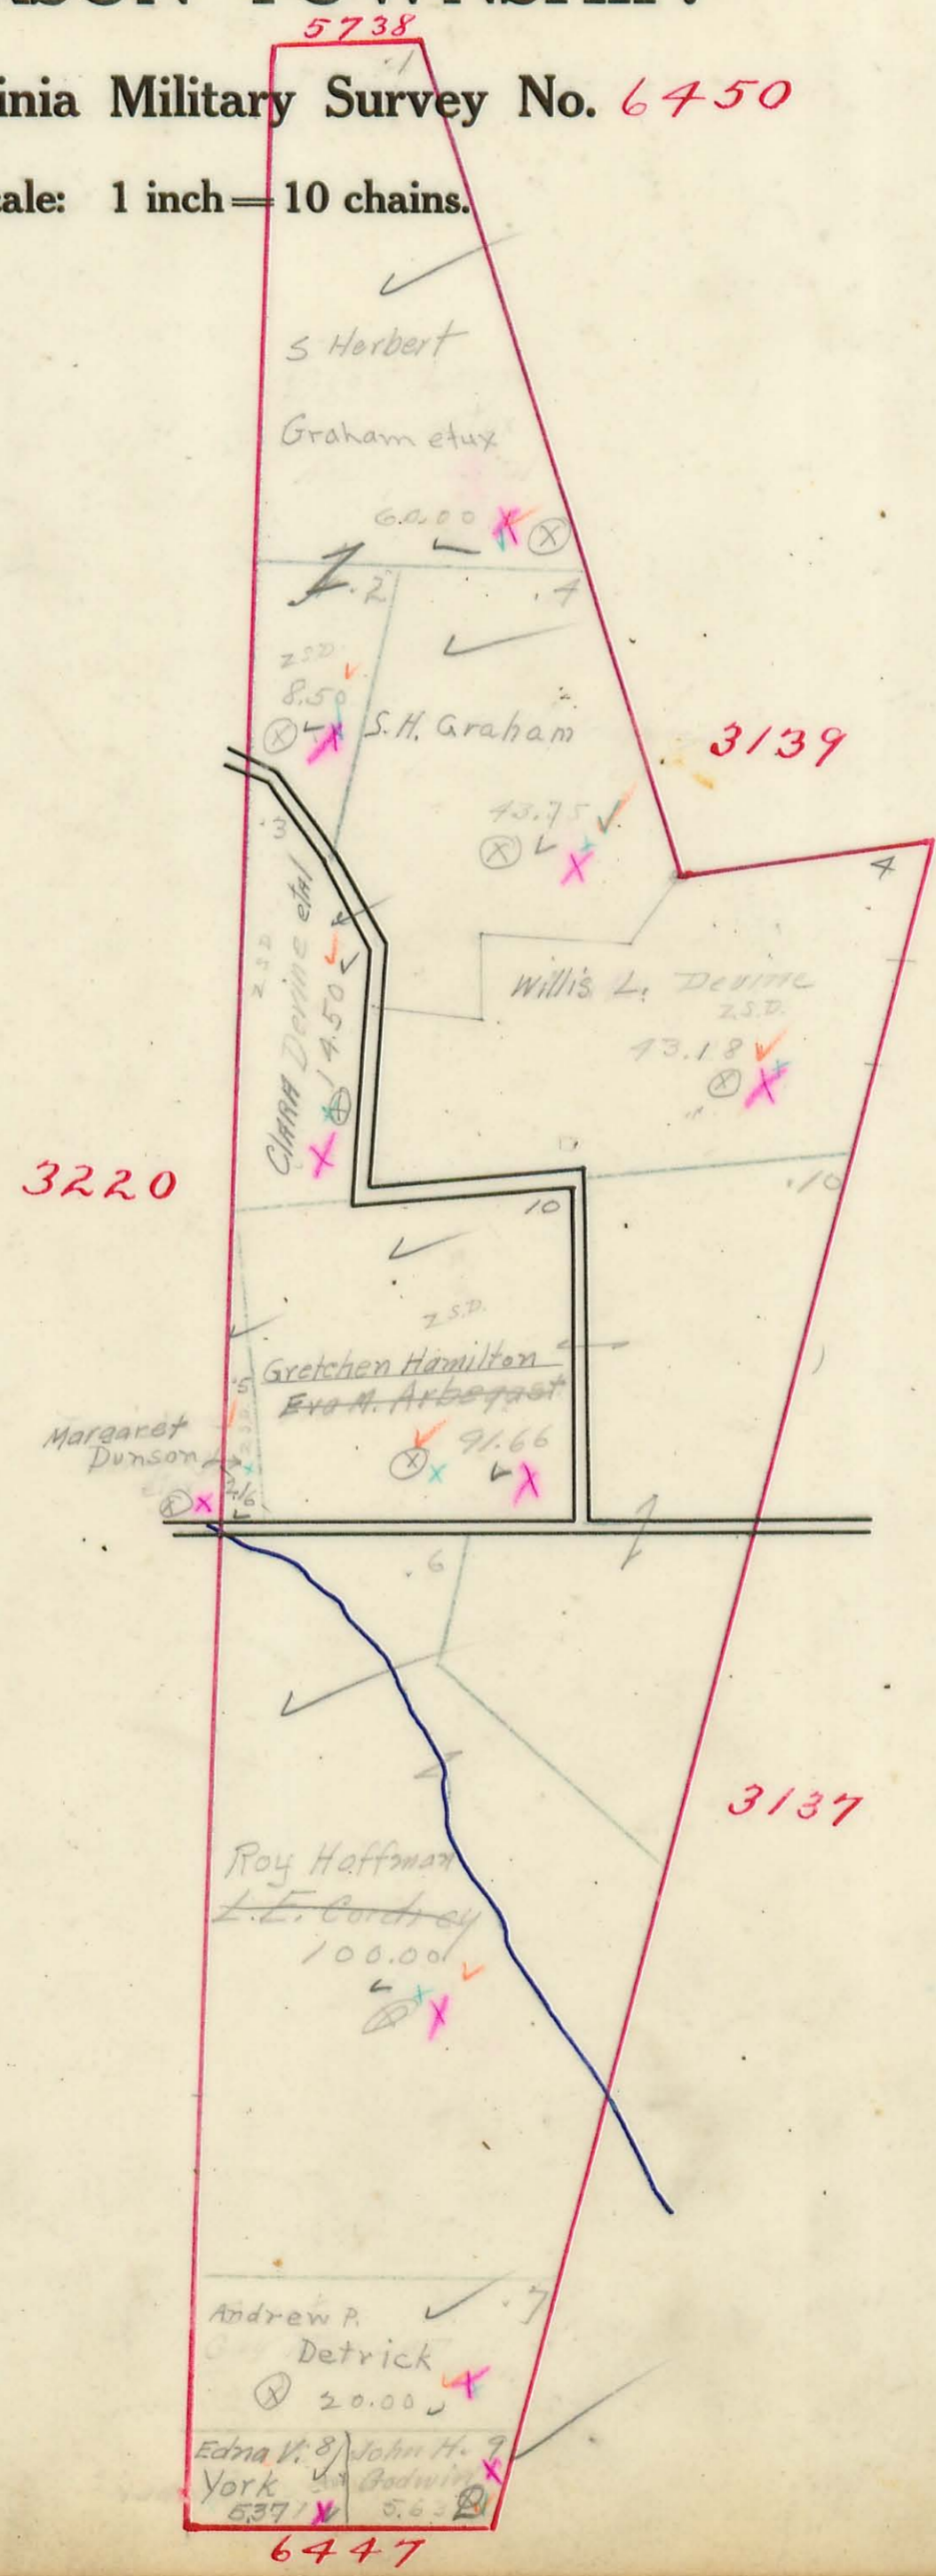


JEFFERSON TOWNSHIP.


Scale: 1 inch = 10 chains.

545
450


all land in Z.S.D.
except land 27.22-26

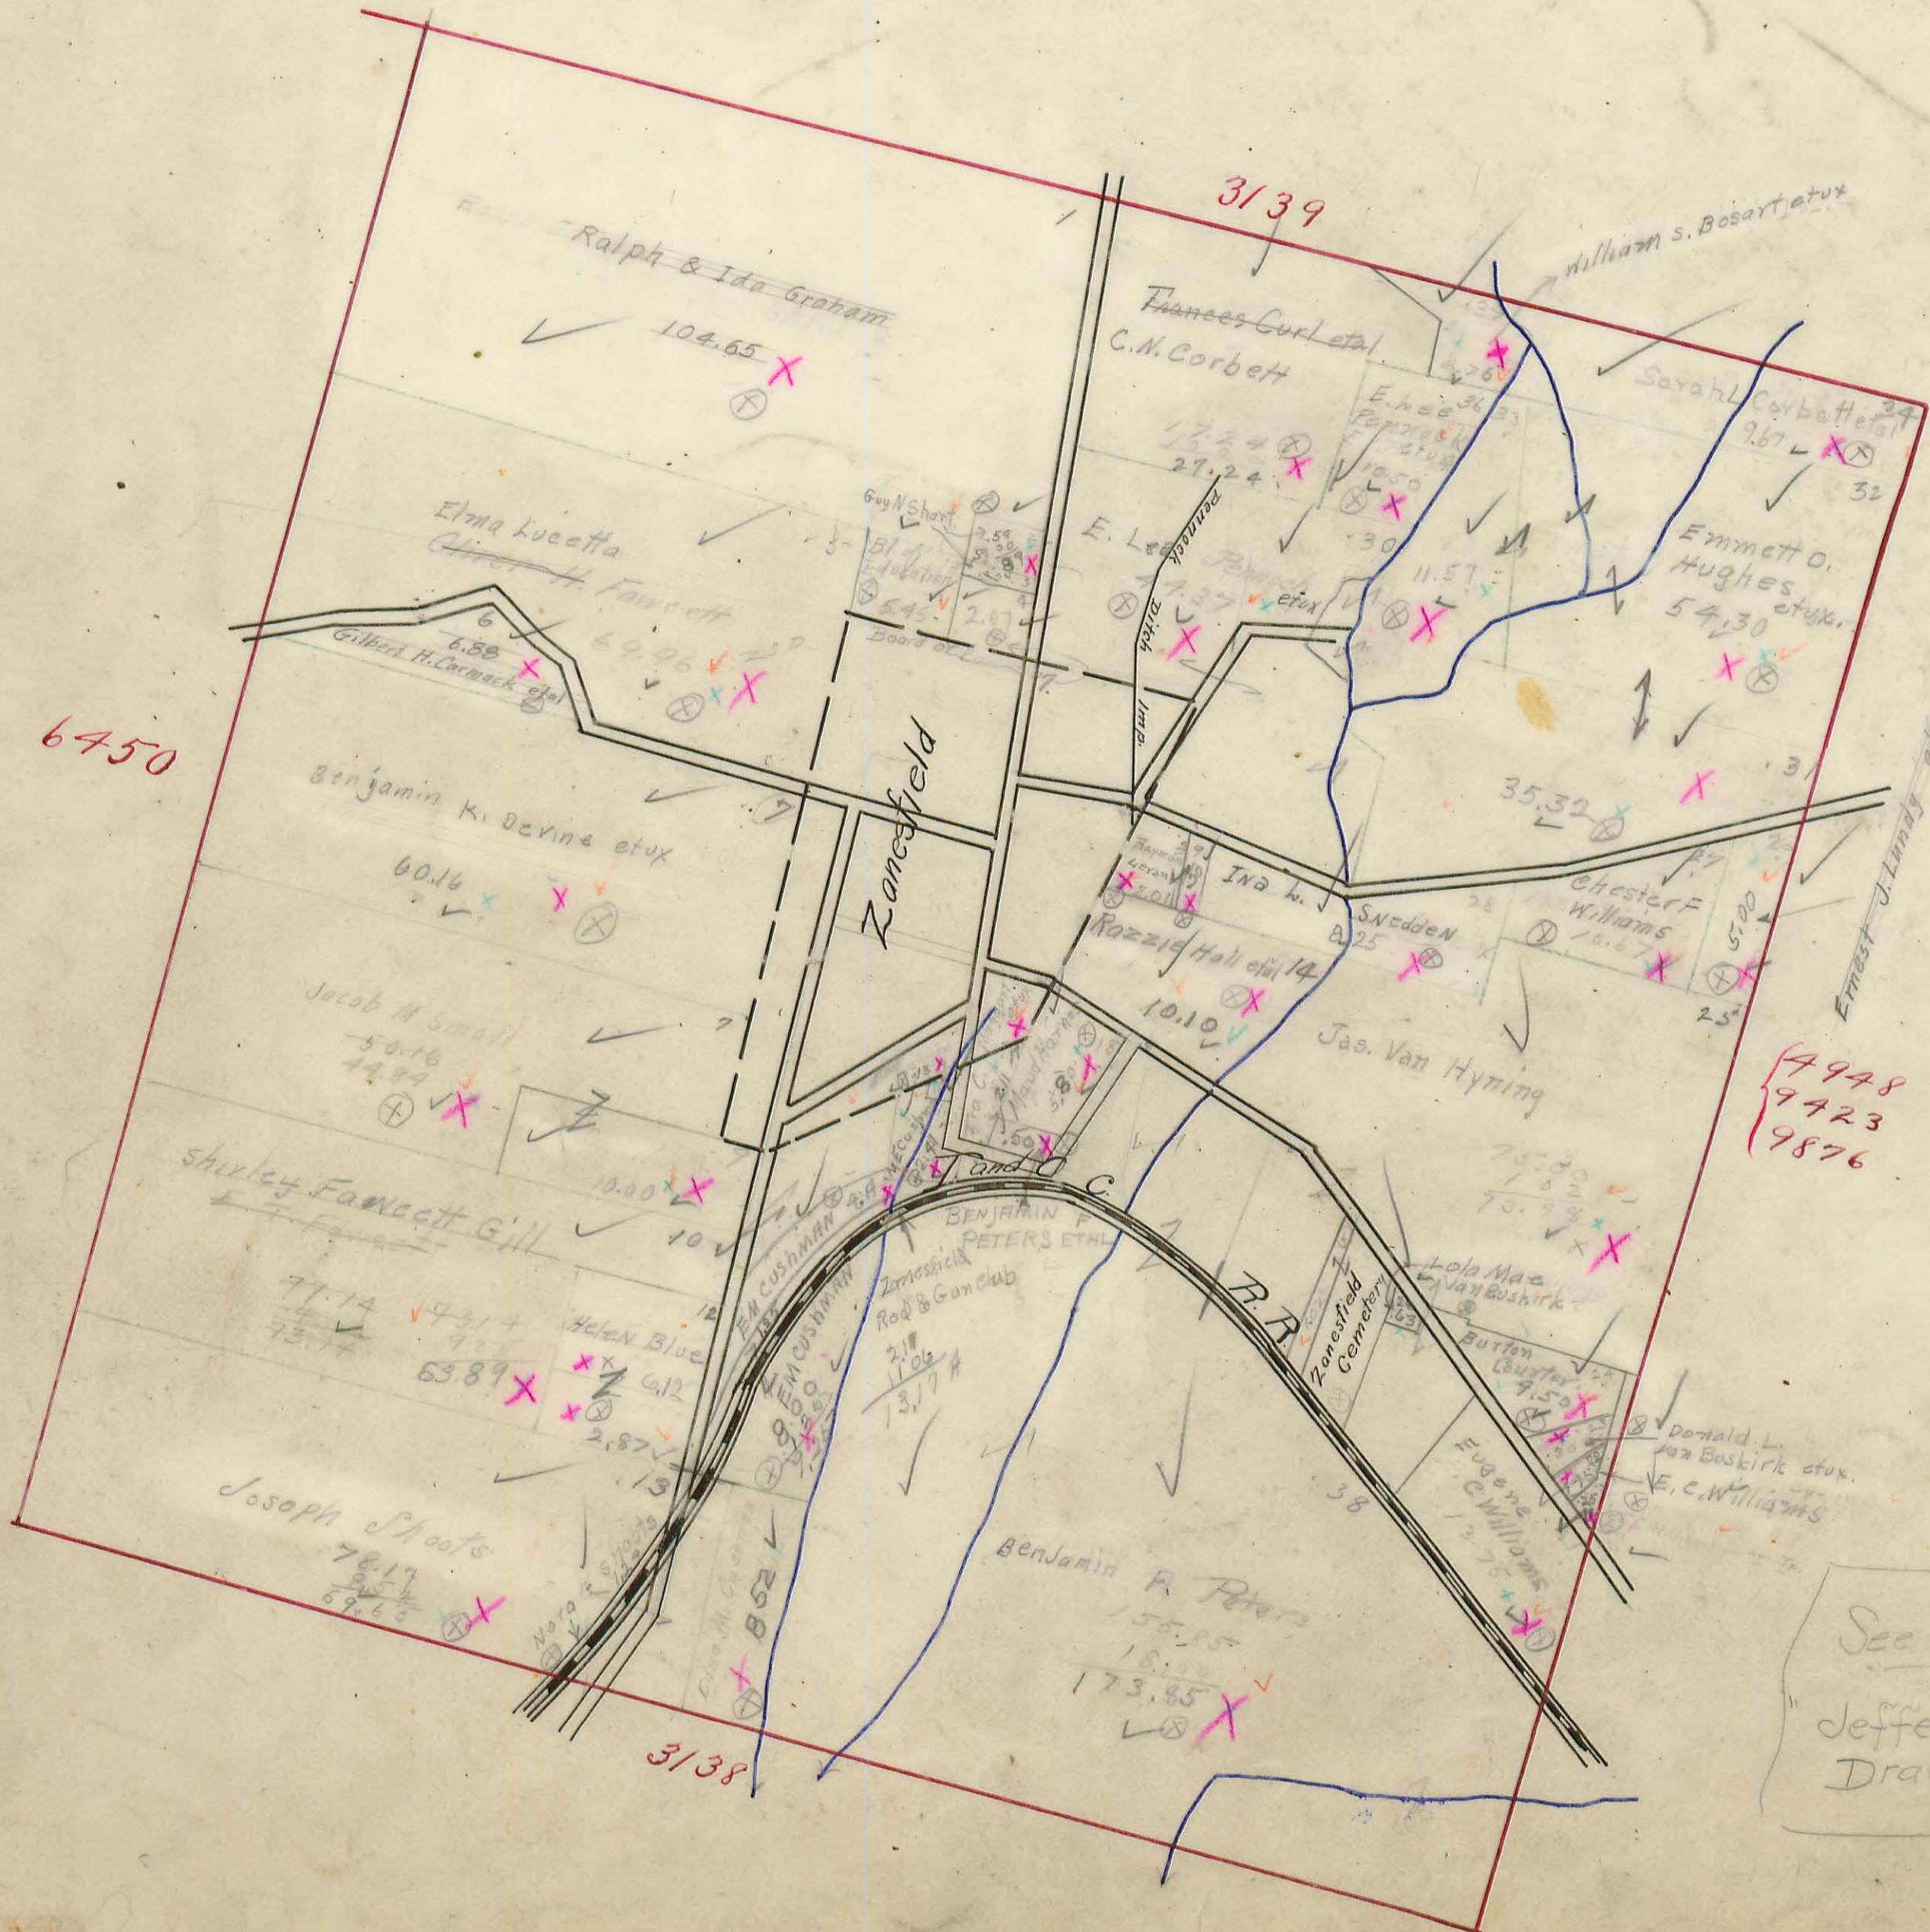

JEFFERSON TOWNSHIP.

Plat of Virginia Military Survey No. ⁴⁹⁴⁸
9423
9876


Scale: 1 inch = 10 chains.

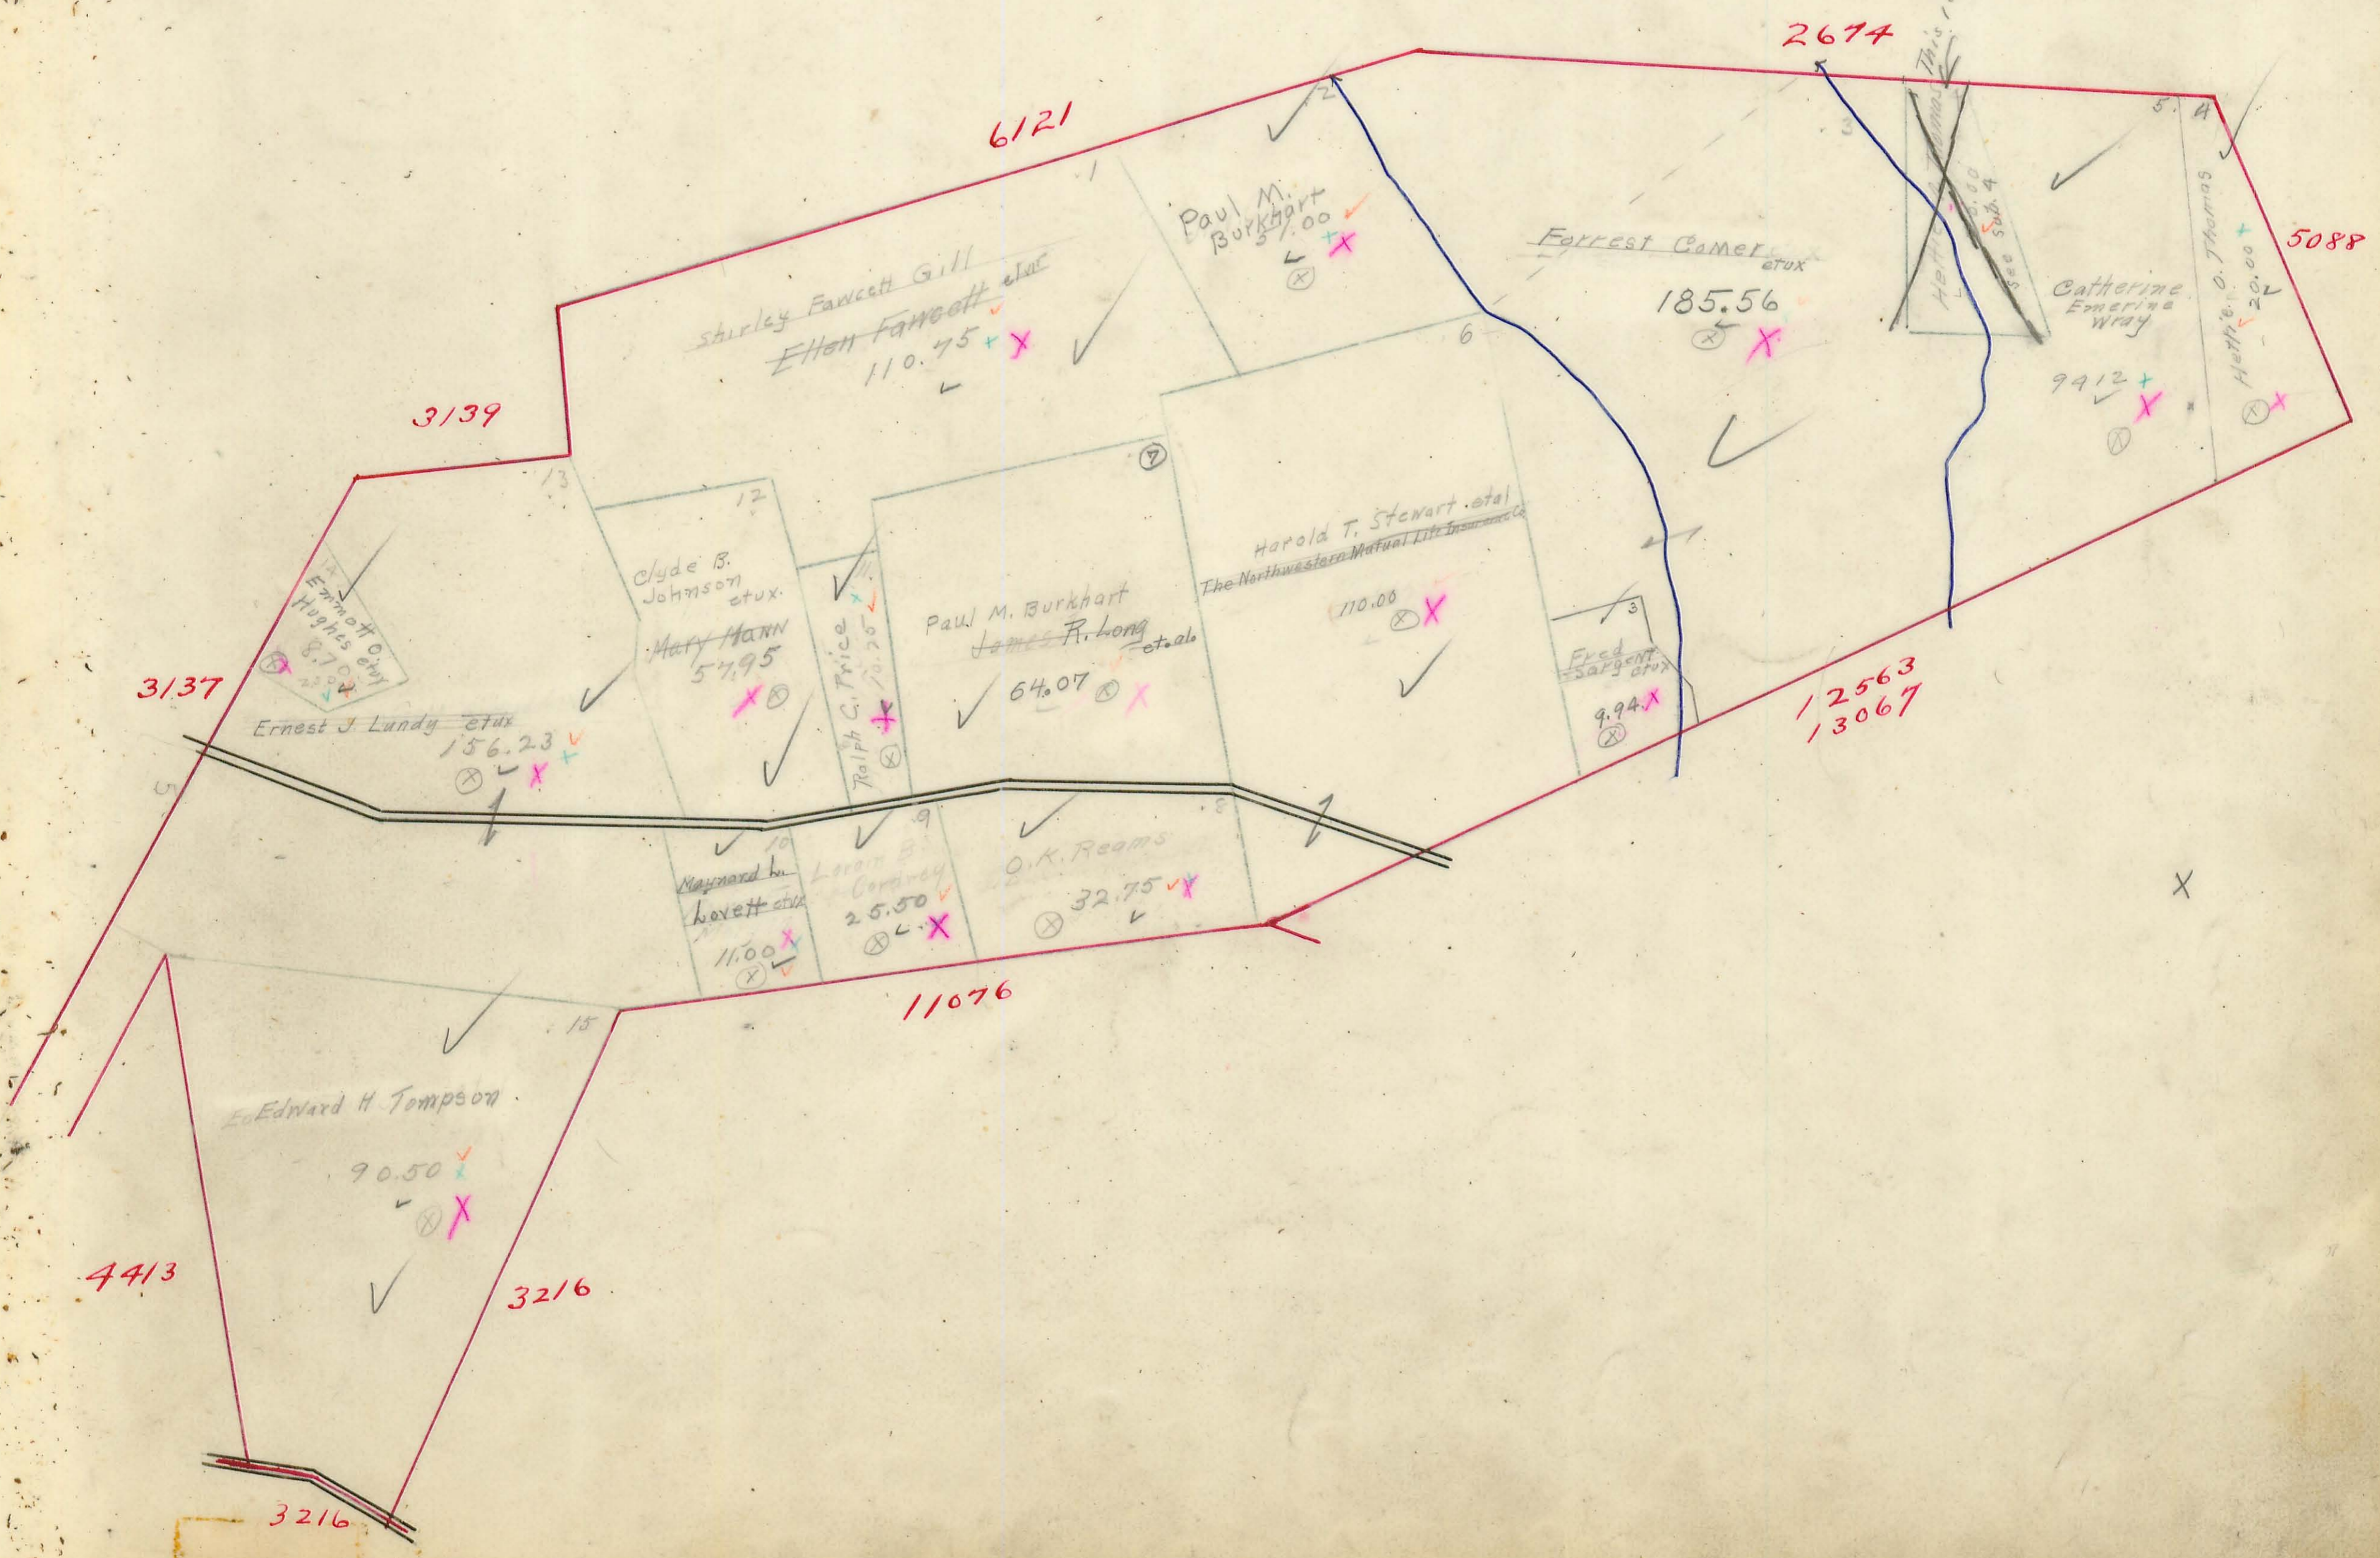

JEFFERSON TOWNSHIP.

Plat of Virginia Military Survey No. 4948
9423
9876
4413
3216

Scale: 1 inch = 10 chains.

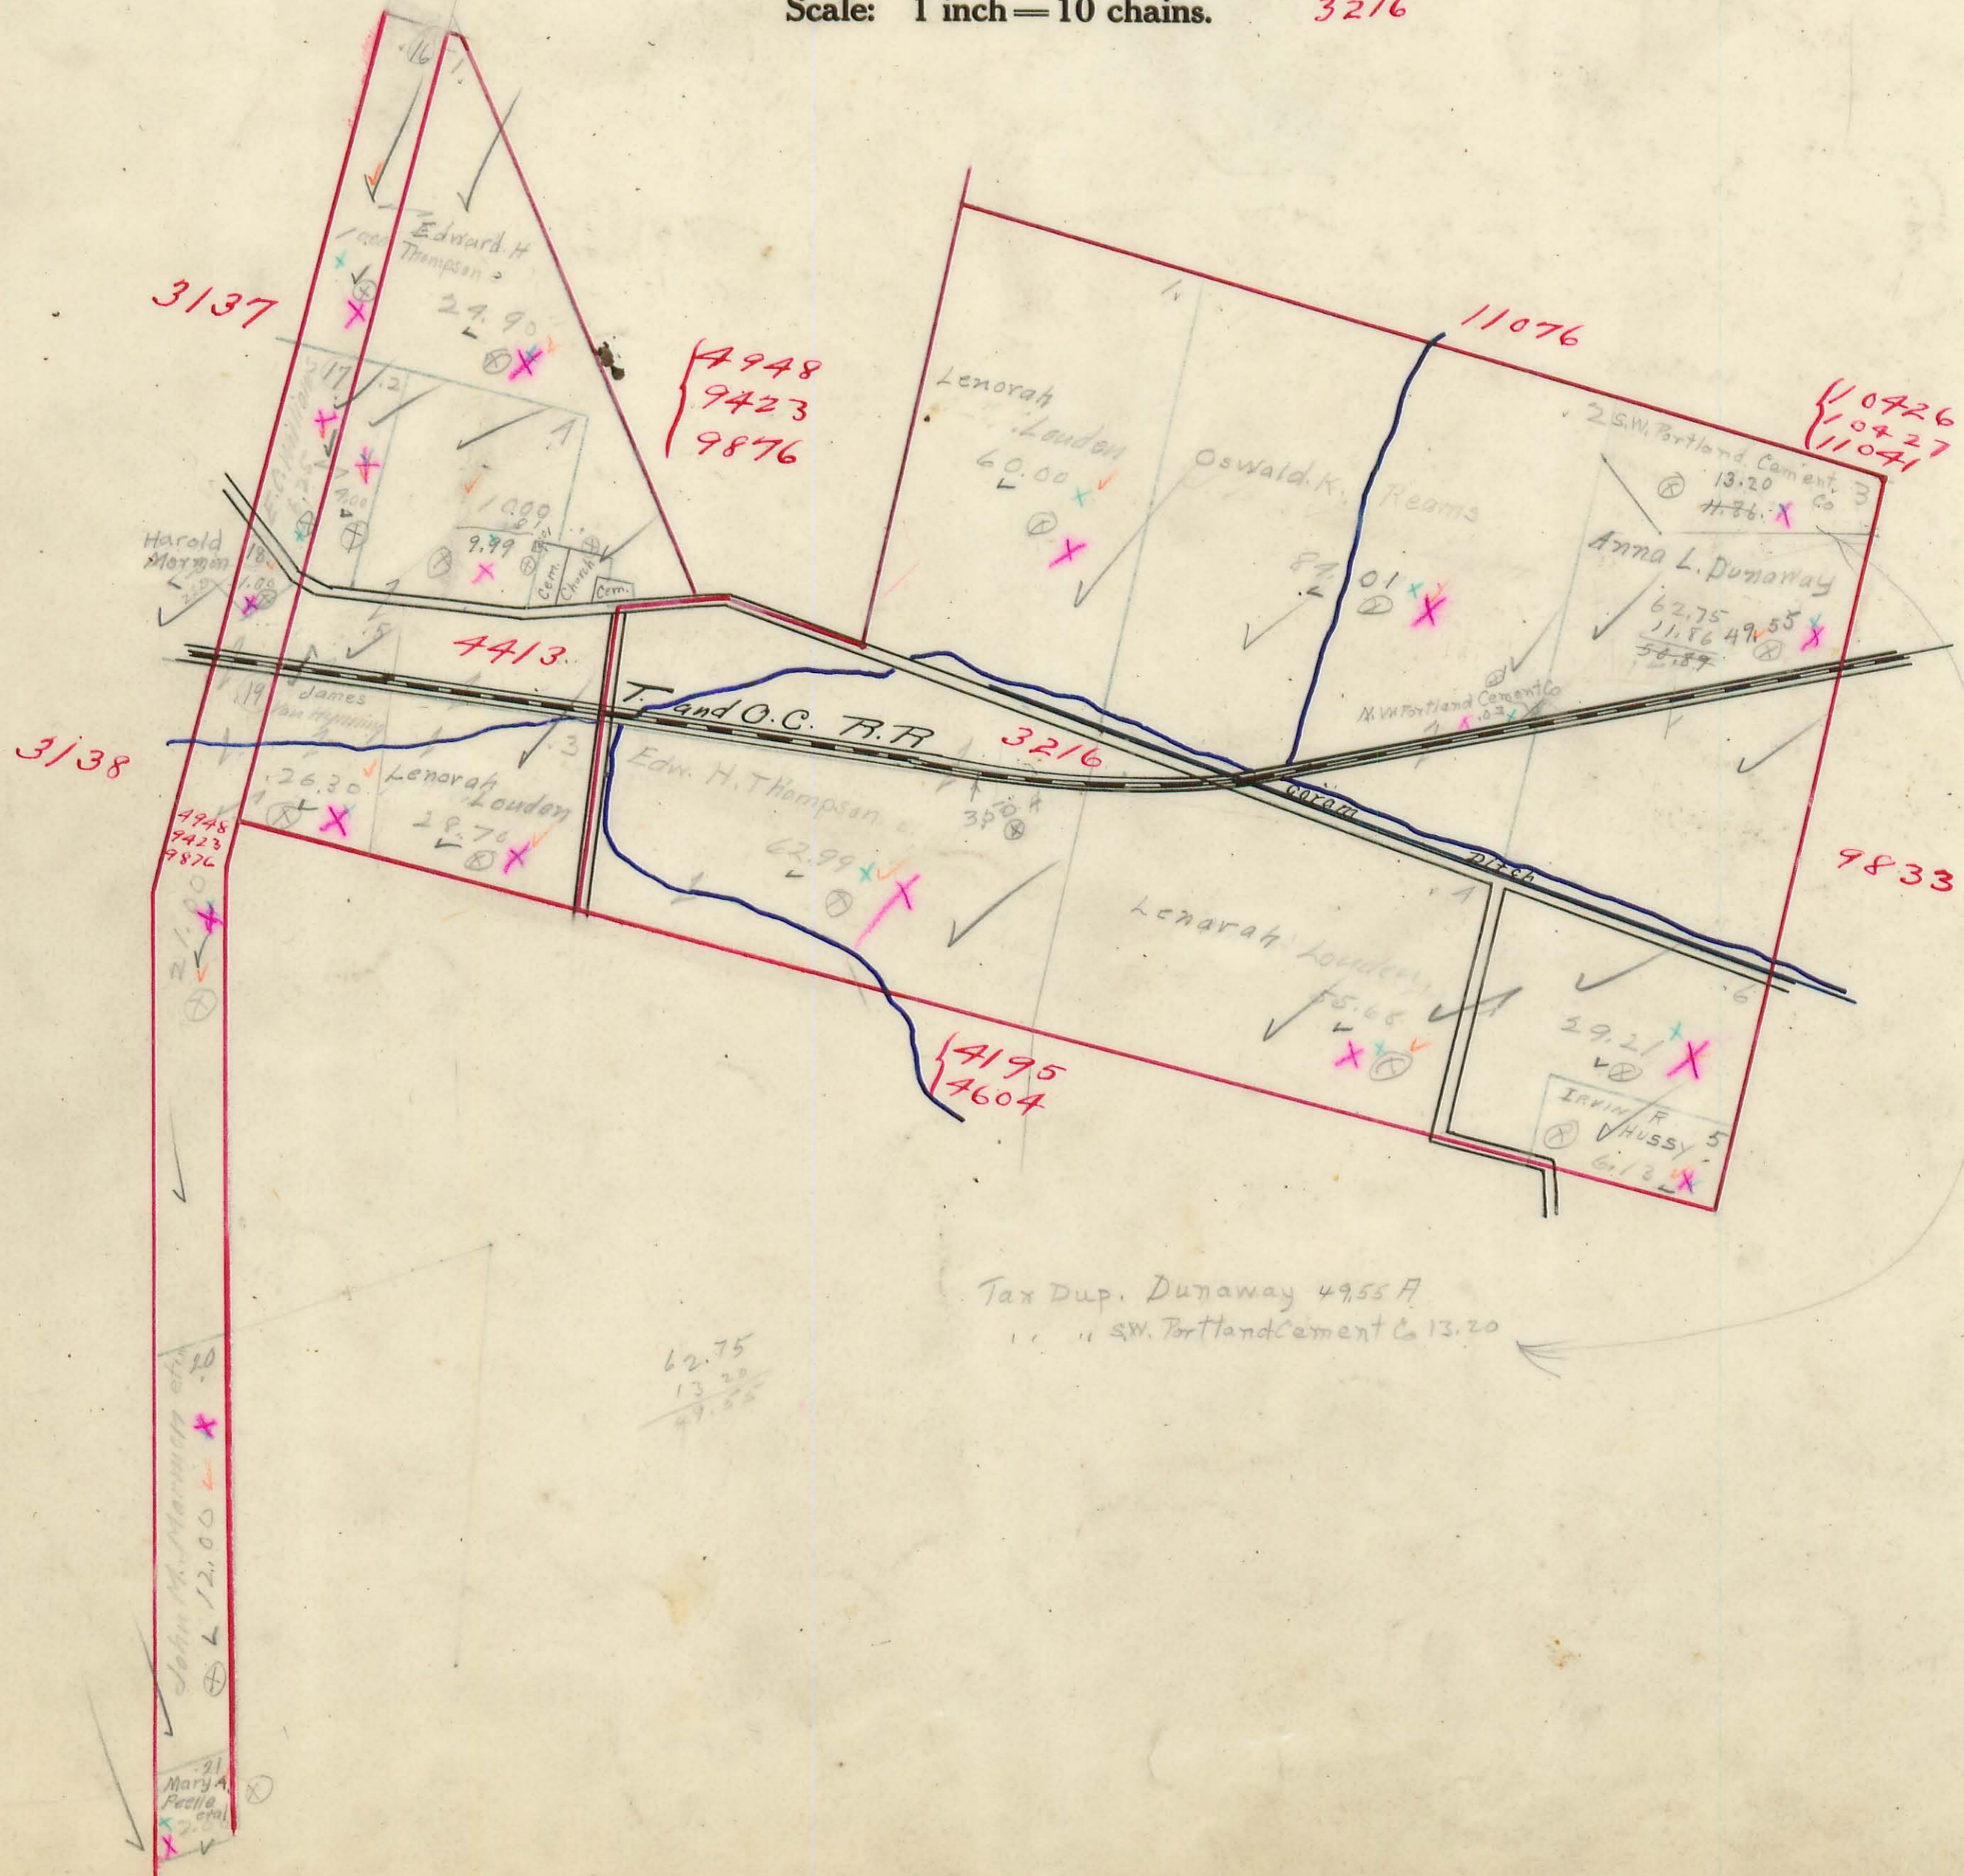


Tax Dup. Dunaway 4955 A
 " " SW. Portland Cement Co 13.20

62.75
 13.20
 49.55

JEFFERSON TOWNSHIP.

Plat of Virginia Military Survey No. ¹⁰⁴²⁶
¹⁰⁴²⁷
¹¹⁰⁴¹
¹¹⁰⁷⁶

Scale: 1 inch = 10 chains.

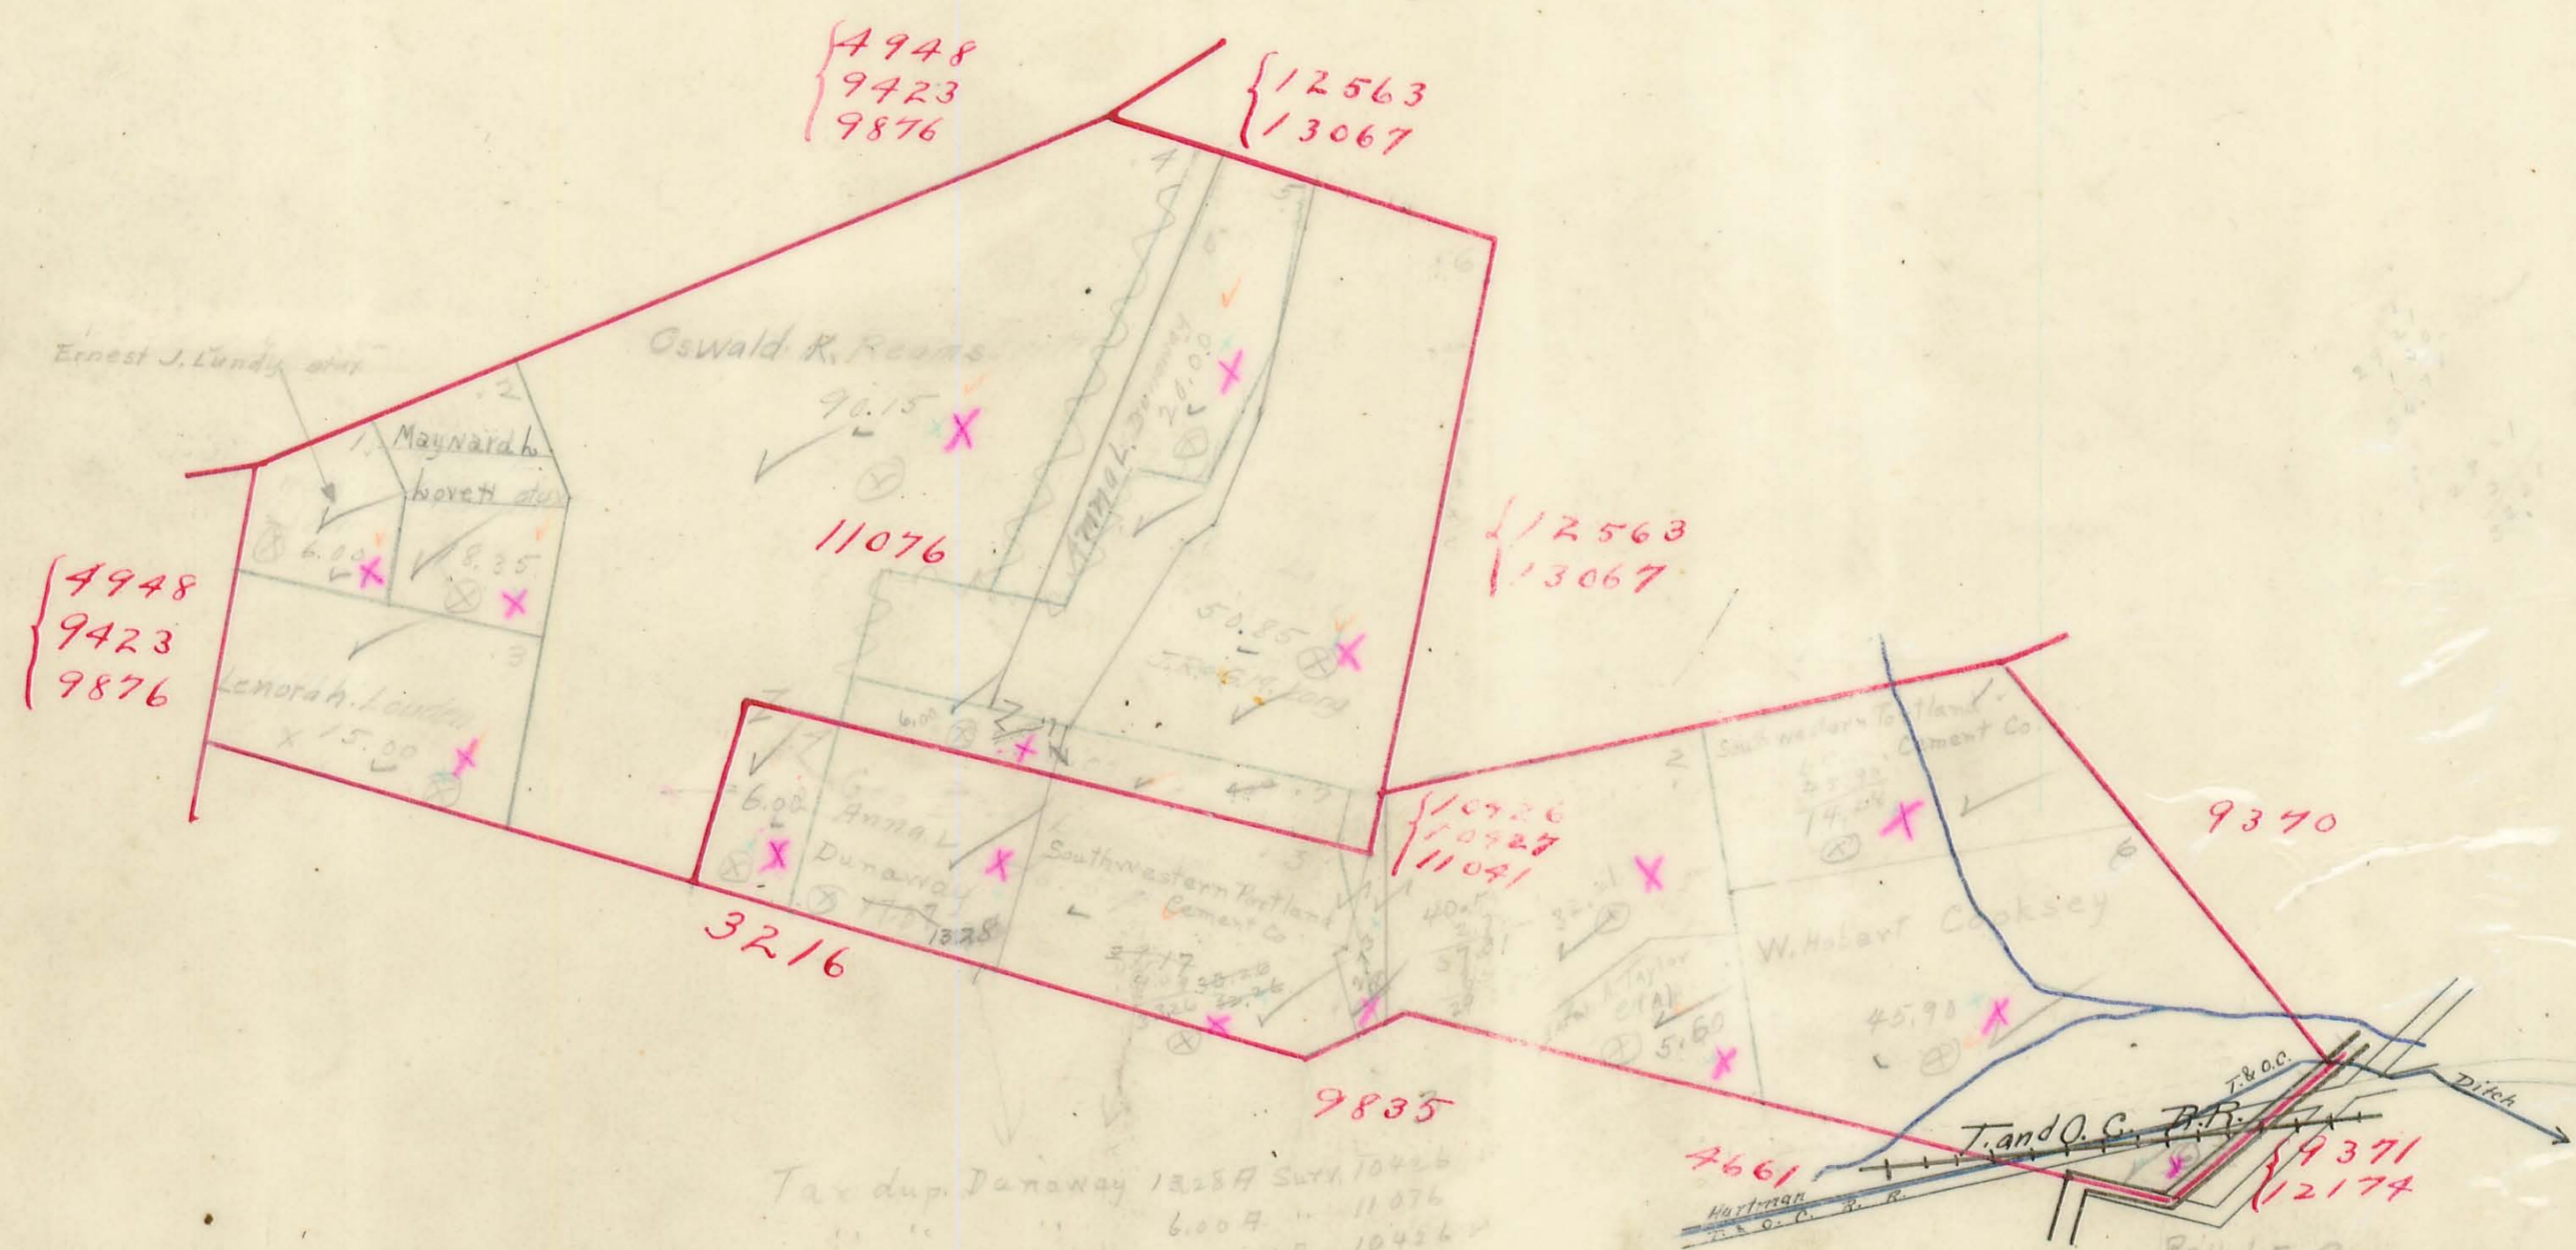


Tax dup. Duraway 1225A SW 10426
 6.00 A " 11076
 " SW Portland Cement Co 3226A " 10426
 32.21 A " 11076
 " SW Portland Cement Co 5.66 A " 10426

11.86
 28.17
 27.00
 24.21
 14.48
 91.45

JEFFERSON TOWNSHIP.

Plat of Virginia Military Survey No. { 12563
13067
9372
5088


Scale: 1 inch = 10 chains.

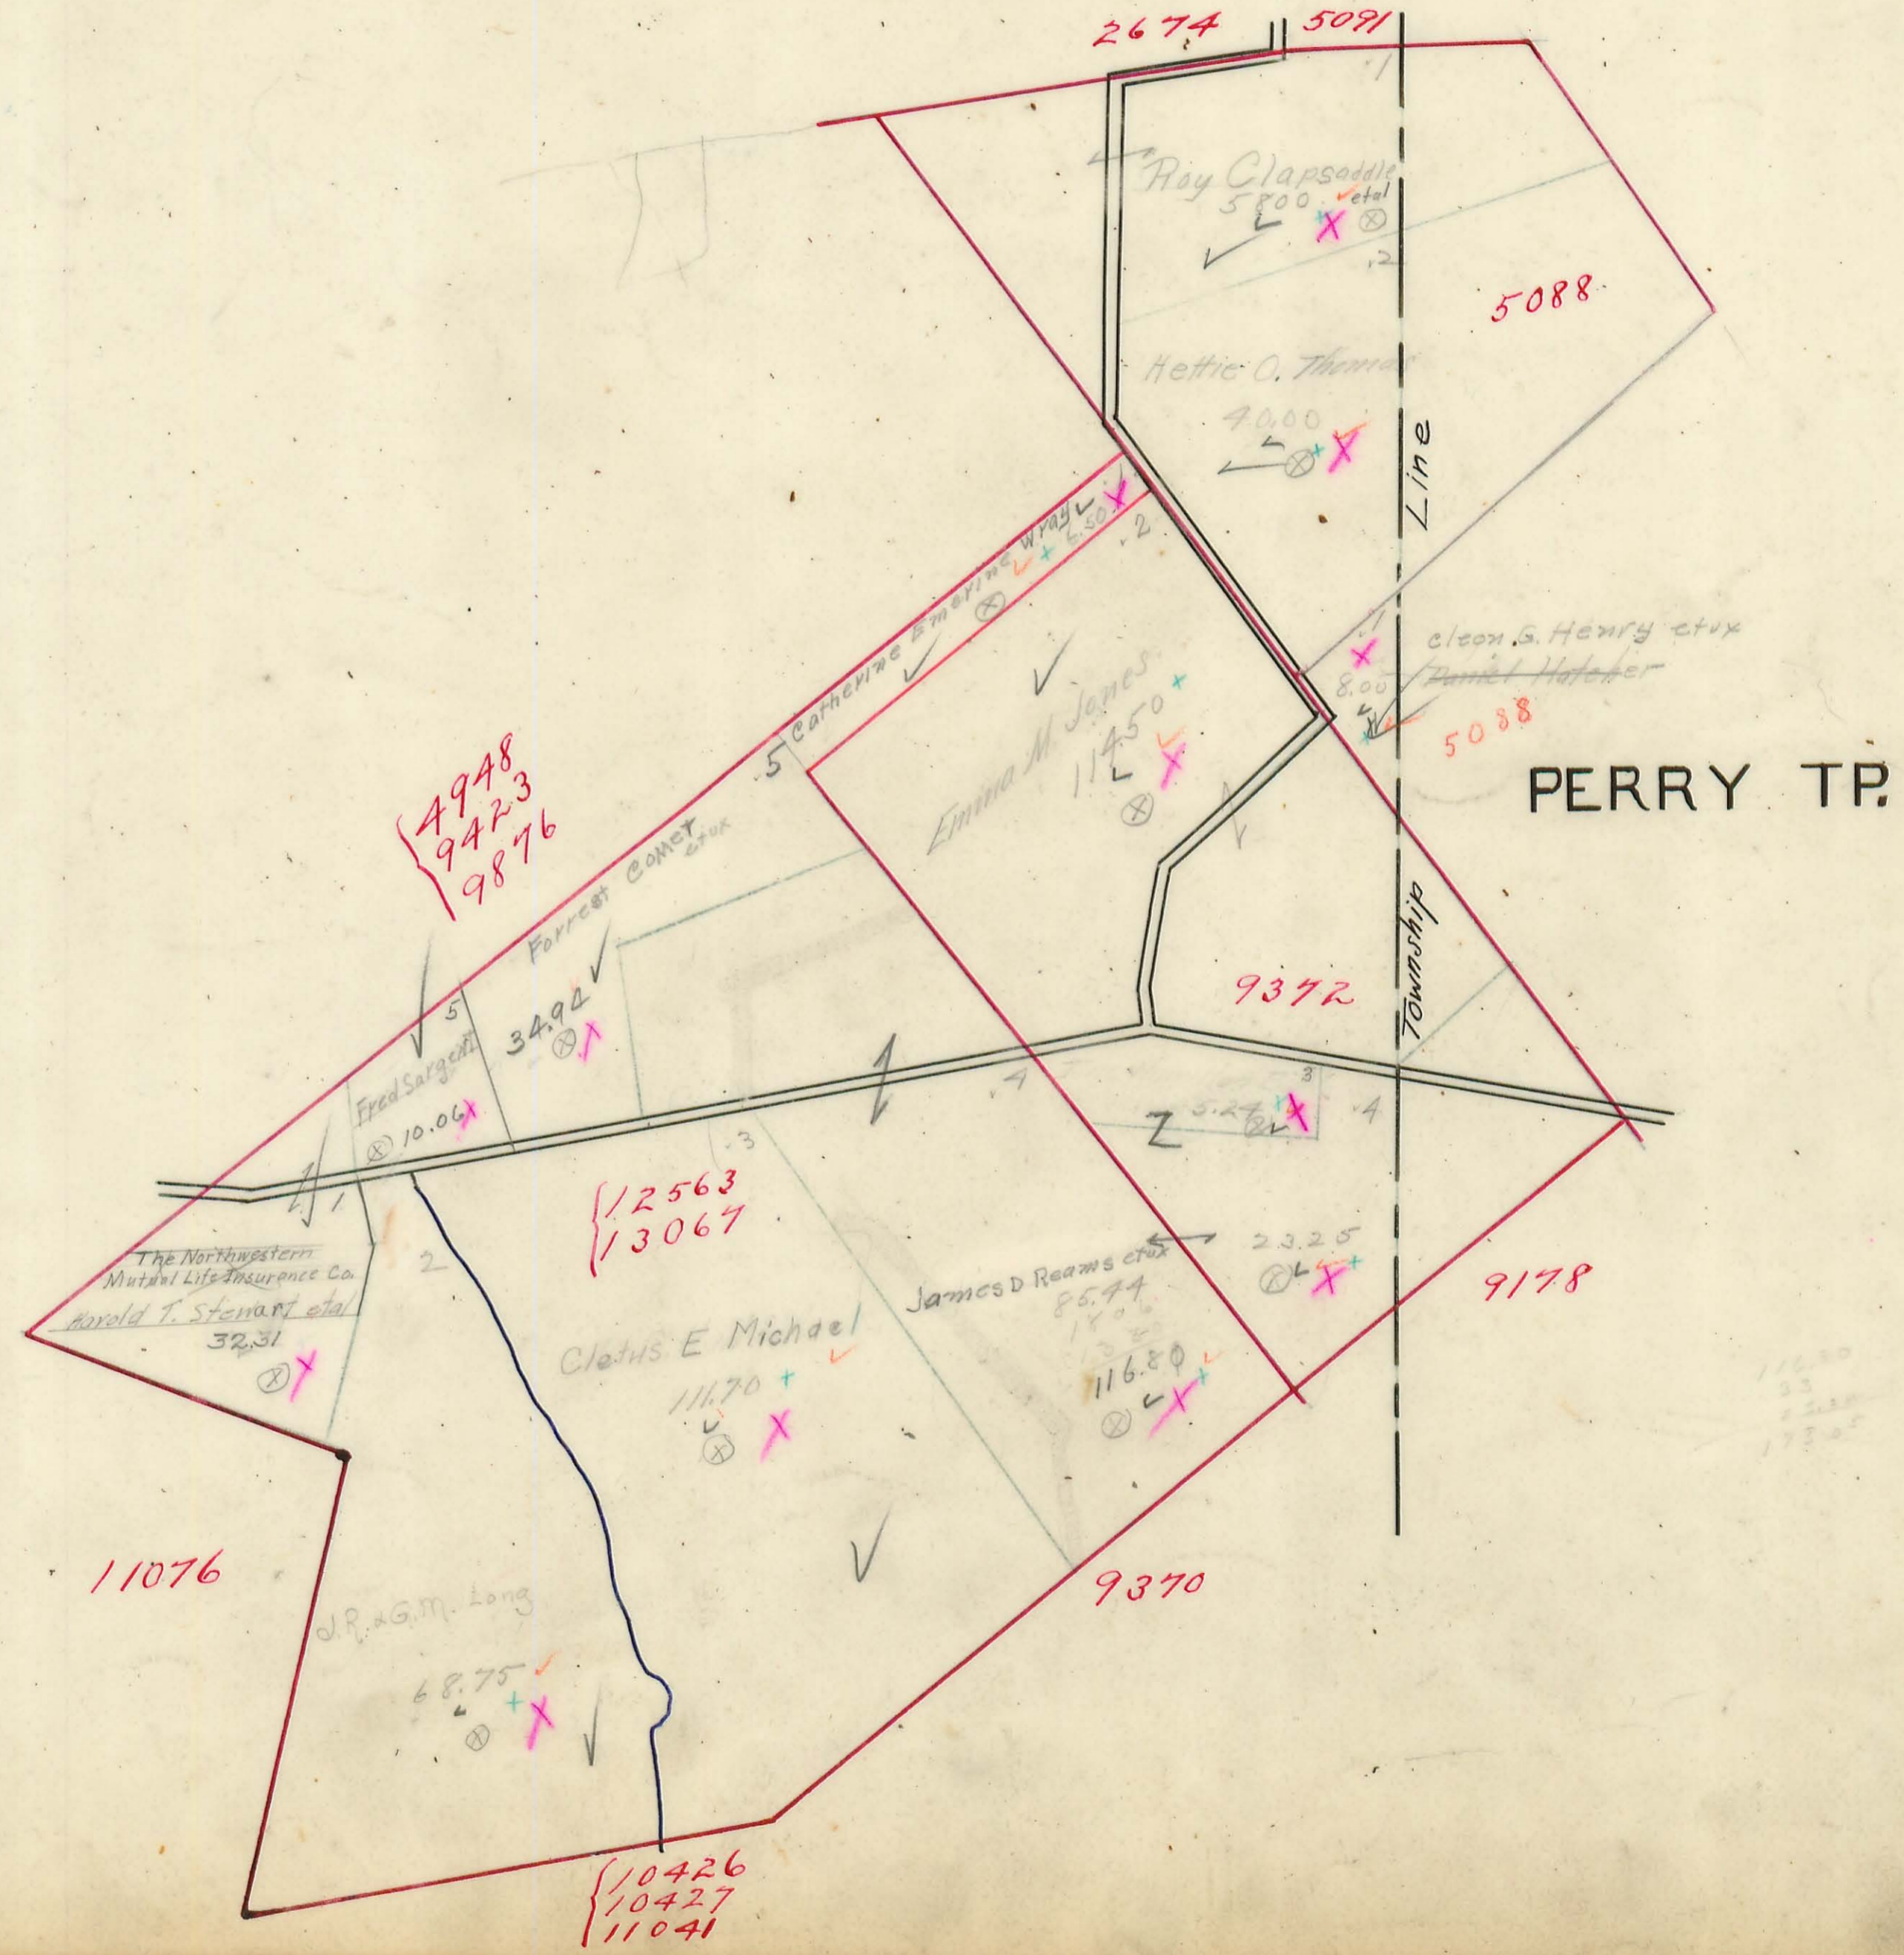

JEFFERSON TOWNSHIP.

Plat of Virginia Military Survey No. ⁹¹⁷⁸ 9370

Scale: 1 inch = 10 chains. { 9371
12174

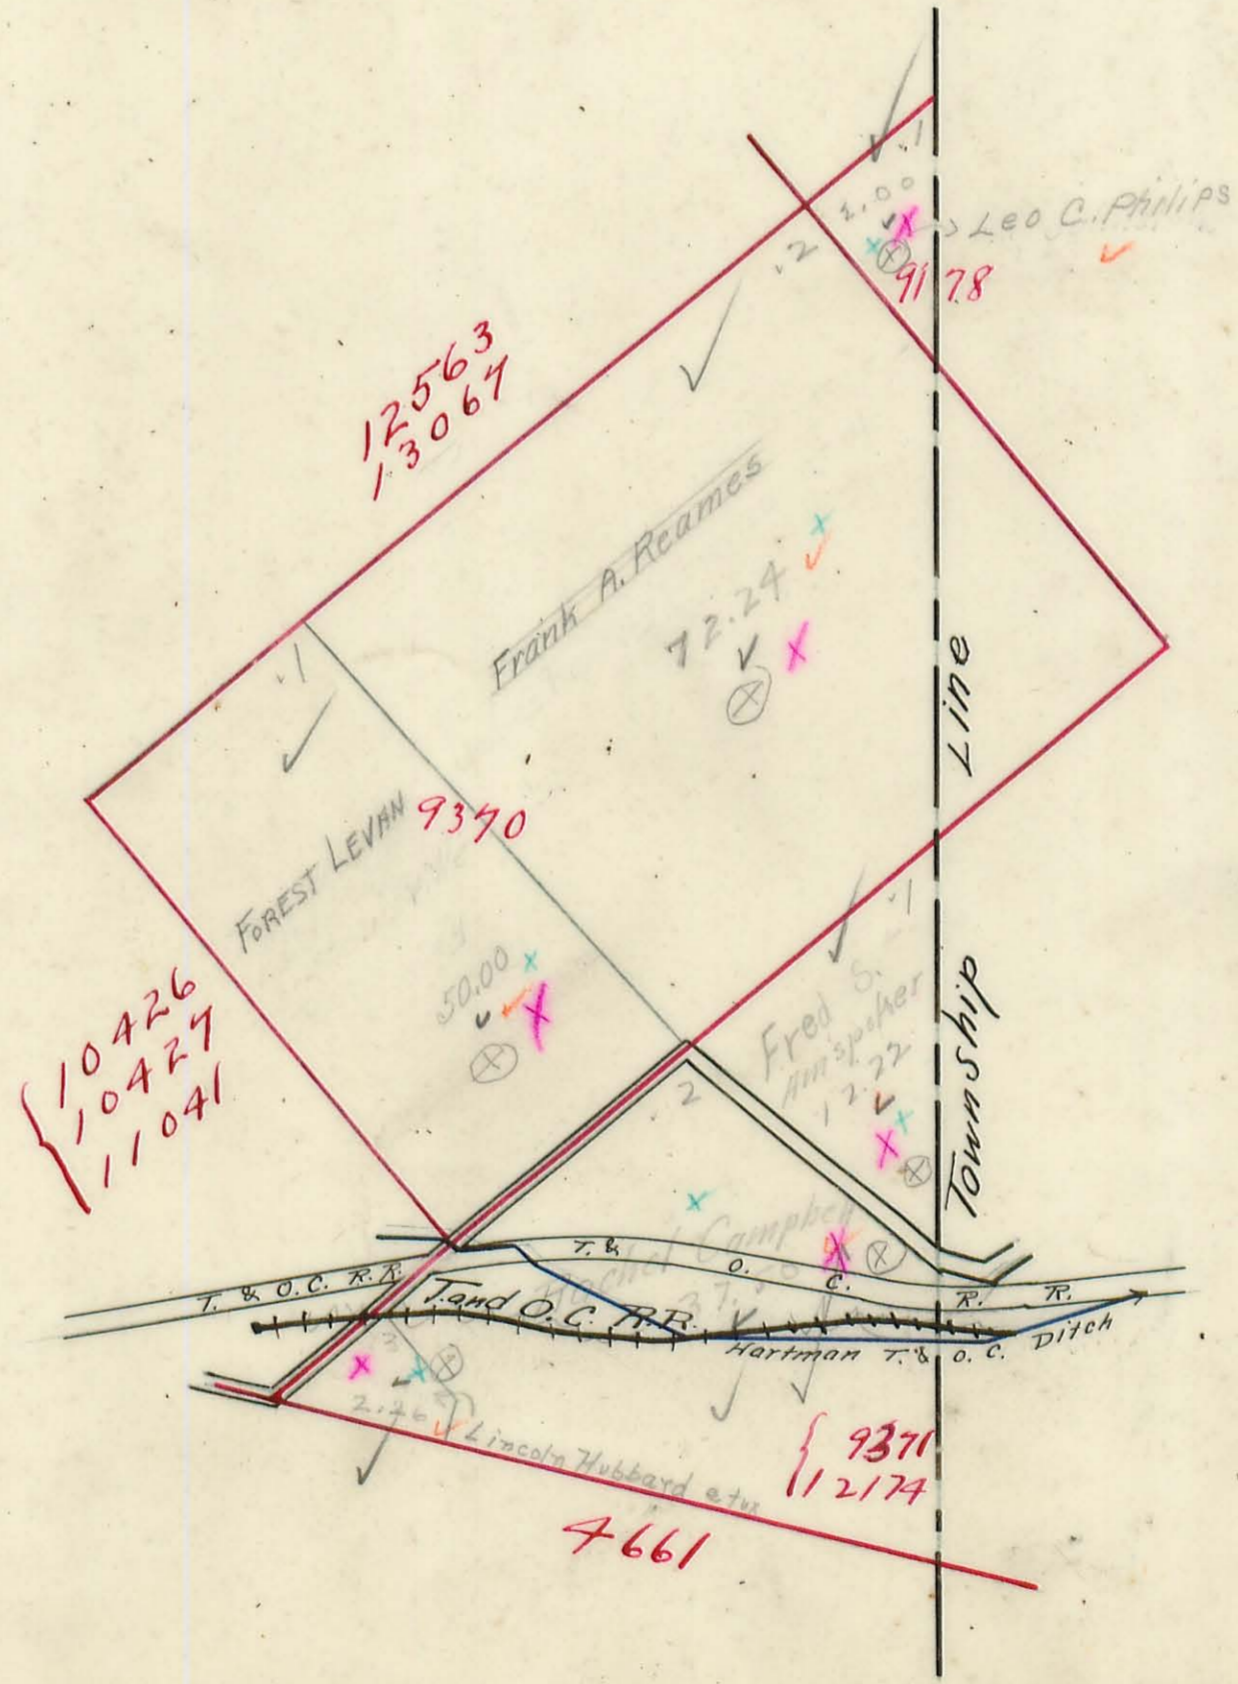


PERRY TP.

JEFFERSON TOWNSHIP.

Plat of Virginia Military Survey No. **4498**
5864


Scale: 1 inch = 10 chains.

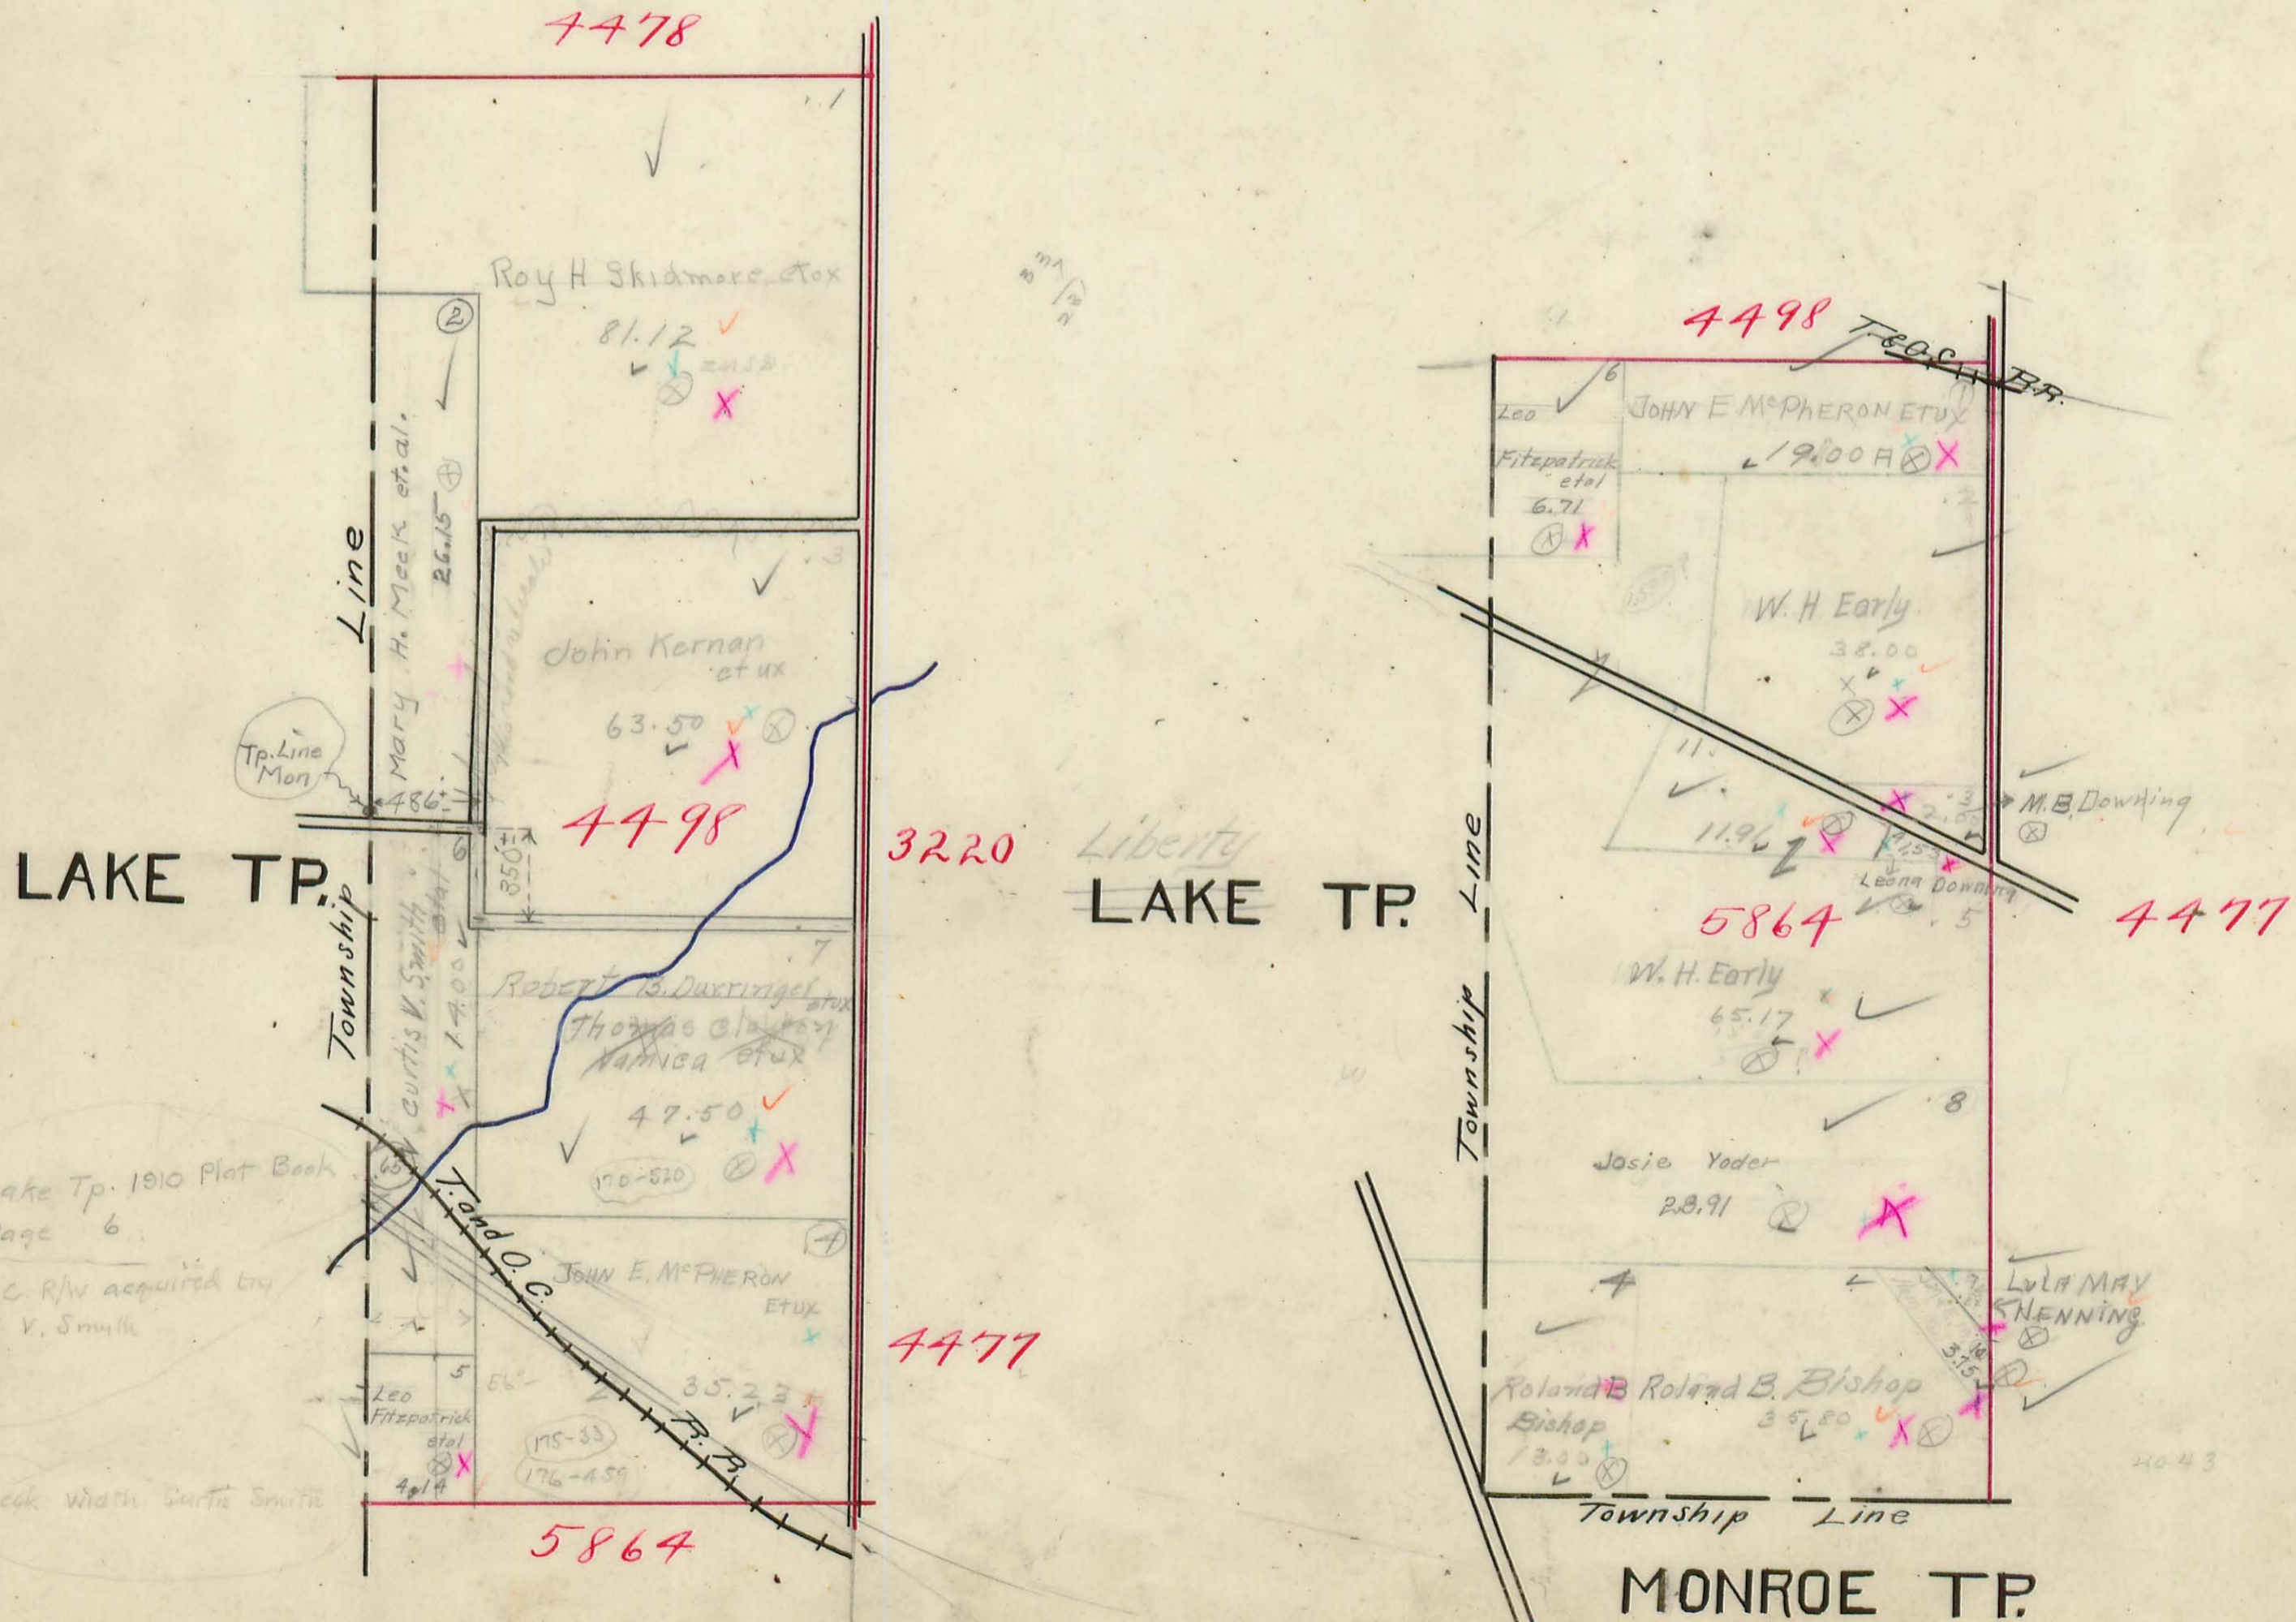

JEFFERSON TOWNSHIP.

Plat of Virginia Military Survey No. ⁴⁴⁷⁷
{ 8303
8485


Scale: 1 inch = 10 chains.

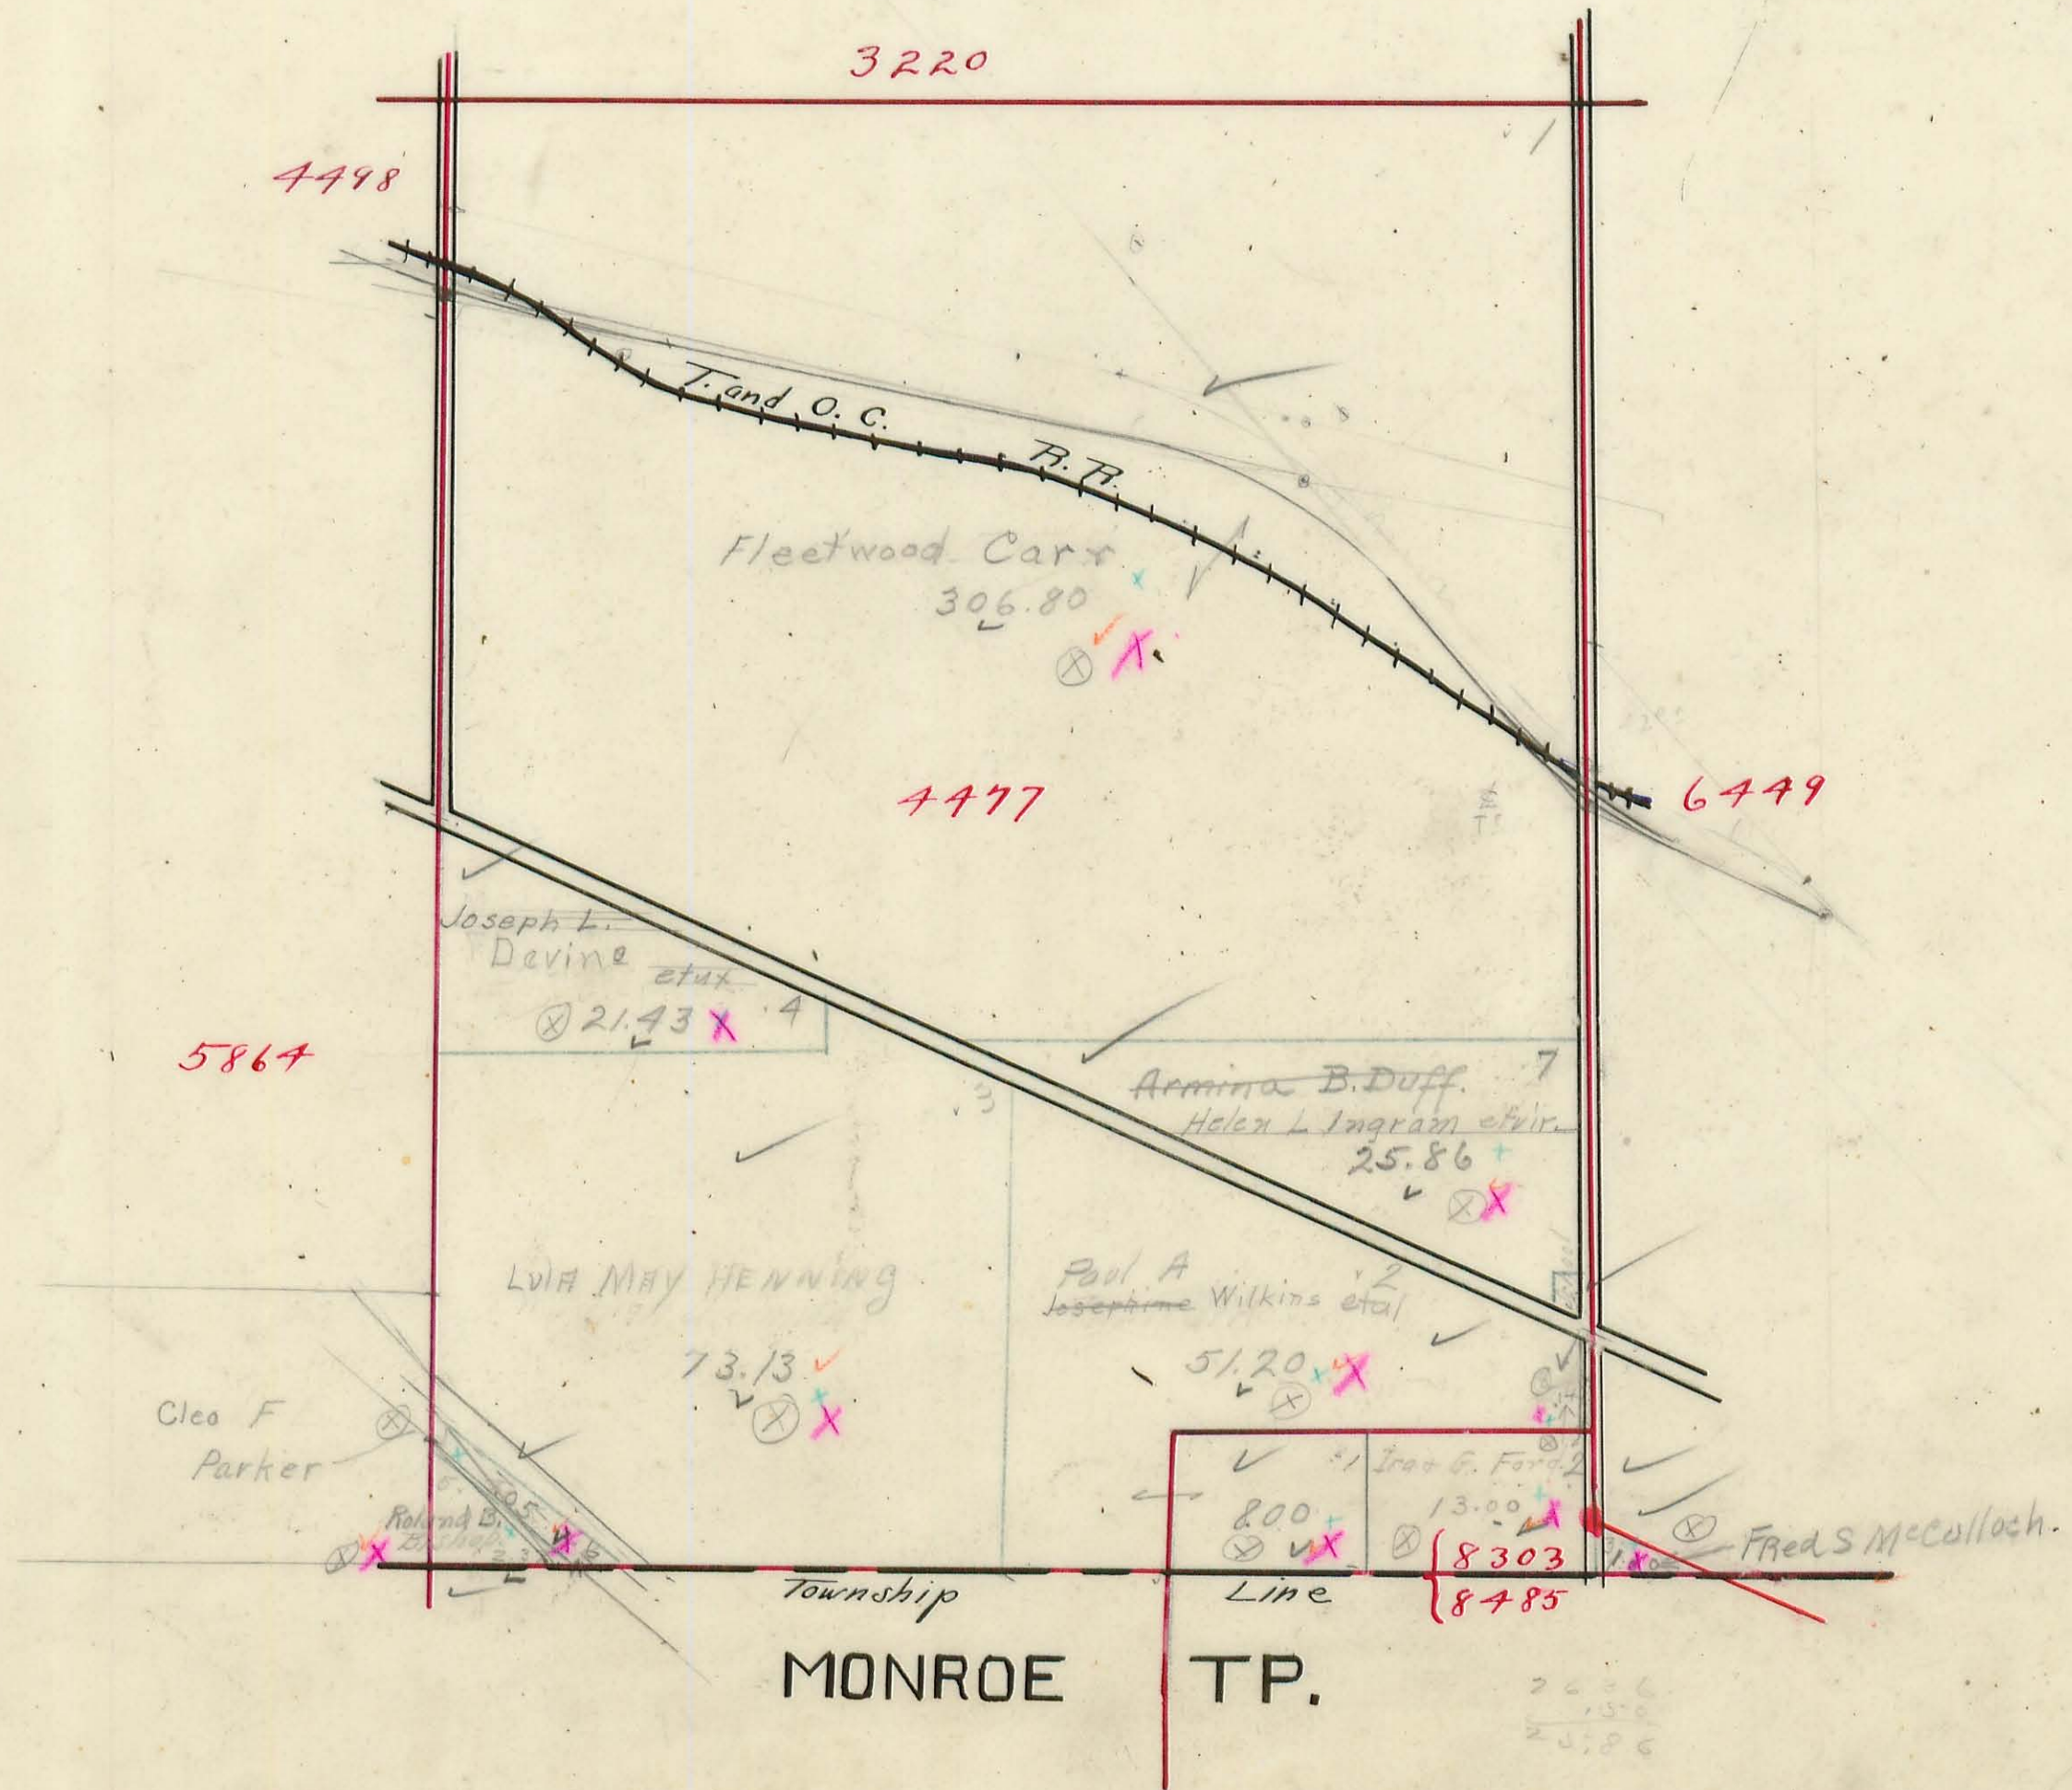

JEFFERSON TOWNSHIP.

Plat of Virginia Military Survey No. 6447
6449
4957


Scale: 1 inch = 10 chains.

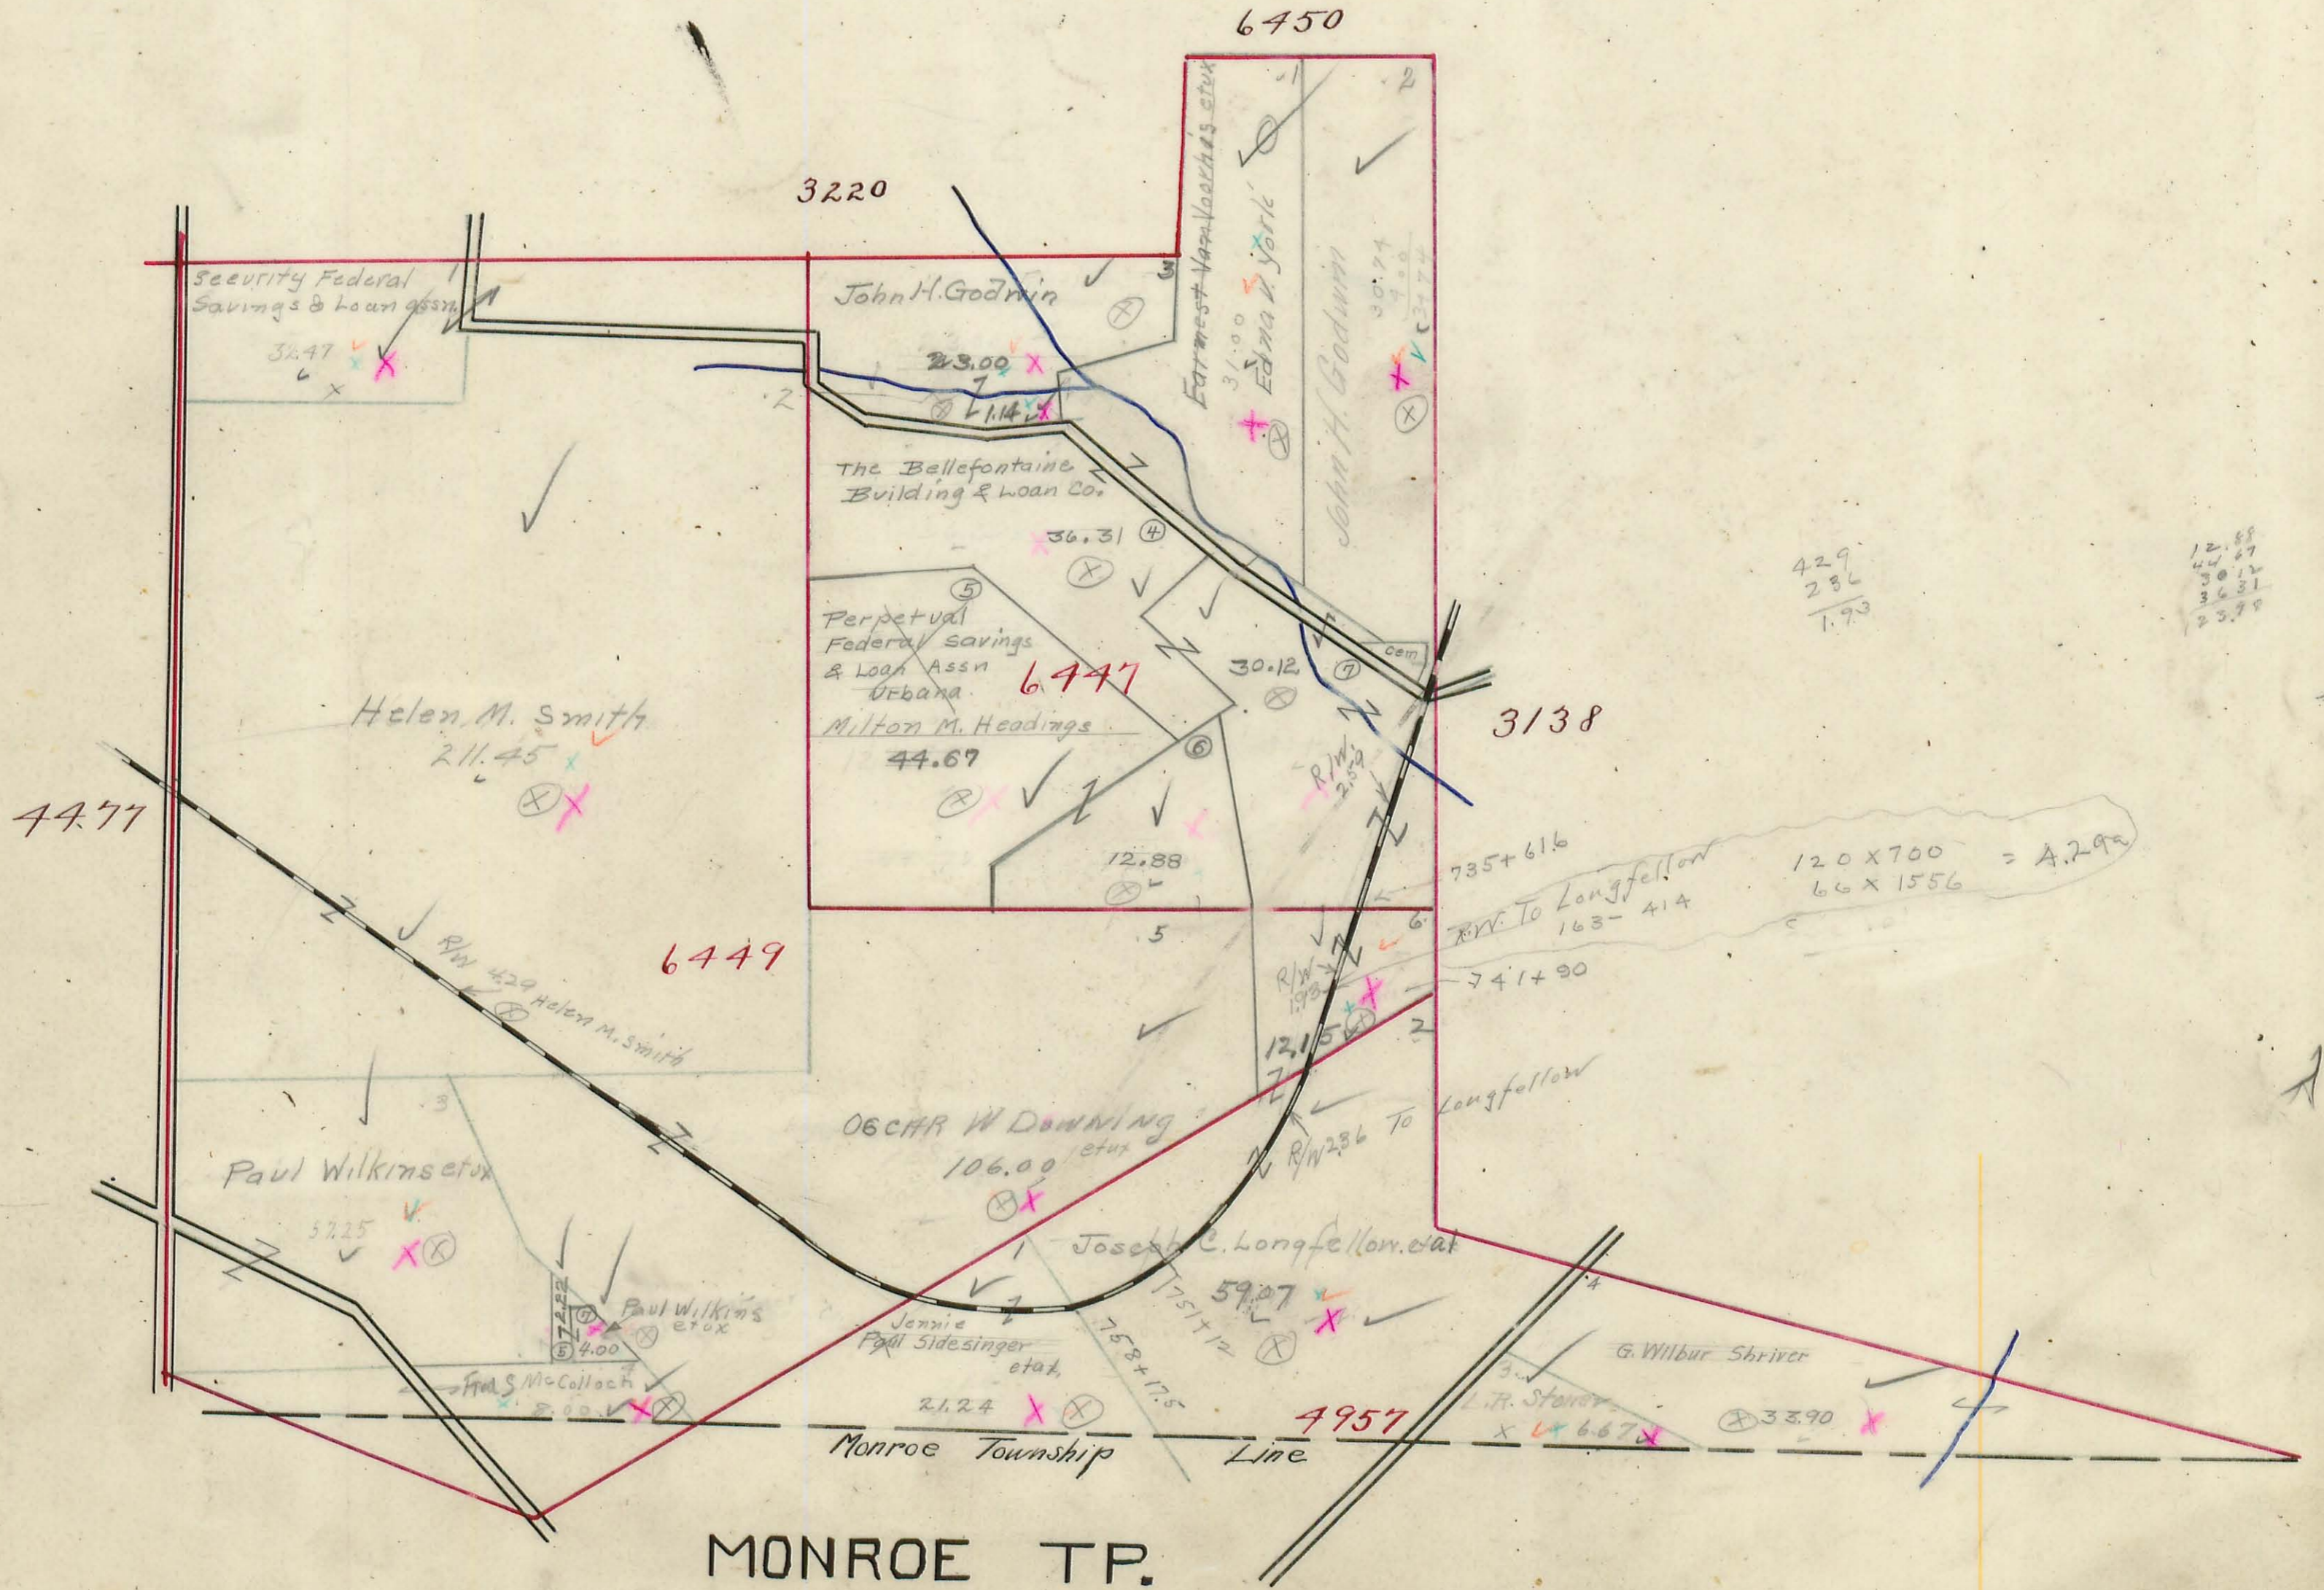

JEFFERSON TOWNSHIP.

Plat of Virginia Military Survey No. 3138

Scale: 1 inch = 10 chains.

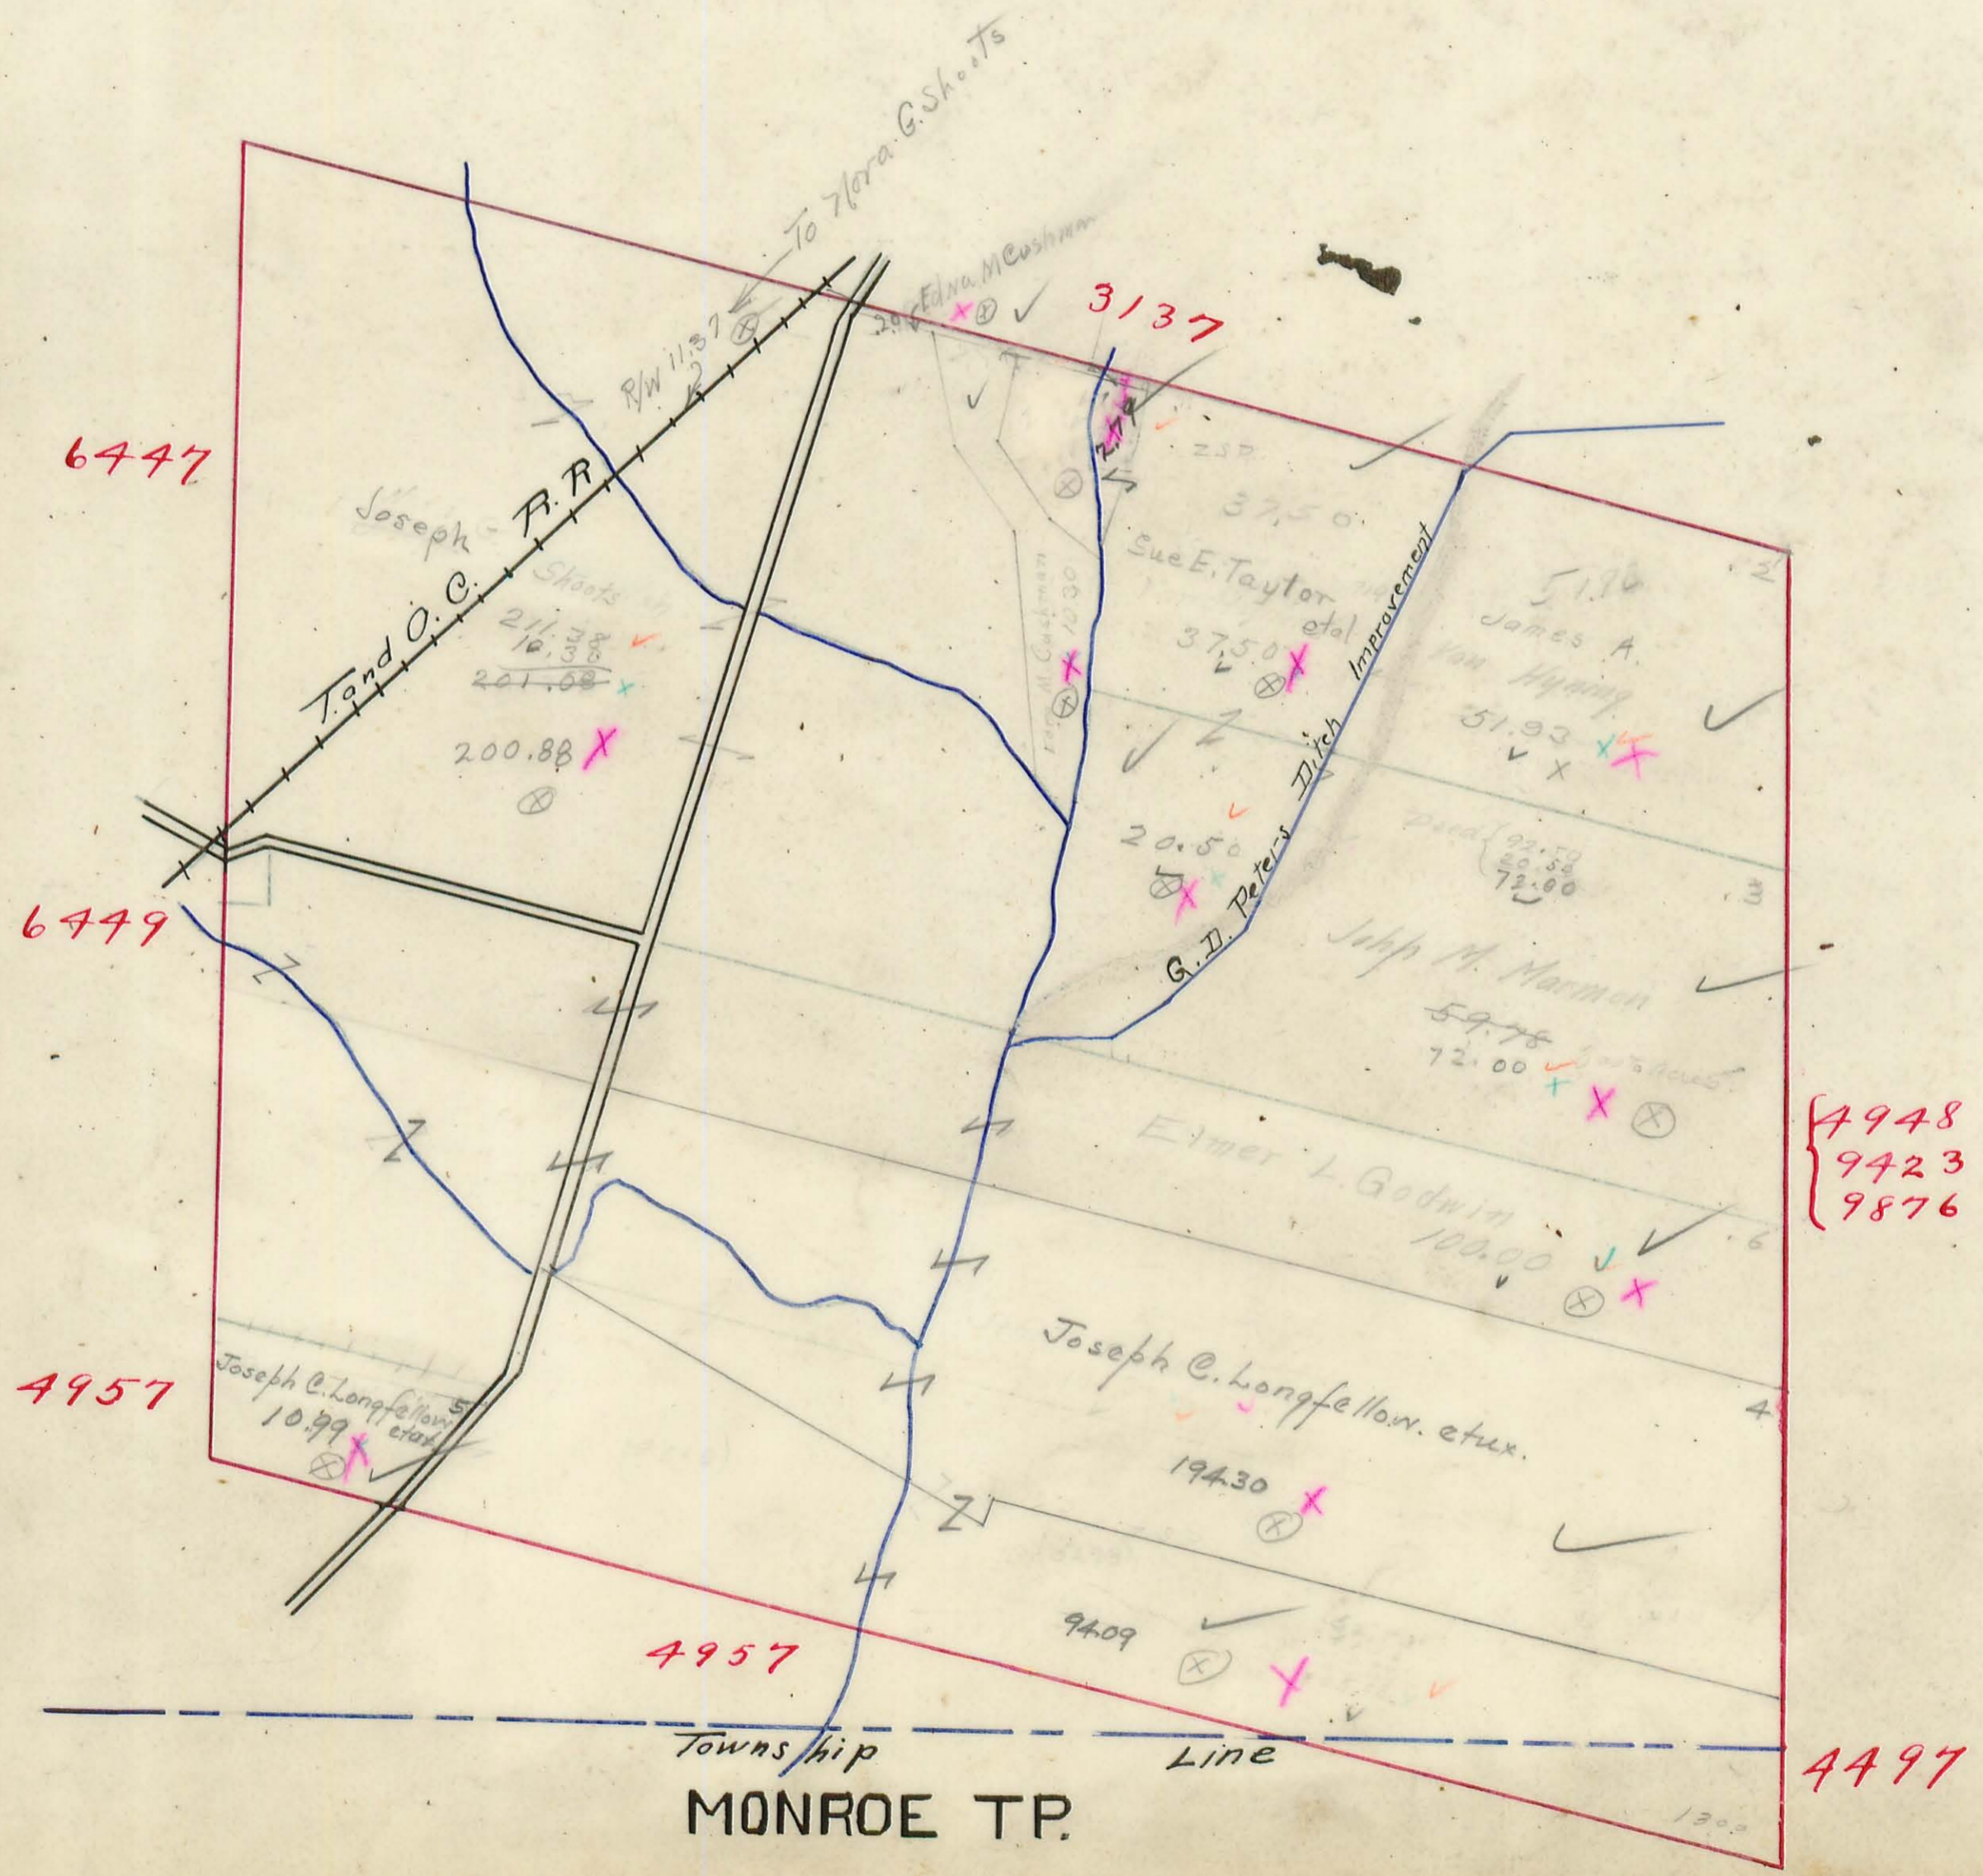

6447

6449

4957

4957

4948
9423
9876

4497

3137







JEFFERSON TOWNSHIP.

Plat of Virginia Military Survey No. ⁴¹⁹⁵
⁴⁶⁰⁴
⁴⁴⁹⁷

Scale: 1 inch = 10 chains.

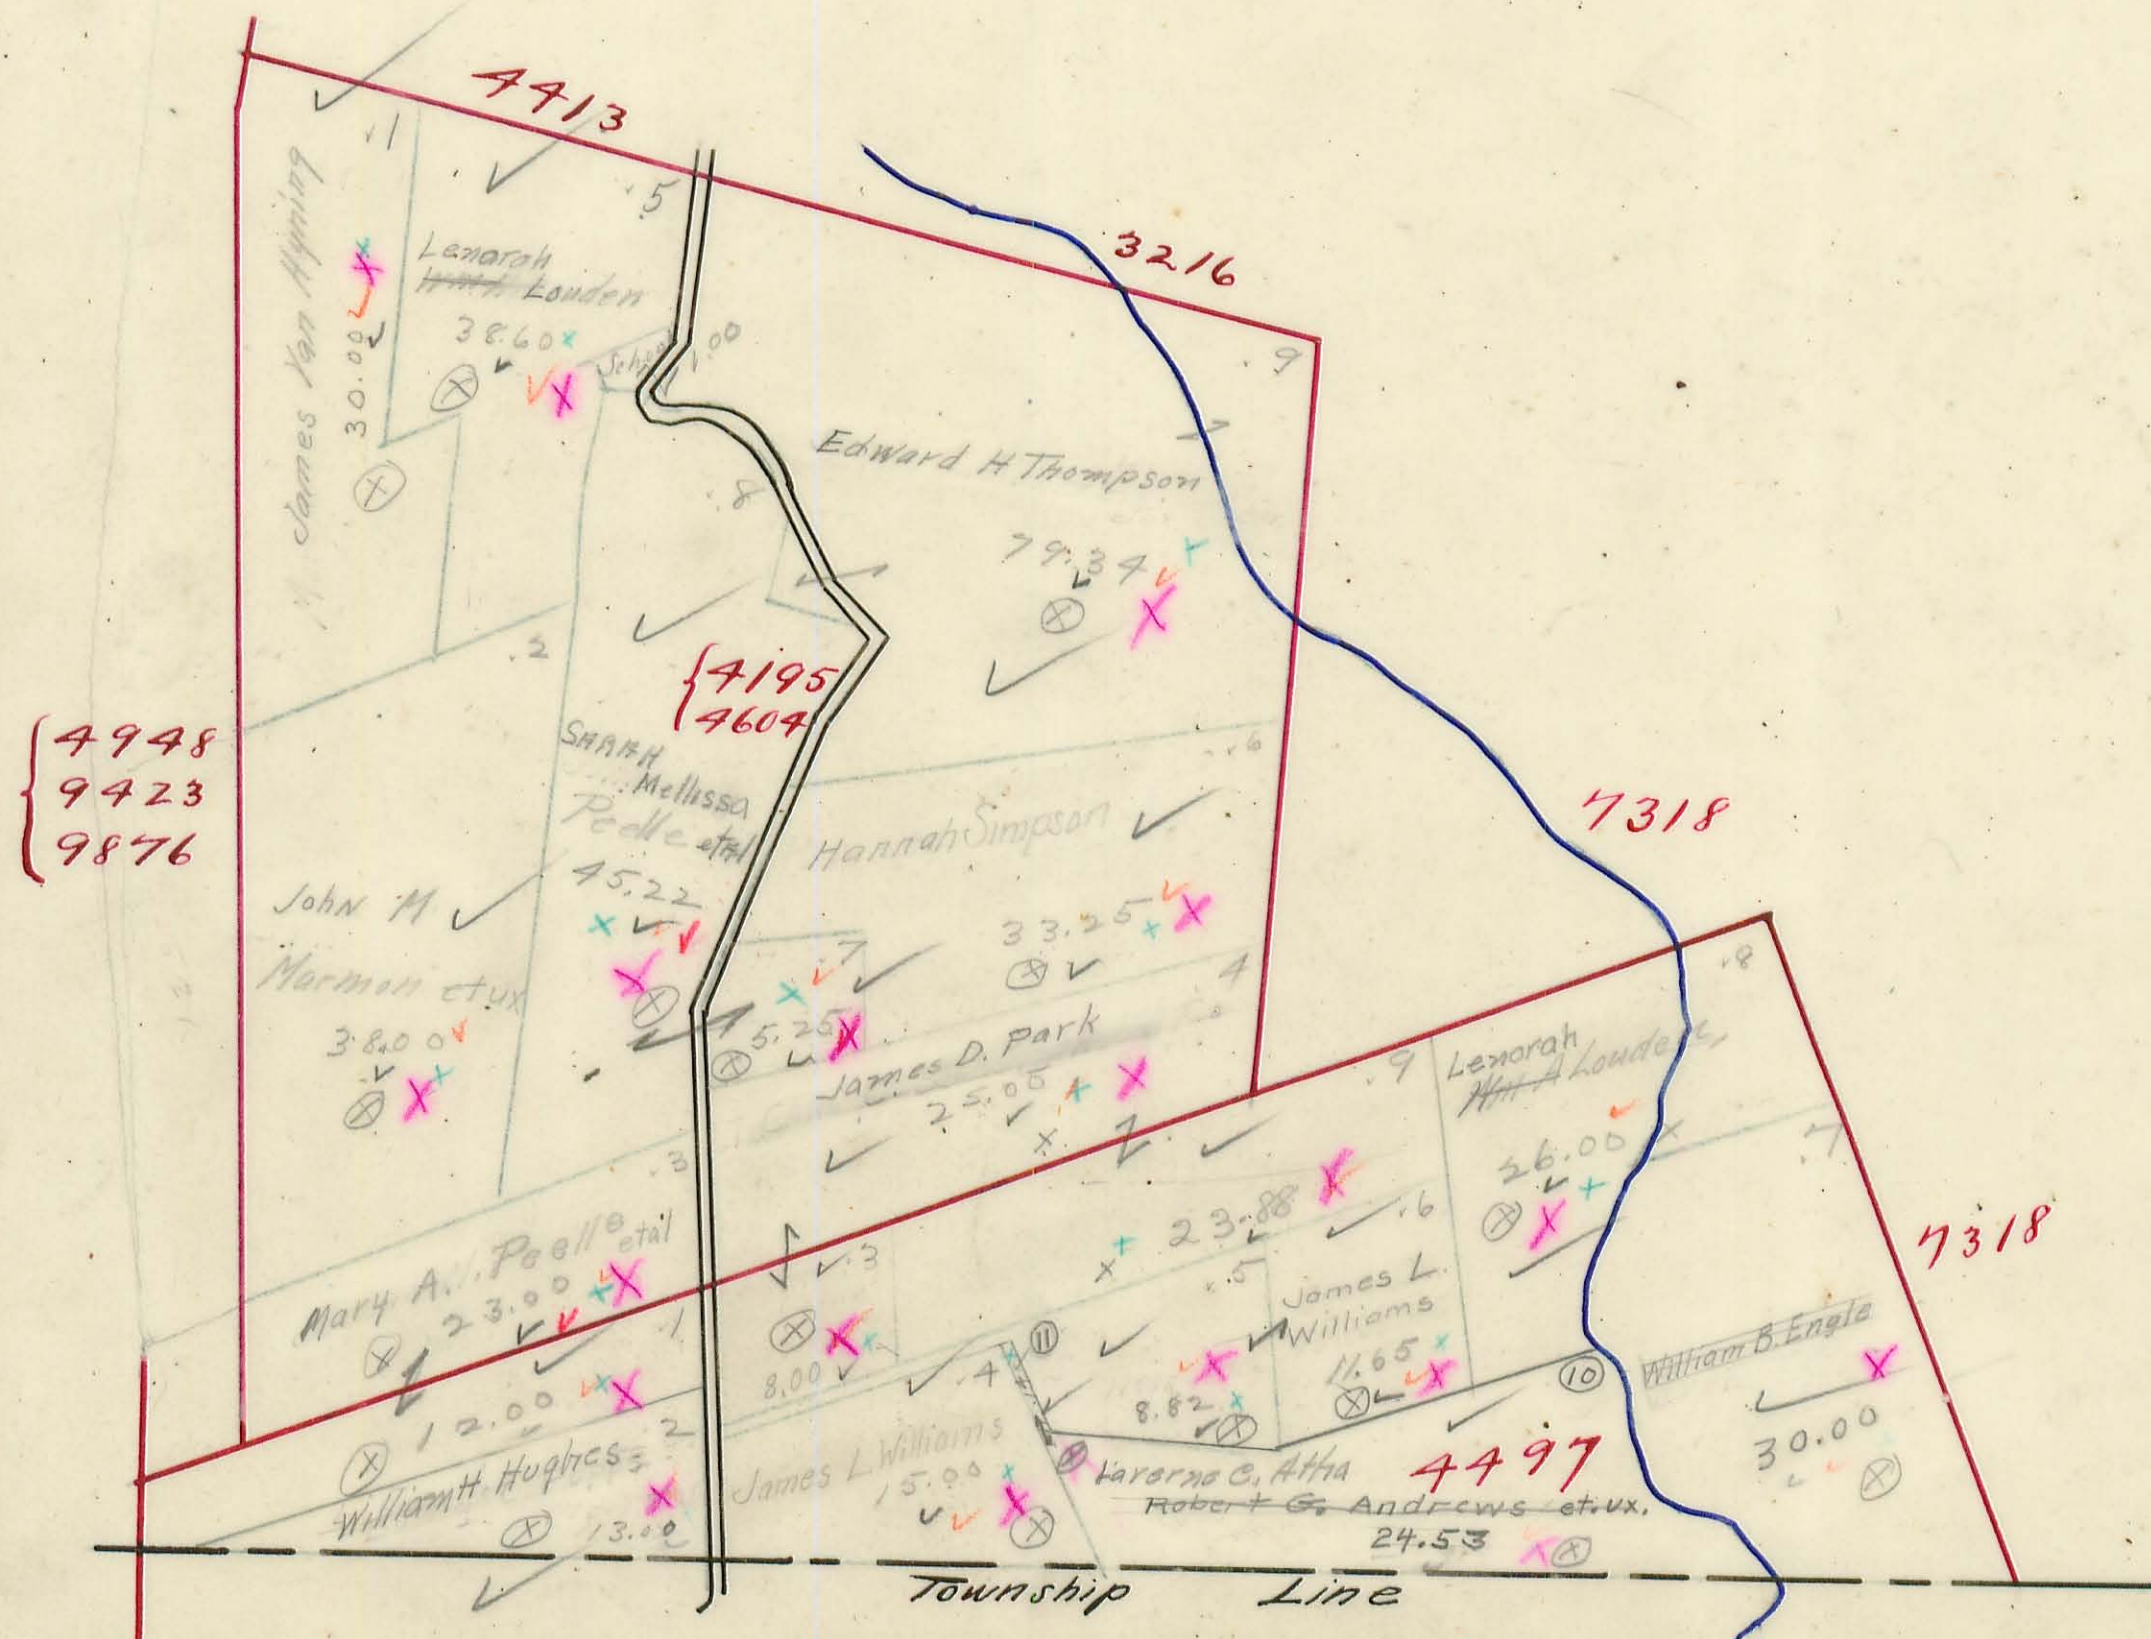


MONROE TR.

JEFFERSON TOWNSHIP.

Plat of Virginia Military Survey No. ⁴⁶⁶¹
₉₈₃₃

Scale: 1 inch = 10 chains.

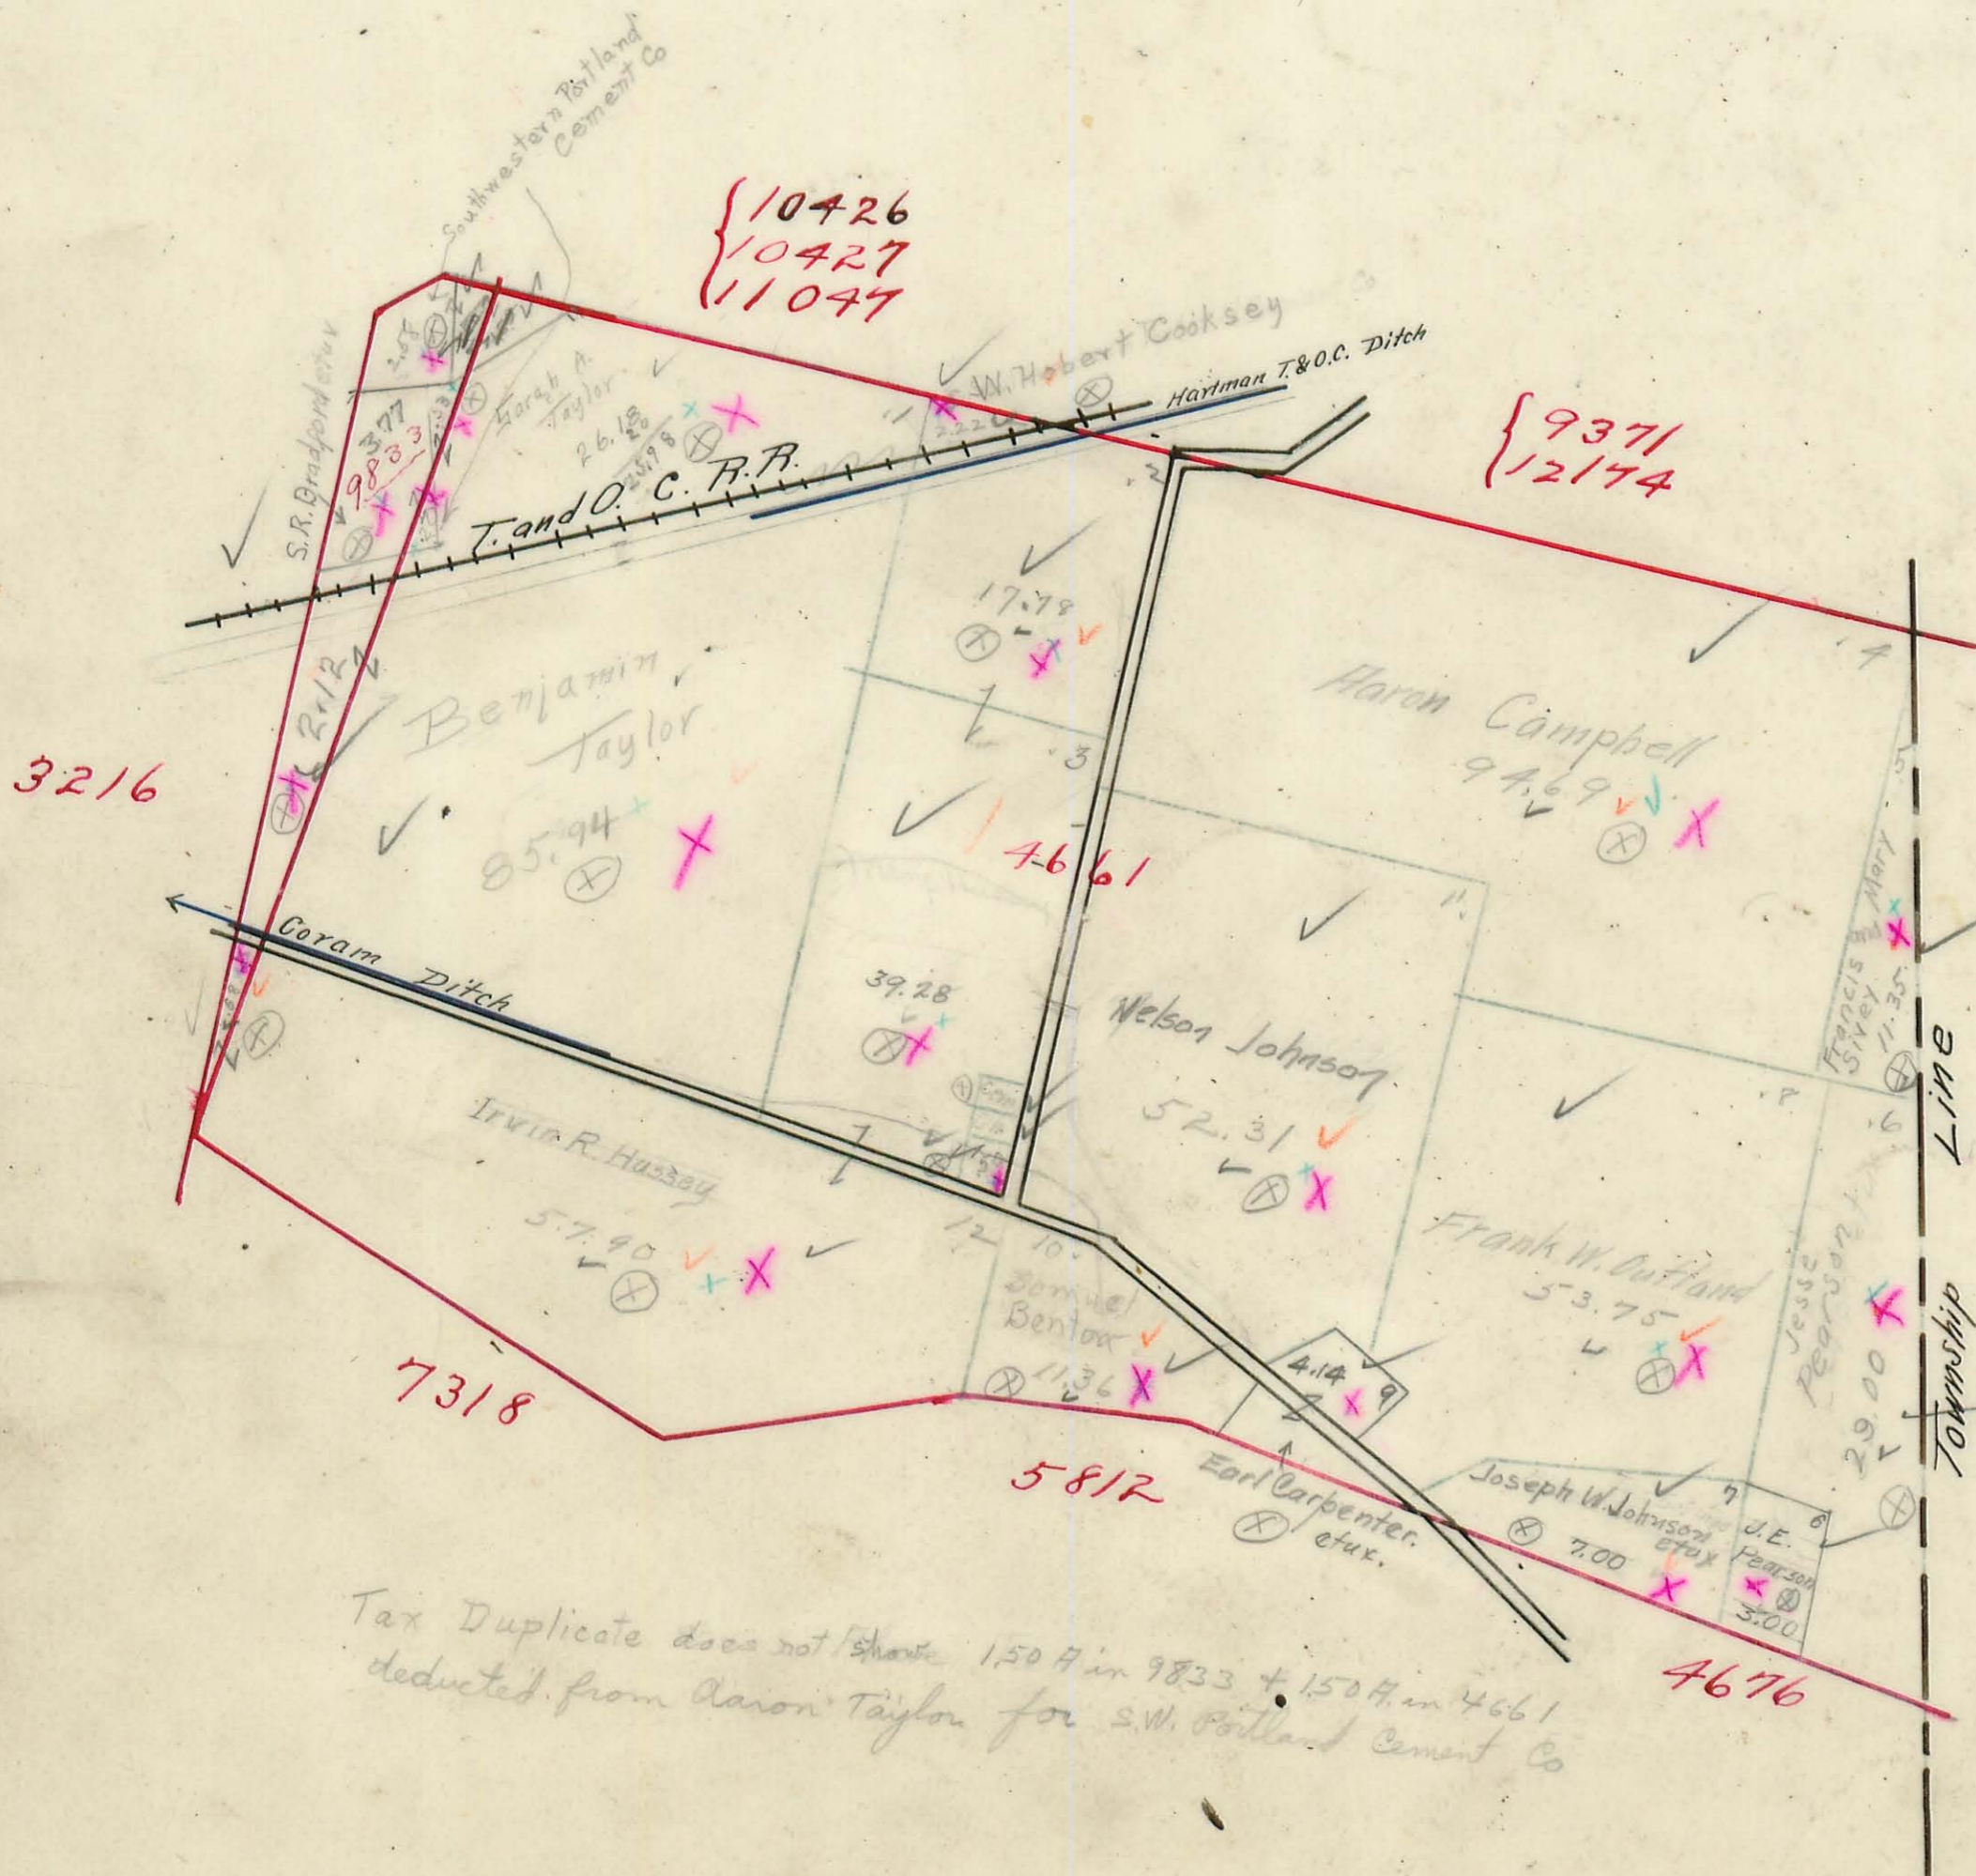


PERRY TP.

Tax Duplicate does not show 150 A in 9833 + 150 A in 4661 deducted from Aaron Taylor for S.W. Portland Cement Co

JEFFERSON TOWNSHIP.

Plat of Virginia Military Survey No. ⁷³¹⁸
⁵⁸¹²
⁴⁶⁷⁶

Scale: 1 inch = 10 chains.

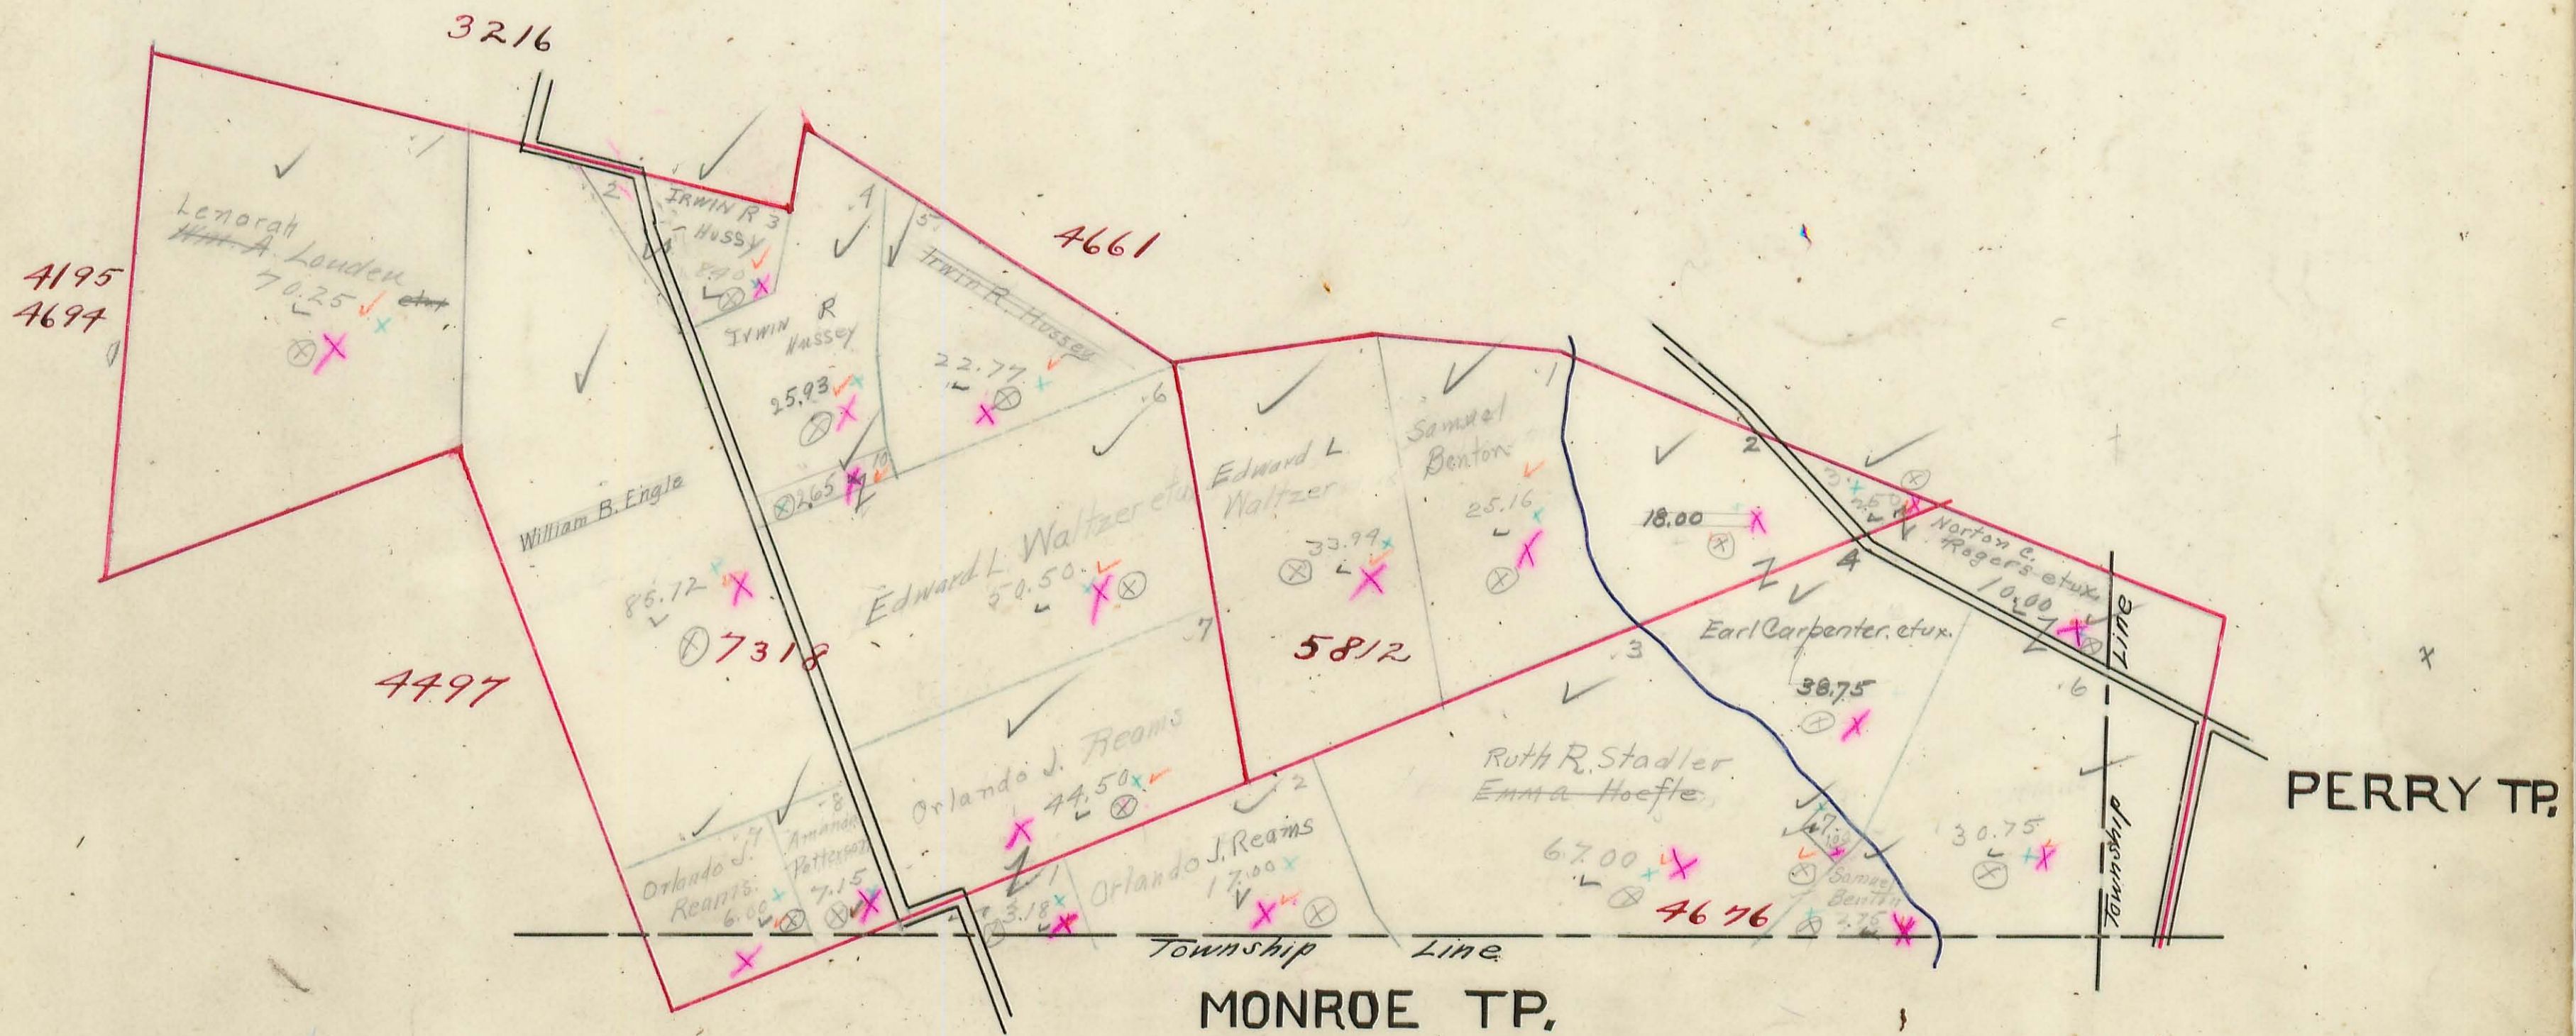


JEFFERSON TOWNSHIP.

Zanesfield

Scale: 1 in. = 200 ft.

1.84
 .60
 2.07
 4.51

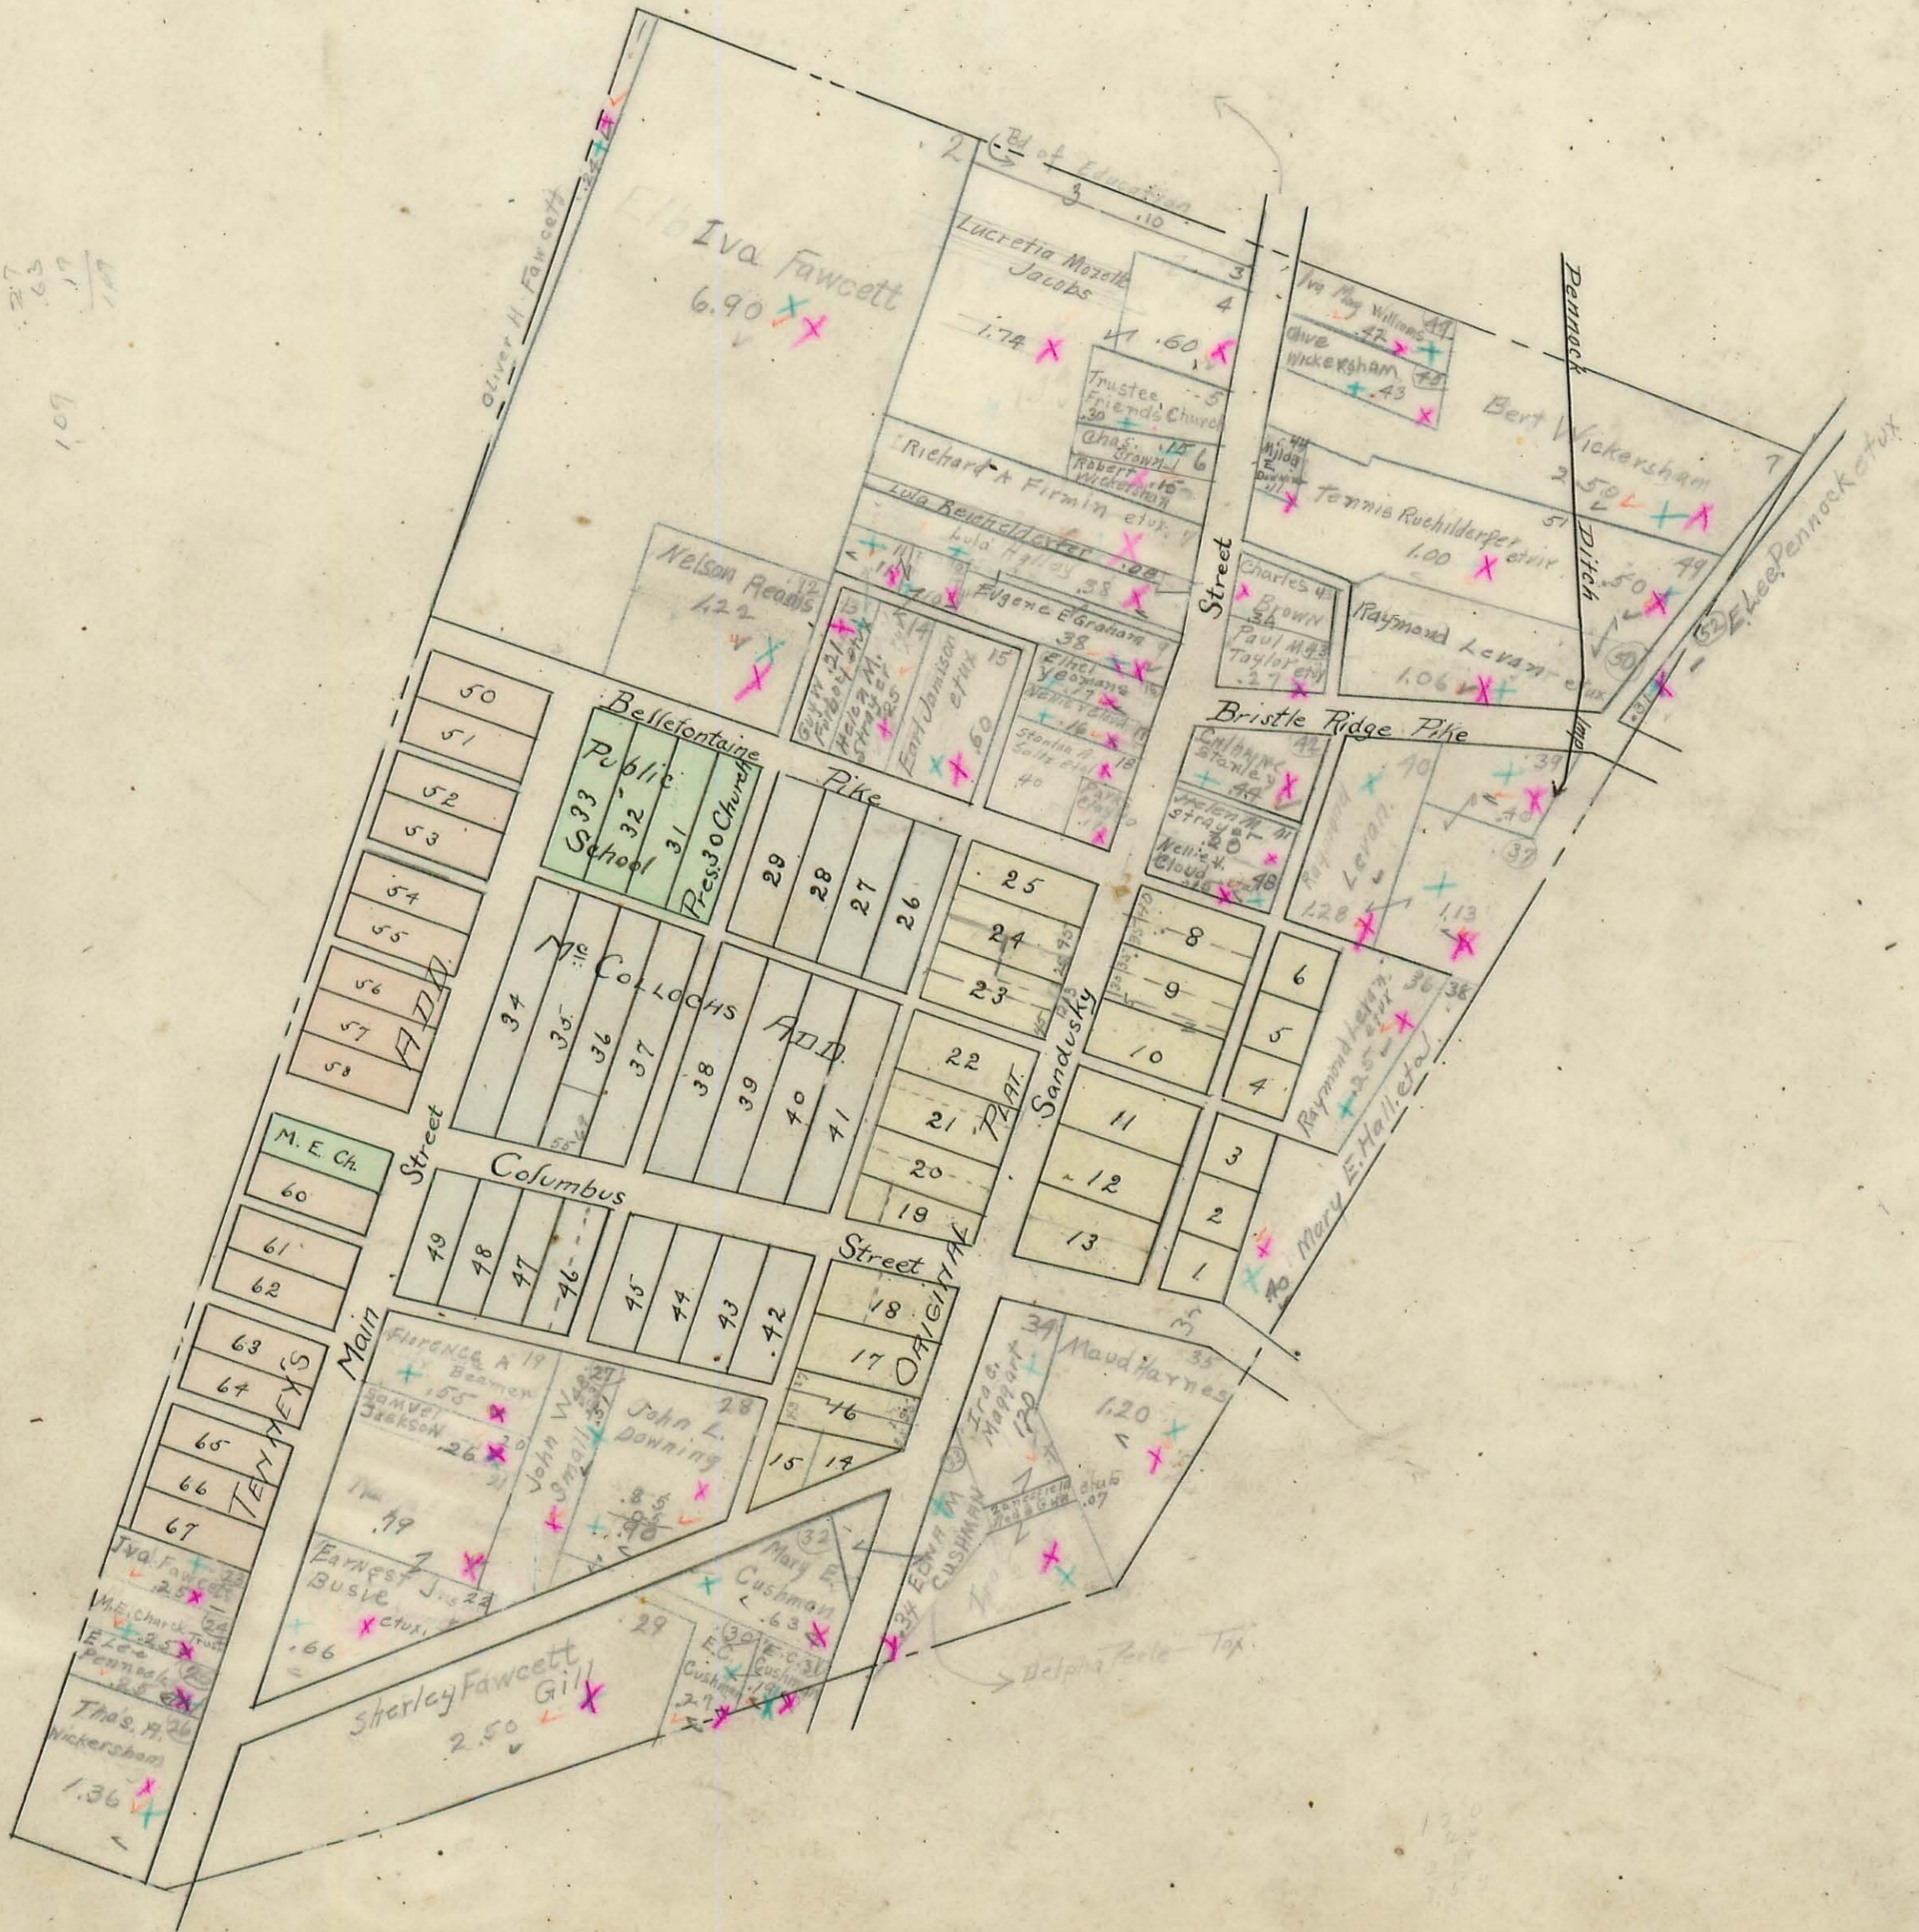

2.7
 .63
 1.1
 1.01

5.7

200
 10x
 96
 100
 100
 104