

**MONROE
TOWNSHIP**

1958

INDEX

VIRGINIA MILITARY SURVEYS

V.M.S.	PAGE	V.M.S.	PAGE
2220	15	4957	3
3138	8	5042	28
3159	12	5044	28
3221	11	5864	1
3222	10	6449	2
3223	17	6487	15
3224	16	6516	13
3225	22	6762	2
3226	23	7318	12
3227	24	8303	2
3228	25	8485	2
3229	26	9592	7
3230	27	9618	7
3242	7	9676	25
4479	14	9793	4
4492-West Part	20	9878	9
4492-East Part	21	10075	25
4493	5	10091	15
4497	8	10109	9
4525	5	10718	9
4570-North Part	18	10719	9
4570-South Part	19	10853	4
4676	12	12099	6

SECTION	TOWN	RANGE	PAGE
15	5	13	33
16	5	13	31
17	5	13	30
21	5	13	32
22	5	13	31
23	5	13	30
24	5	13	29
19	4	14	29
PICKRELL TOWN			34

MONROE TOWNSHIP


INDEX MAP

CORRECTED TO

January 1, 1964


January 1, 1965

1 January, 1966

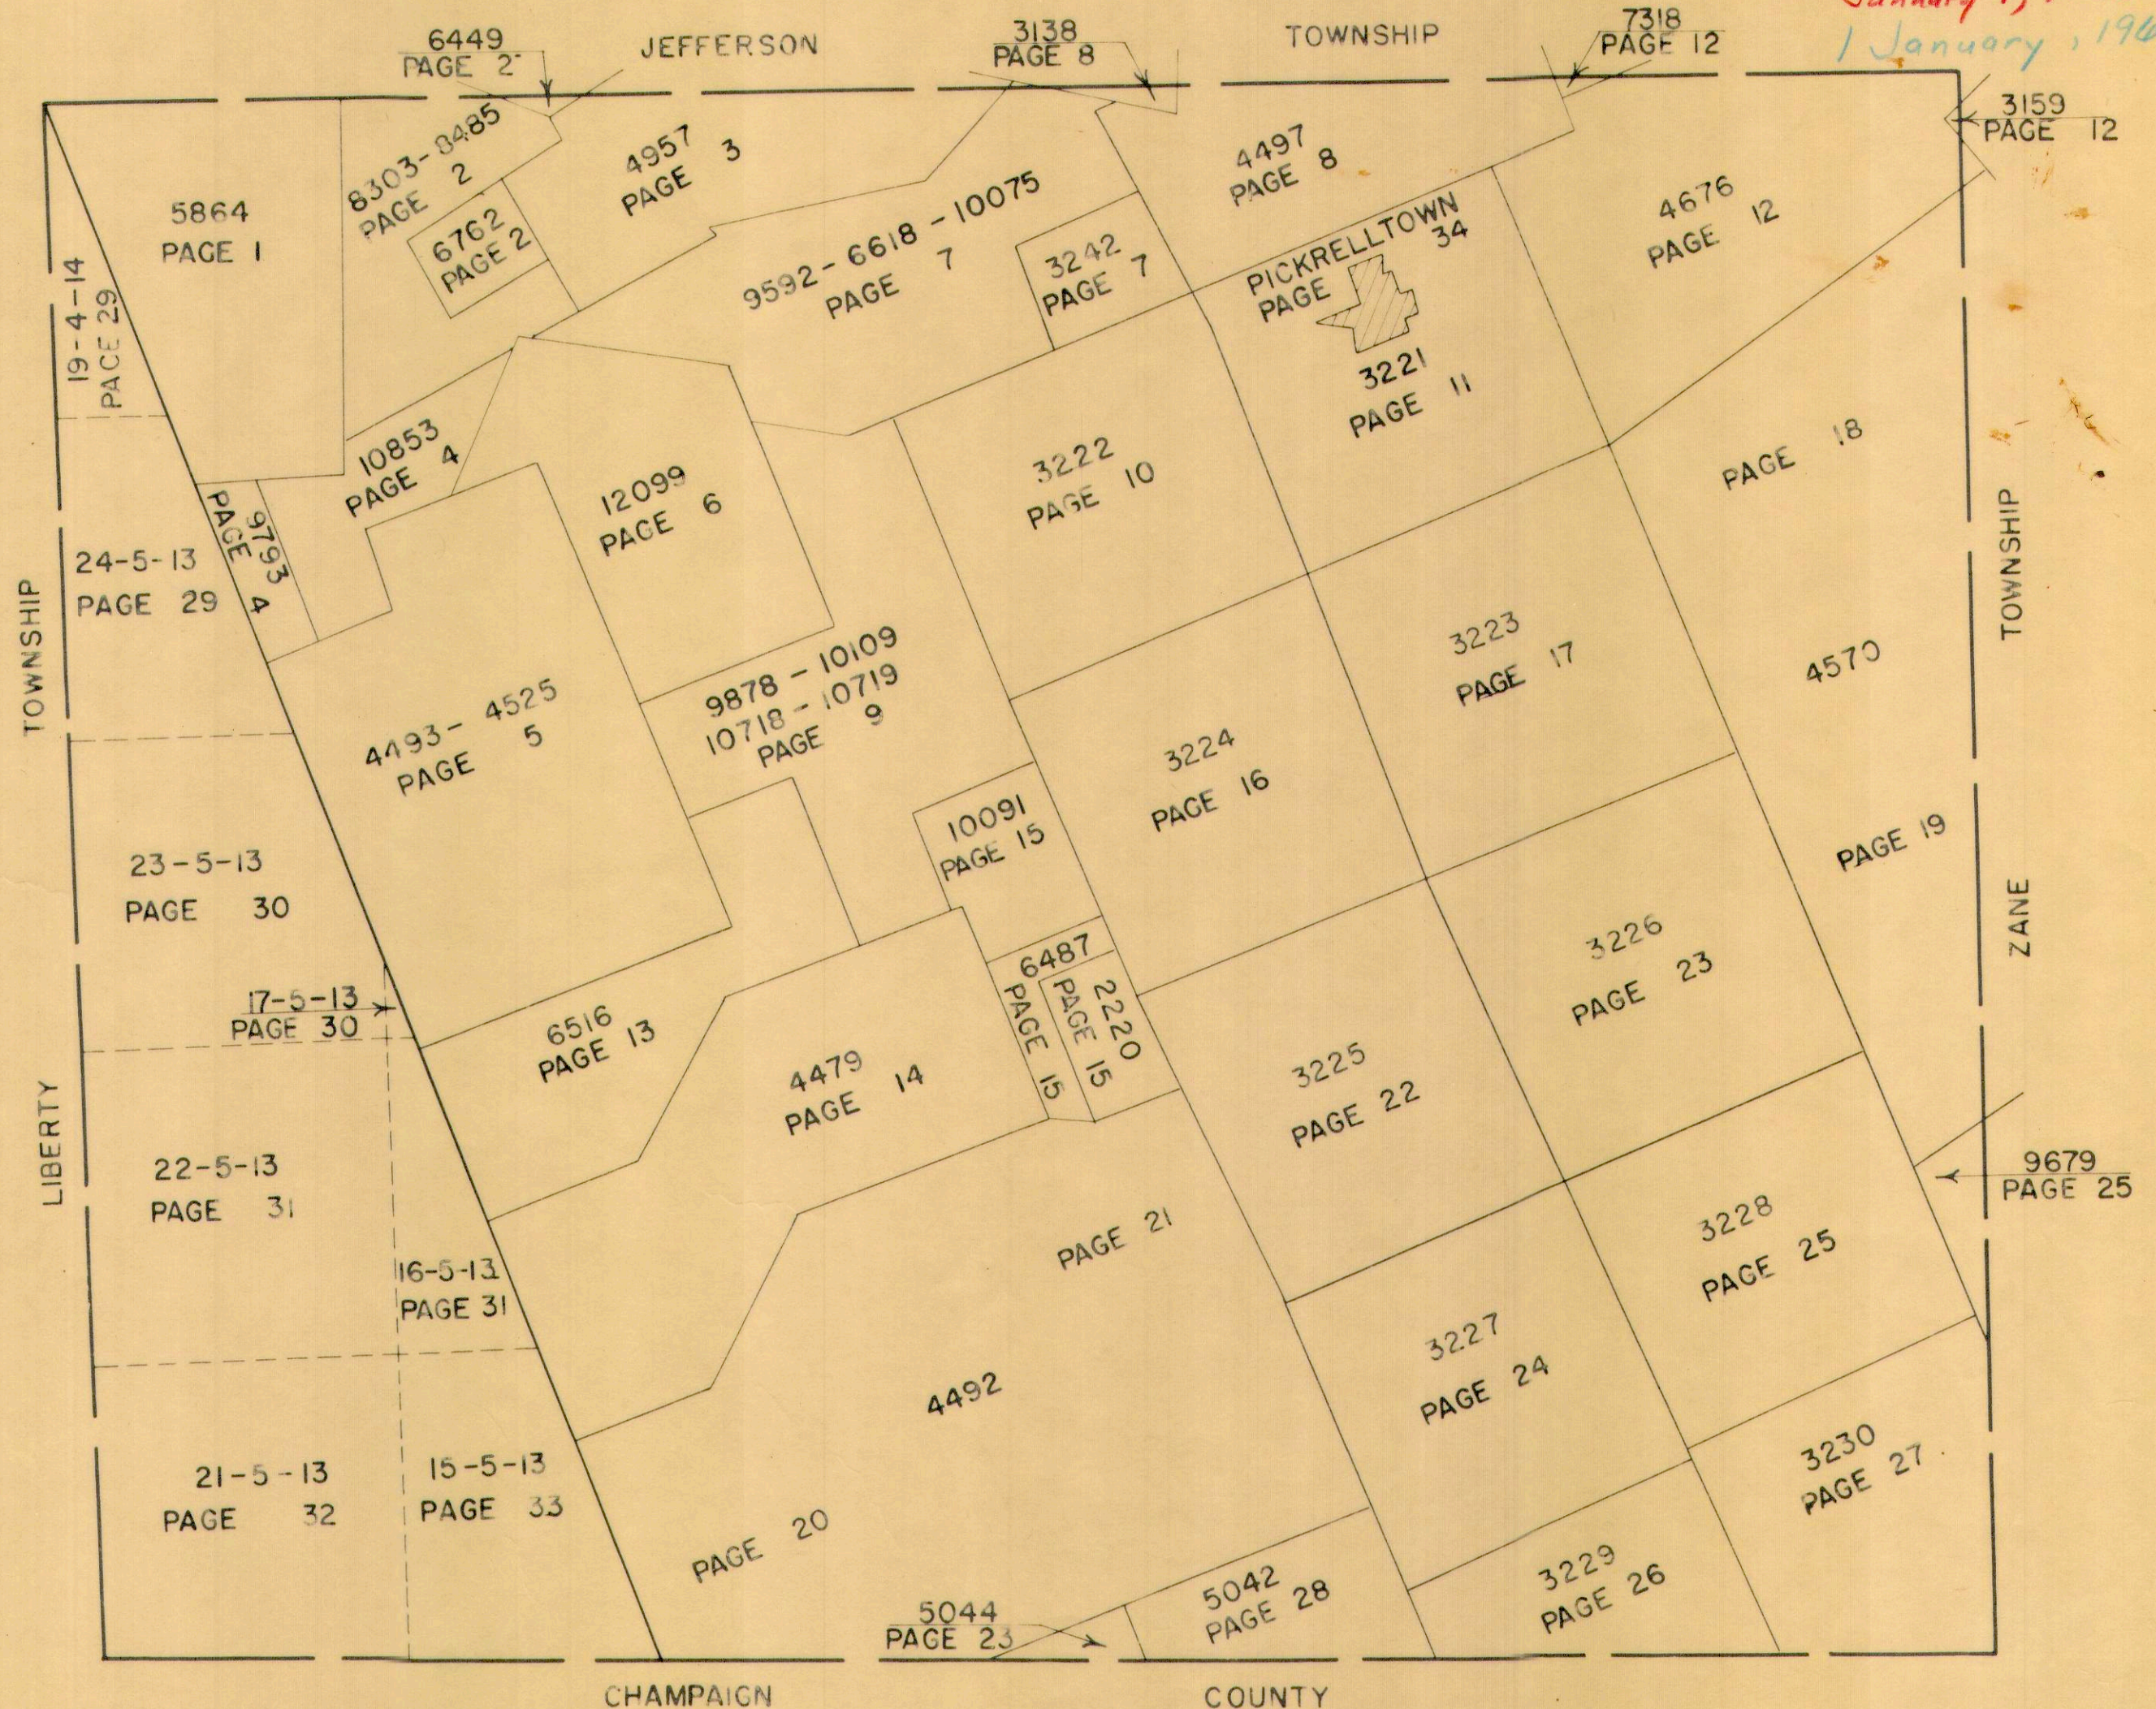

MONROE TOWNSHIP
VIRGINIA MILITARY SURVEY 5864

SCALE 10 CHAINS TO THE INCH

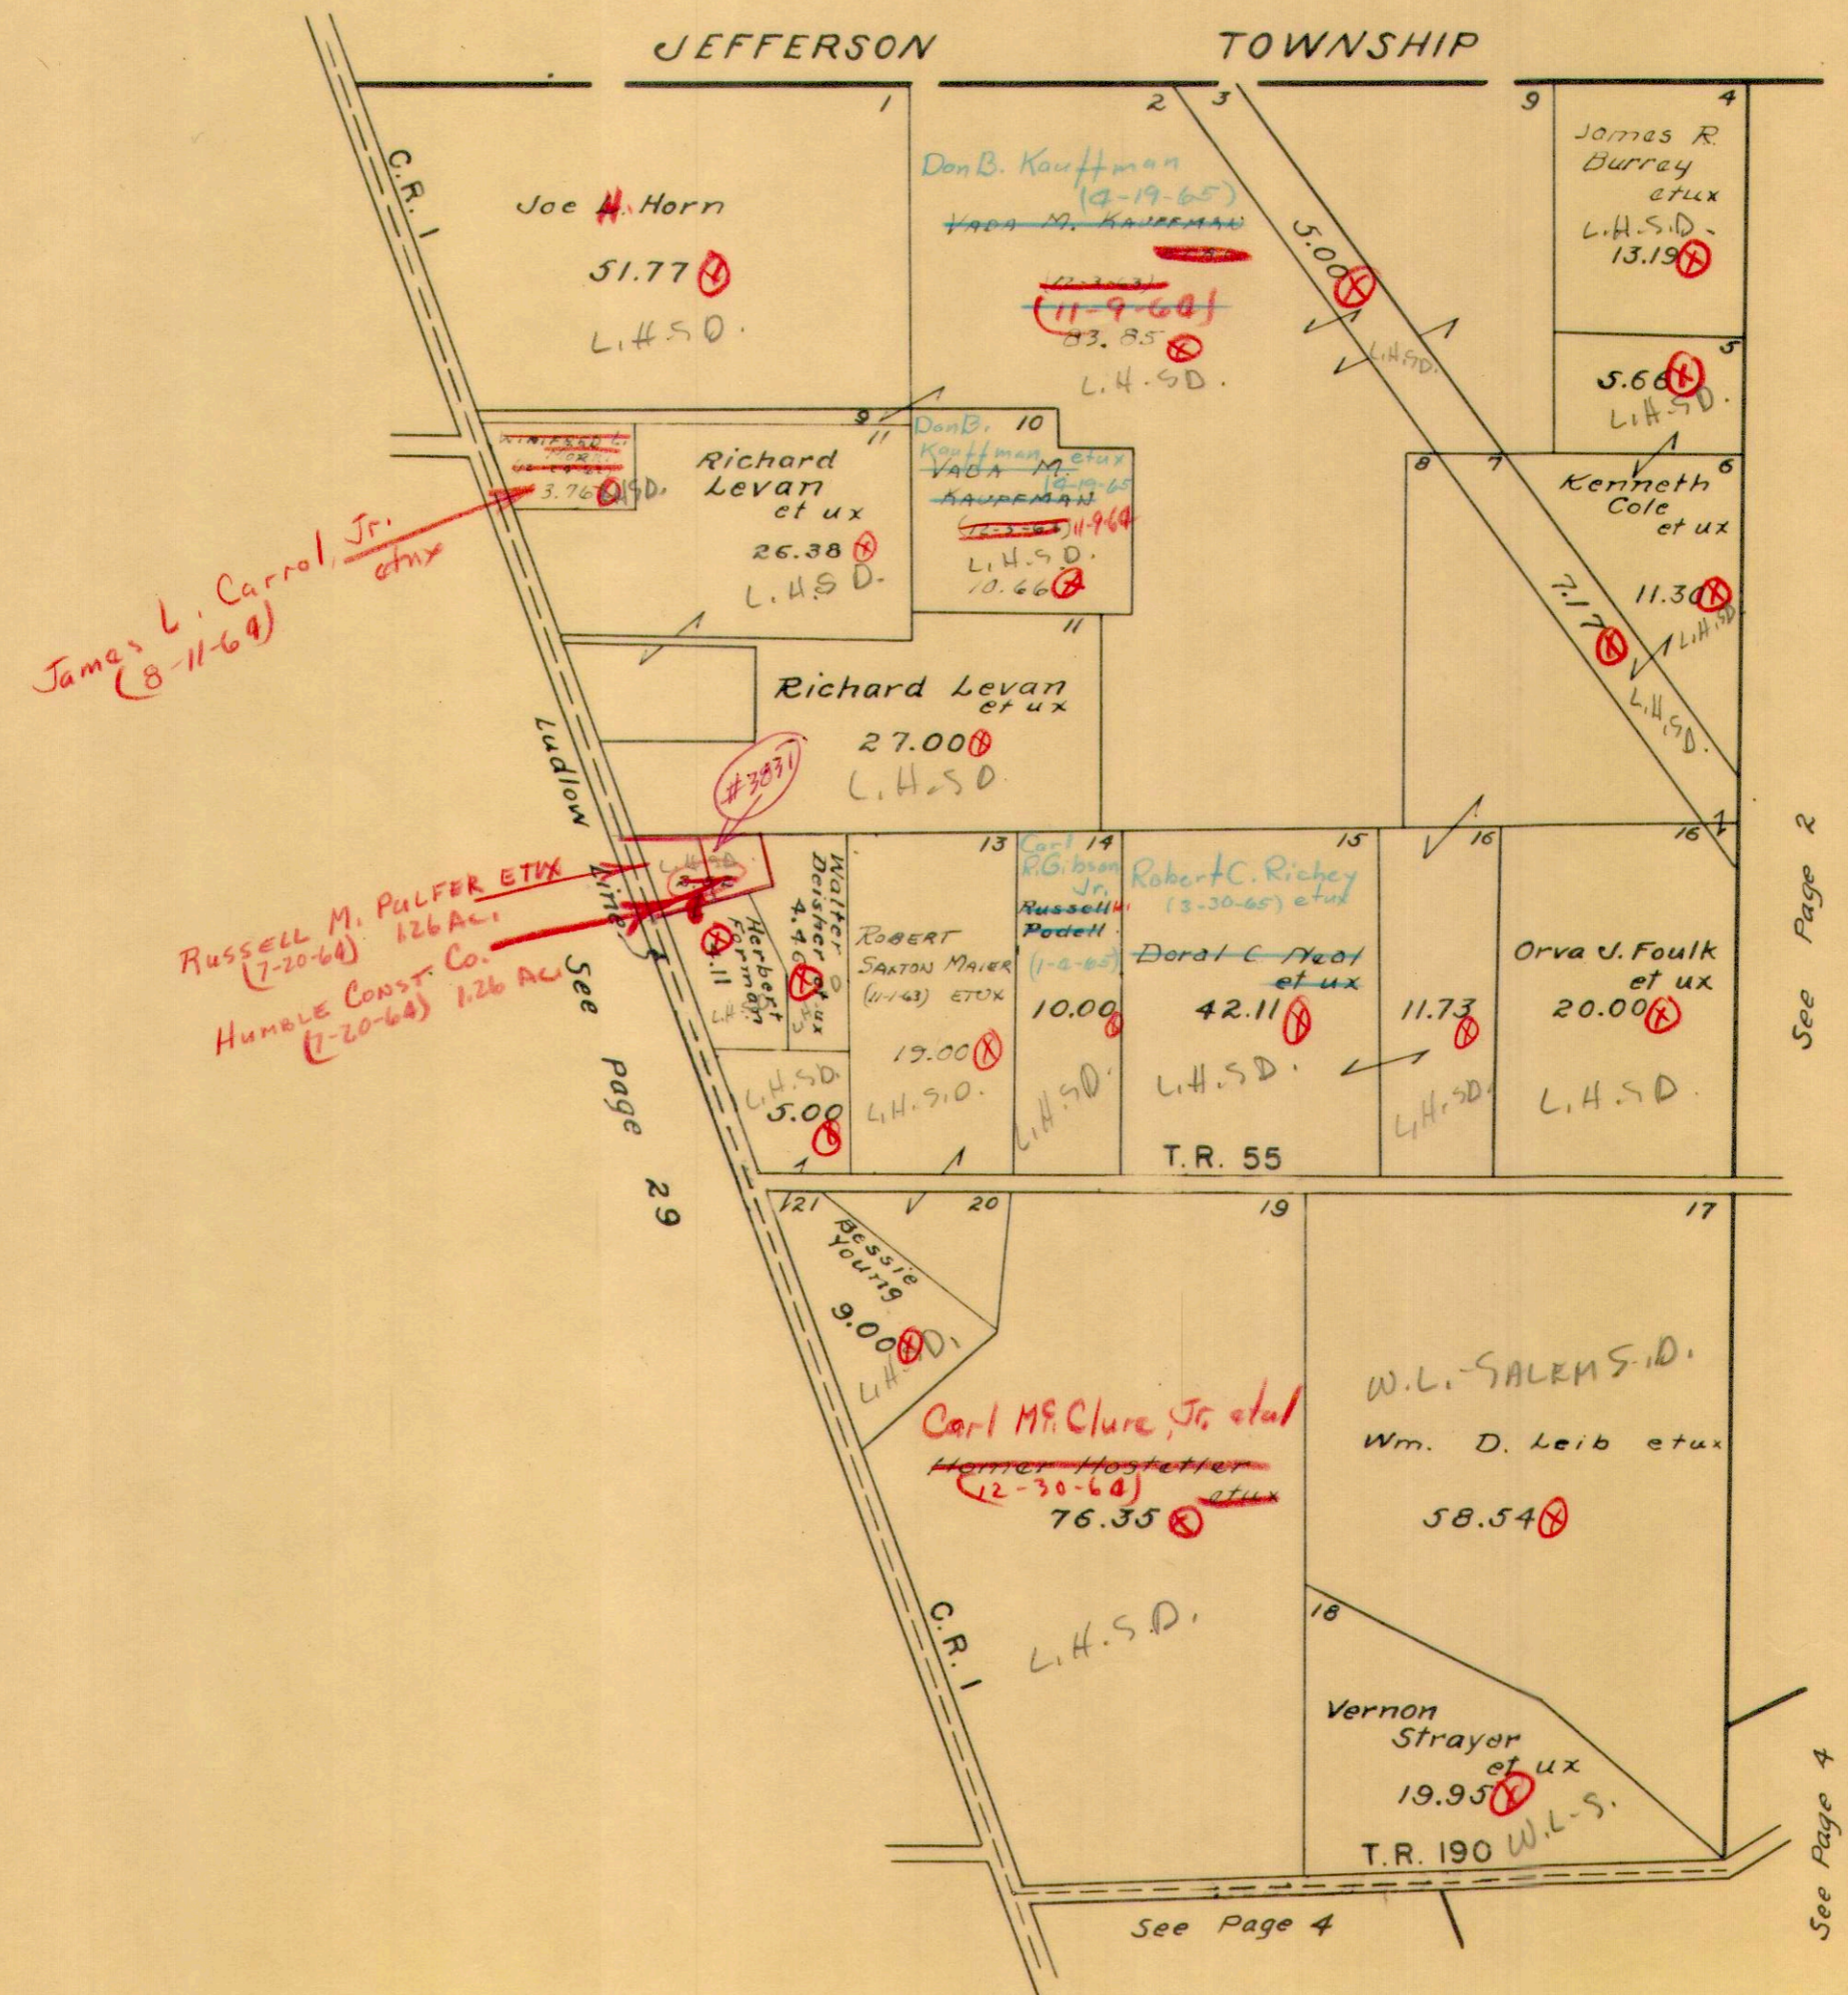

See Page 2

See Page 4

See Page 4




MONROE TOWNSHIP
VIRGINIA MILITARY SURVEYS

PAGE 2
8303
8485
6449
6762


SCALE 10 CHAINS TO THE INCH

6449

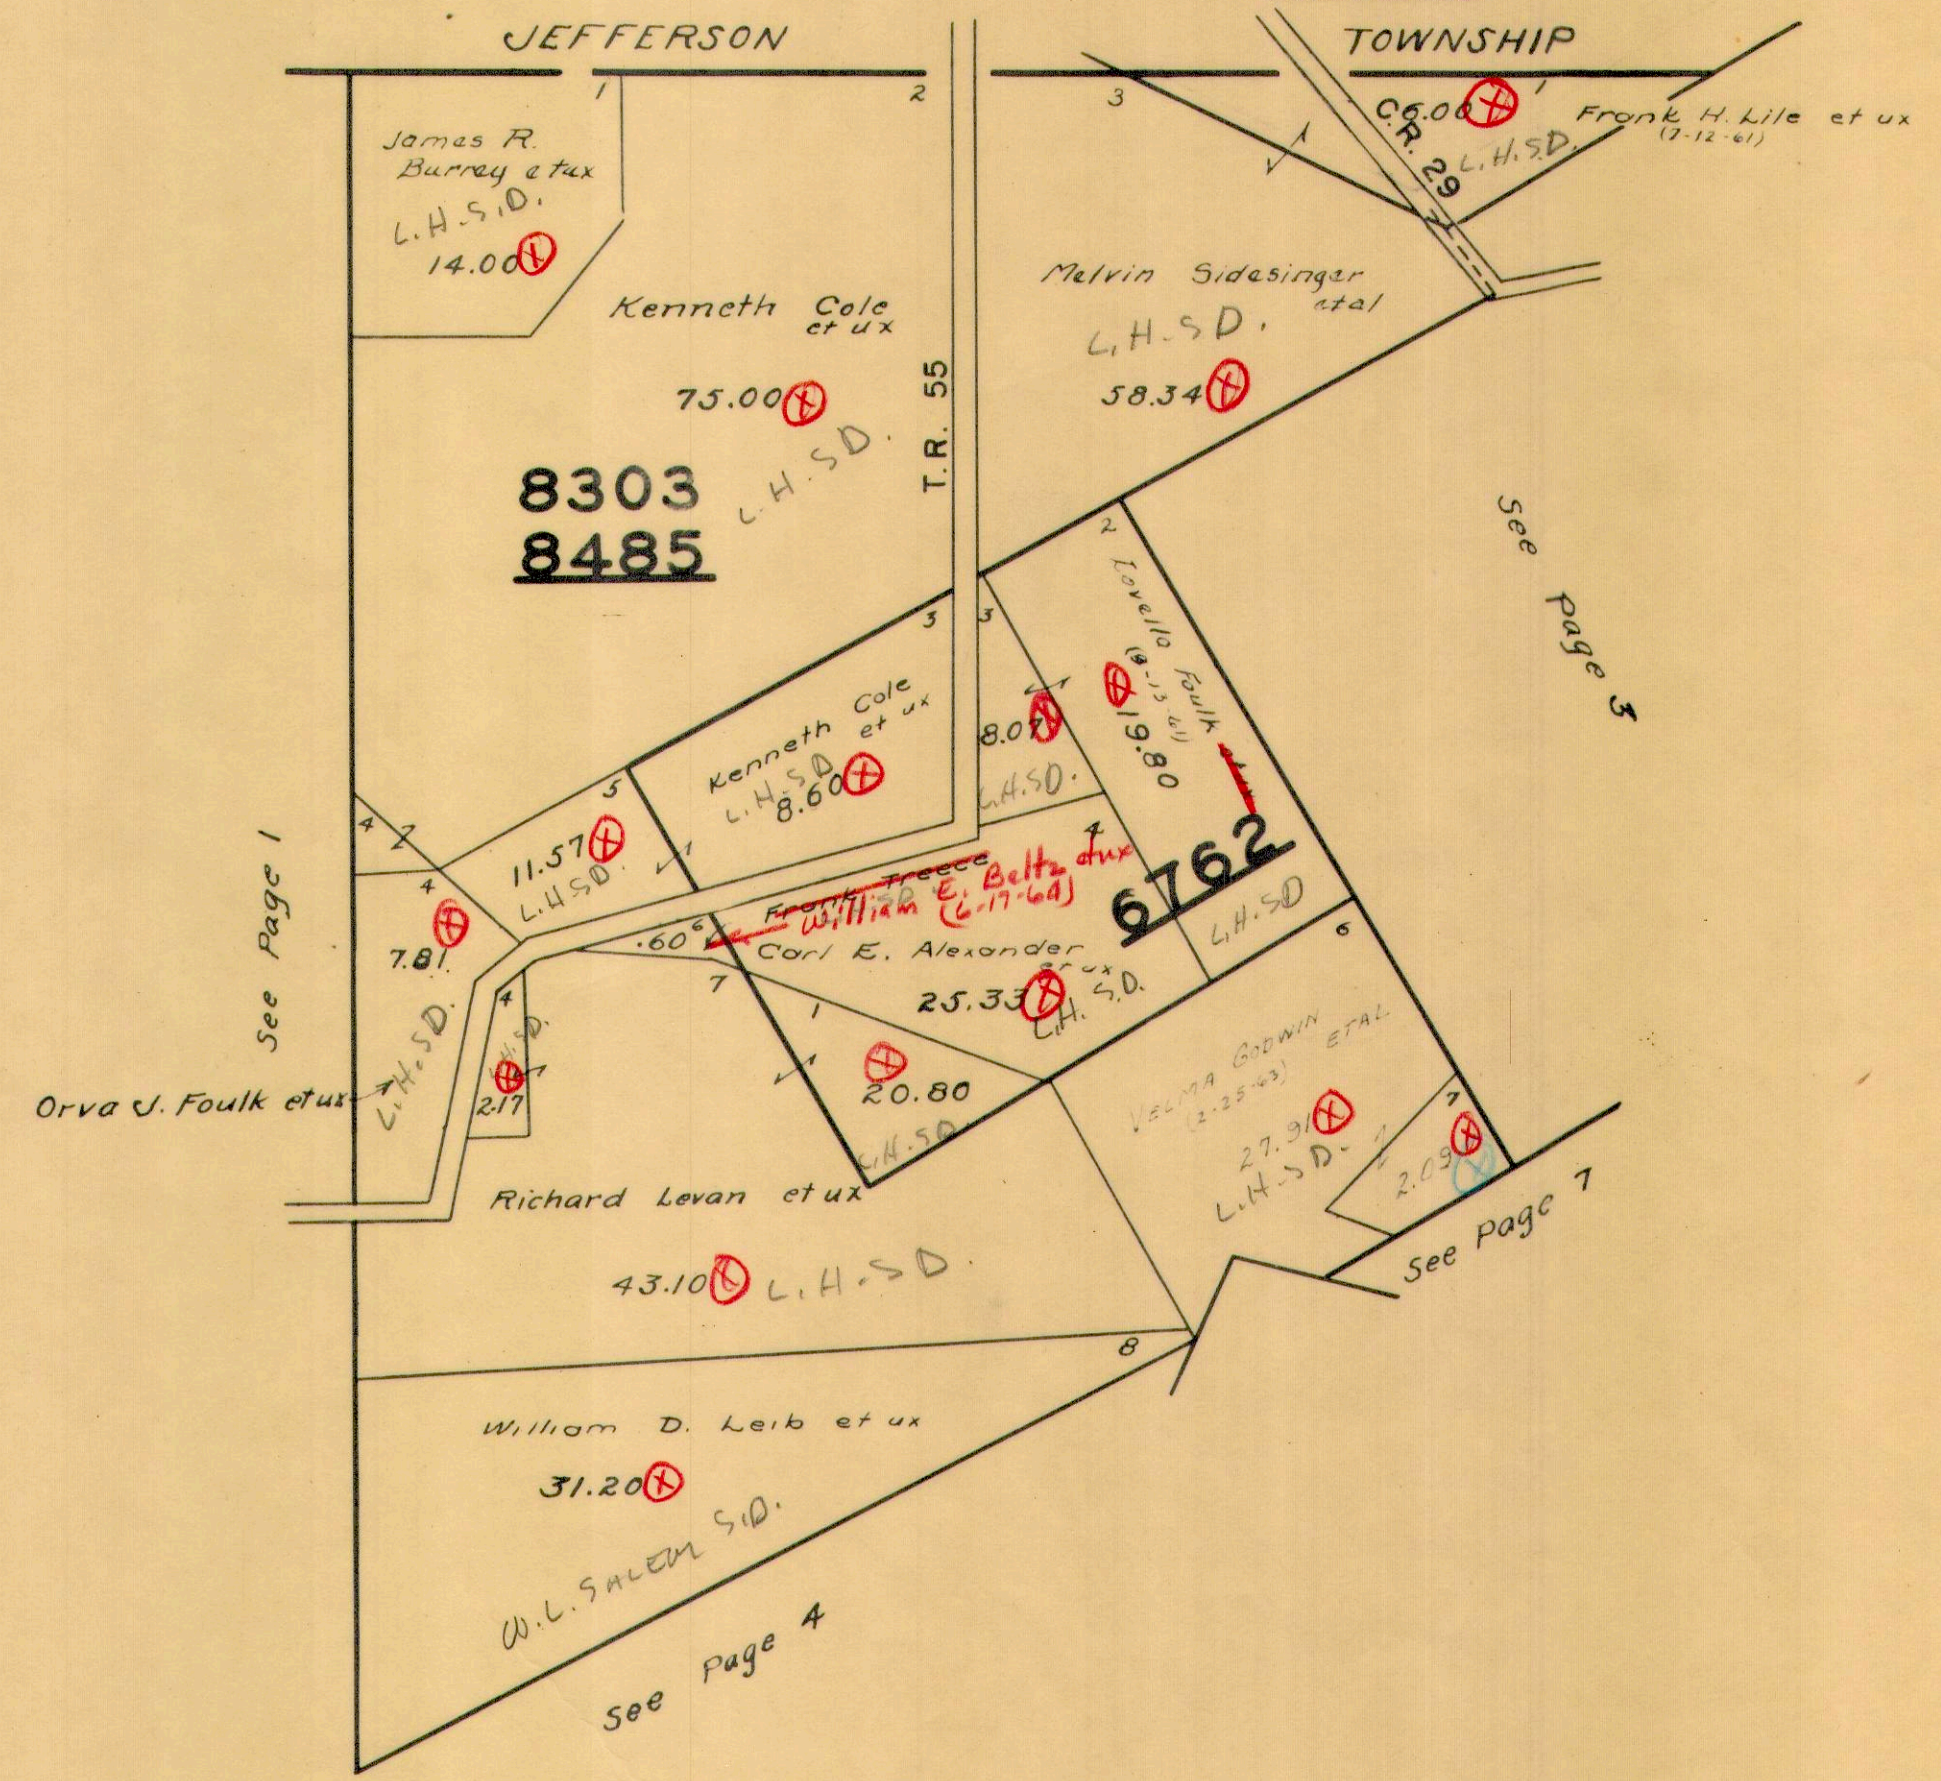


VIRGINIA MILITARY SURVEY 4957

SCALE 10 CHAINS TO THE INCH

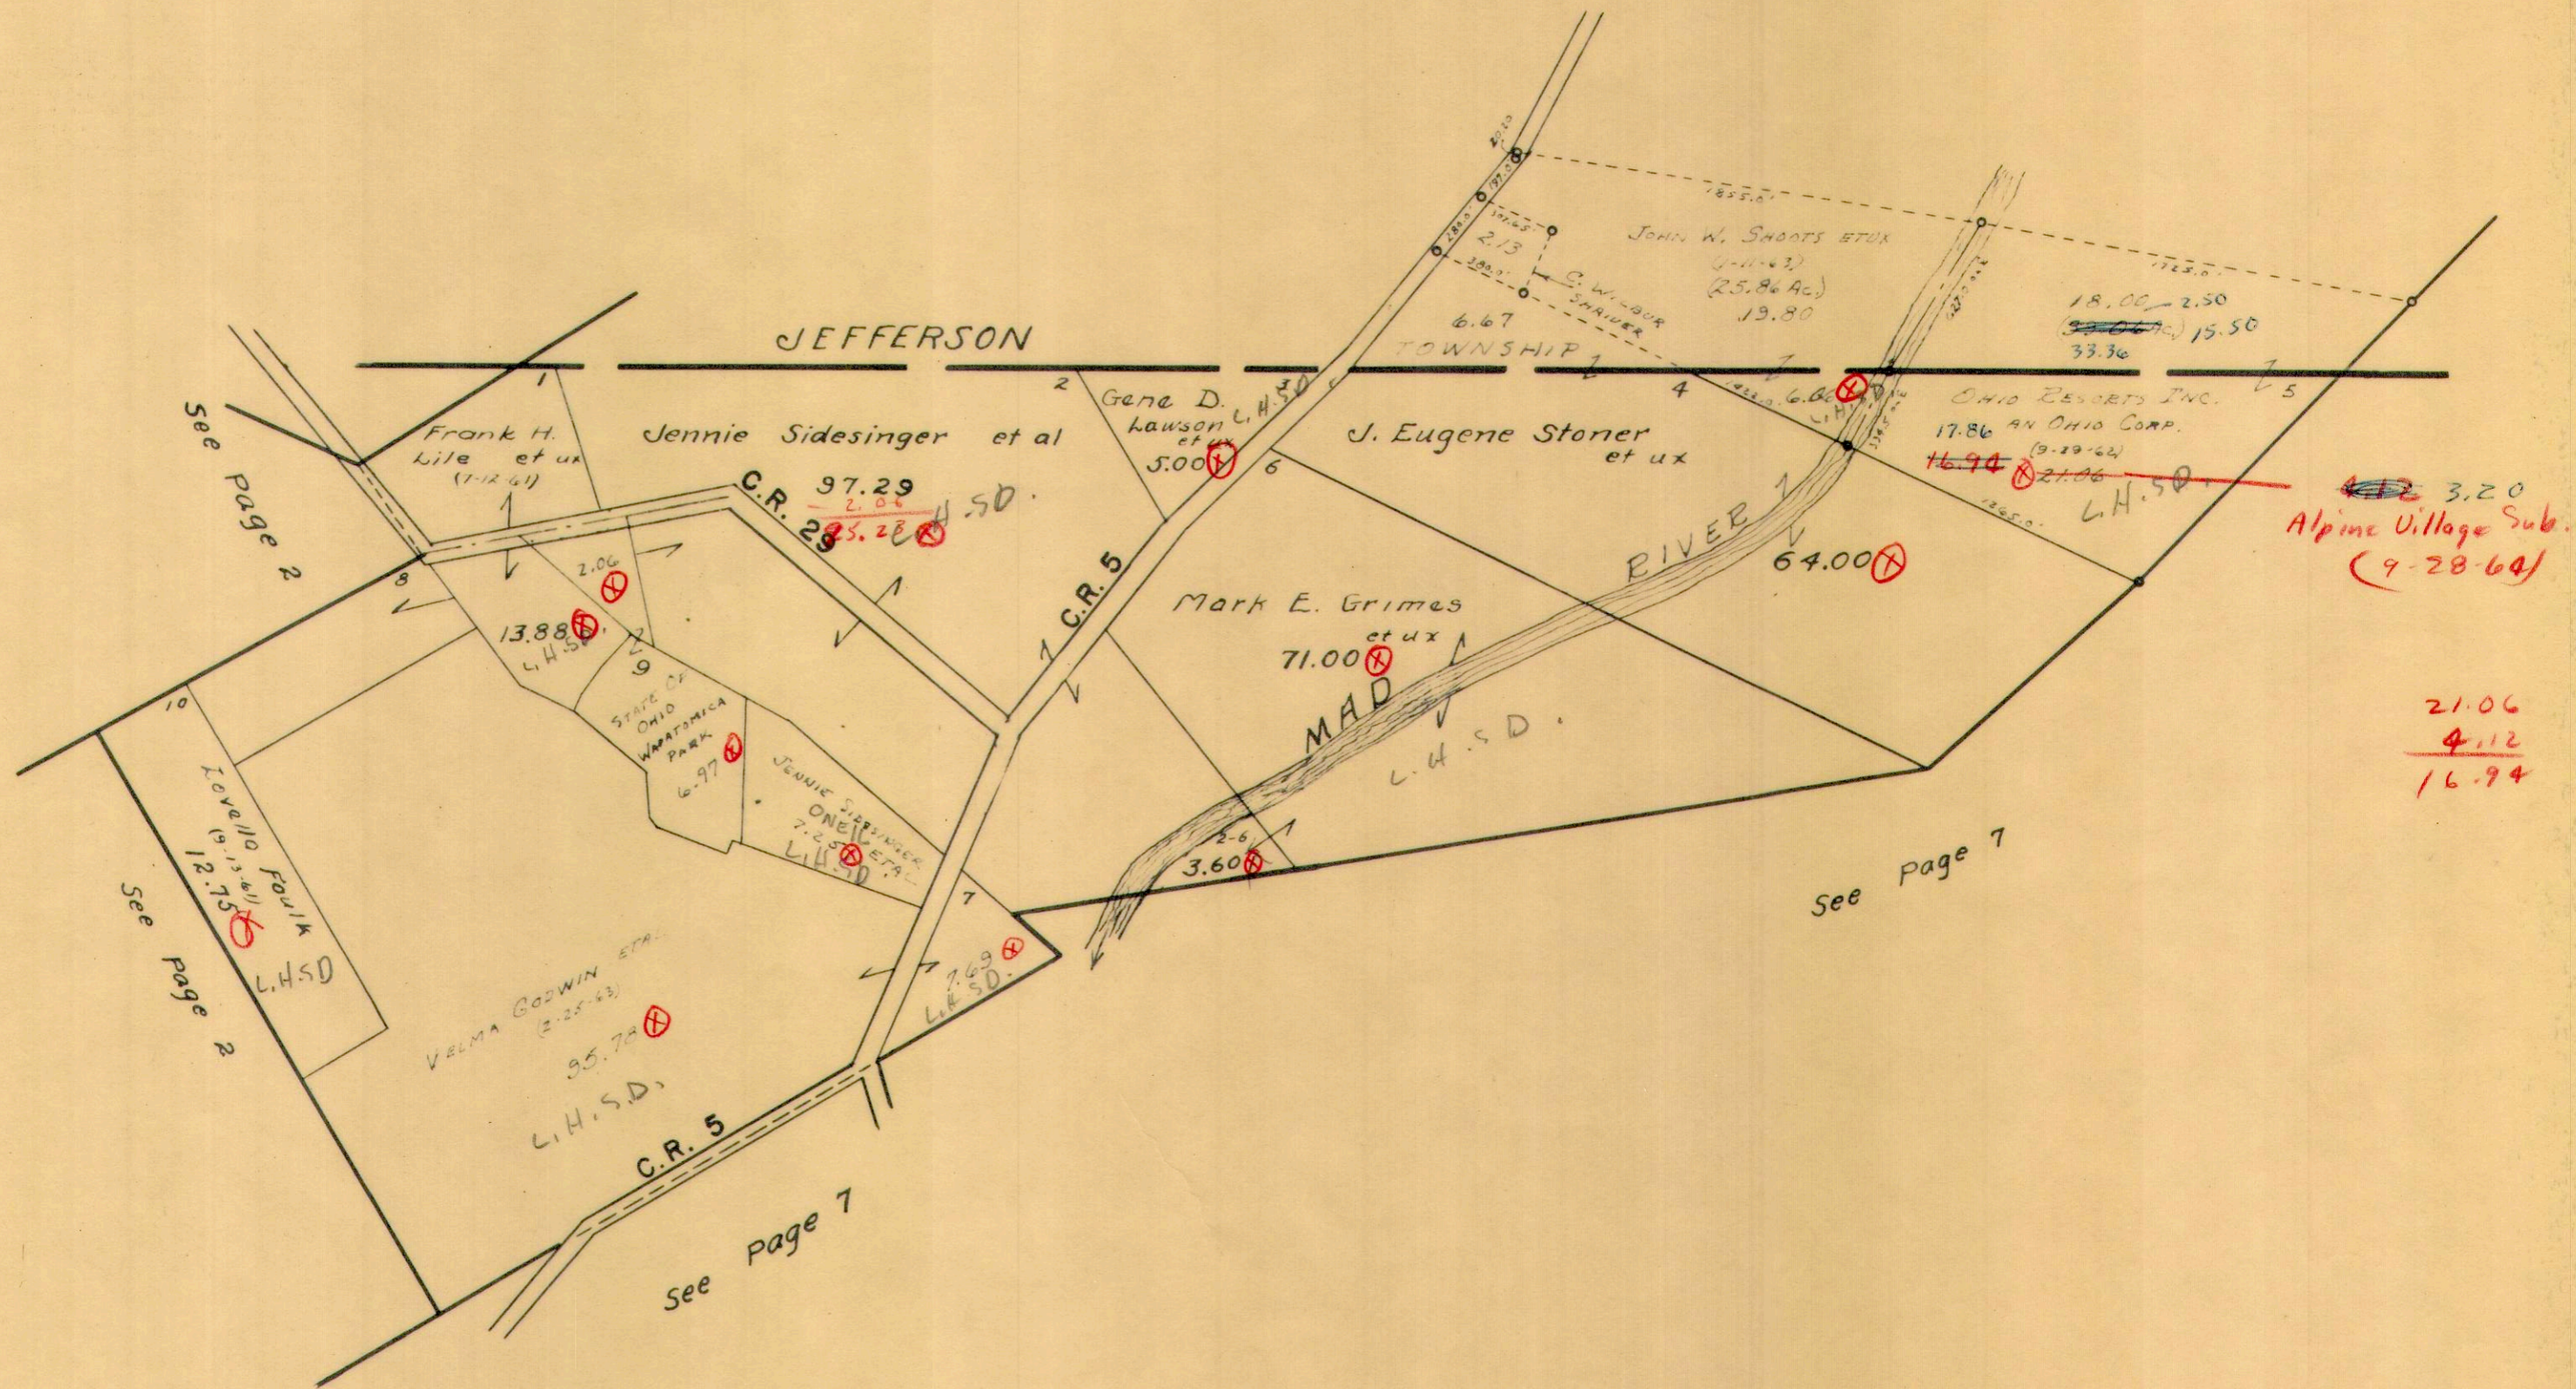

MONROE TOWNSHIP
VIRGINIA MILITARY SURVEYS 9793 10853
SCALE 10 CHAINS TO THE INCH

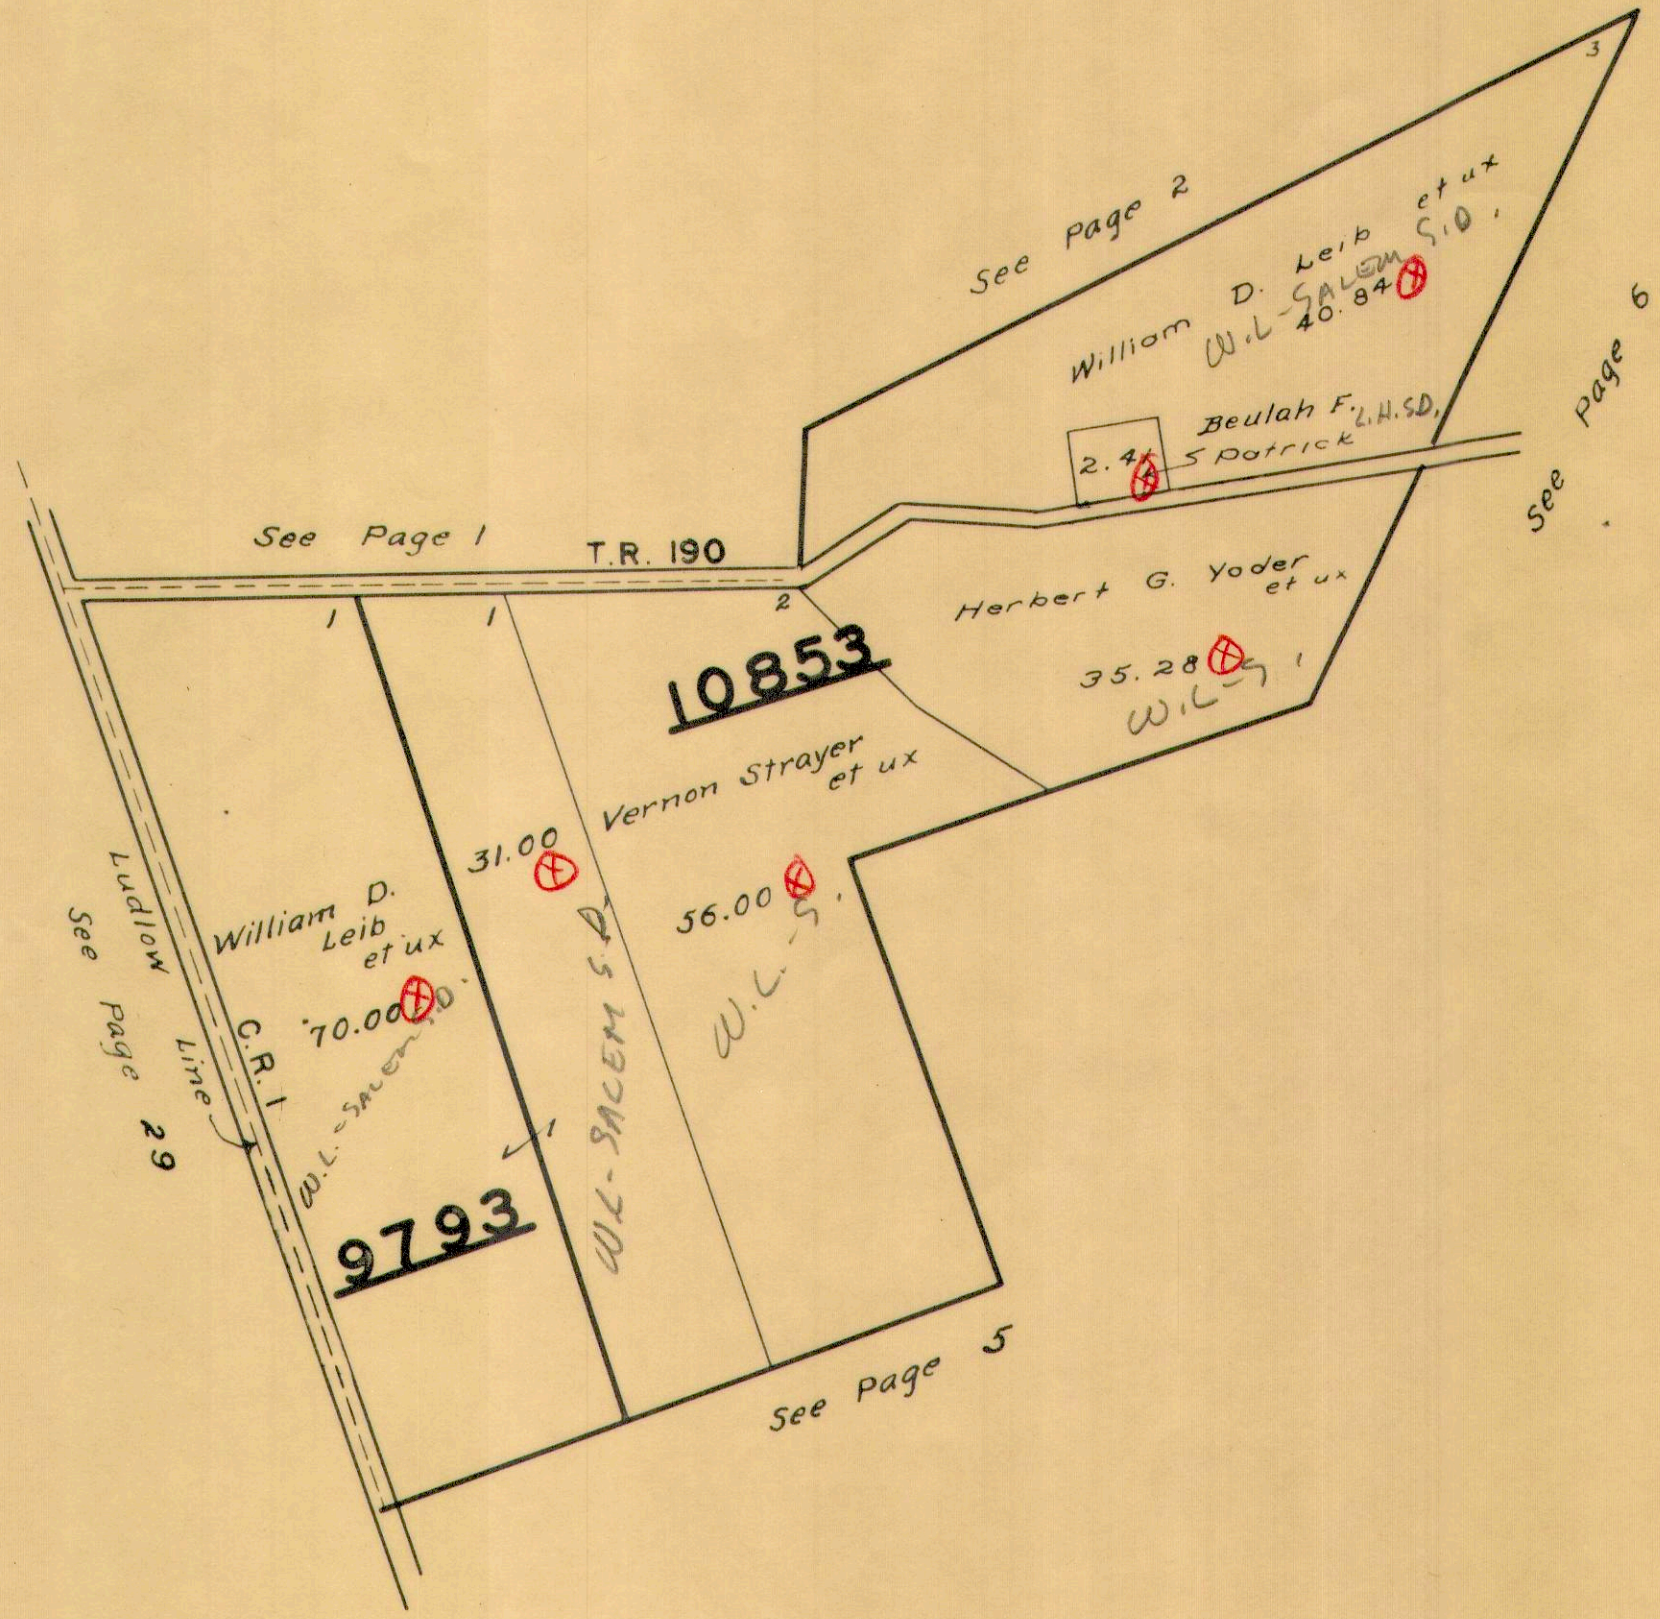


VIRGINIA MILITARY SURVEYS {4493
4525

SCALE 10 CHAINS TO THE INCH




VIRGINIA MILITARY SURVEY 12099

SCALE 10 CHAINS TO THE INCH

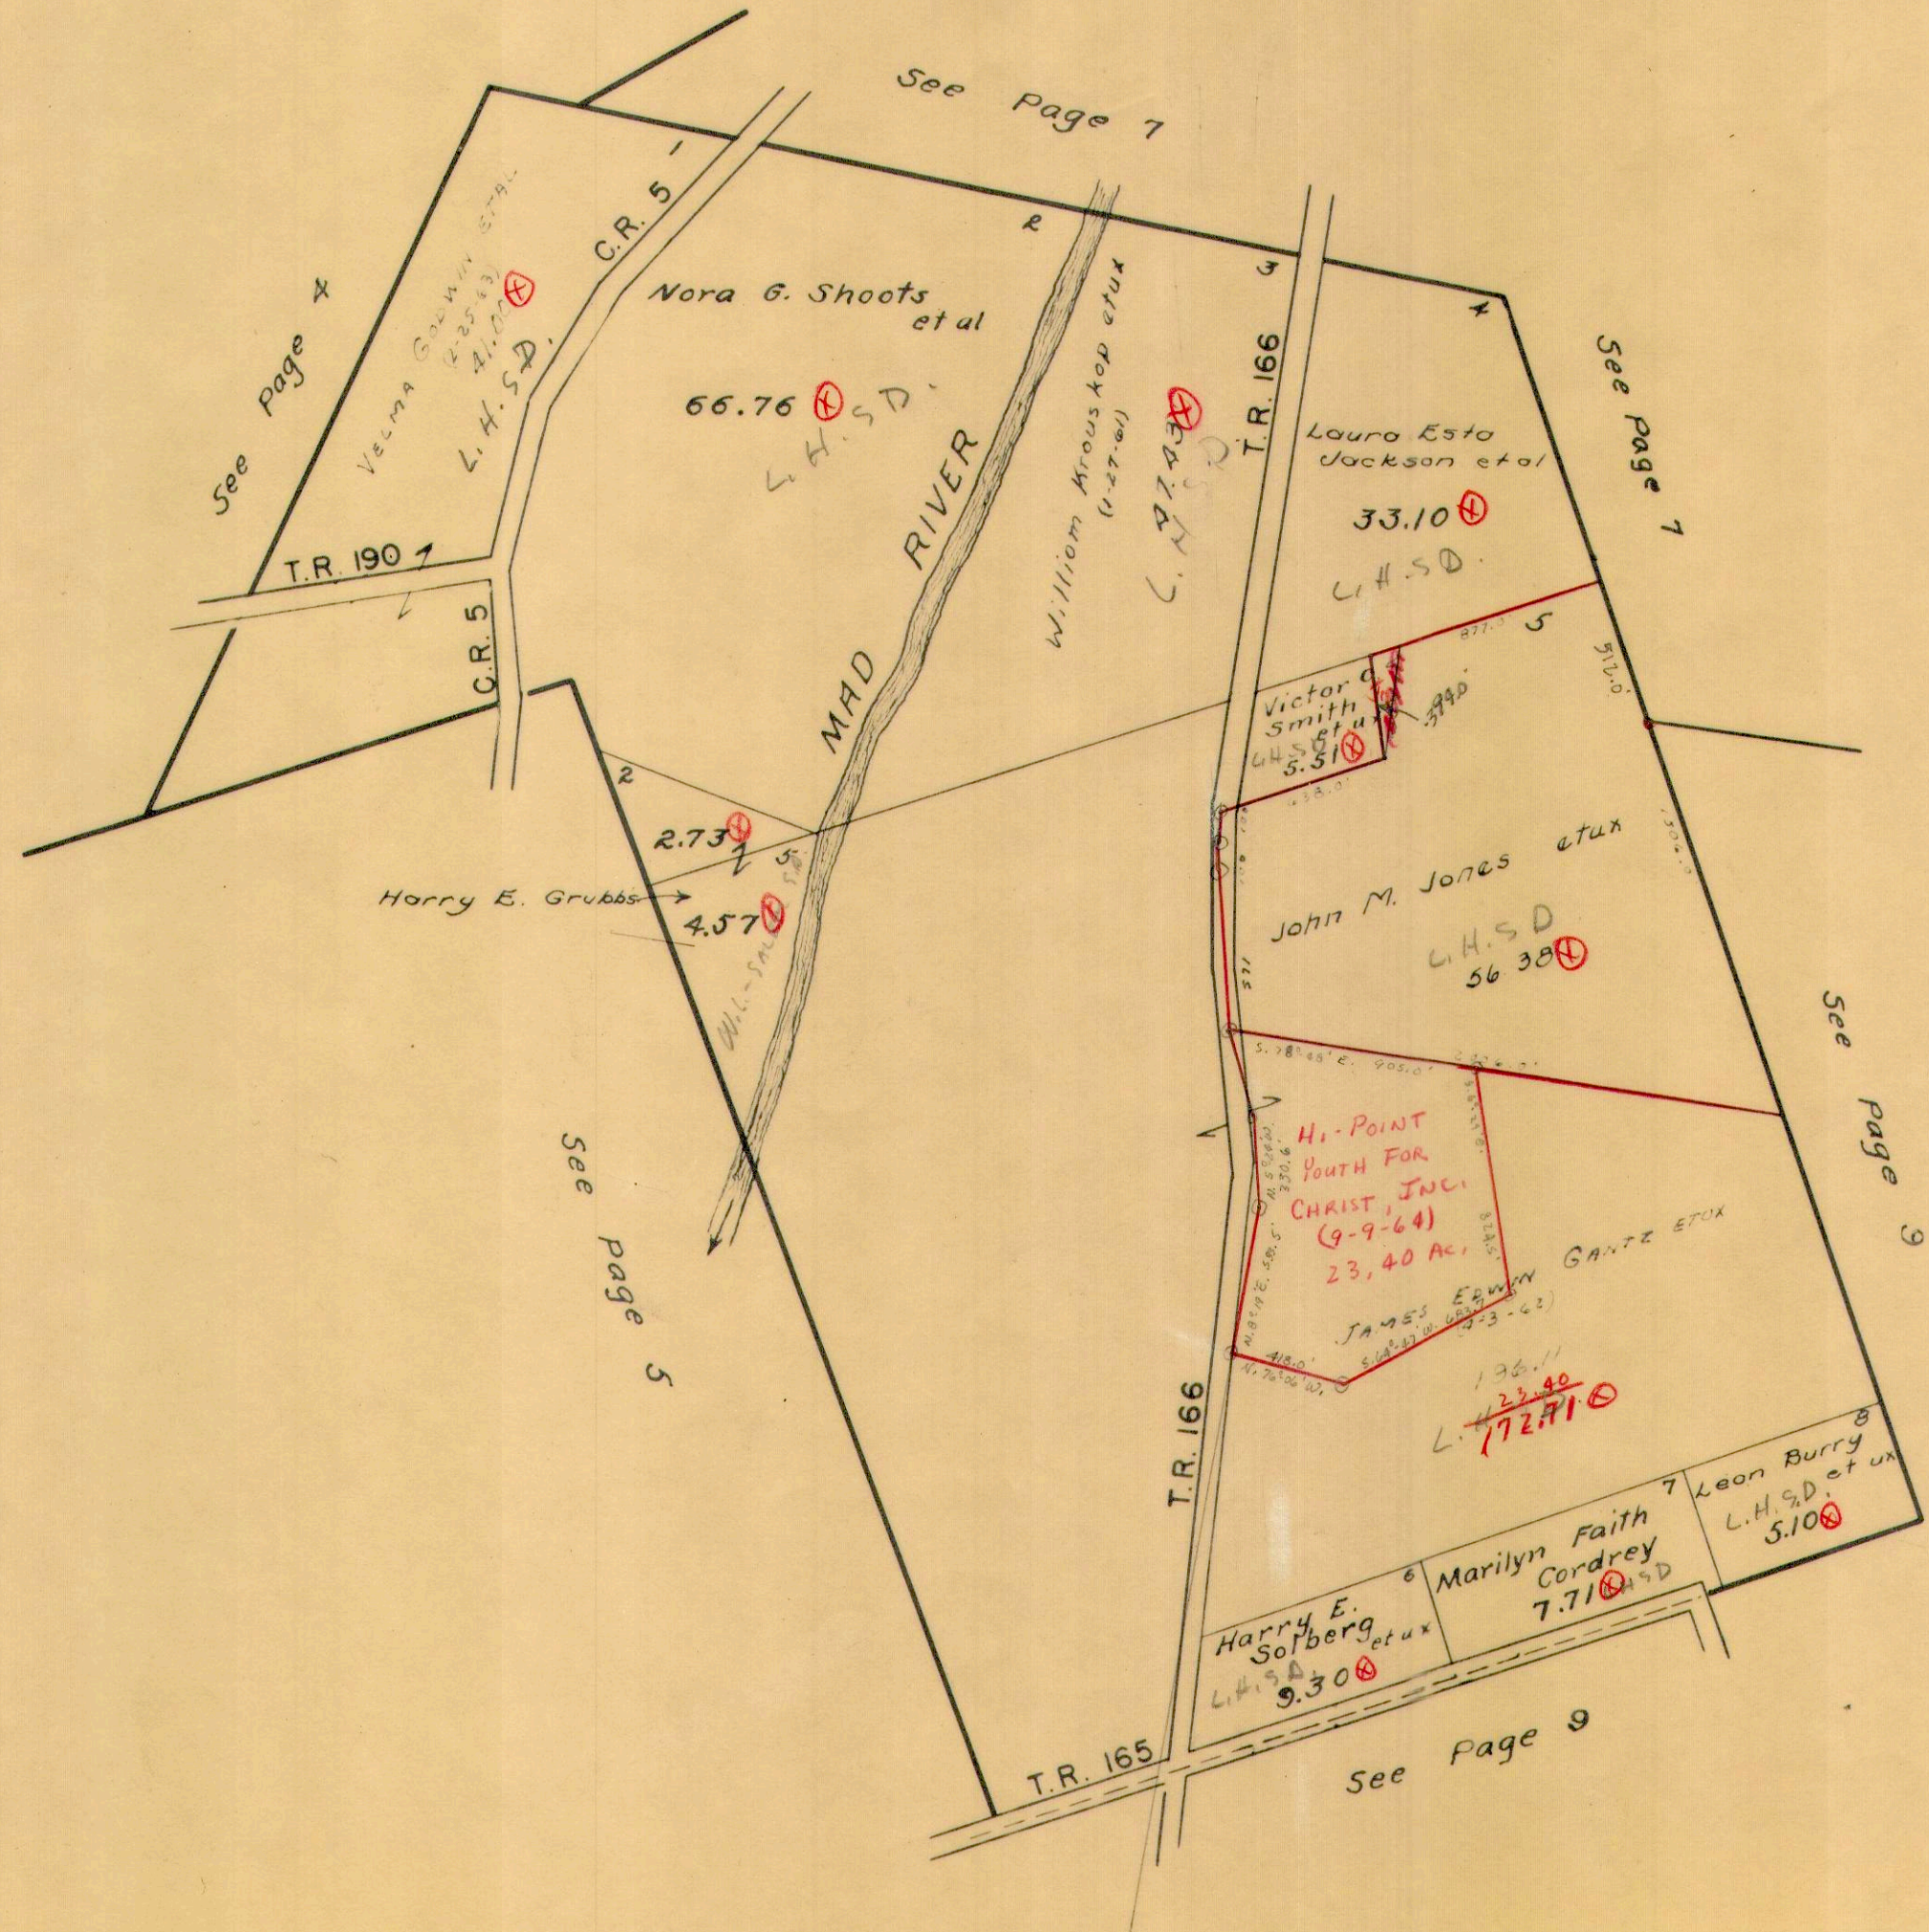


9592
9618
10075
3242

SCALE 10 CHAINS TO THE INCH

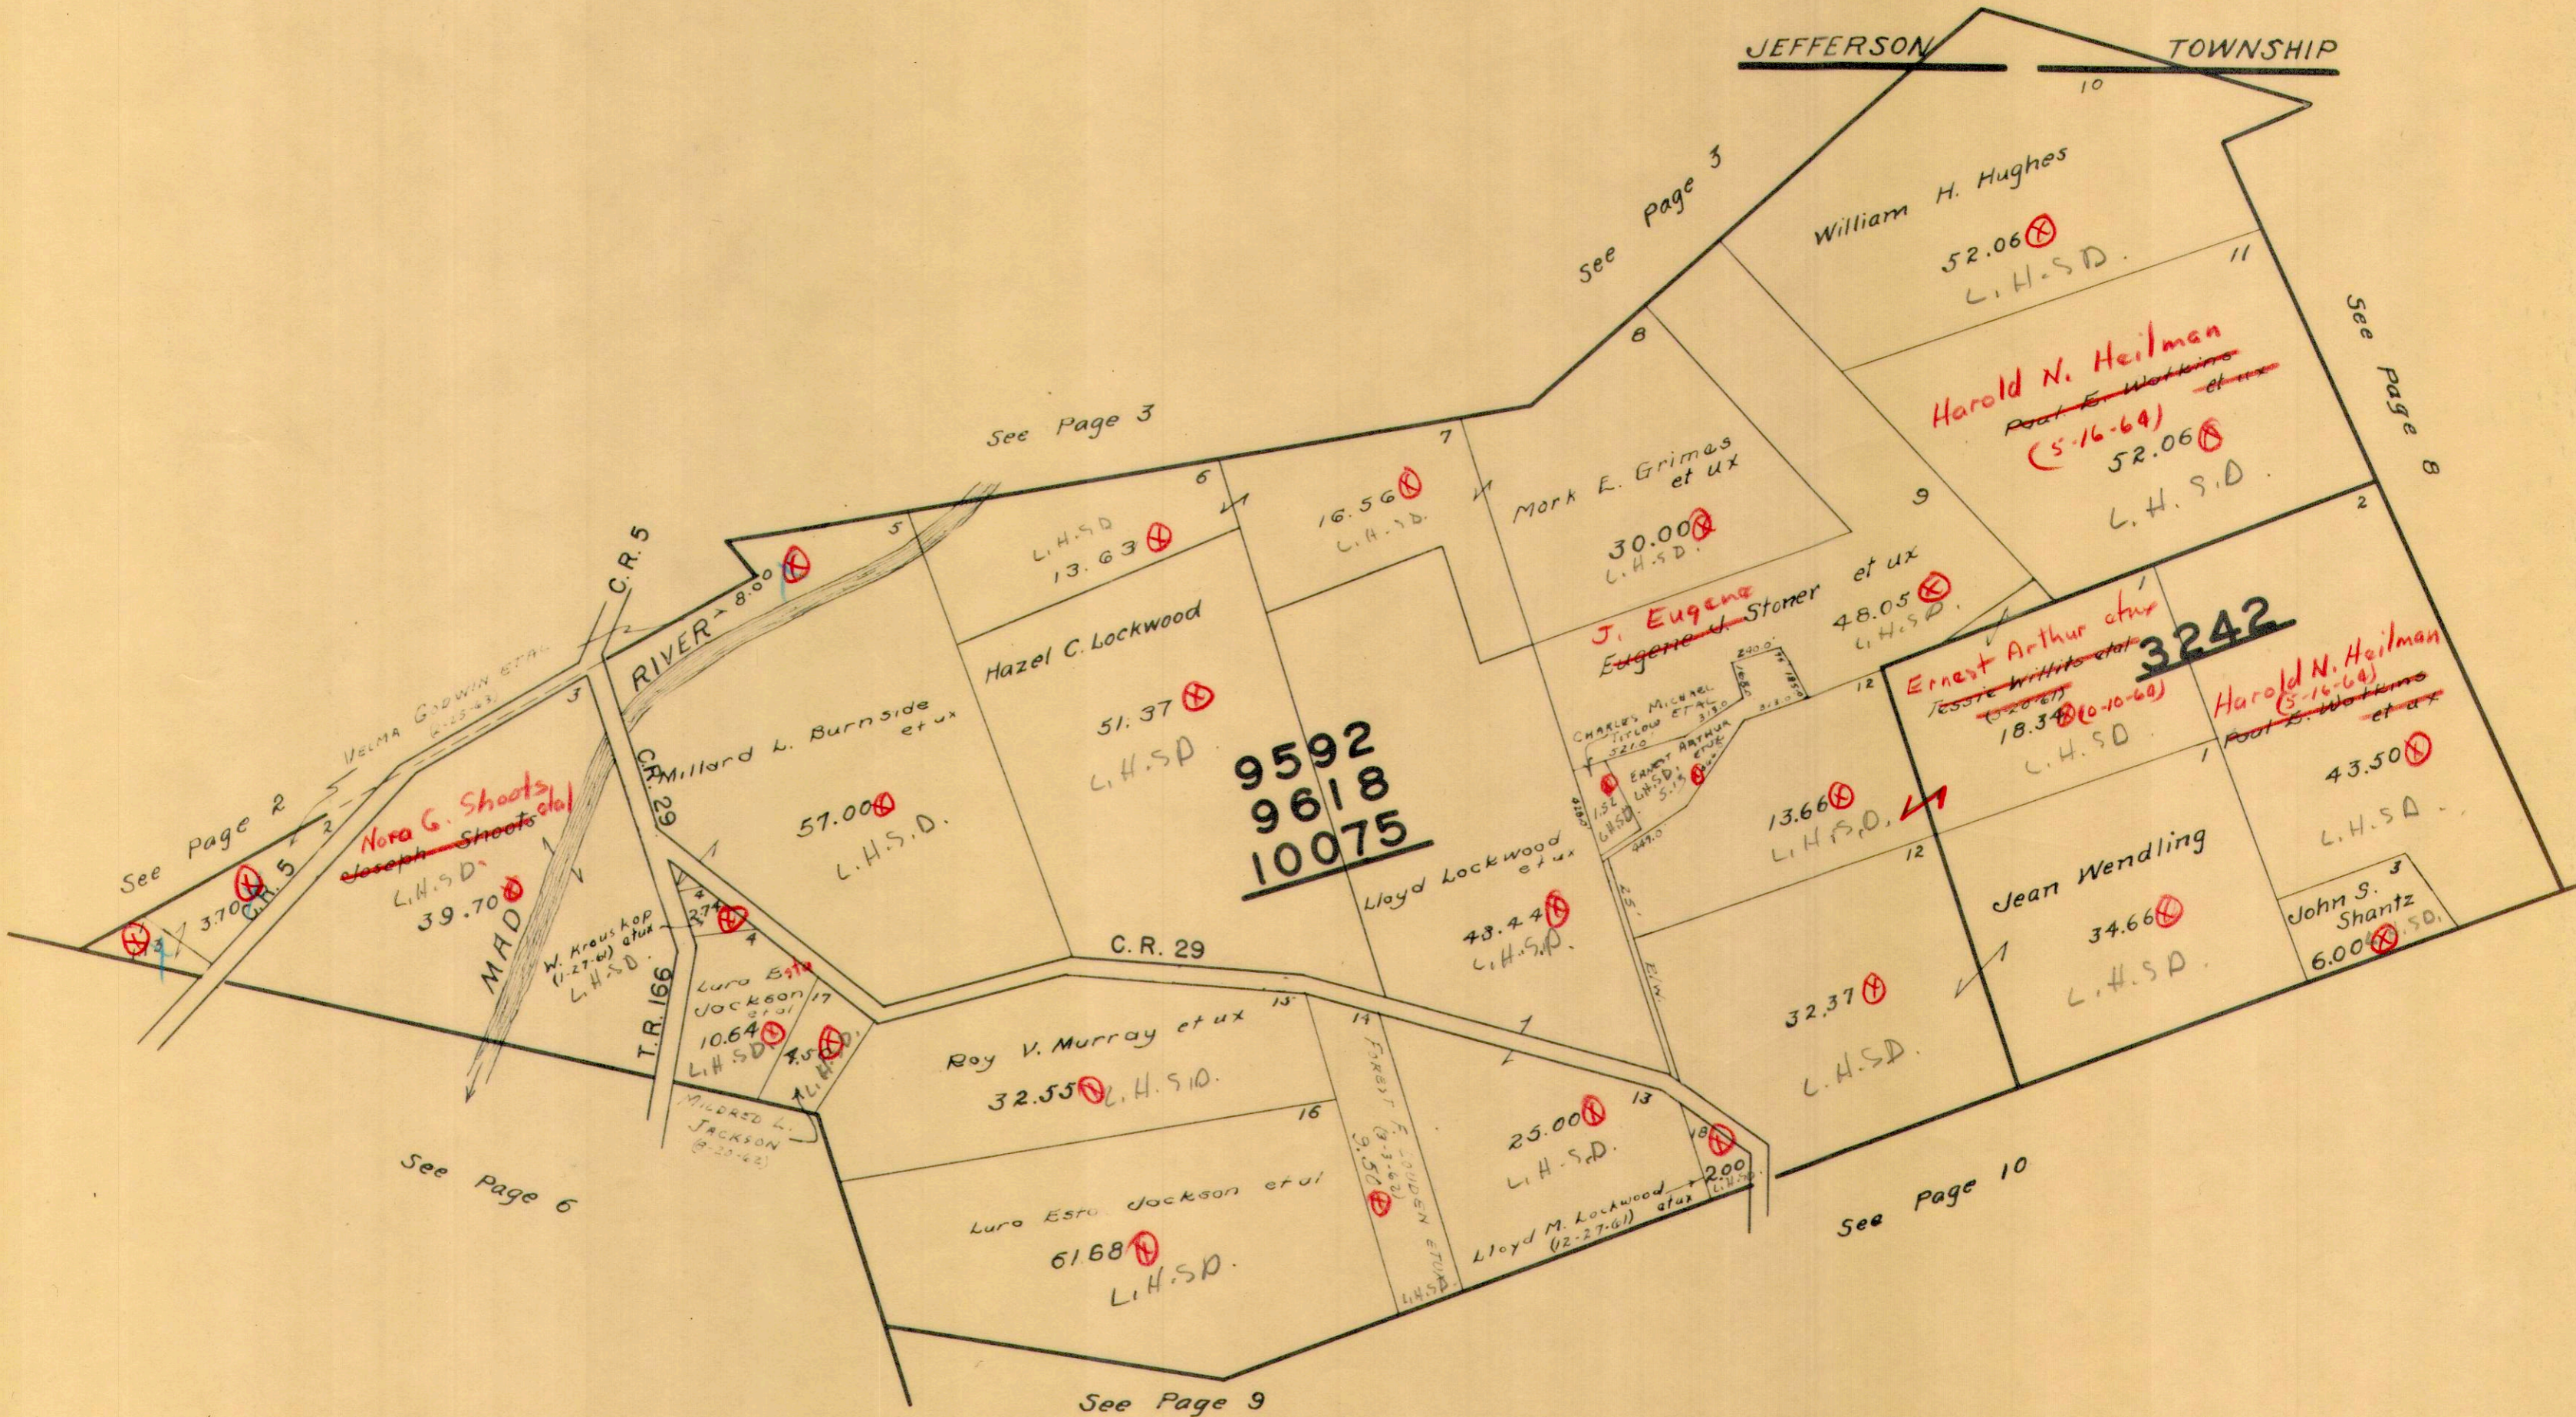


MONROE TOWNSHIP
VIRGINIA MILITARY SURVEY 3222

SCALE 10 CHAINS TO THE INCH

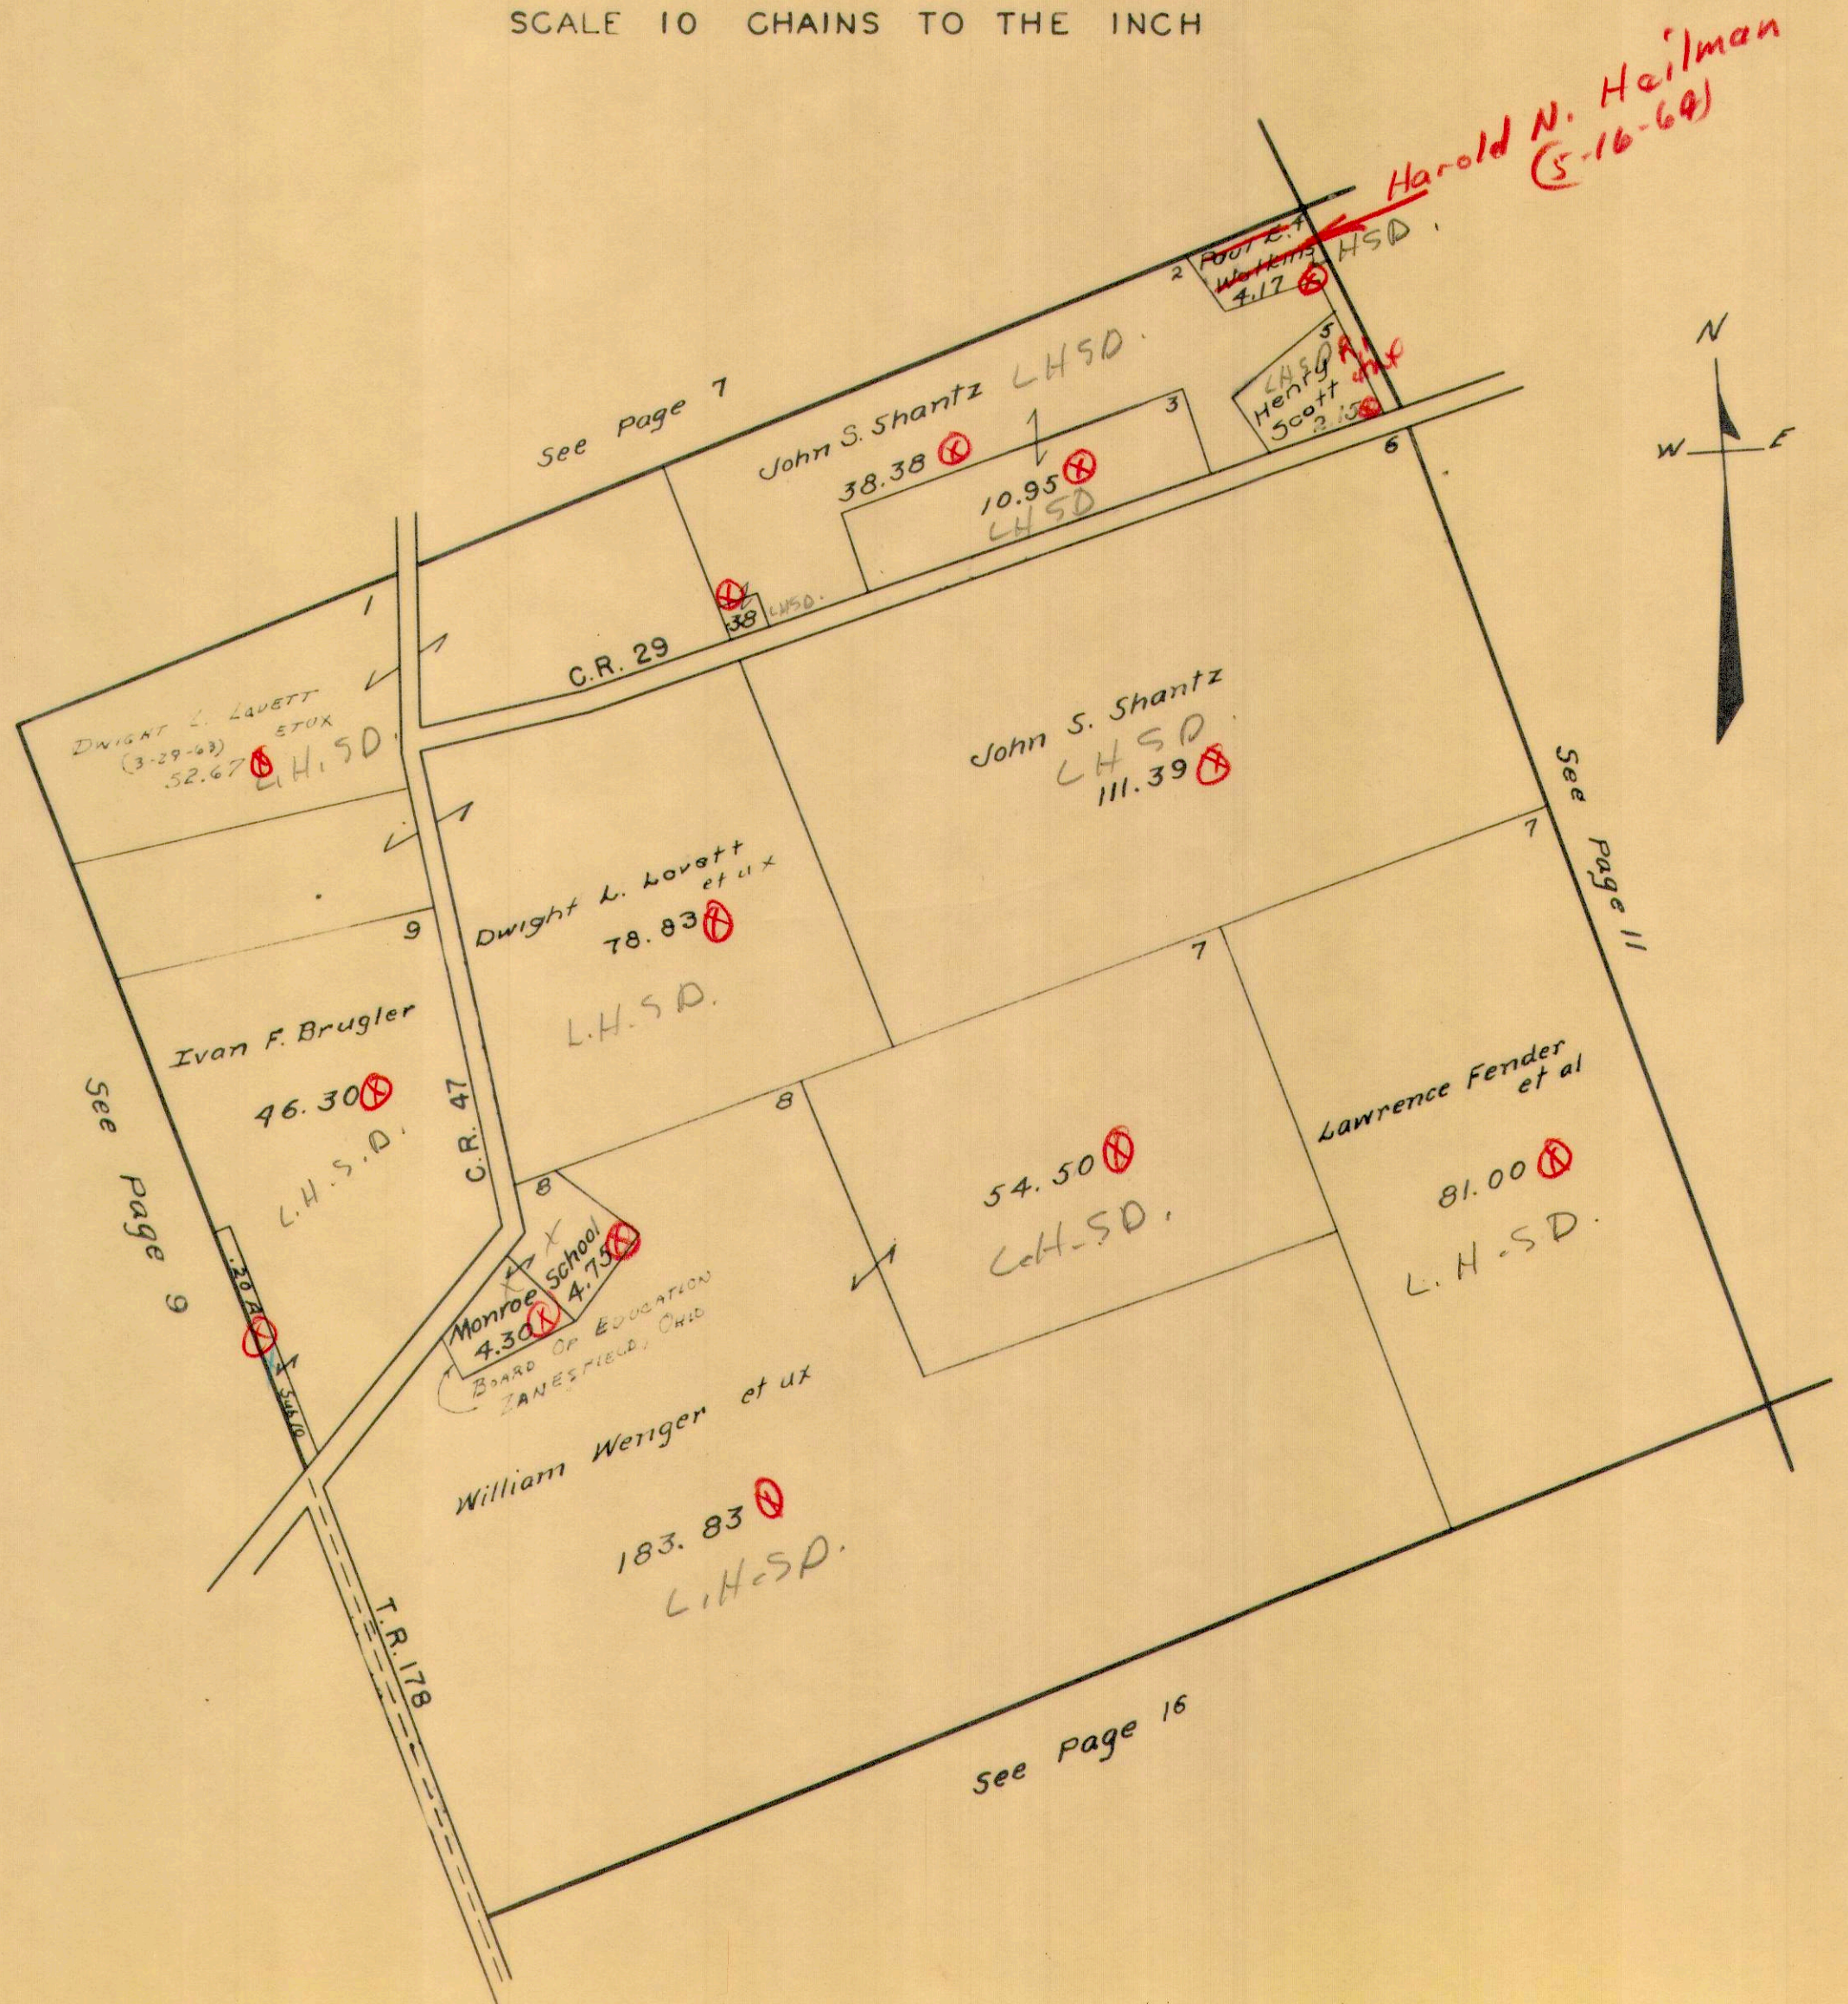

MONROE TOWNSHIP
 VIRGINIA MILITARY SURVEY 3221


SCALE 10 CHAINS TO THE INCH

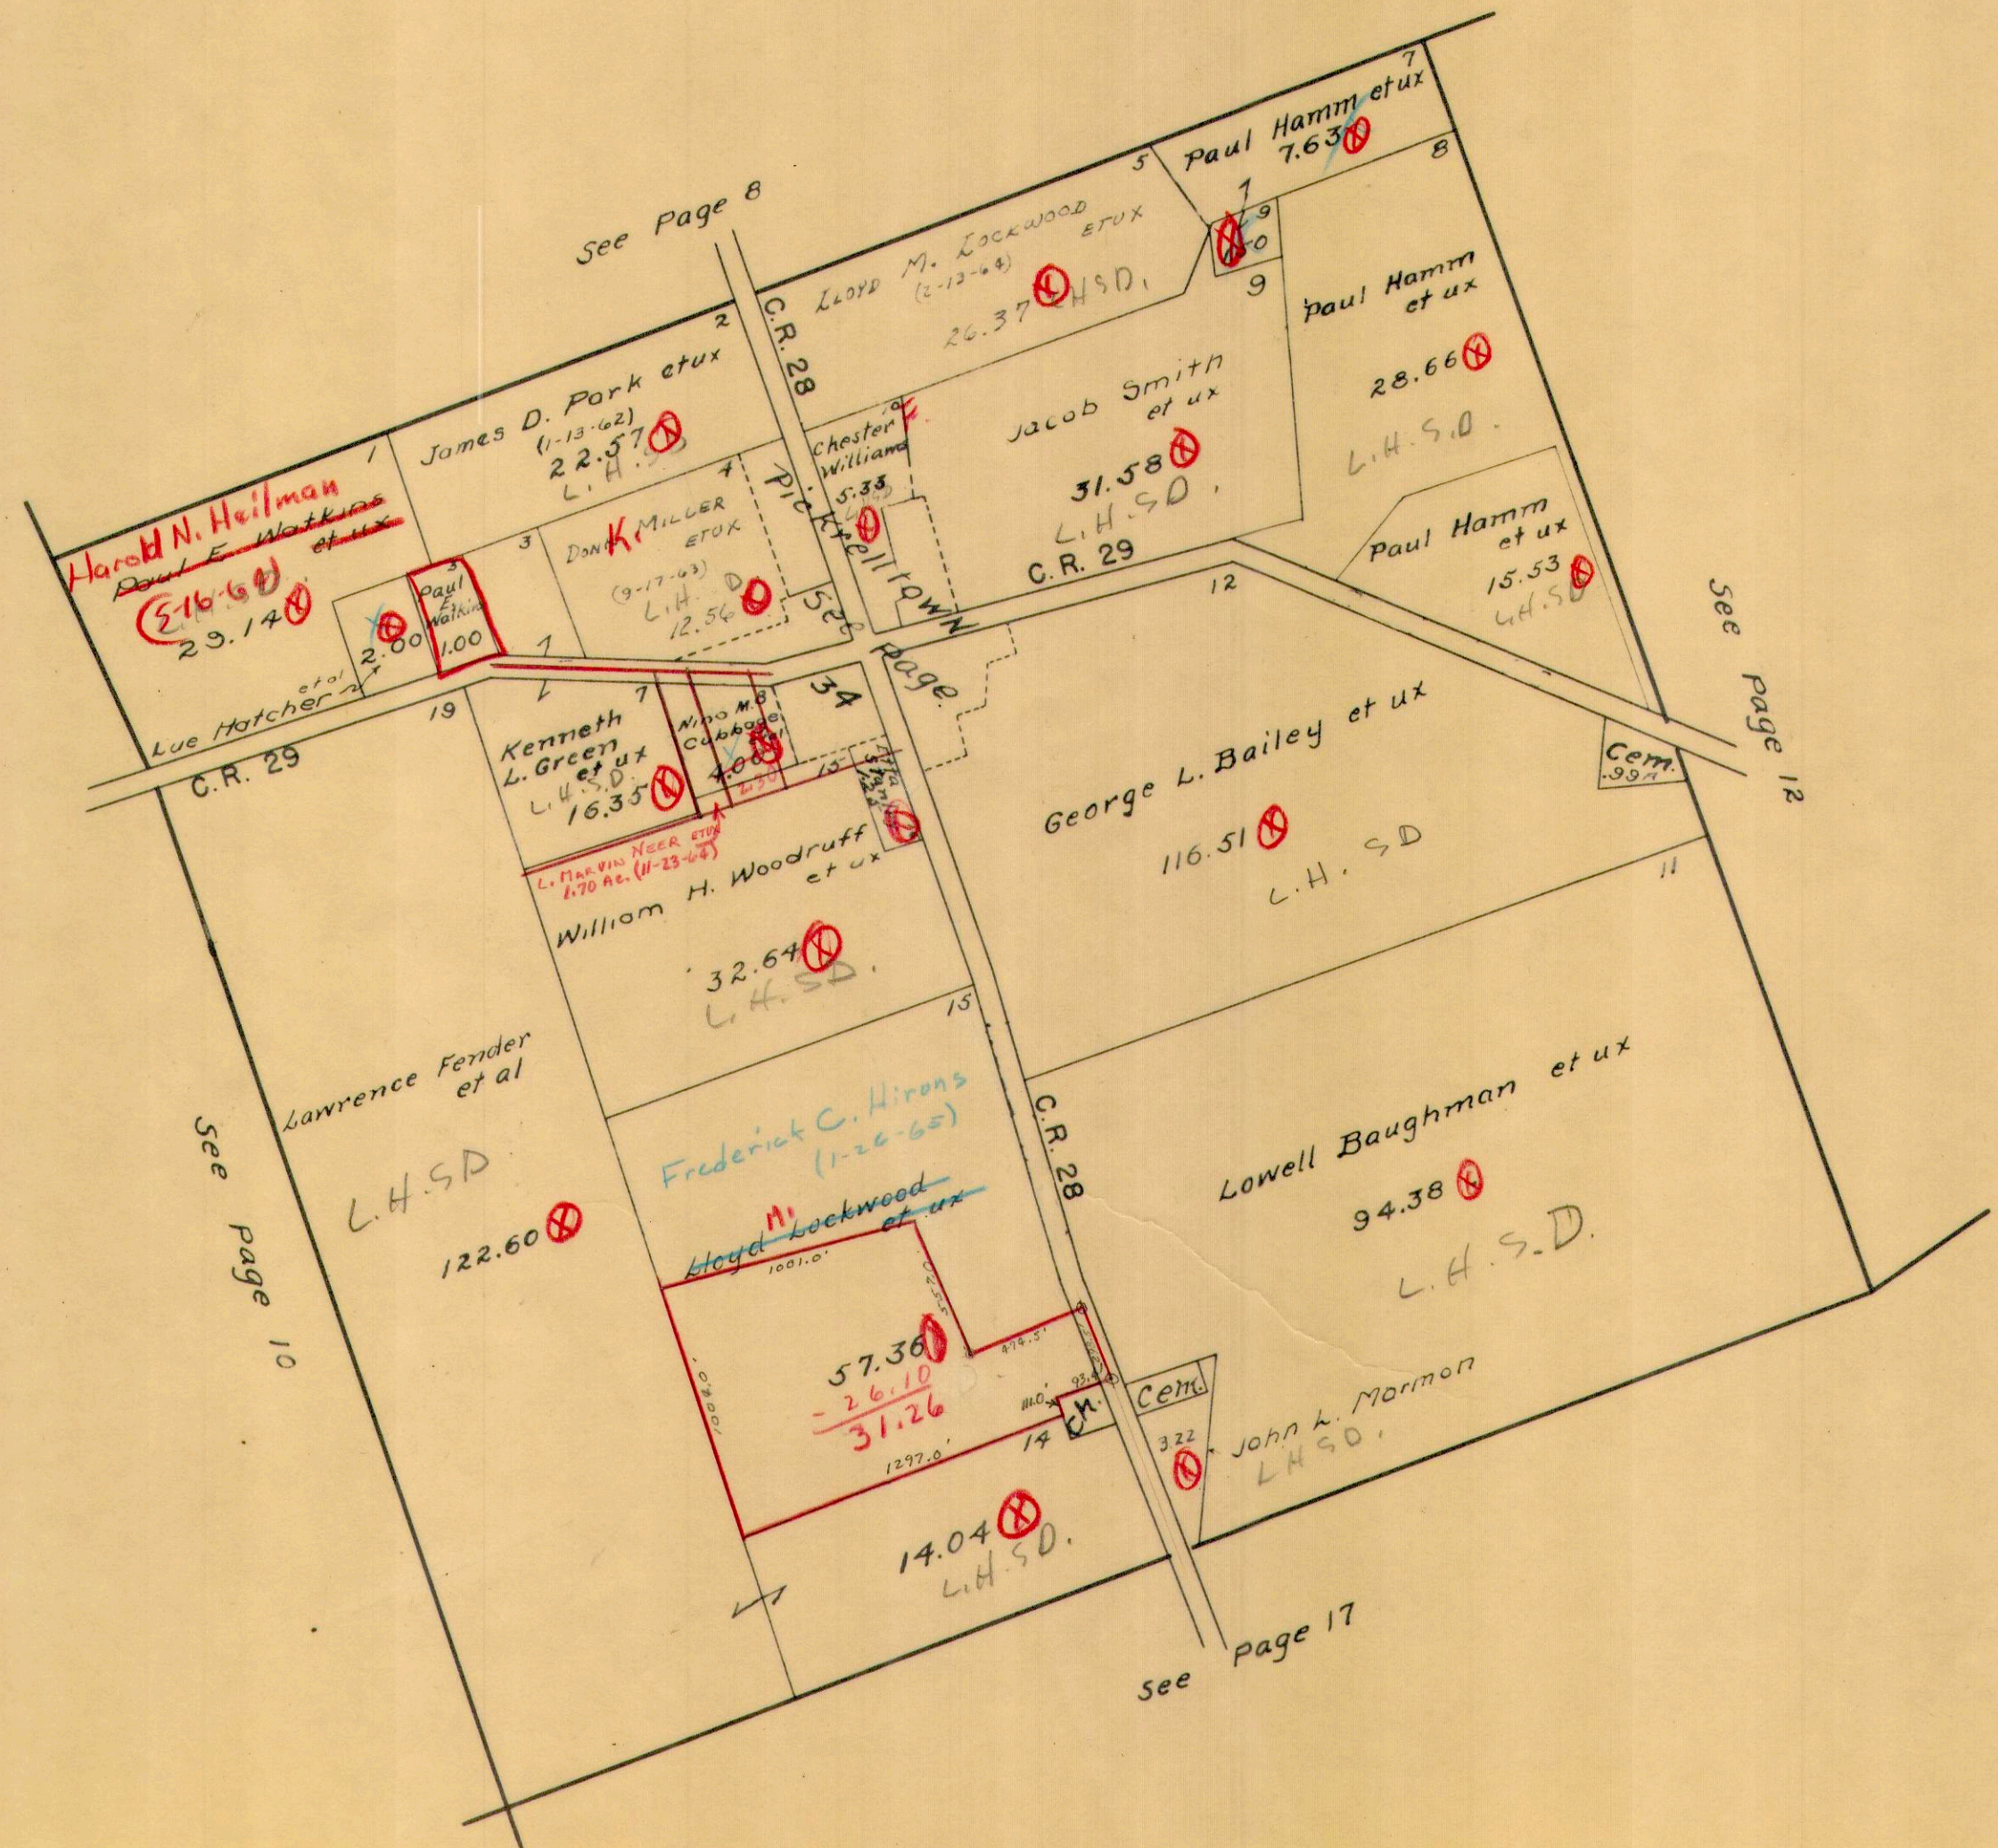

4.00
 1.70
 2.30



SCALE 10 CHAINS TO THE INCH

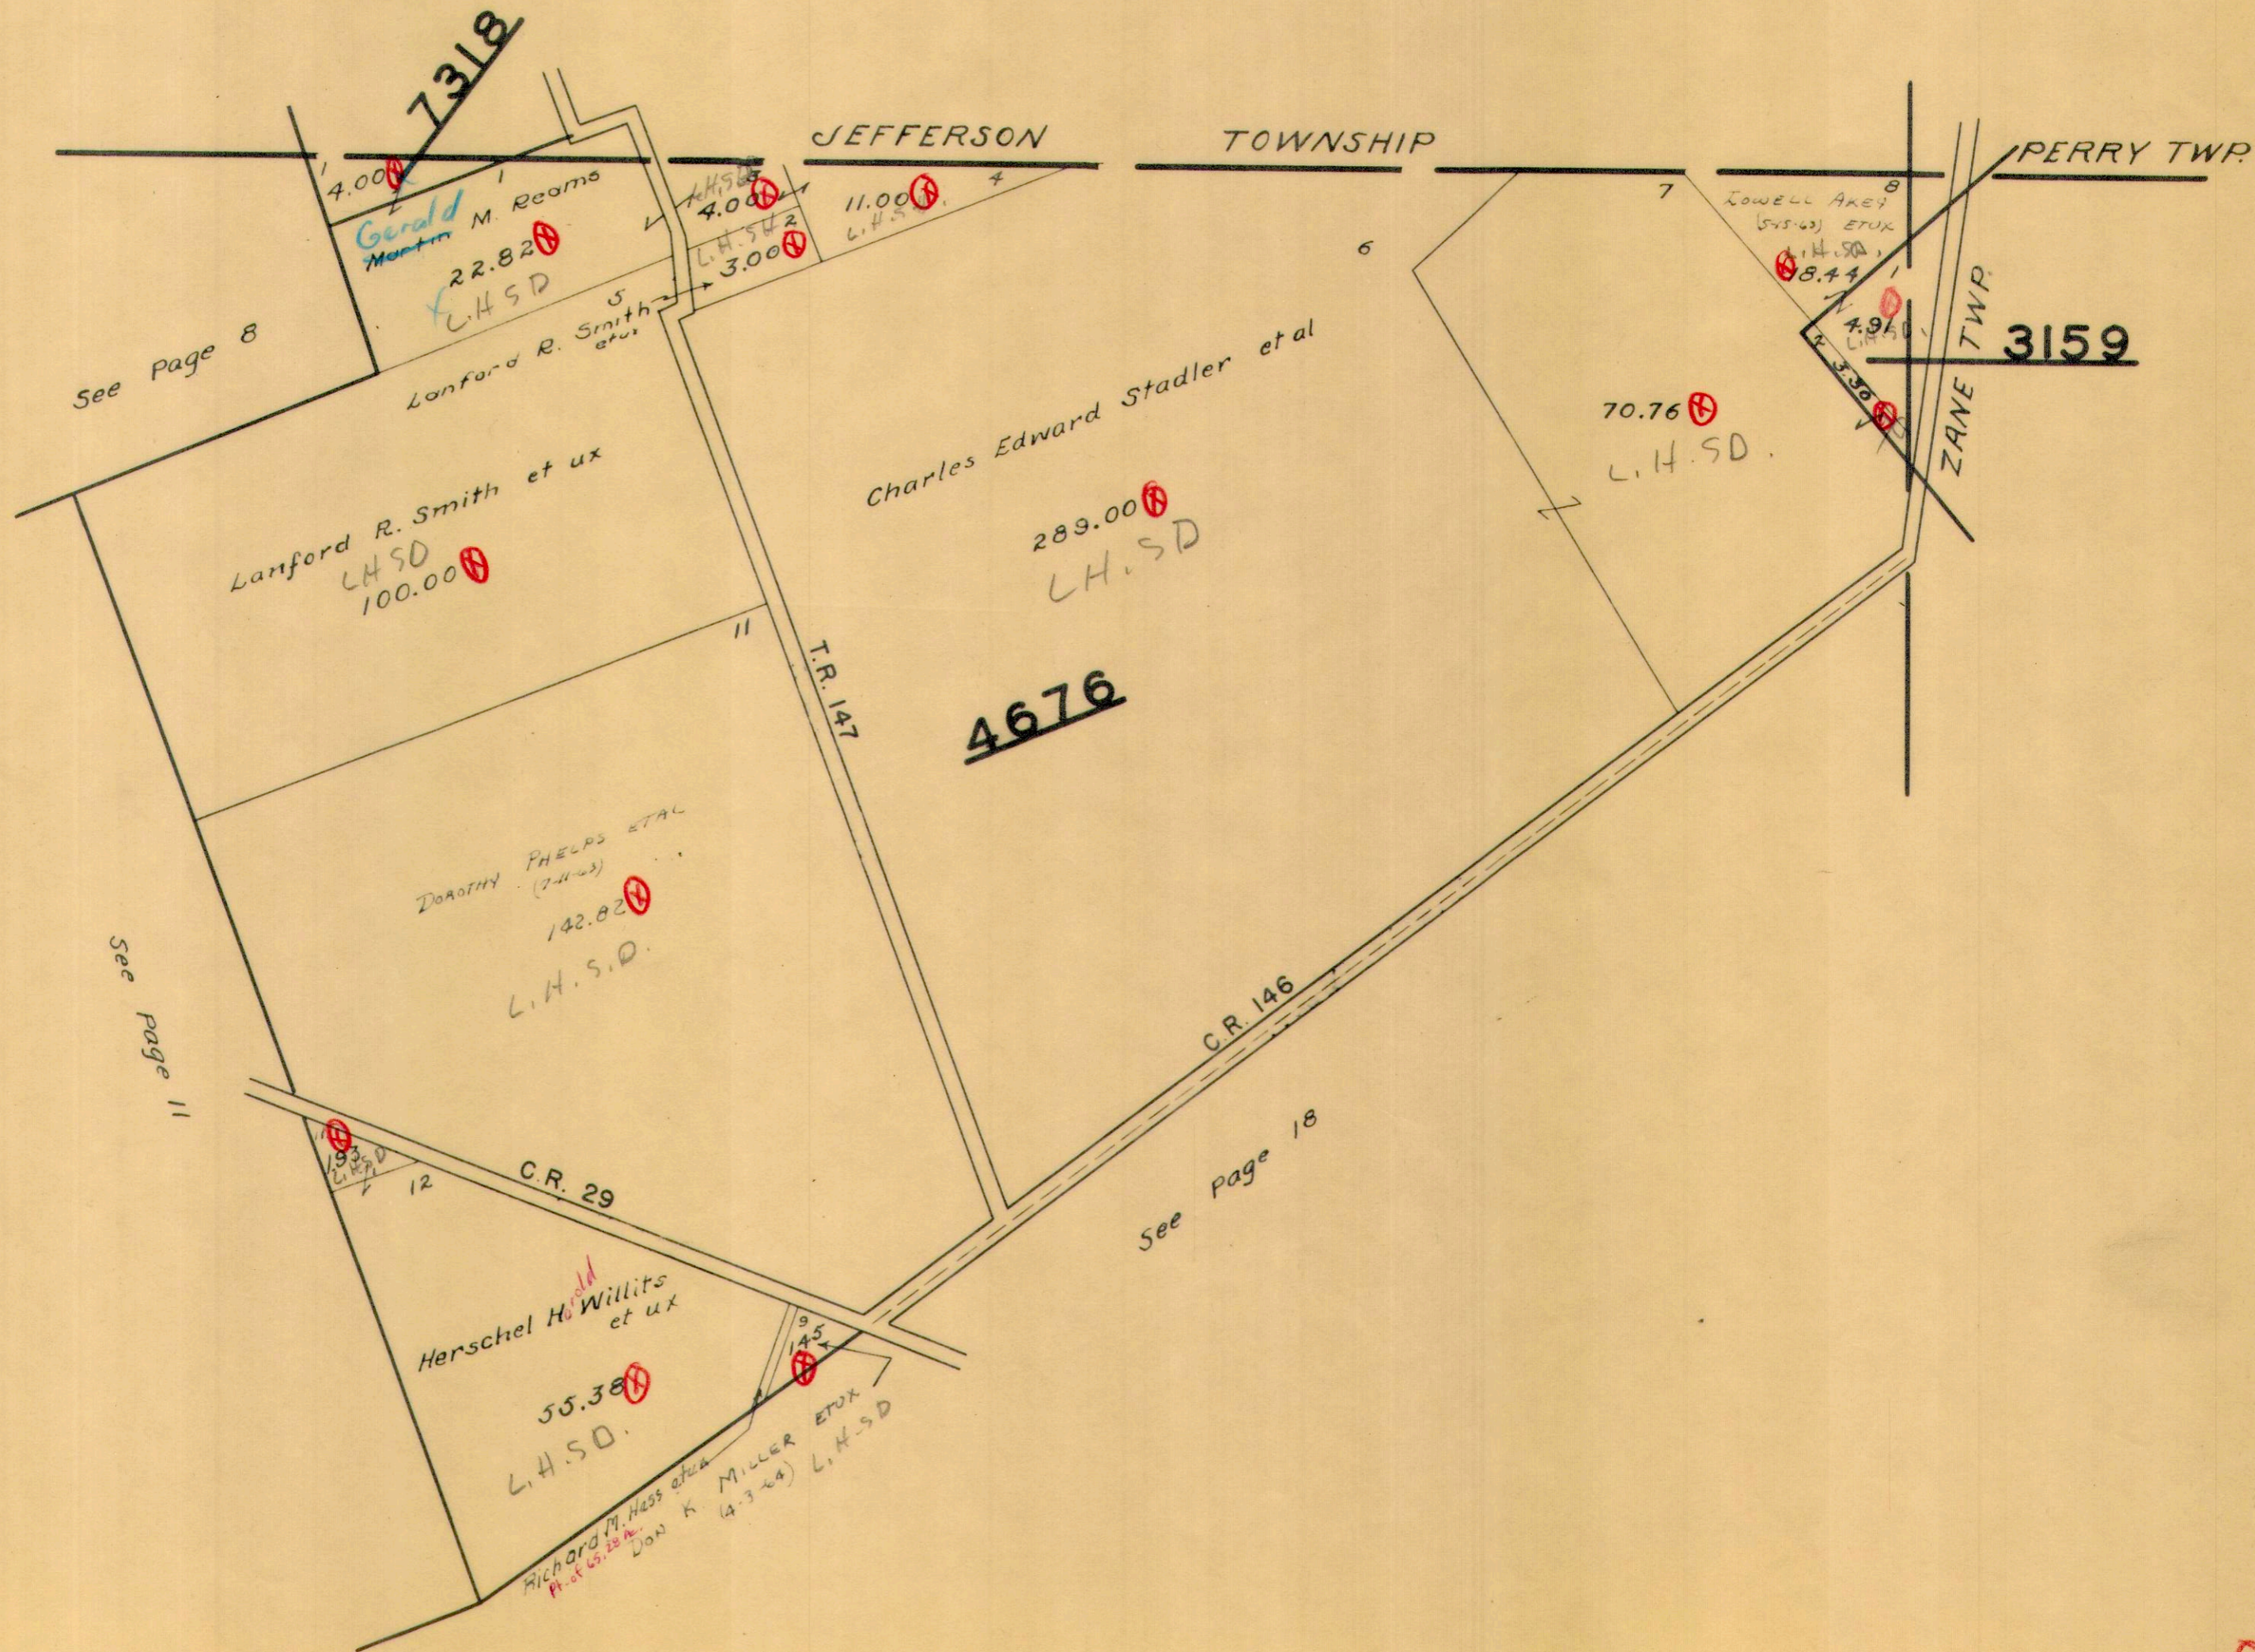

See Page 8


See Page 11

See Page 18




MONROE TOWNSHIP
VIRGINIA MILITARY SURVEY 6516

SCALE 10 CHAINS TO THE INCH

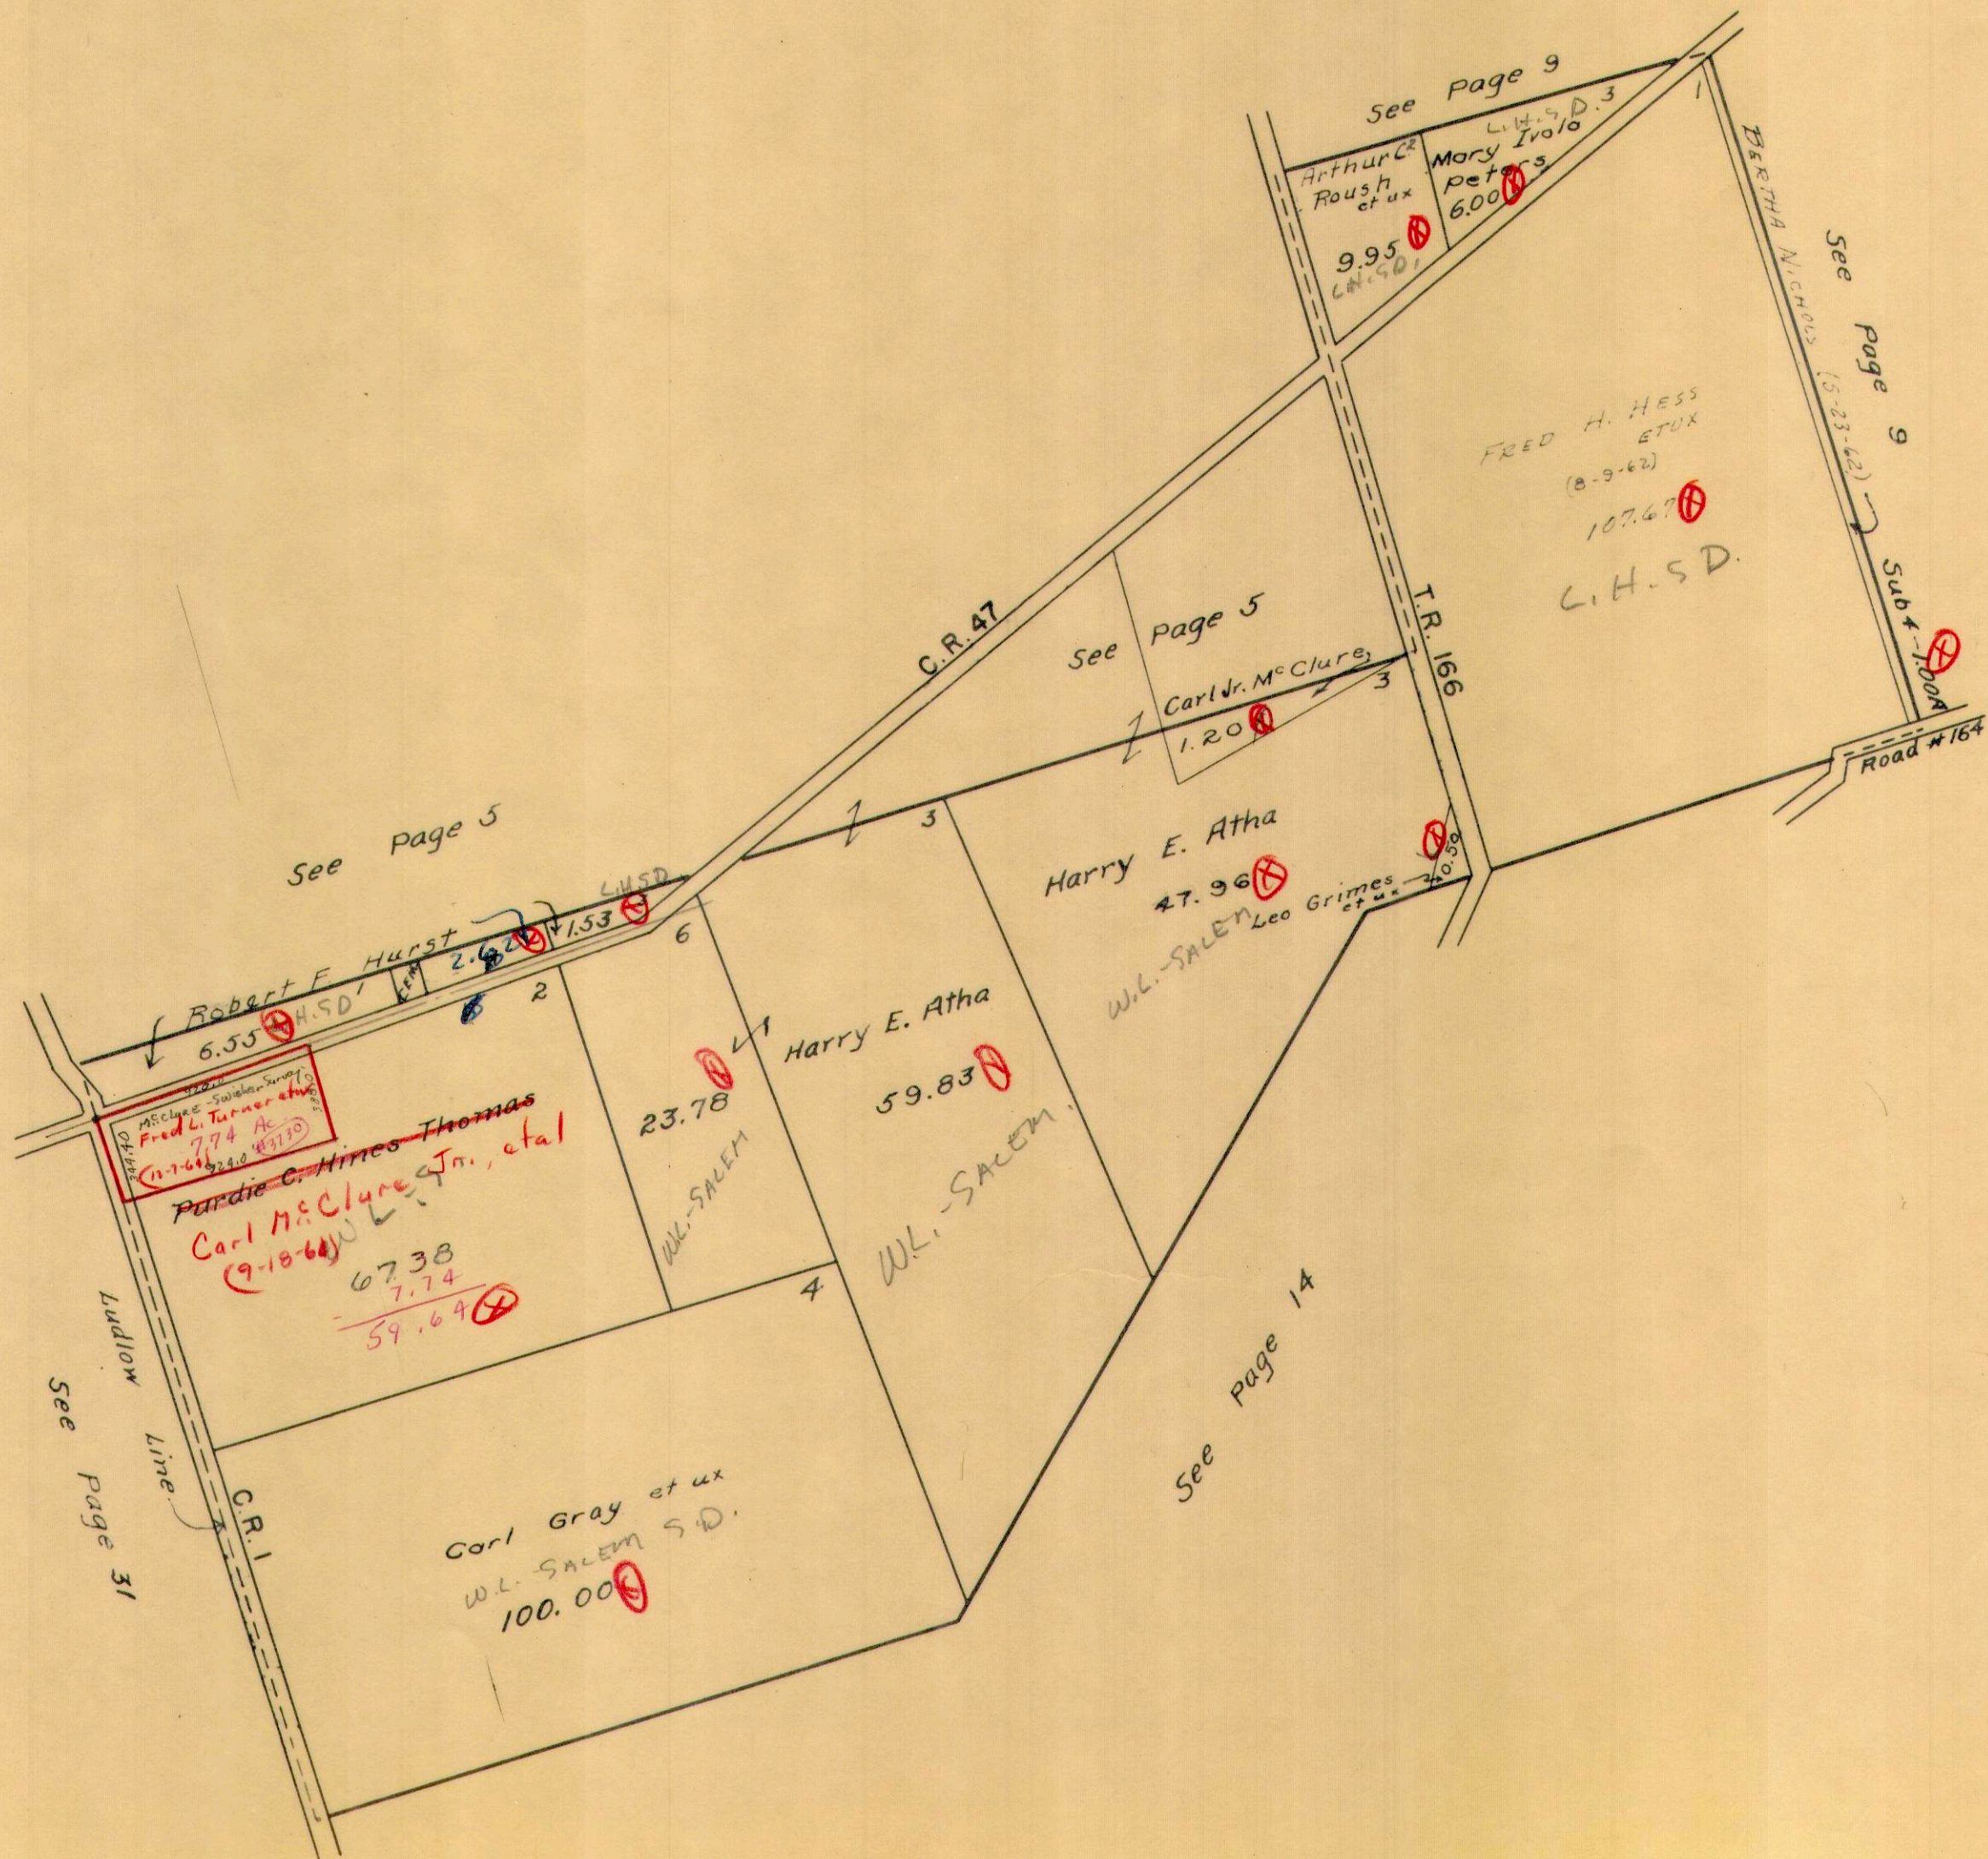

VIRGINIA MILITARY SURVEY 4479


SCALE 10 CHAINS TO THE INCH

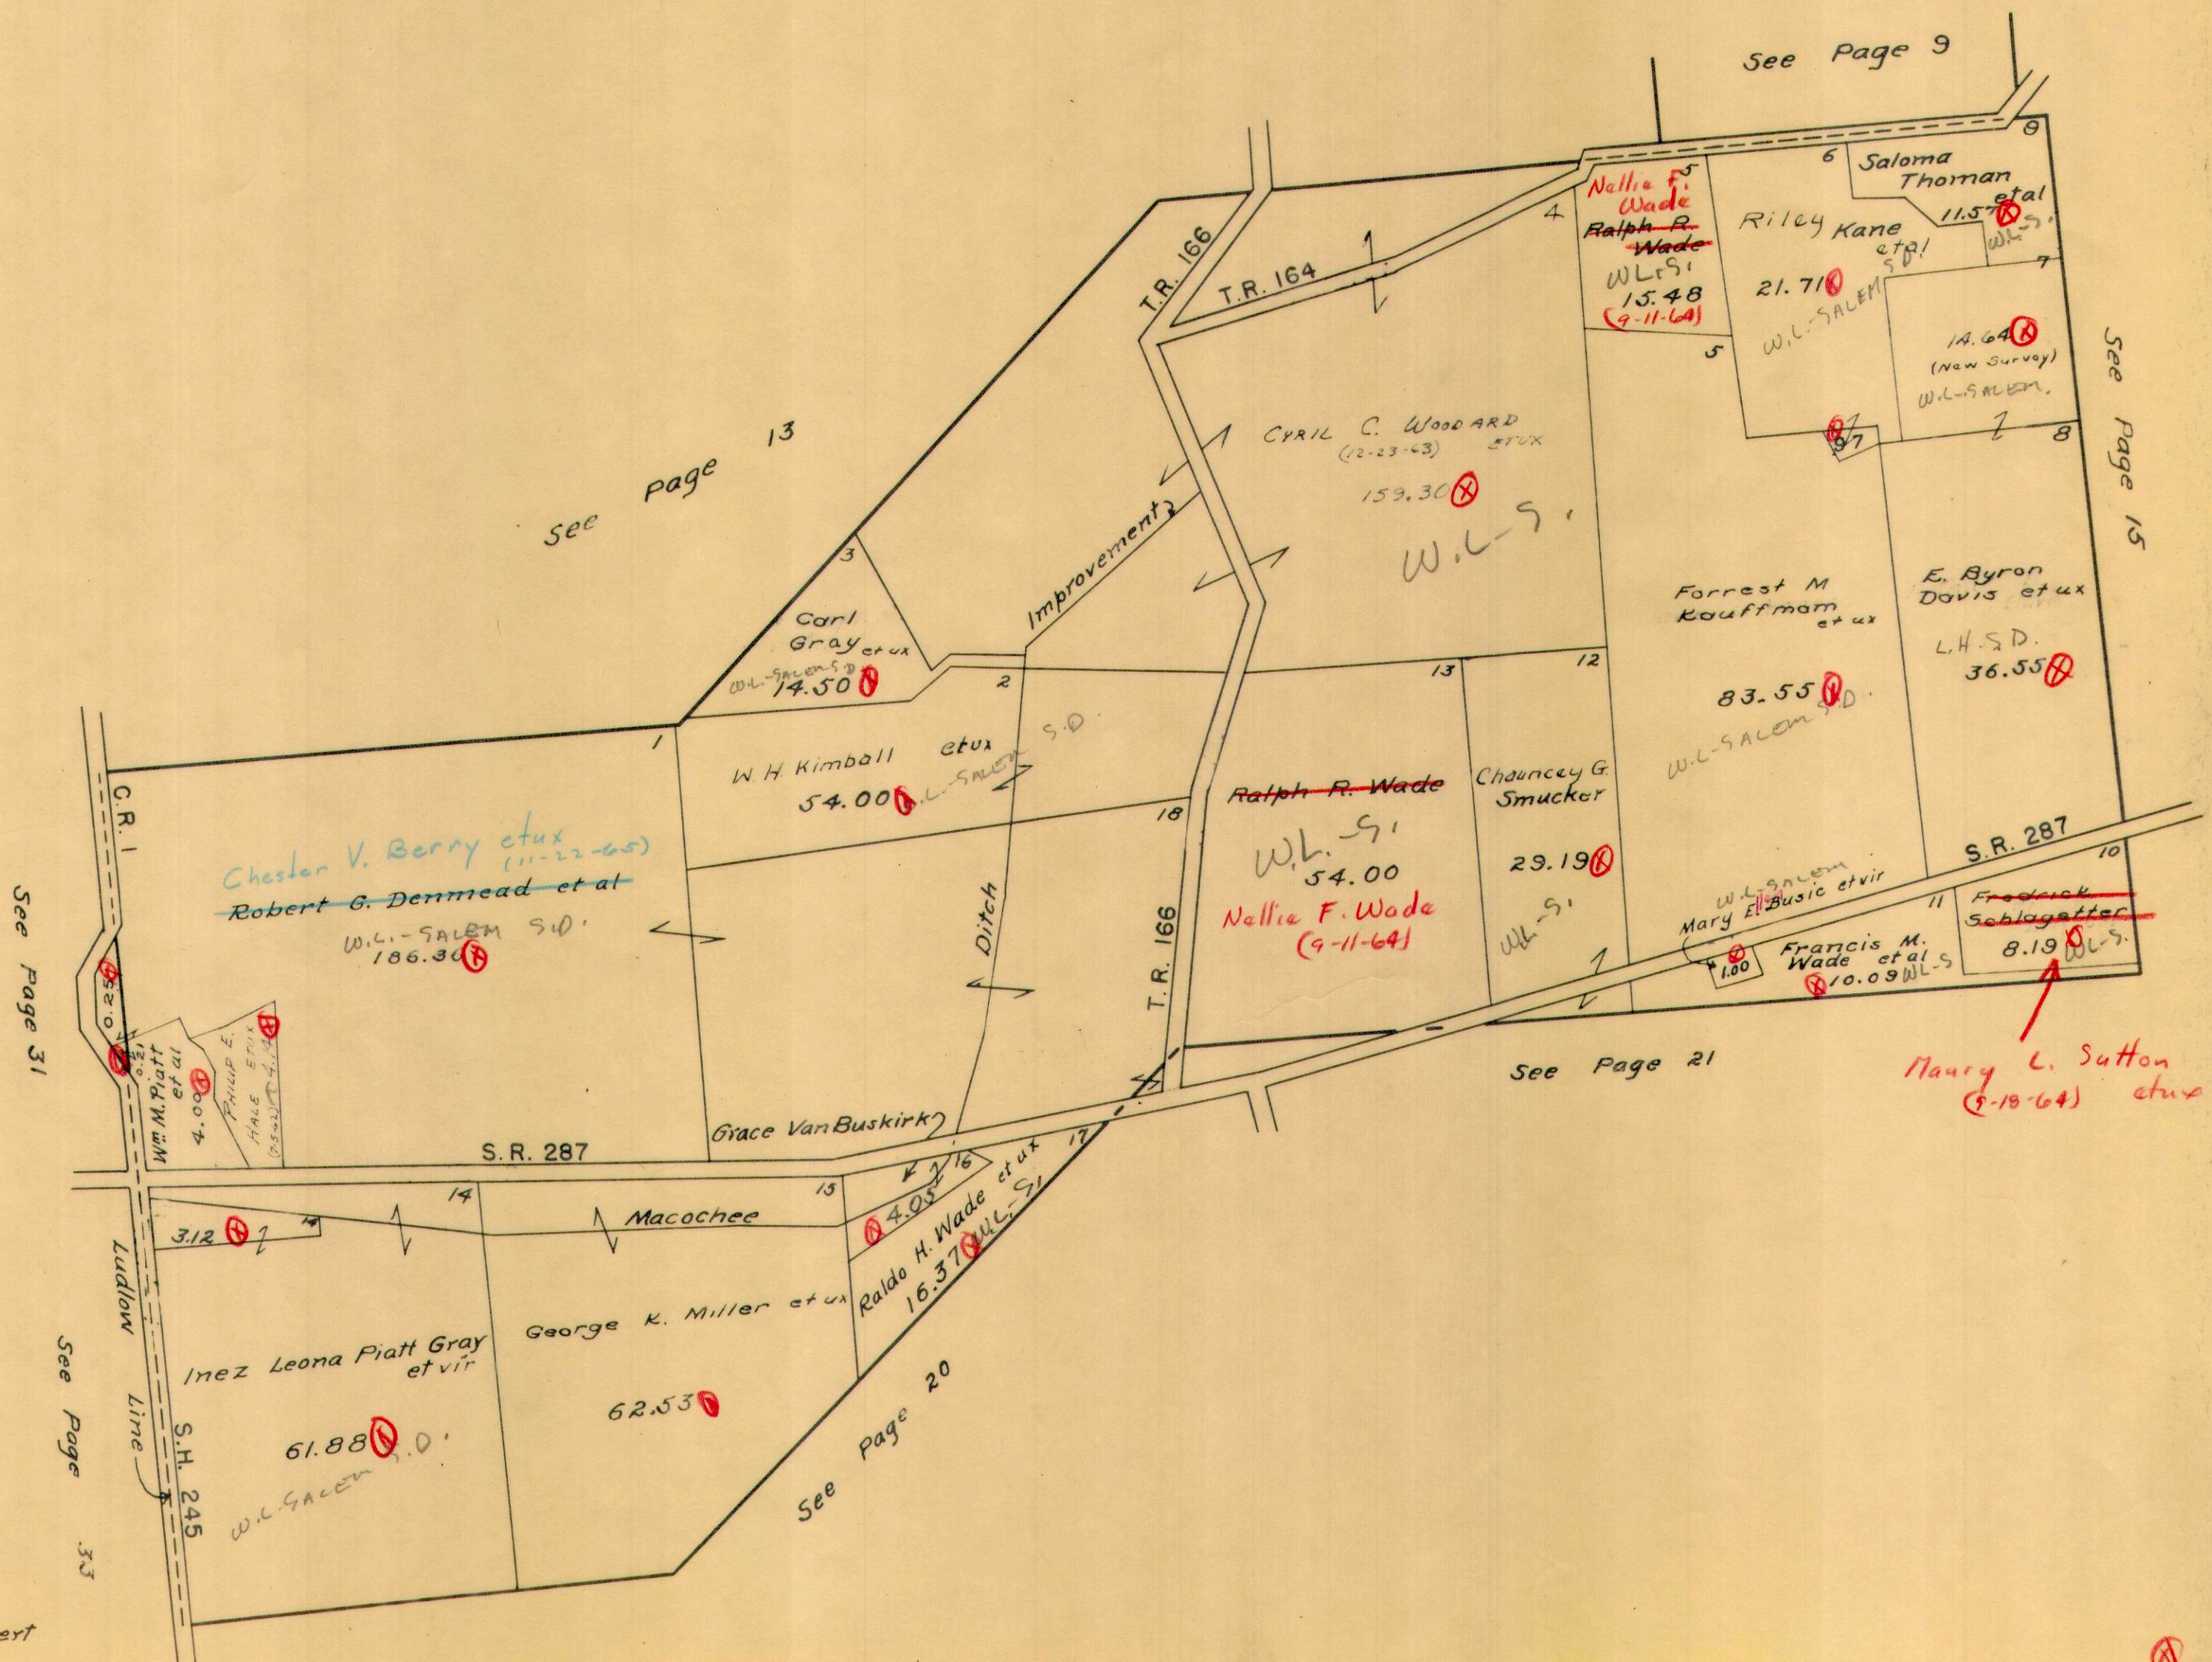


MONROE TOWNSHIP
VIRGINIA MILITARY SURVEYS

10091
6487
2220

SCALE 10 CHAINS TO THE INCH

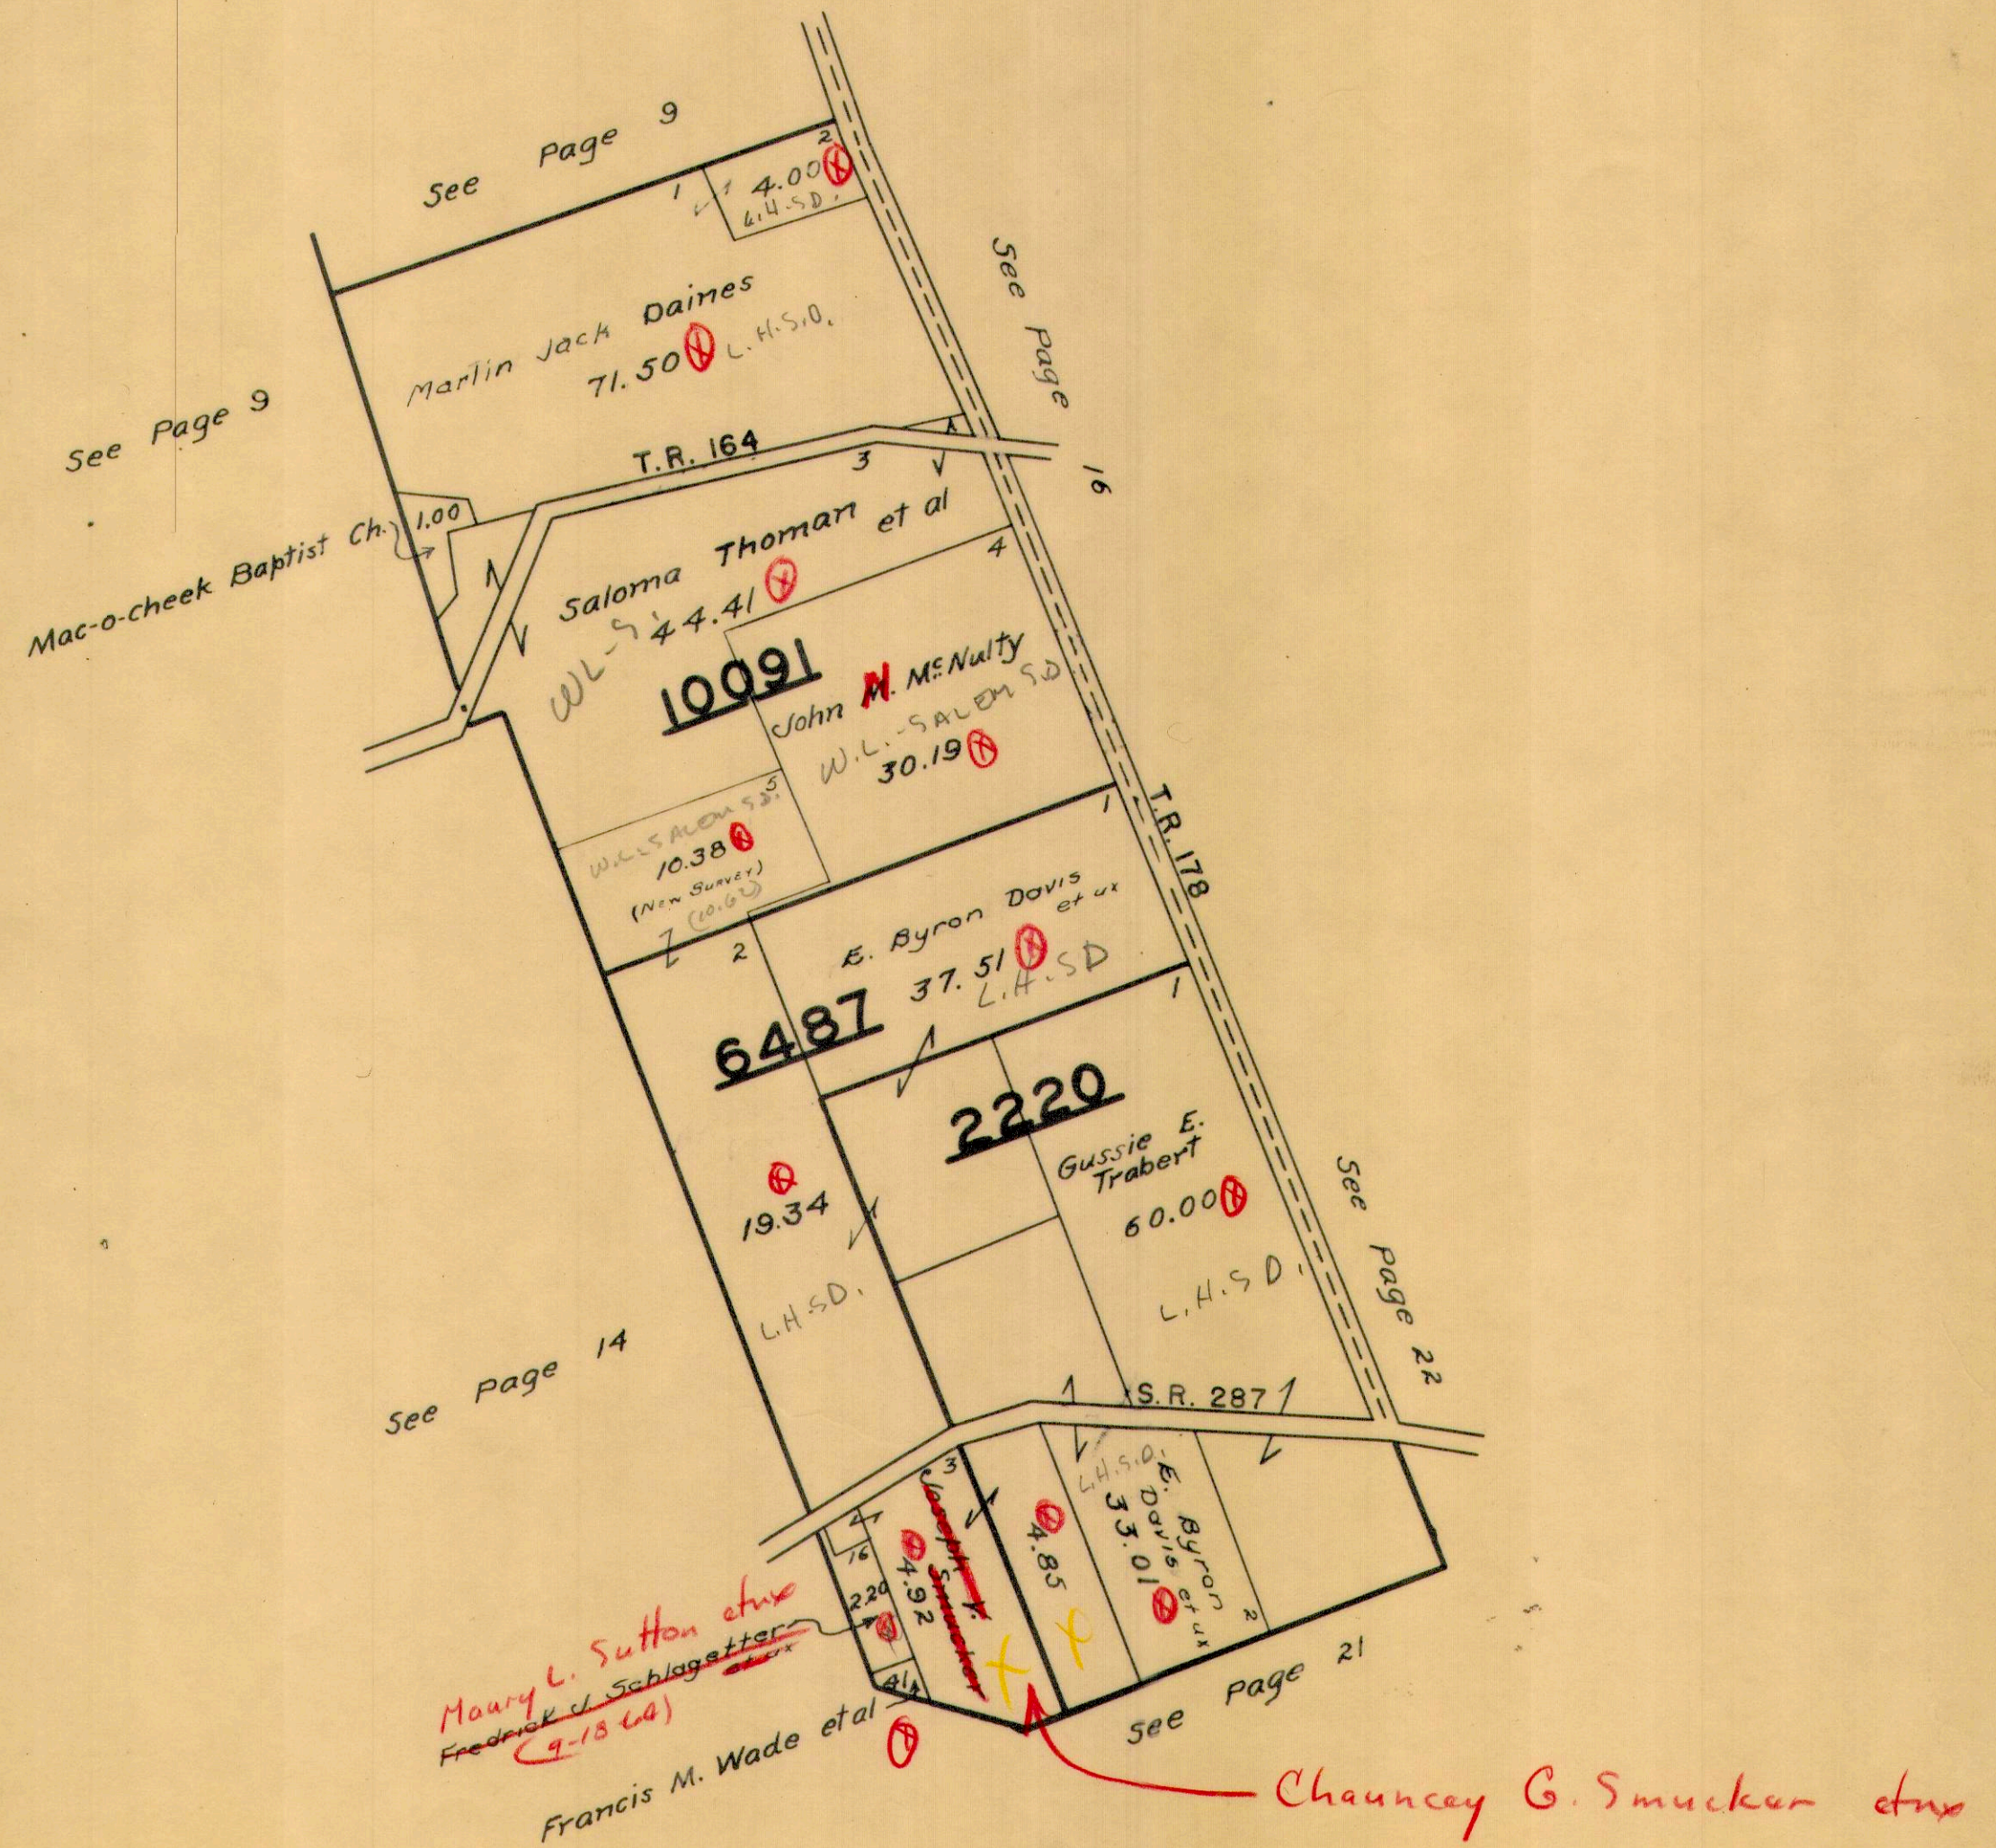


MONROE TOWNSHIP
VIRGINIA MILITARY SURVEY 3224
SCALE 10 CHAINS TO THE INCH

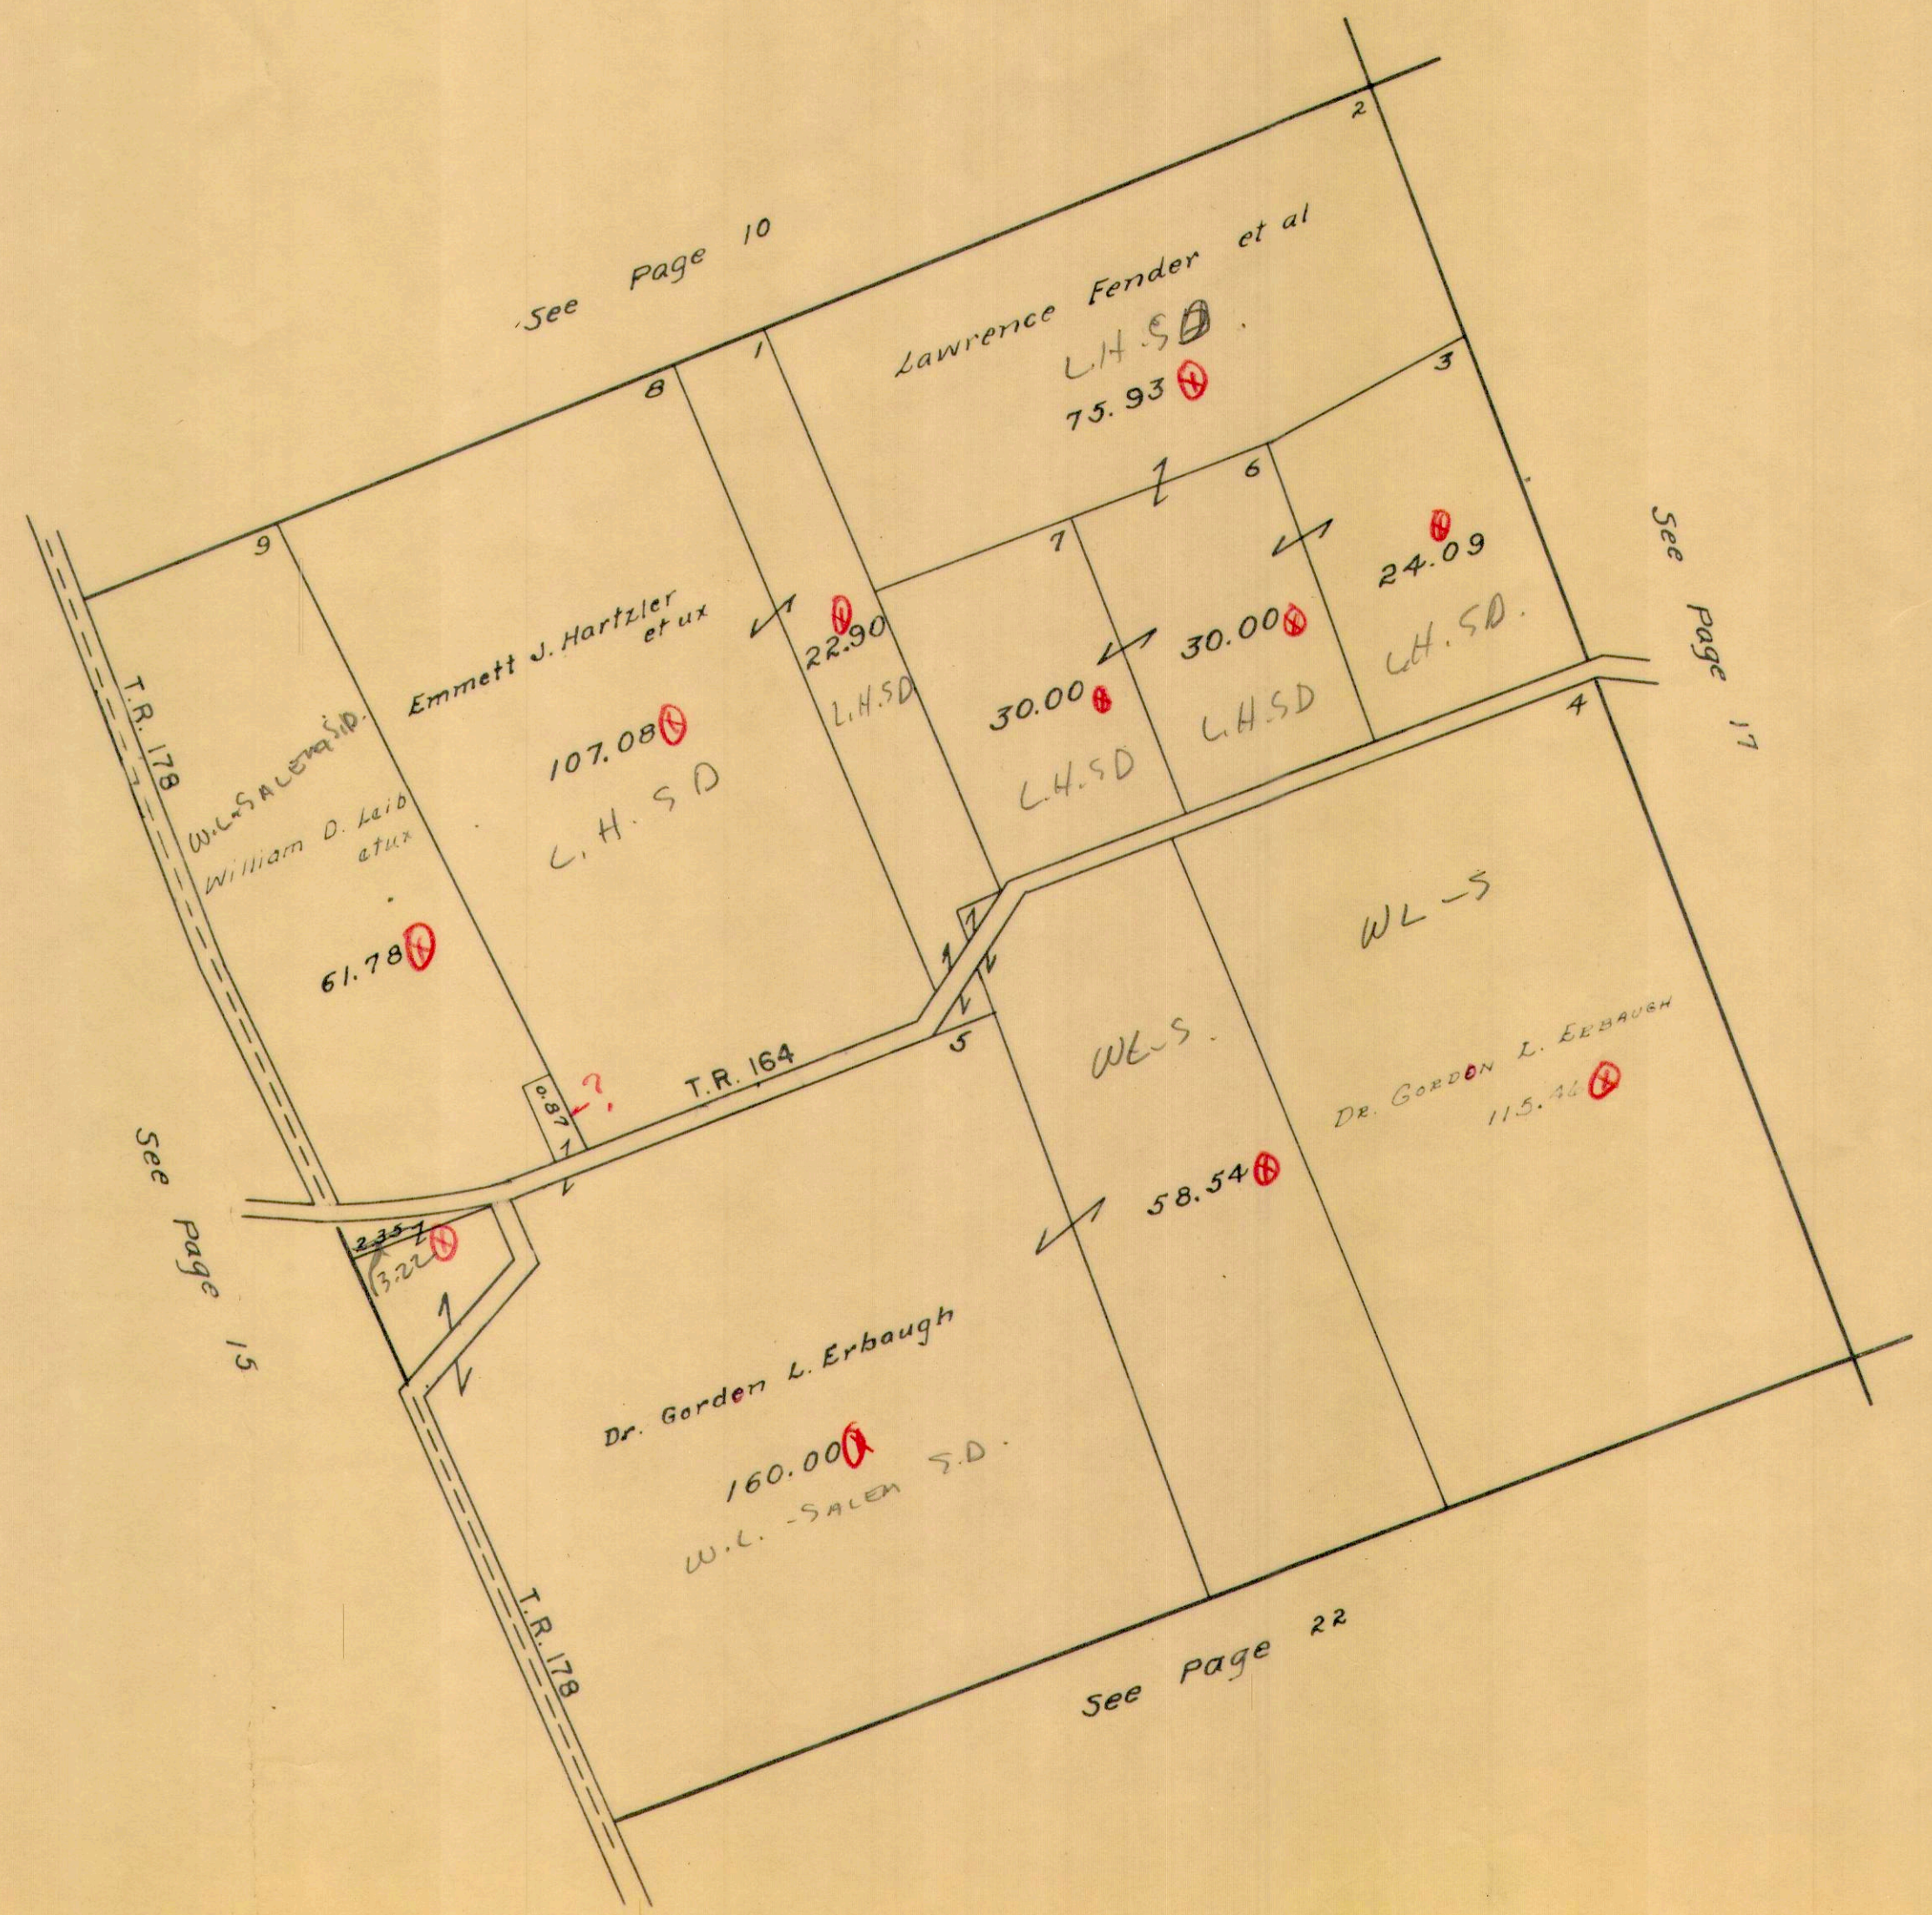


VIRGINIA MILITARY SURVEY 3223

SCALE 10 CHAINS TO THE INCH

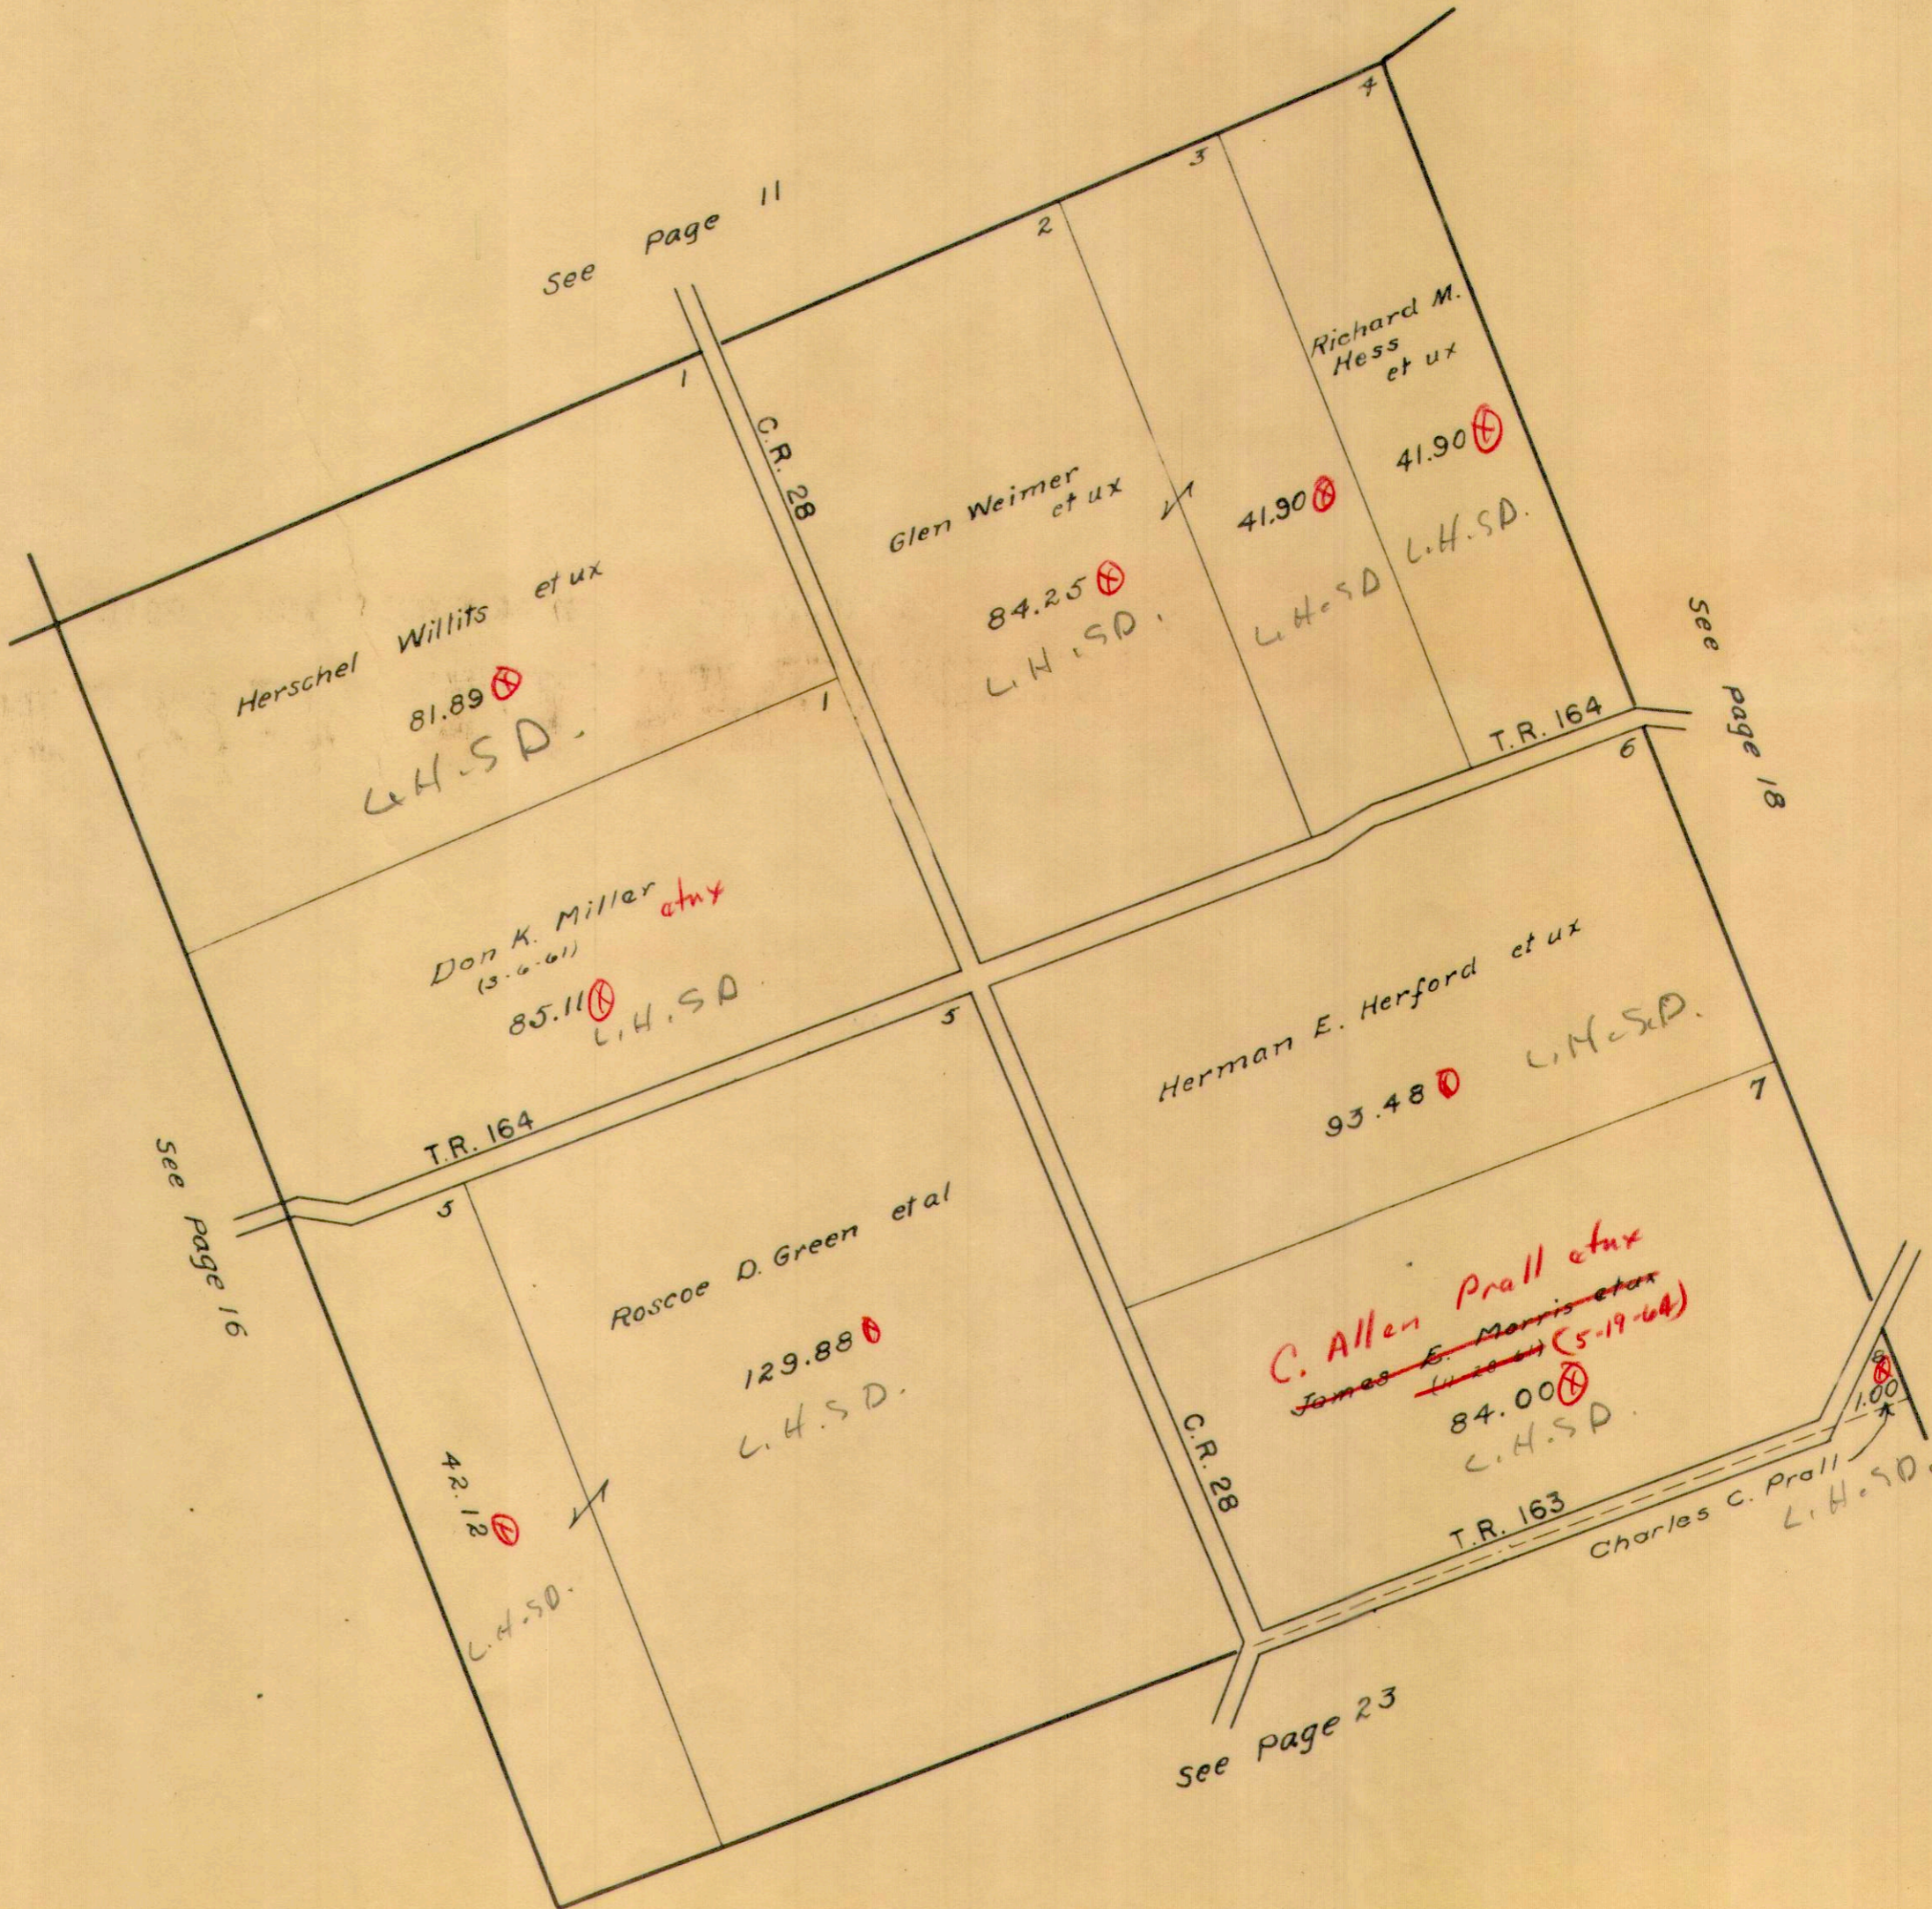

VIRGINIA MILITARY SURVEY N. PART 4570

SCALE 10 CHAINS TO THE INCH

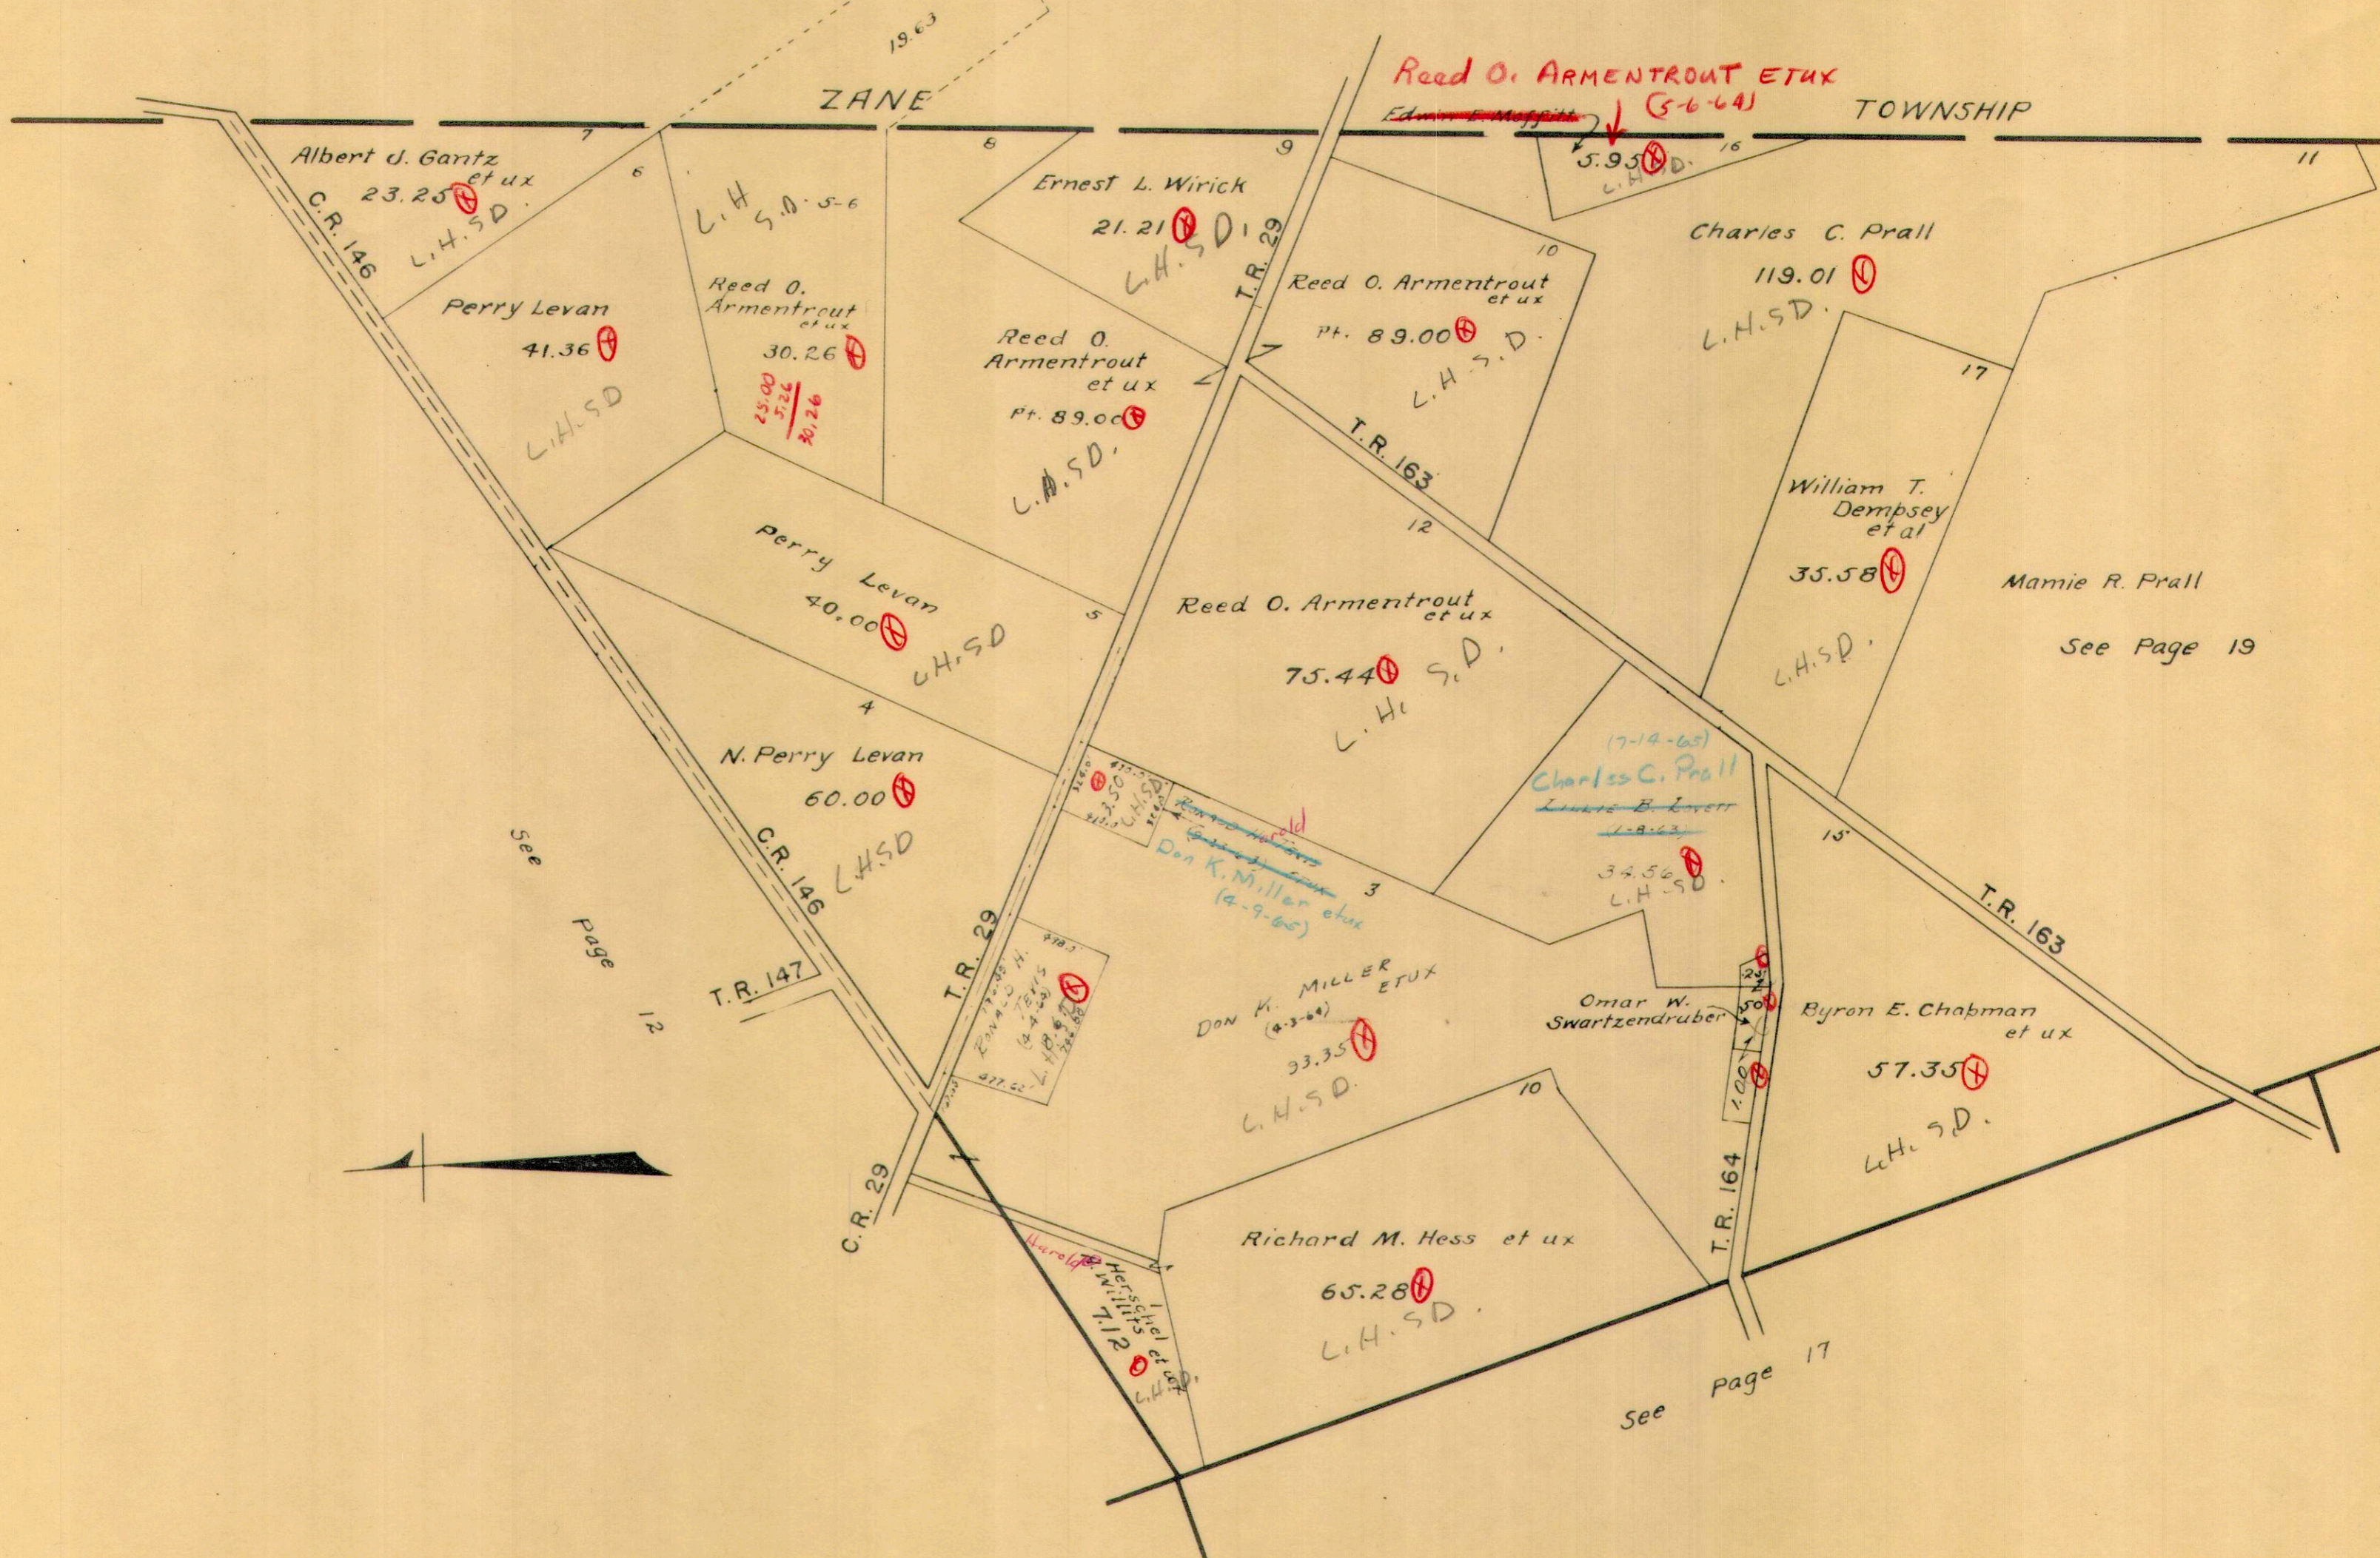


See Page 12

See Page 17




MONROE TOWNSHIP
VIRGINIA MILITARY SURVEY S. PART 4570

SCALE 10 CHAINS TO THE INCH

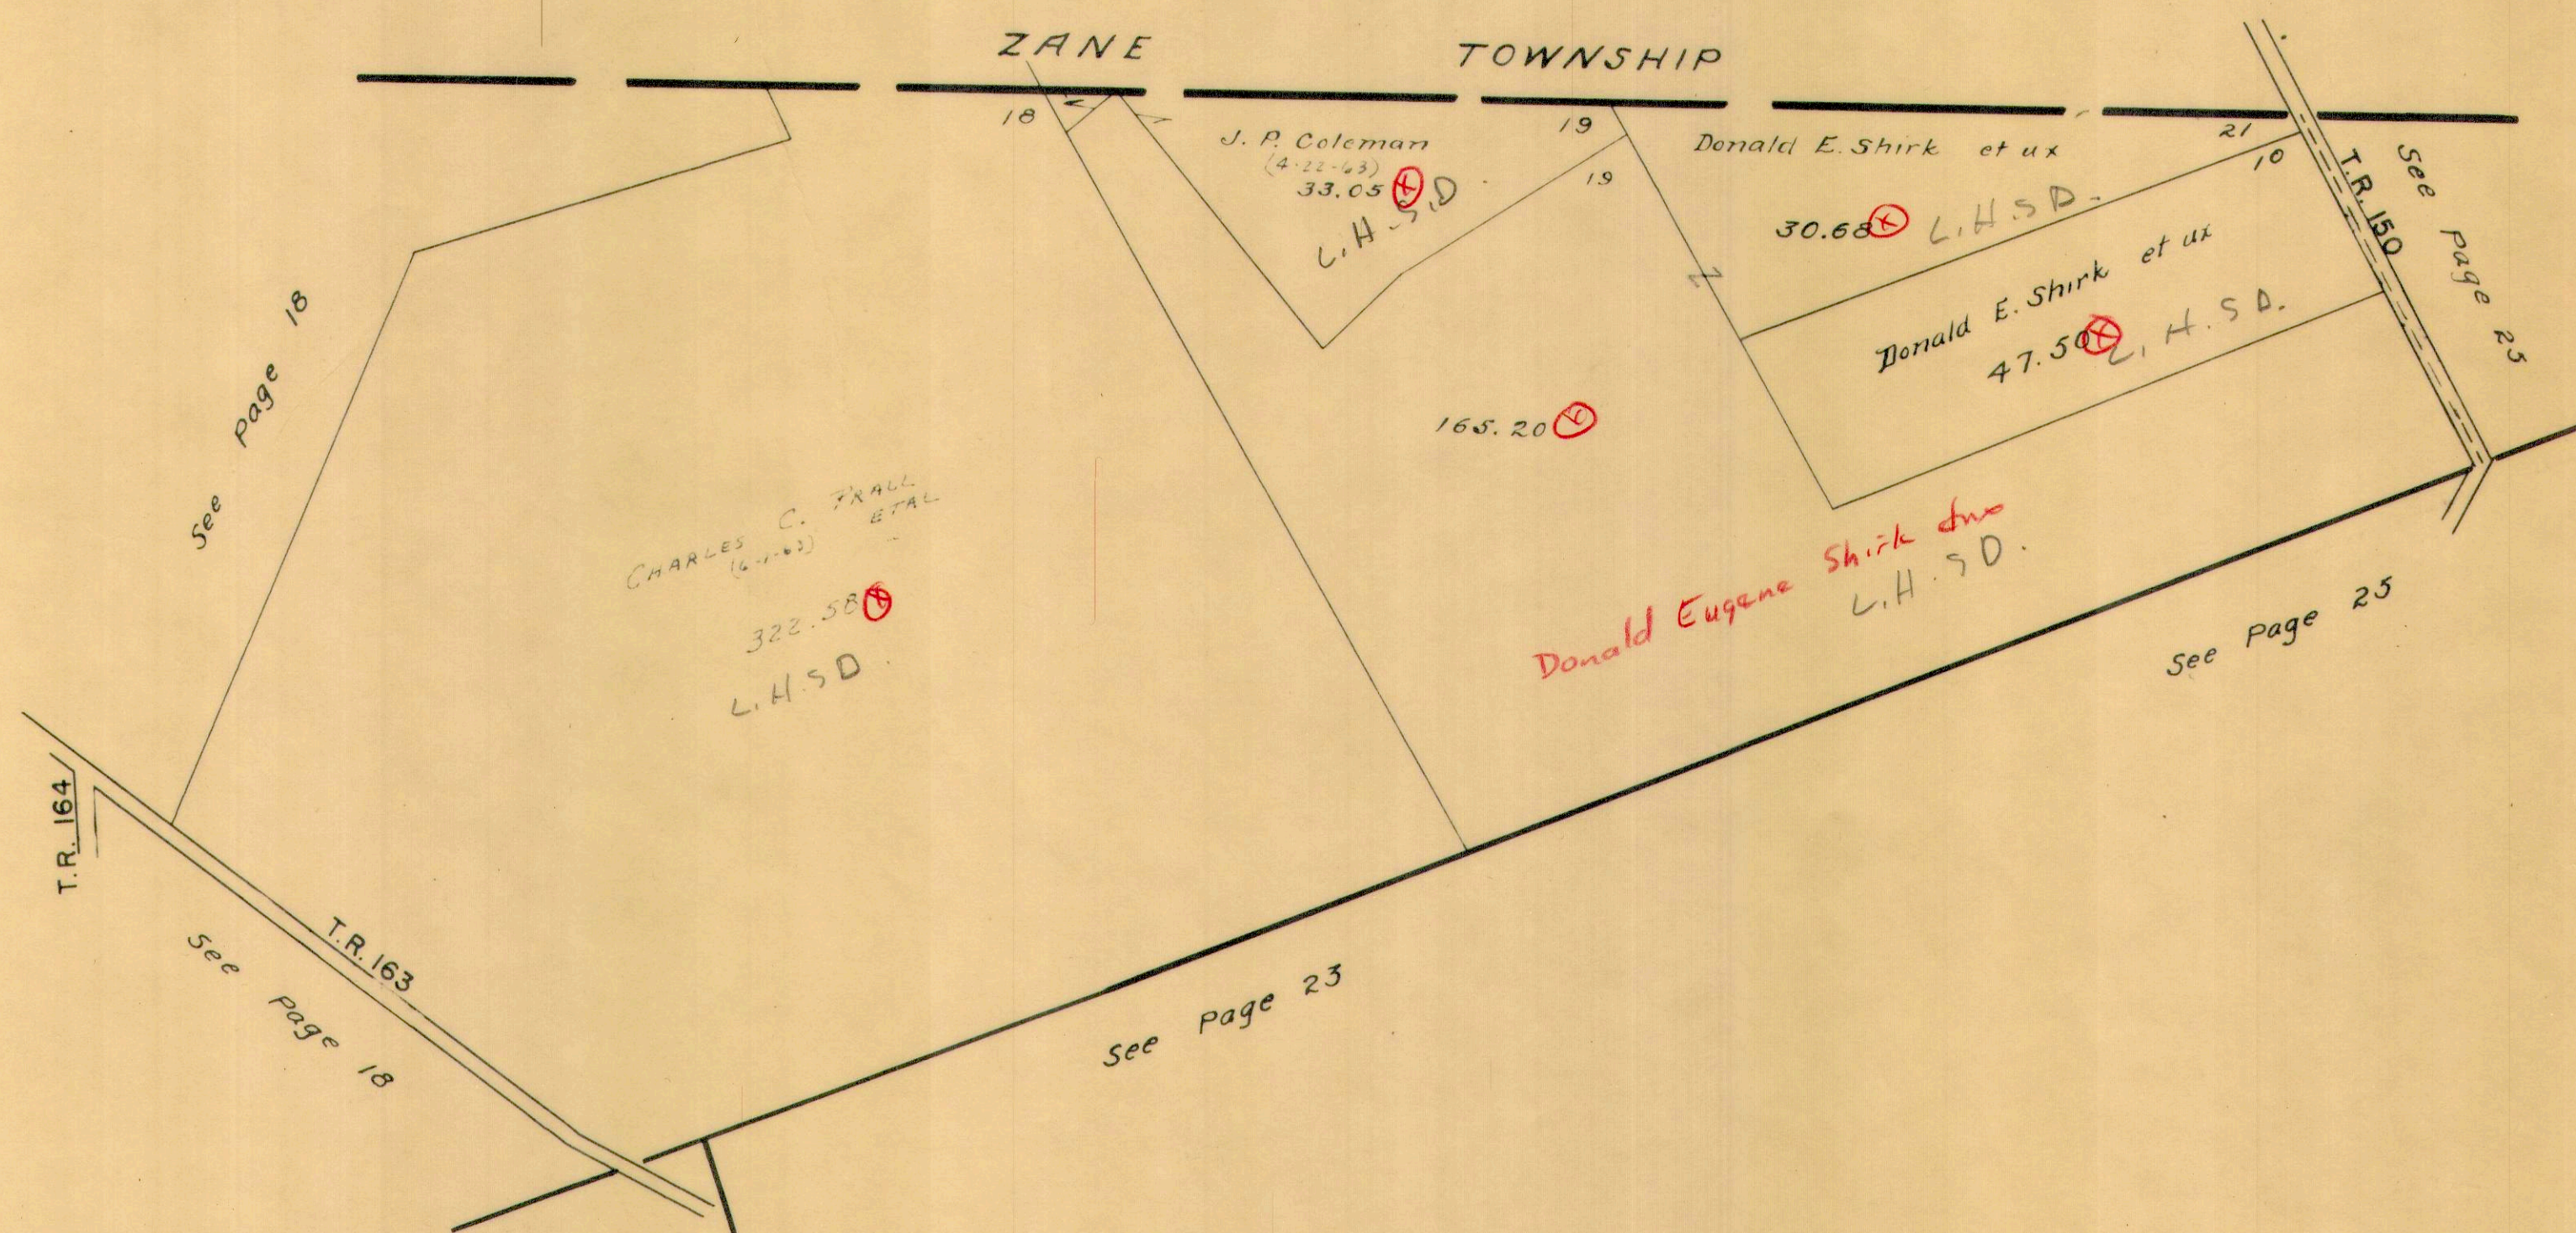

VIRGINIA MILITARY SURVEY W. PART 4492

SCALE 10 CHAINS TO THE INCH

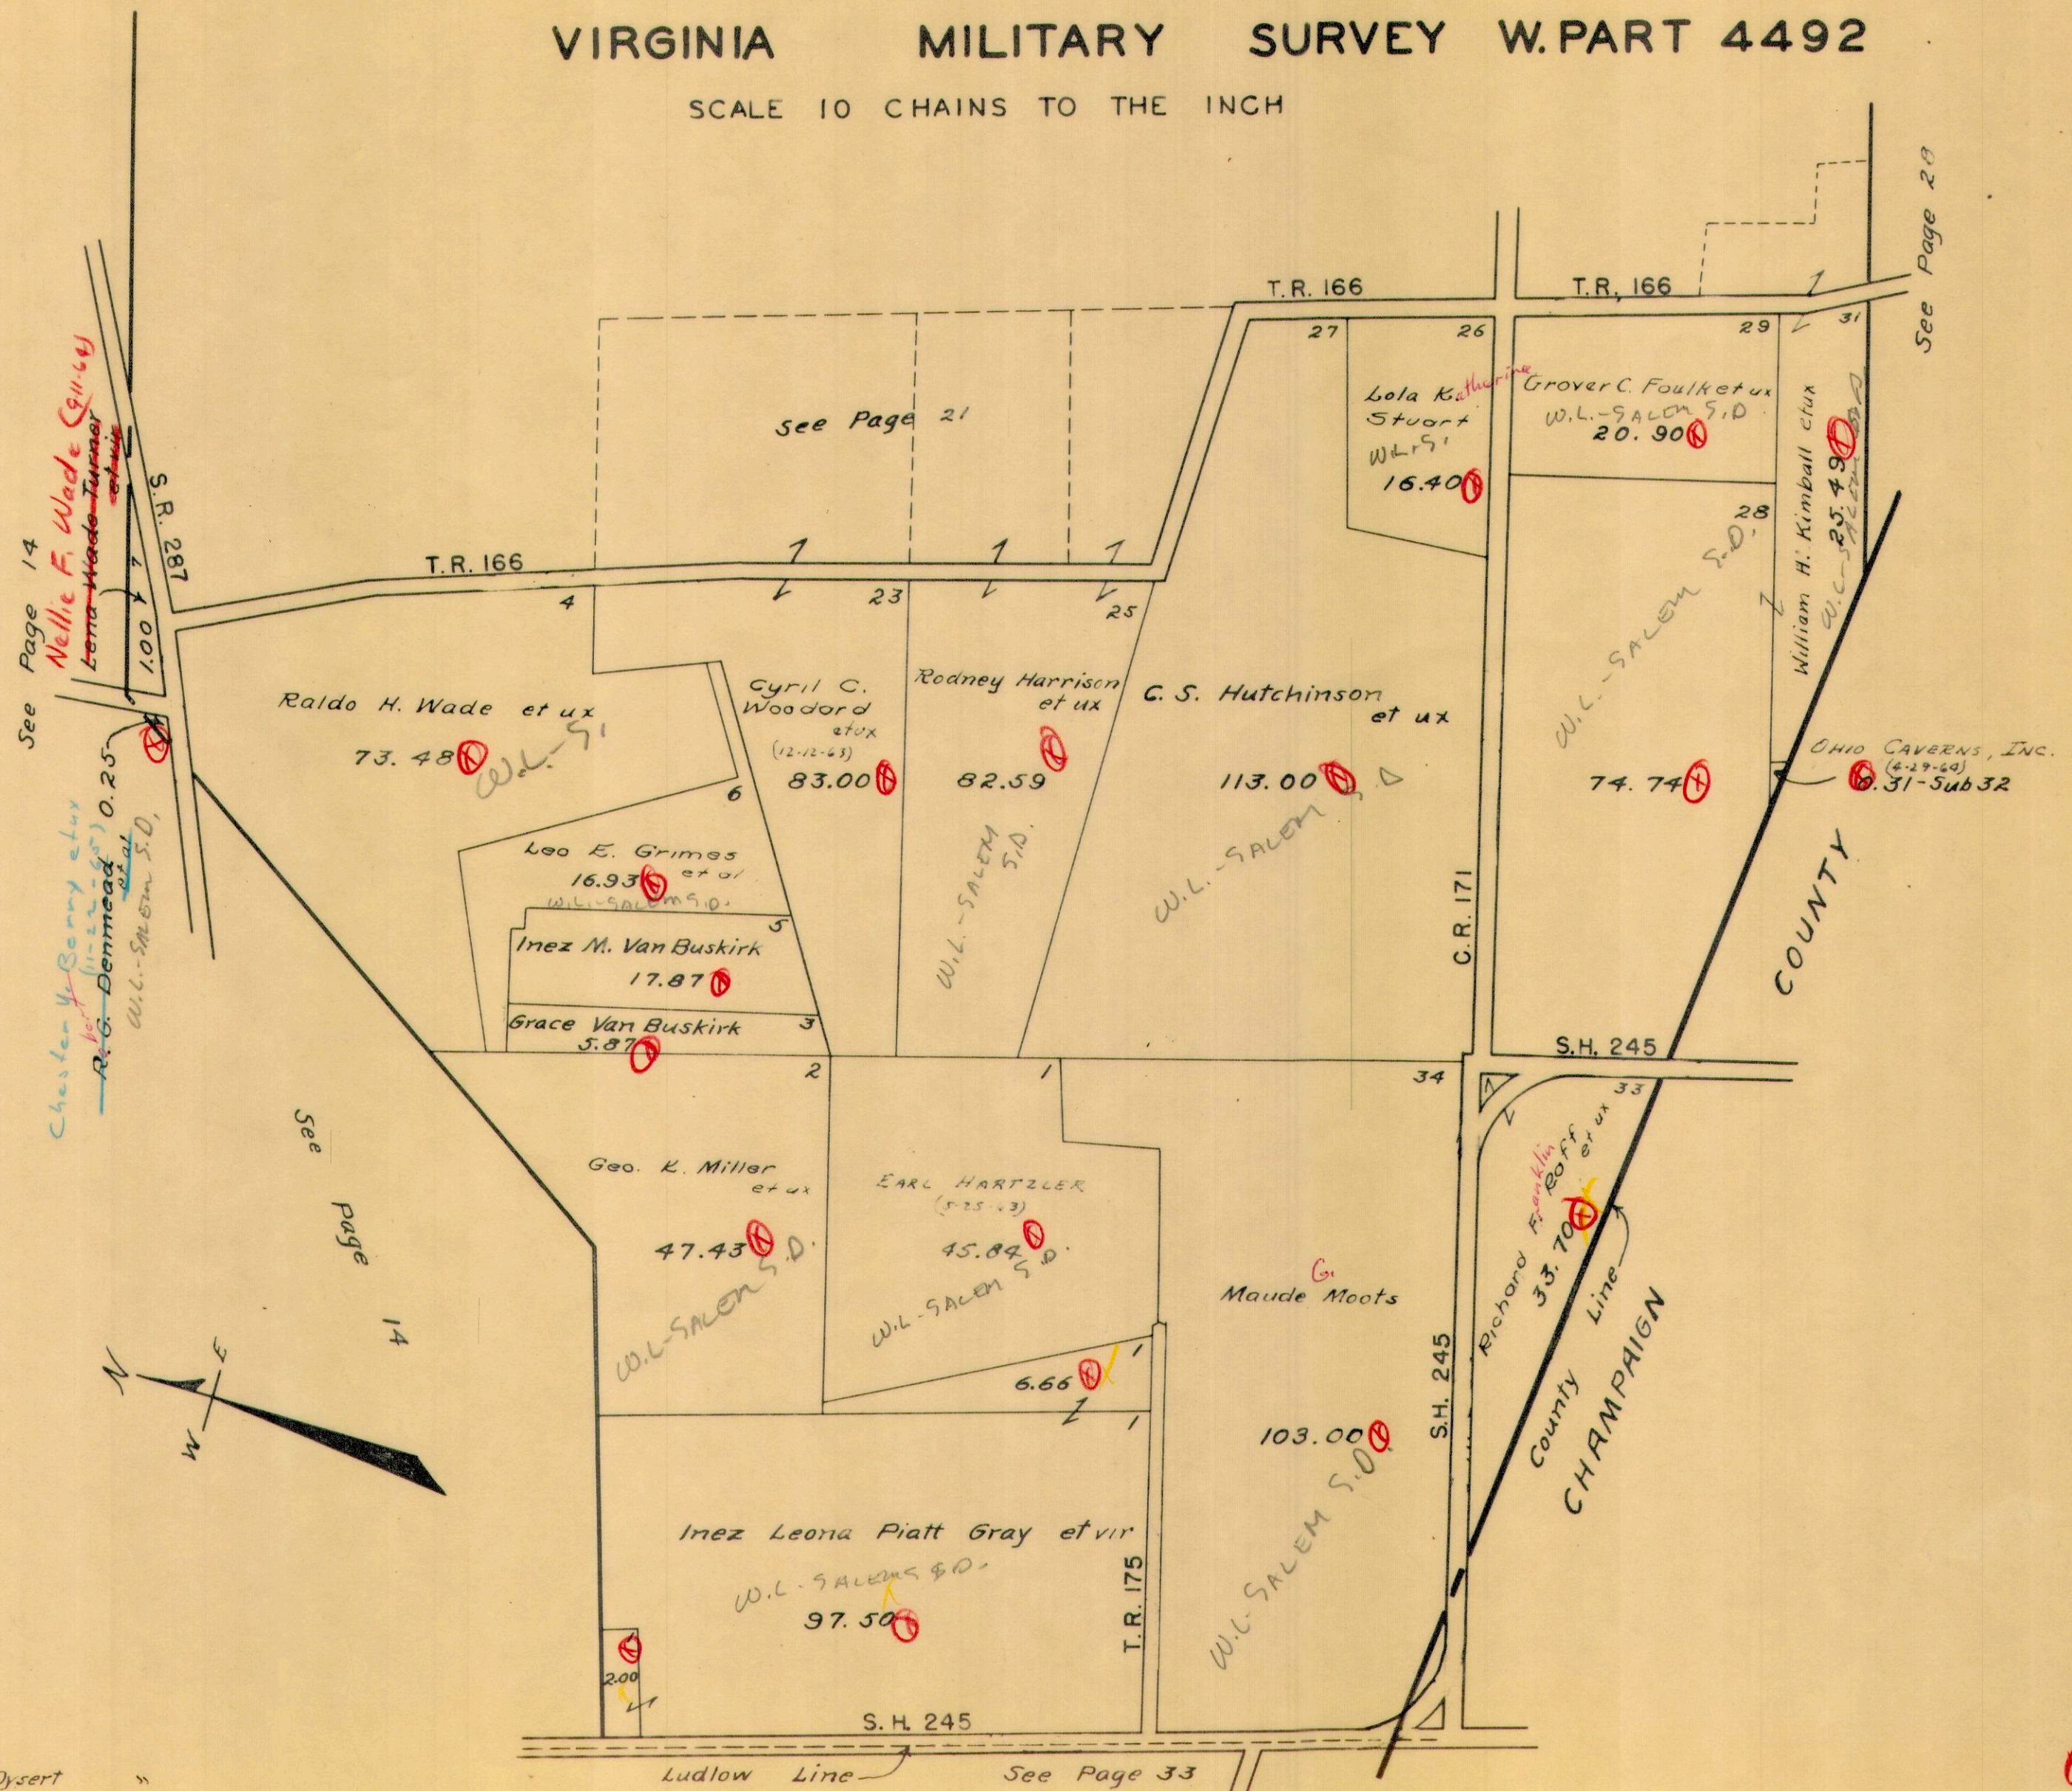

See Page 20



See Page 14

See Page 14

14

MONROE TOWNSHIP
VIRGINIA MILITARY SURVEY E. PART 4492

SCALE 10 CHAINS TO THE INCH

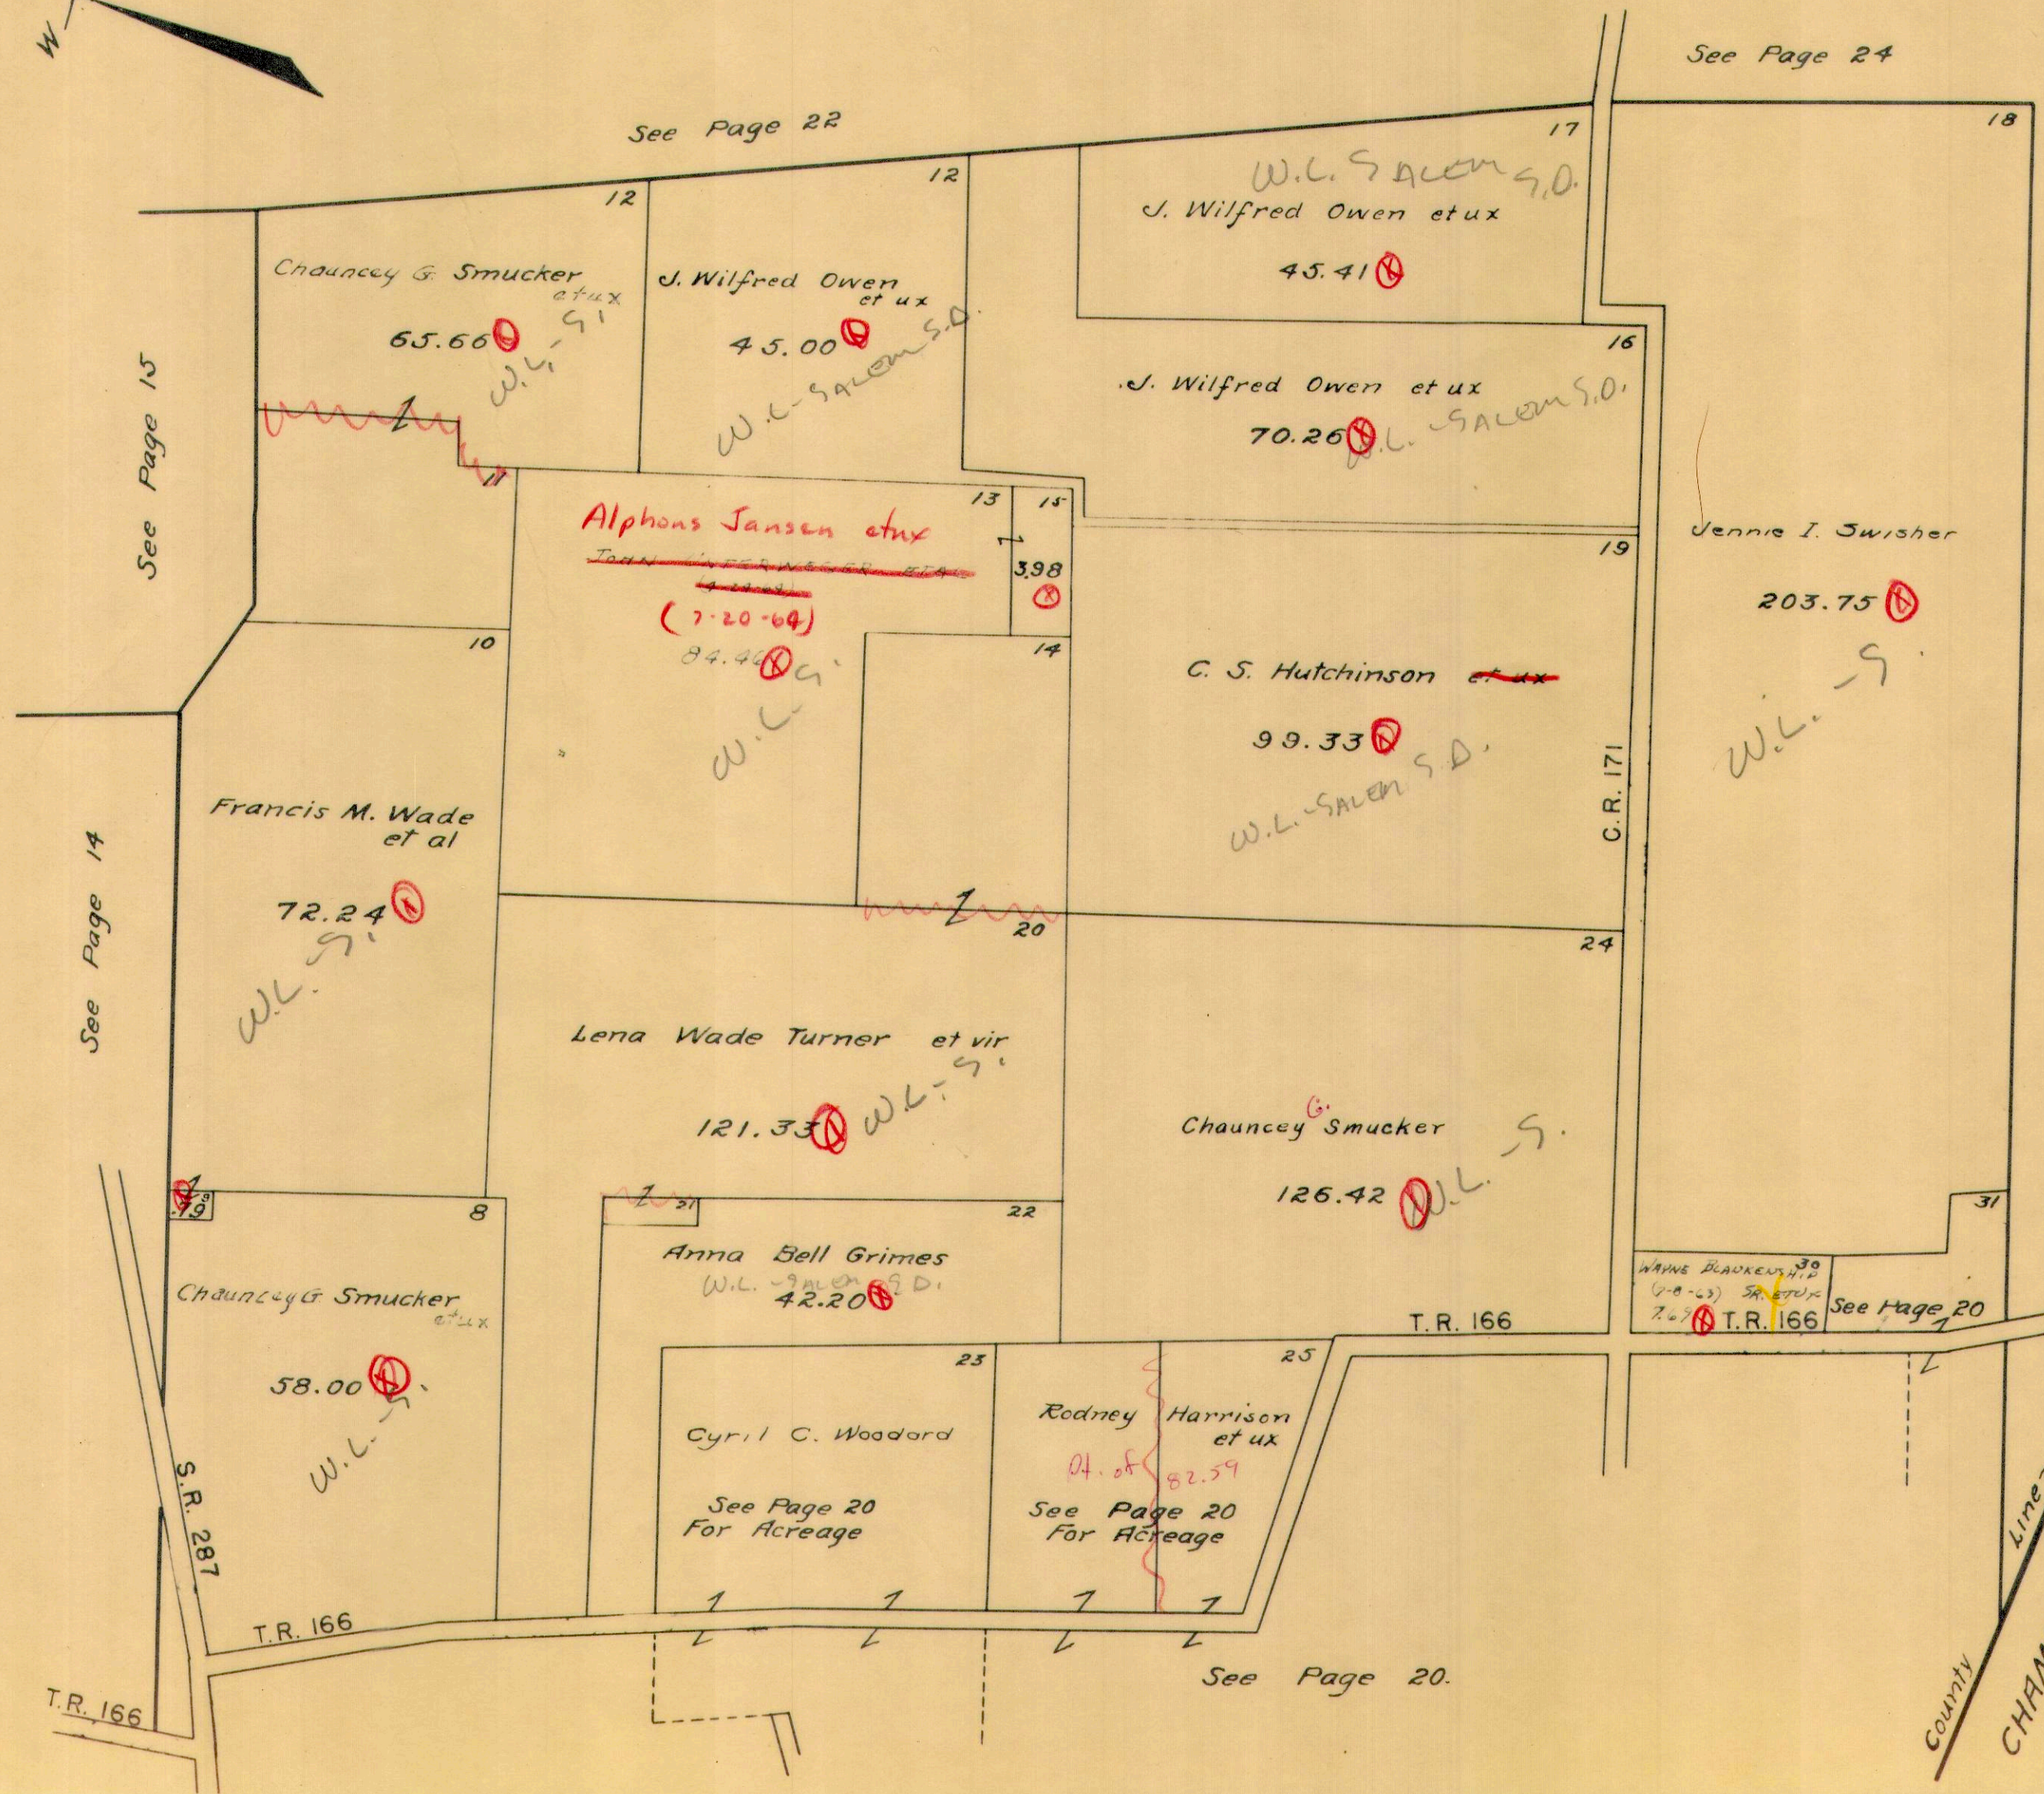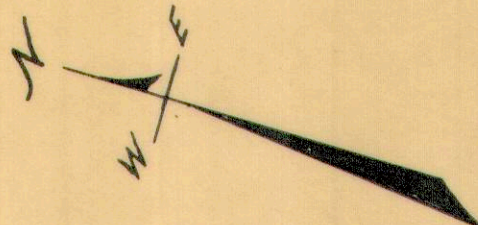

See Page 24

See Page 22

See Page 15

See Page 14

See Page 28


WAYNE BLACKEN³⁰
7-8-63 S.R. 287
7.69 T.R. 166 See Page 20

See Page 20.

County Line
CHAMPAIGN COUNTY

VIRGINIA MILITARY SURVEY 3225

SCALE 10 CHAINS TO THE INCH

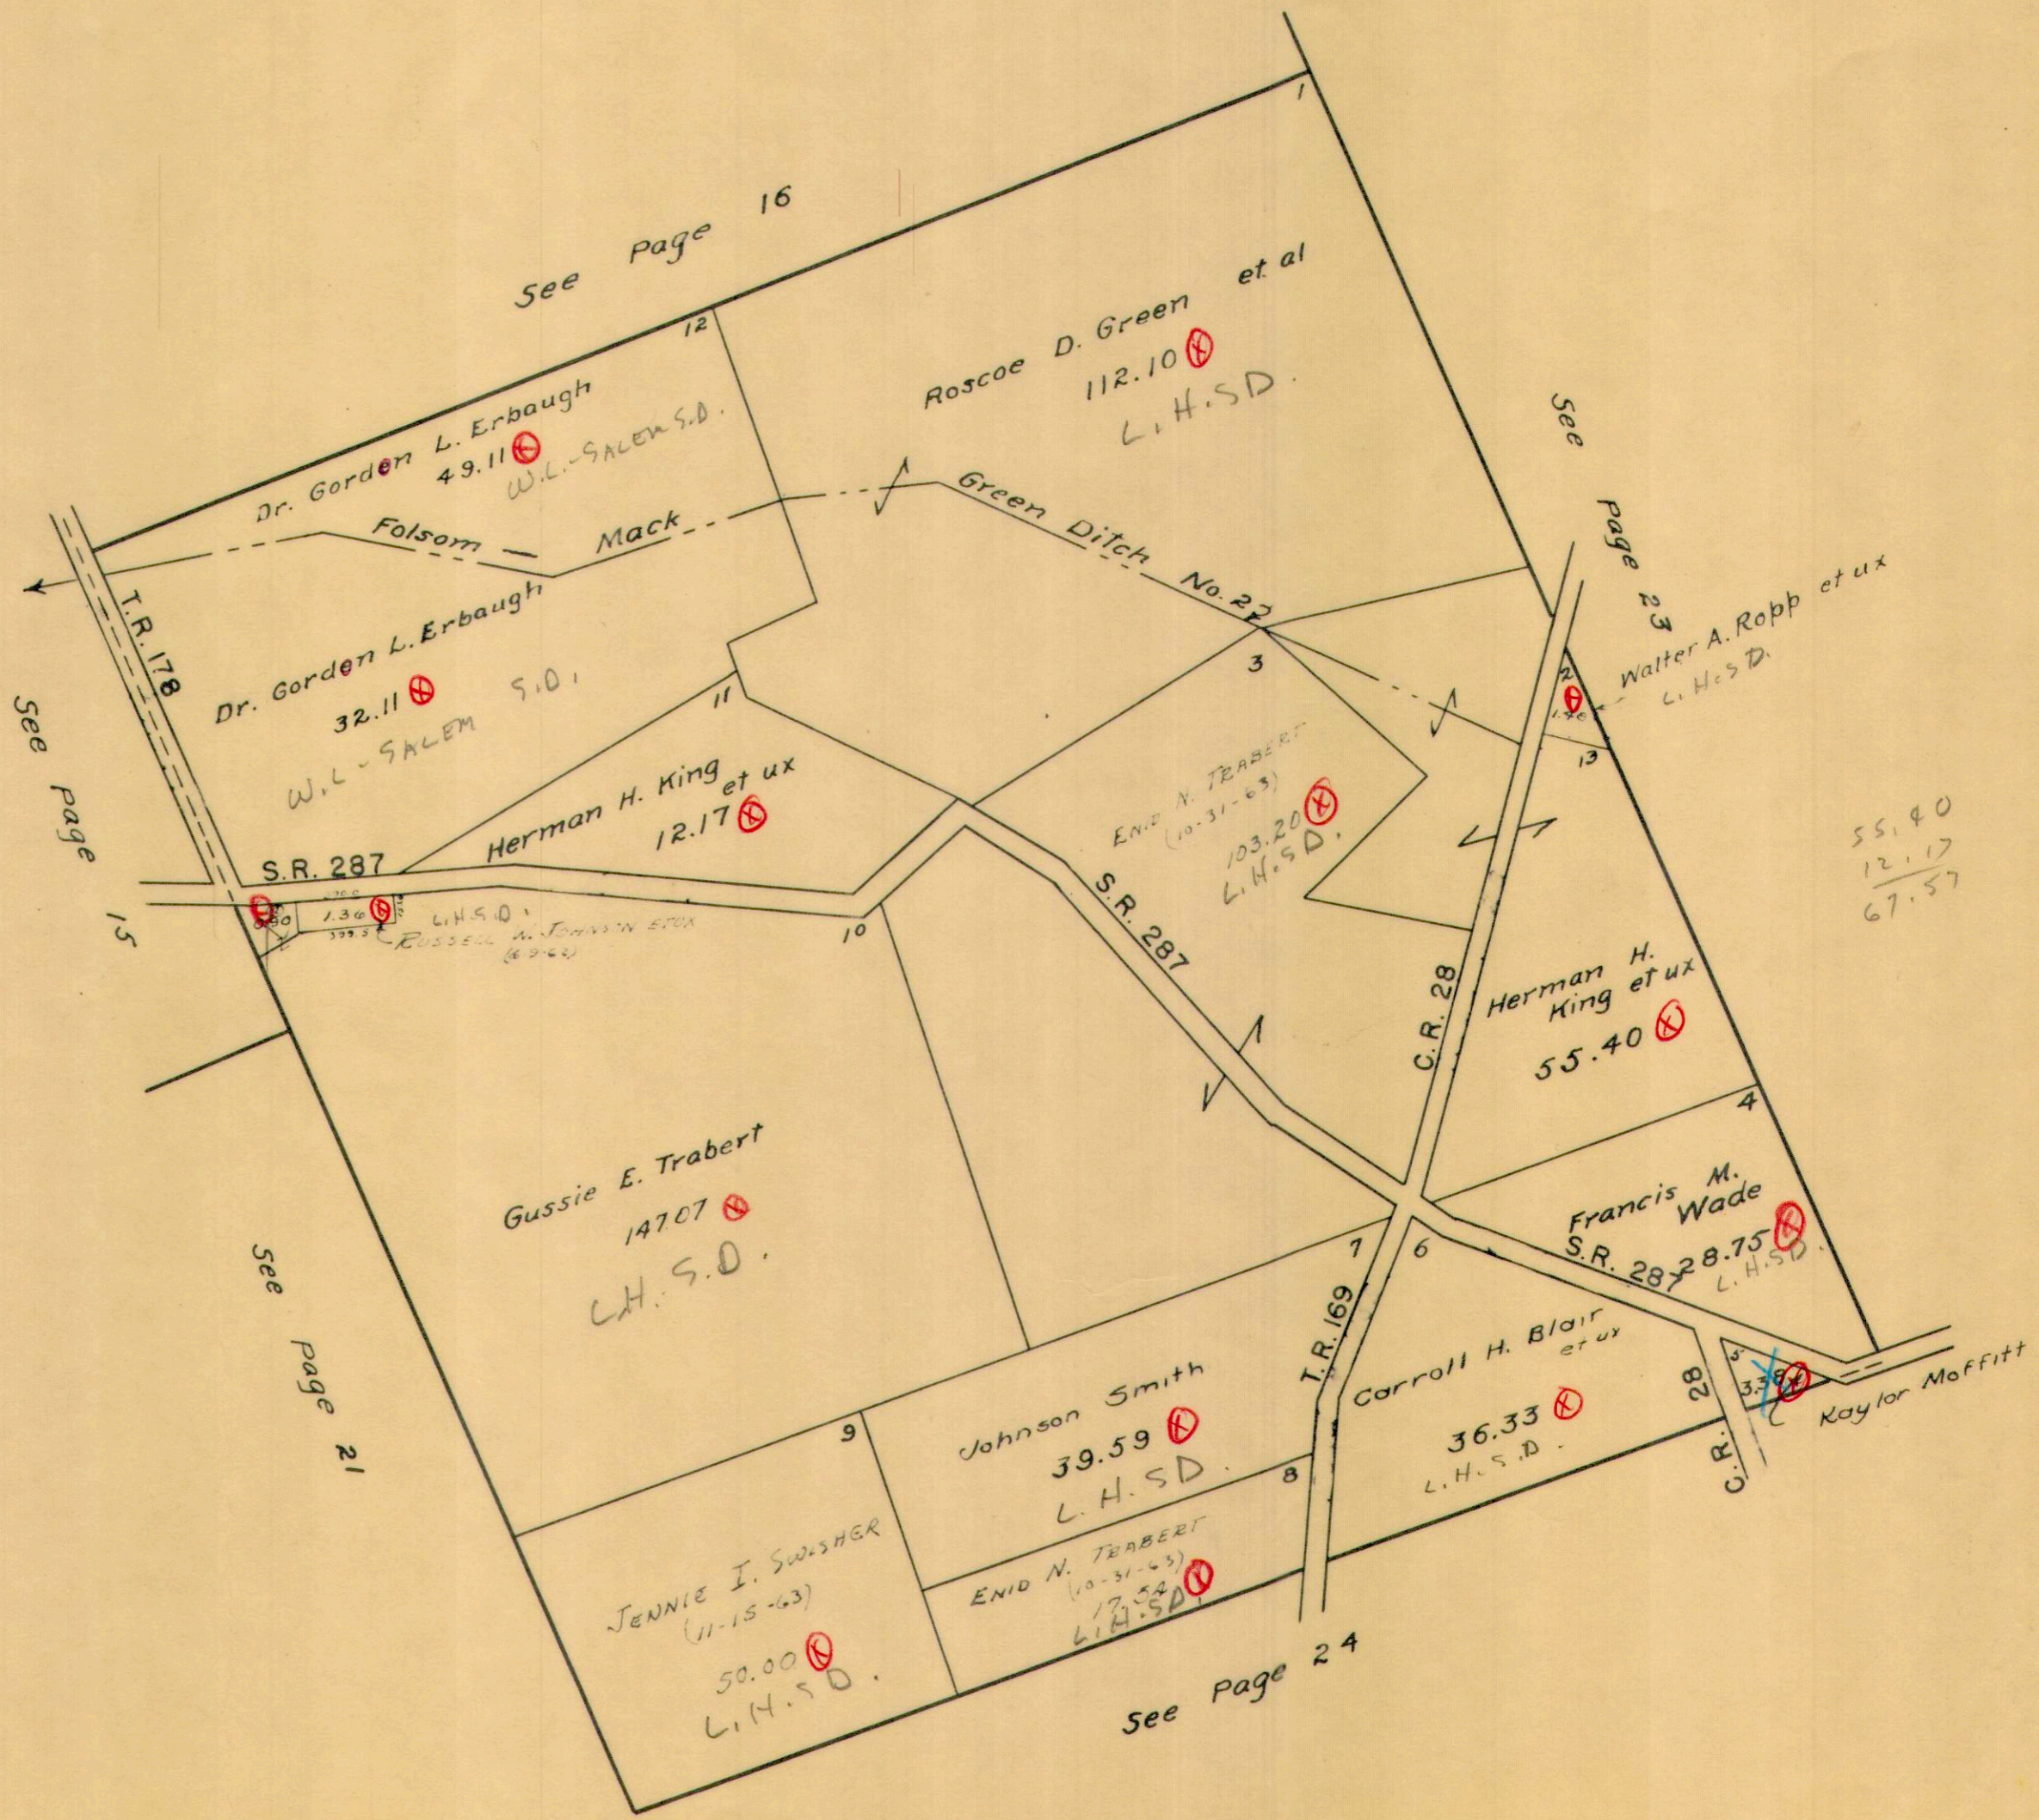

VIRGINIA MILITARY SURVEY 3226

SCALE 10 CHAINS TO THE INCH




H.E. Dysert



MONROE TOWNSHIP
VIRGINIA MILITARY SURVEY 3227

SCALE 10 CHAINS TO THE INCH

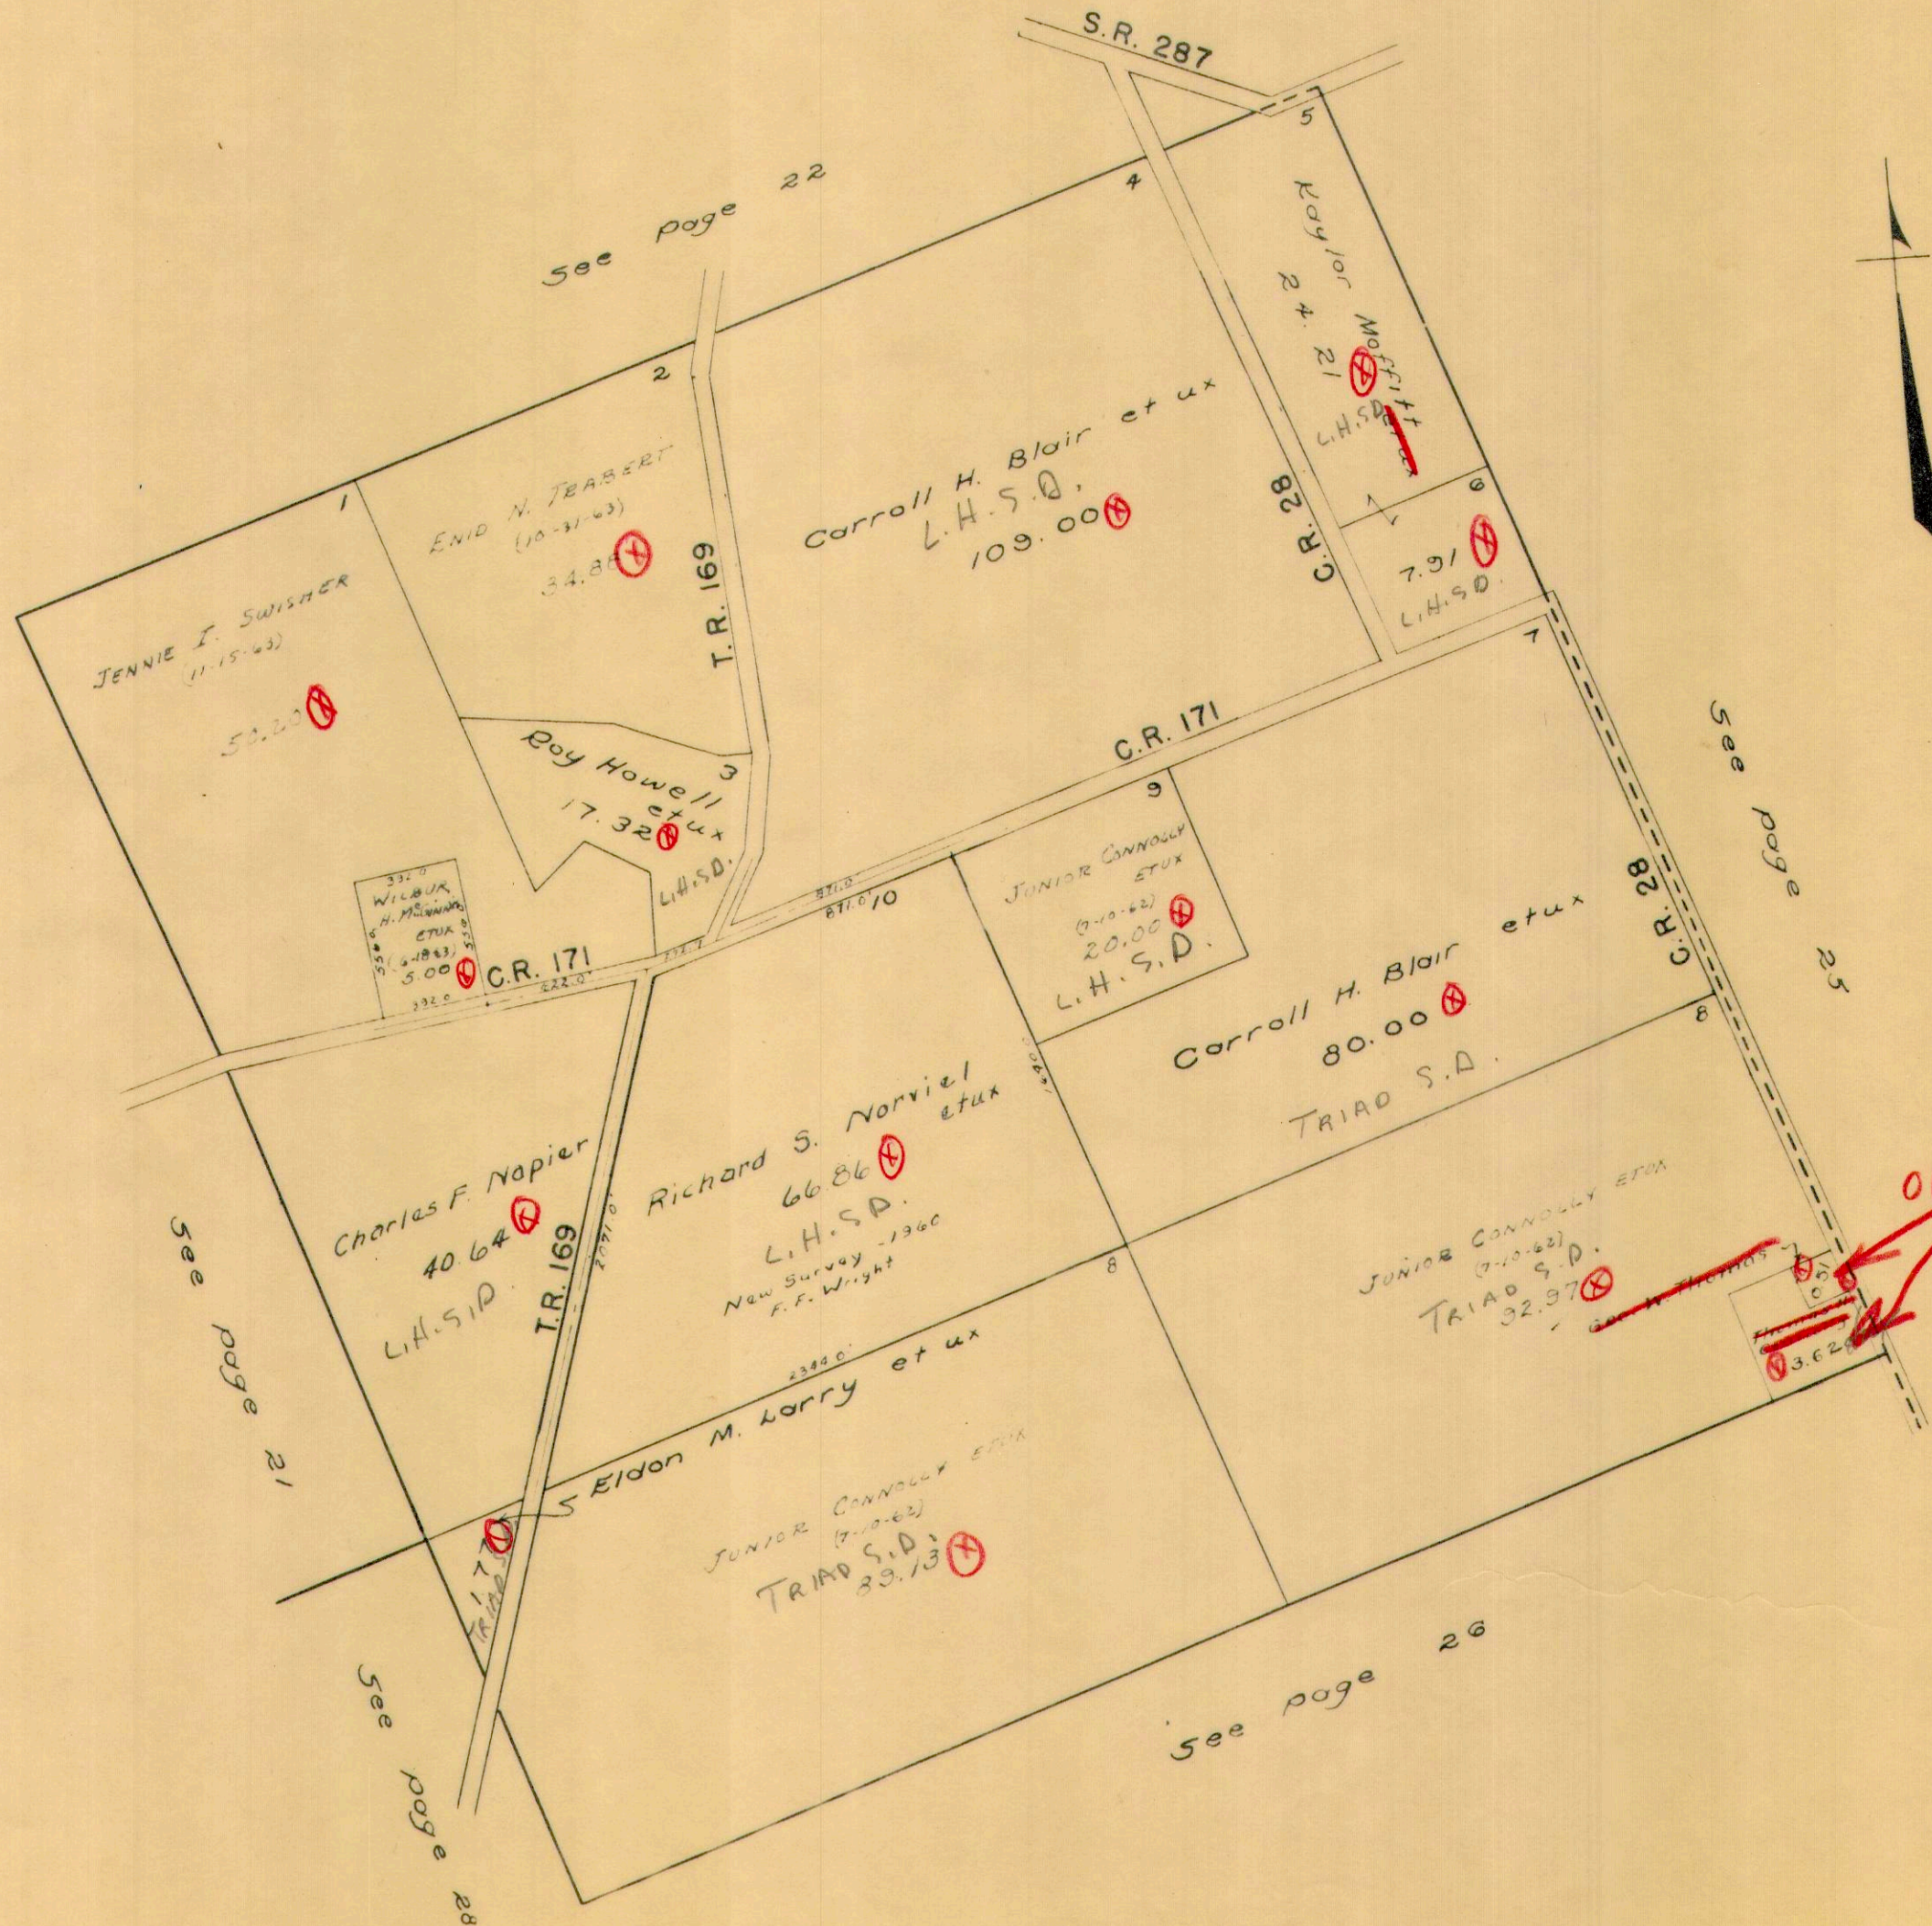

Opal M. Connolly
(5-7-60)

See page 22

See page 25

See page 21

See page 28


See page 26



VIRGINIA MILITARY SURVEYS

3228
9679

SCALE 10 CHAINS TO THE INCH

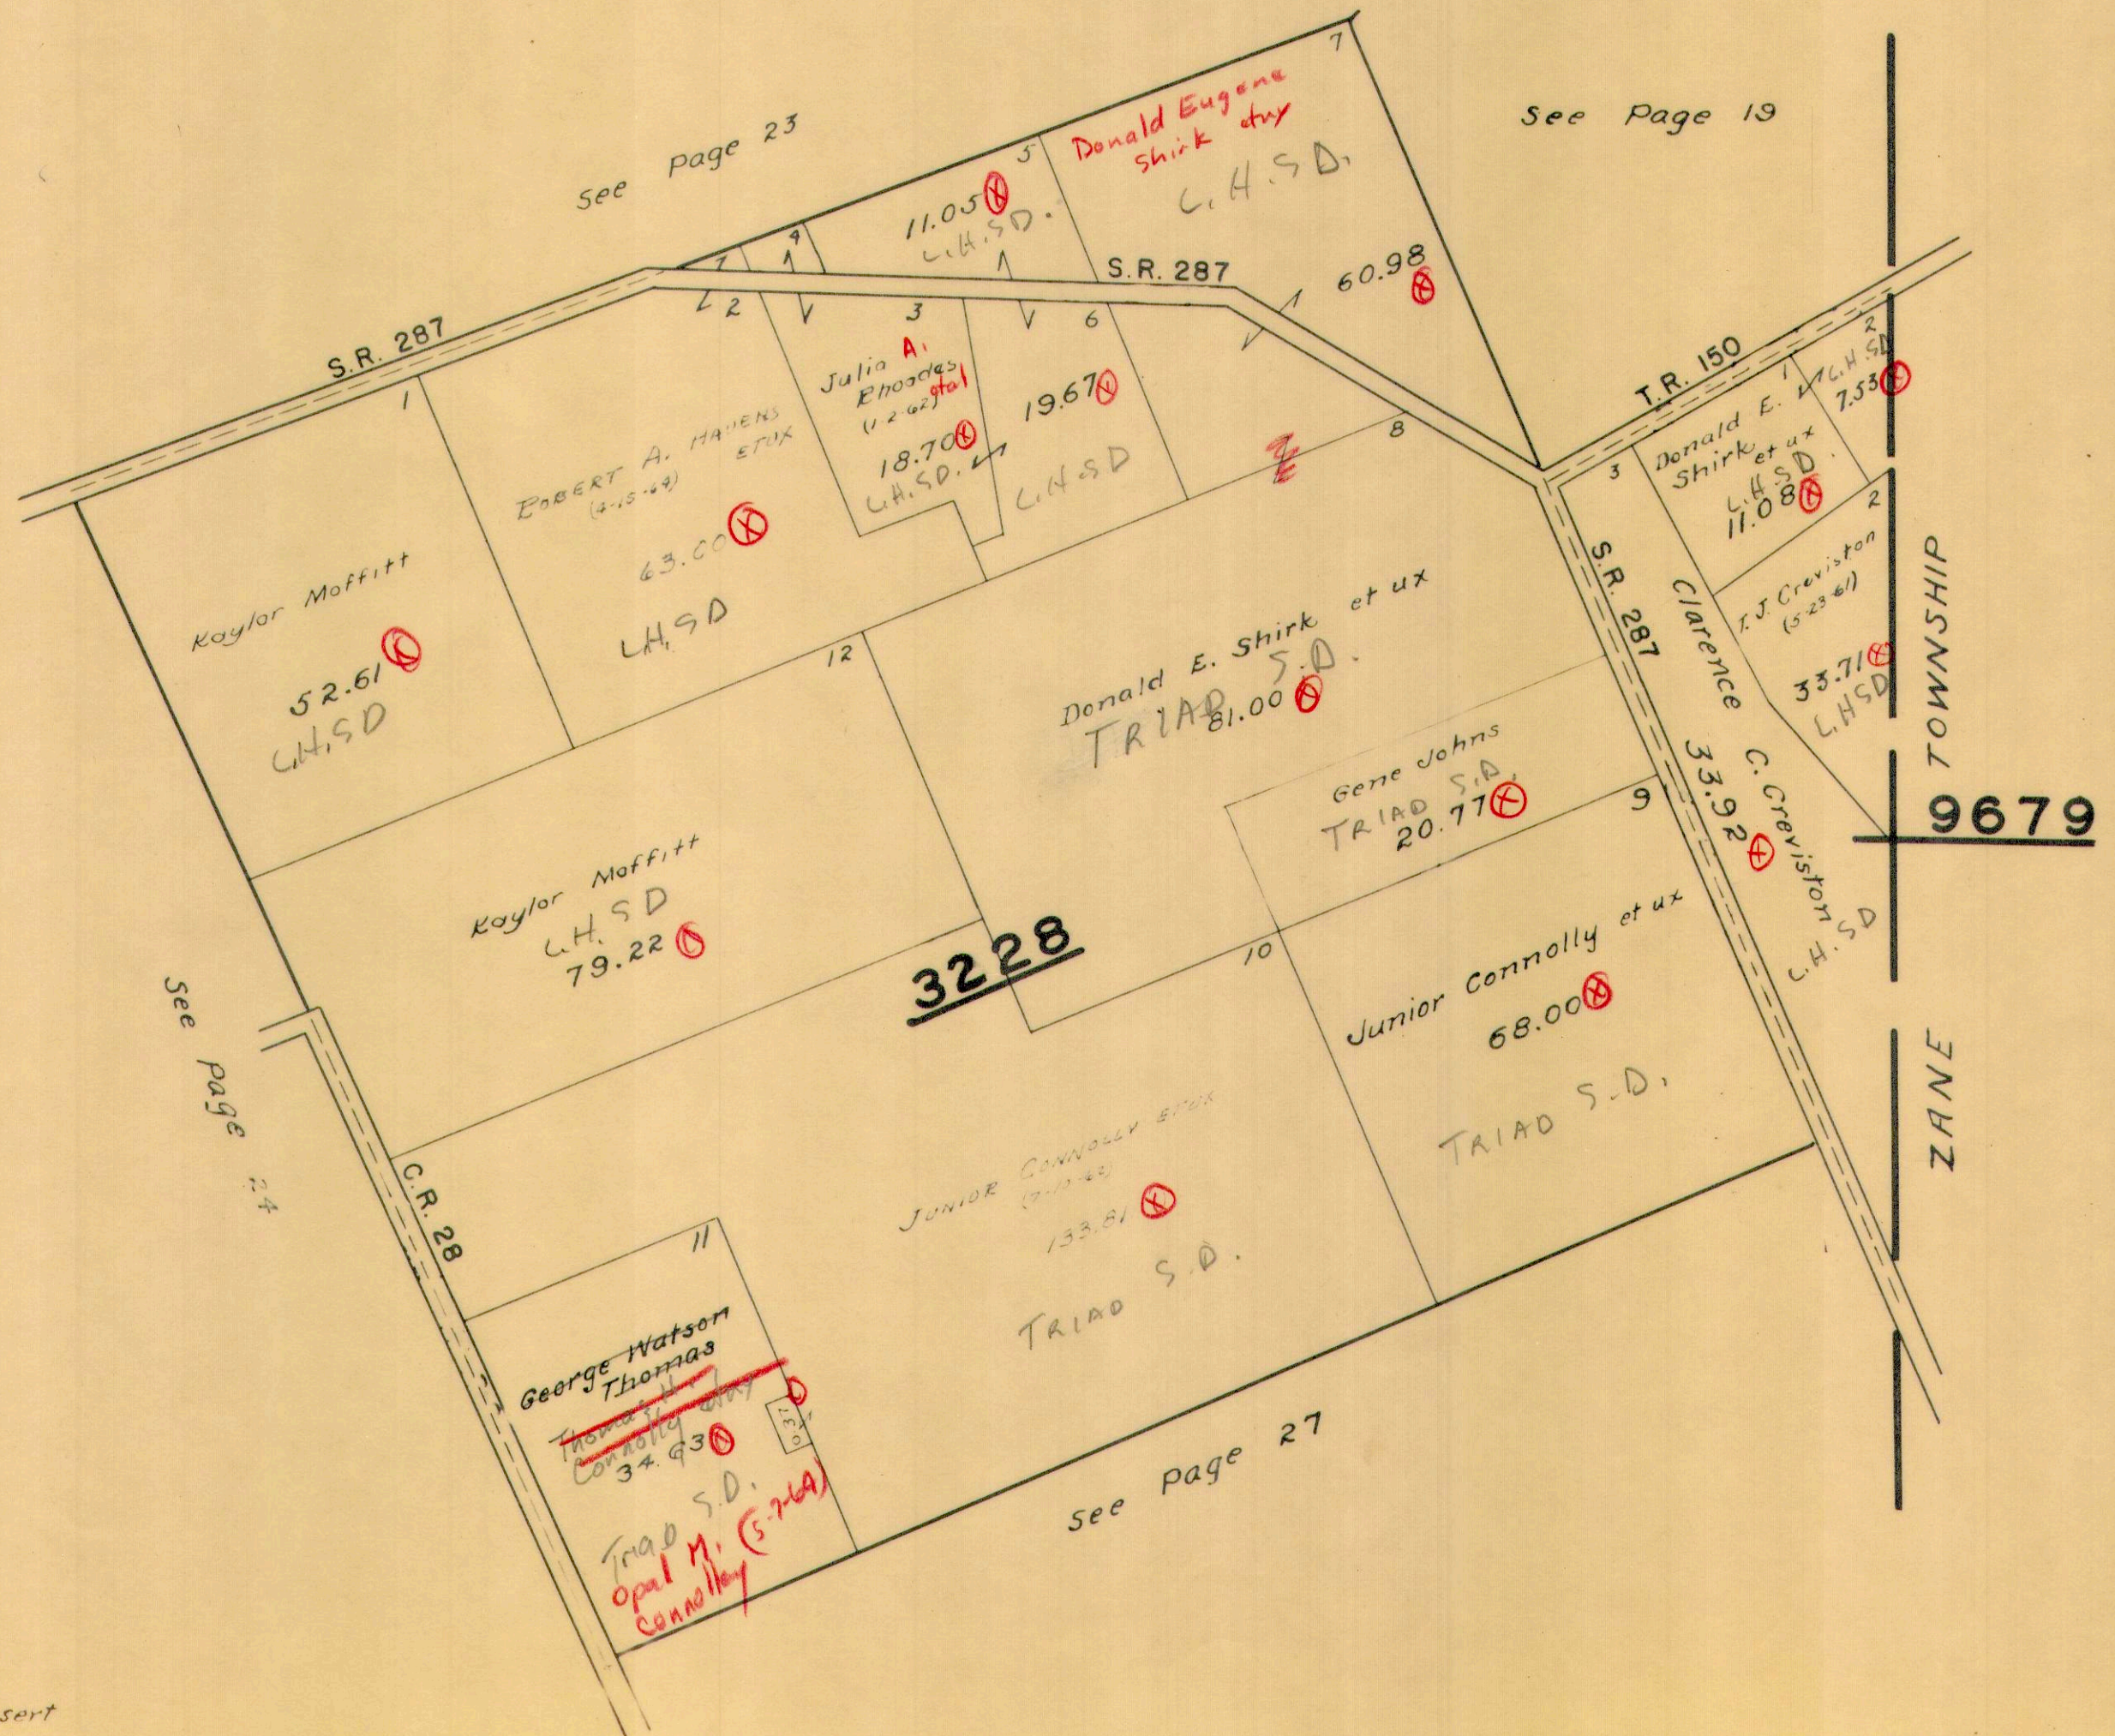


See Page 23

See Page 19


See Page 24


See Page 27

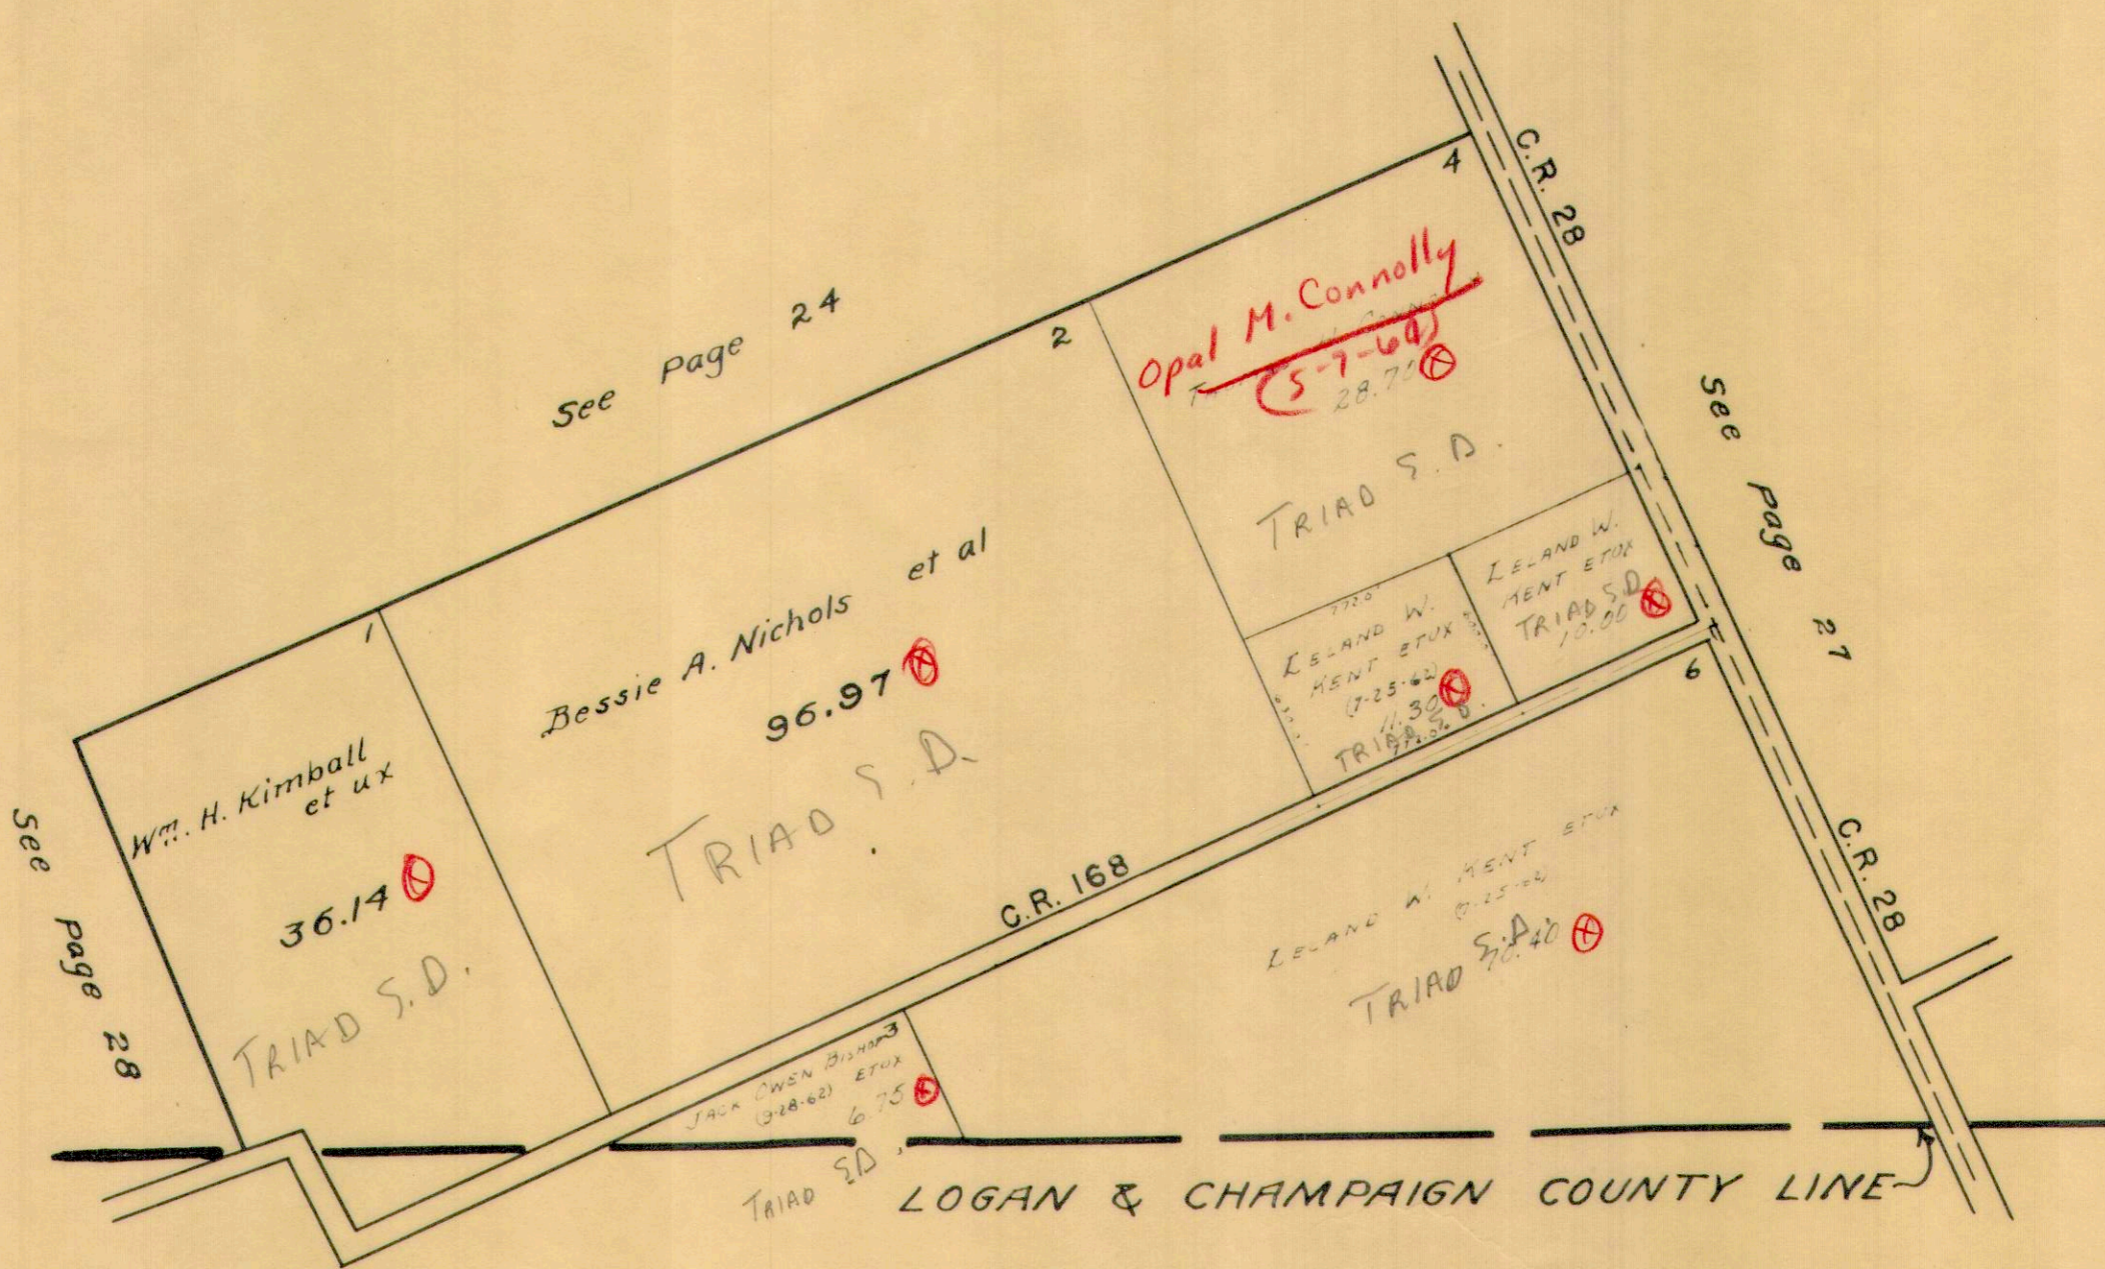

VIRGINIA MILITARY SURVEY 3230



SCALE 10 CHAINS TO THE INCH

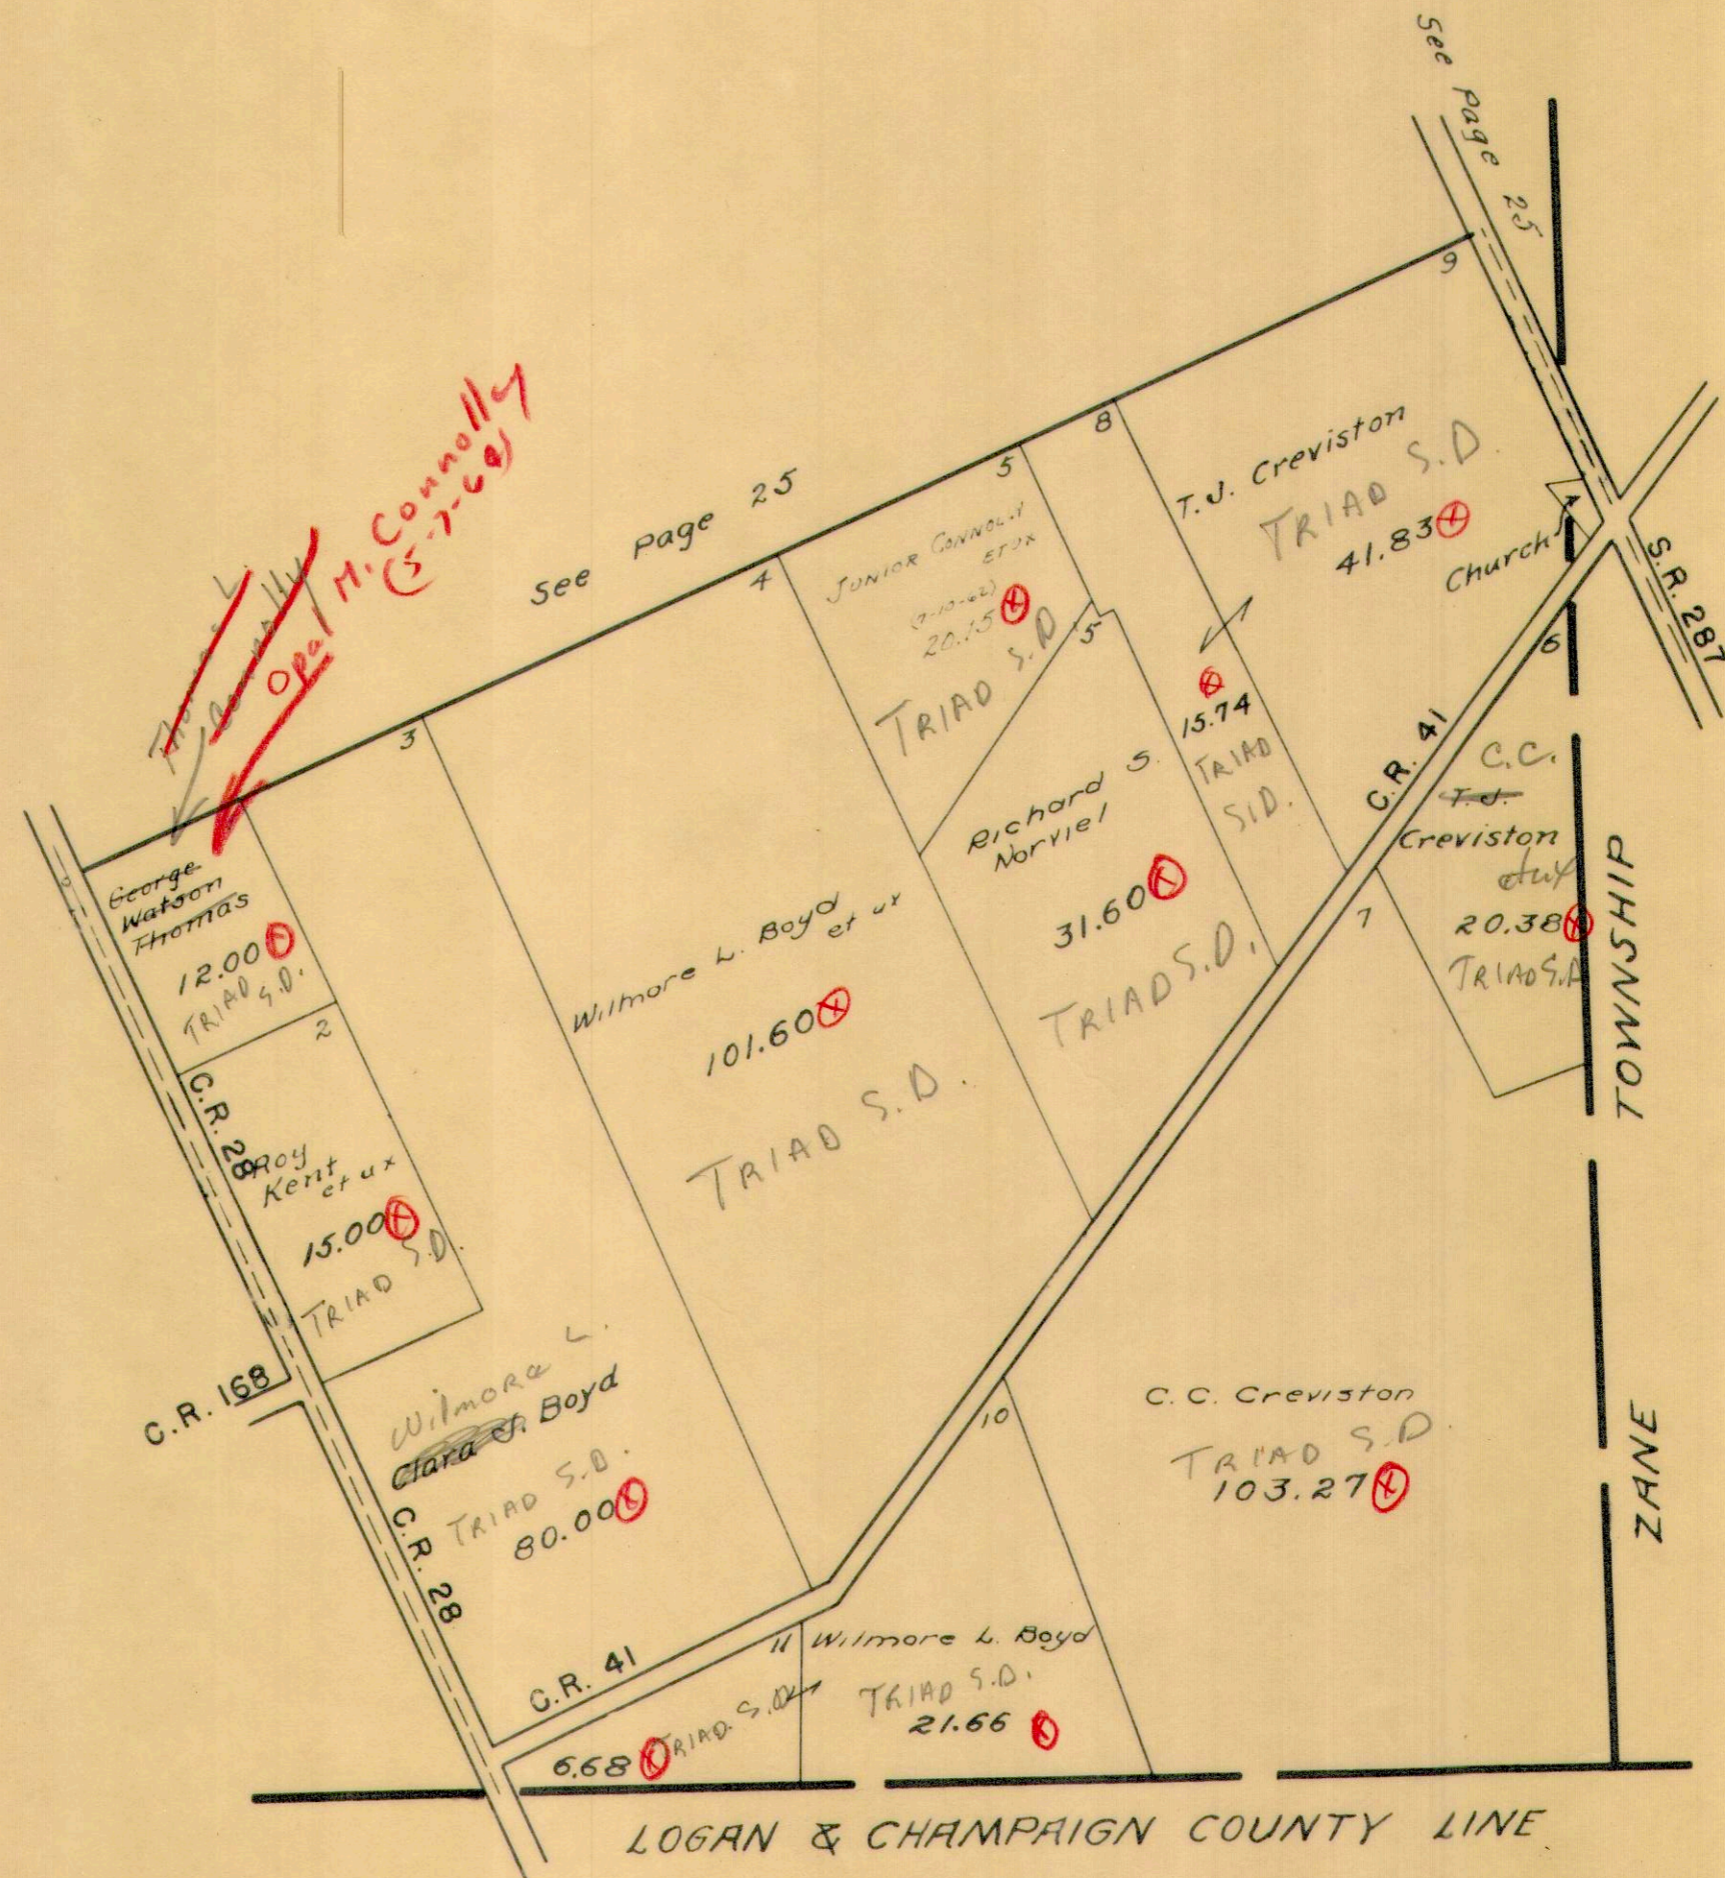

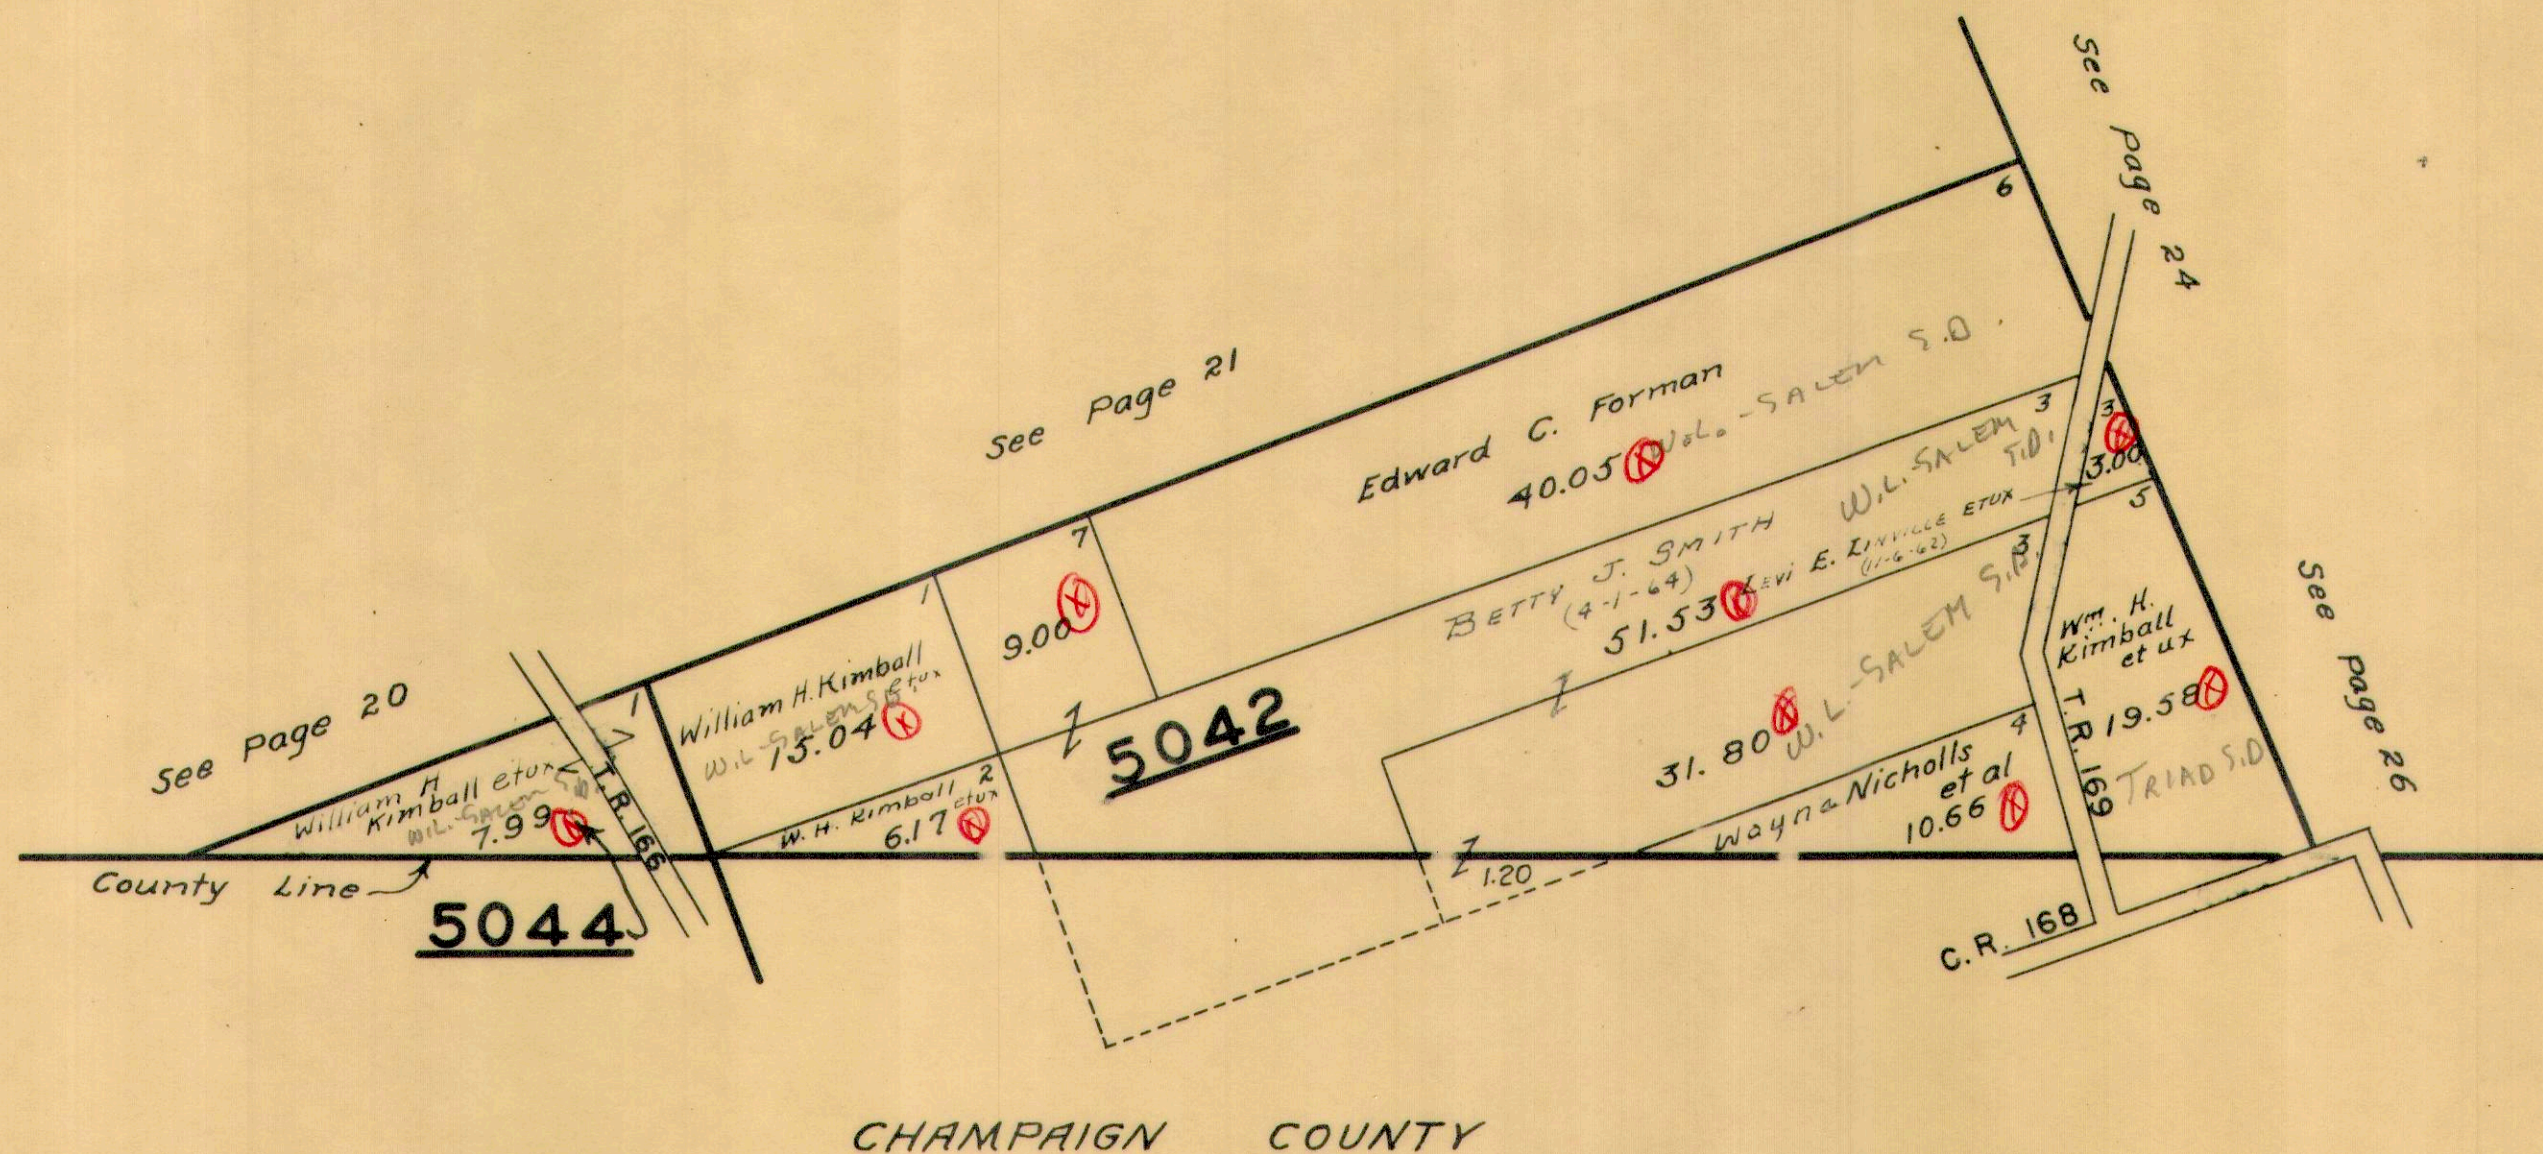


SECTION 19 TOWN 4 RANGE 14
SECTION 24 TOWN 5 RANGE 13

SCALE 10 CHAINS TO THE INCH

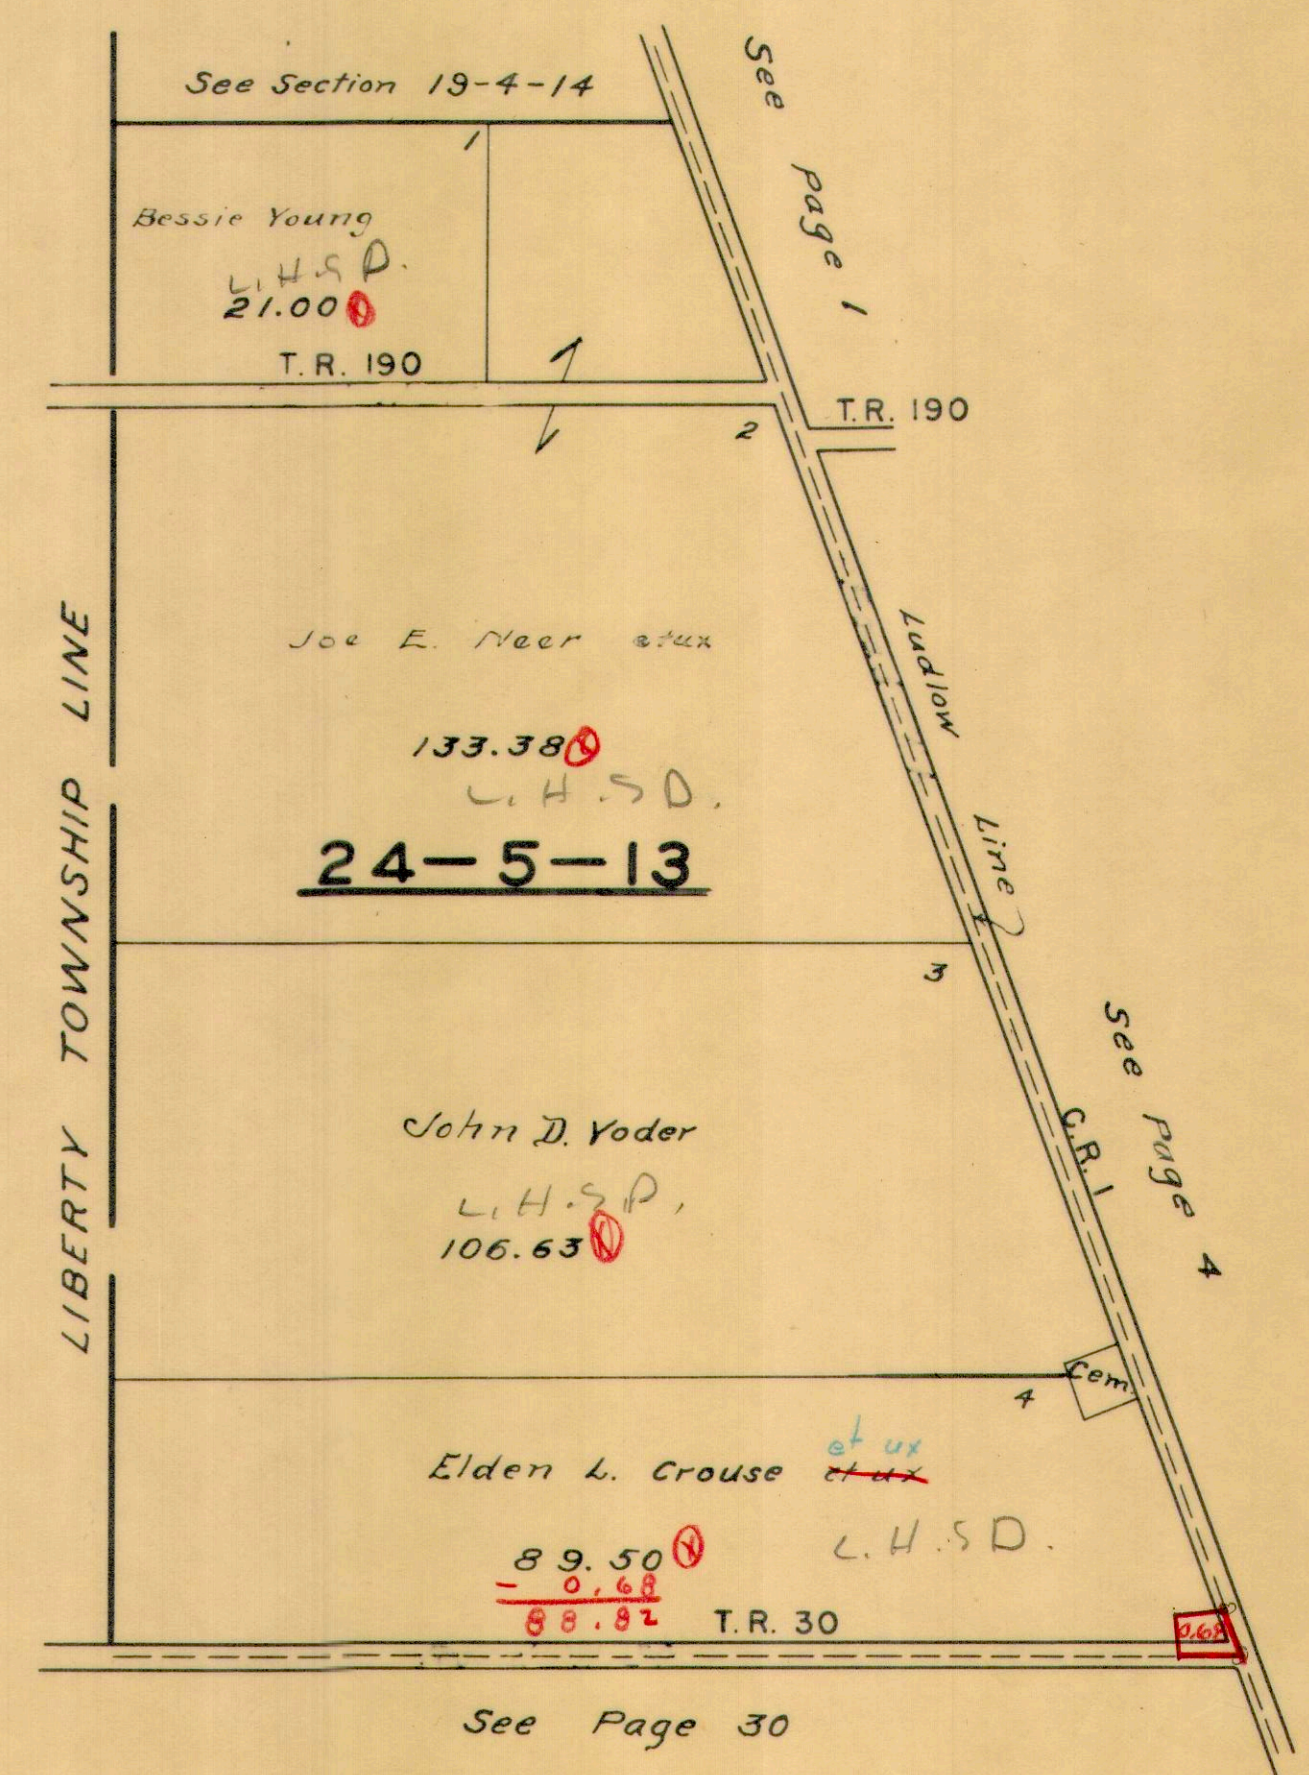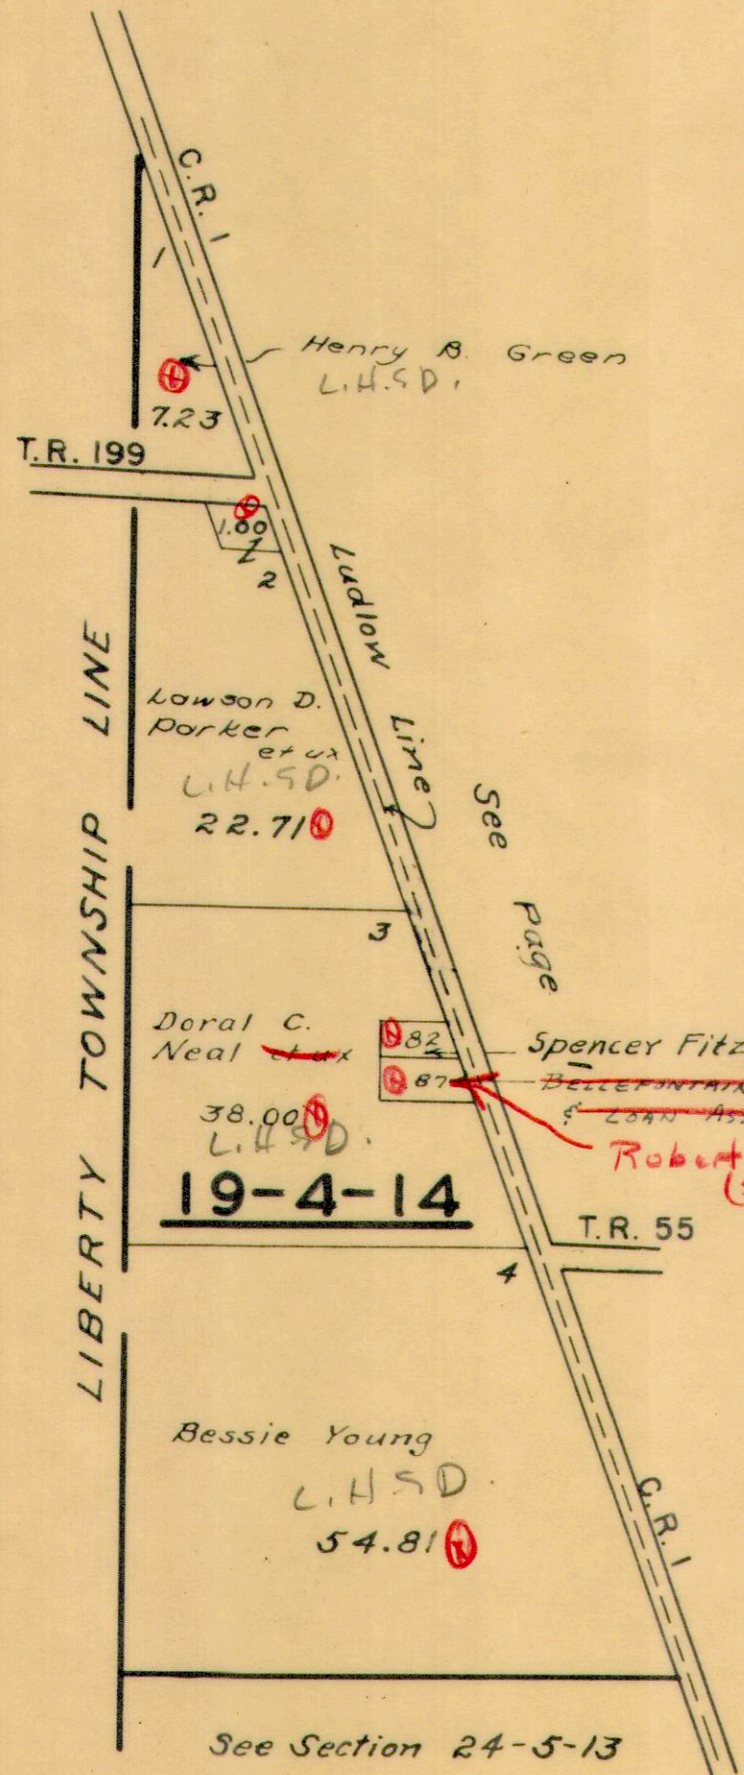


SECTION 17 TOWN 5 RANGE 13
SECTION 23 TOWN 5 RANGE 13

SCALE 10 CHAINS TO THE INCH

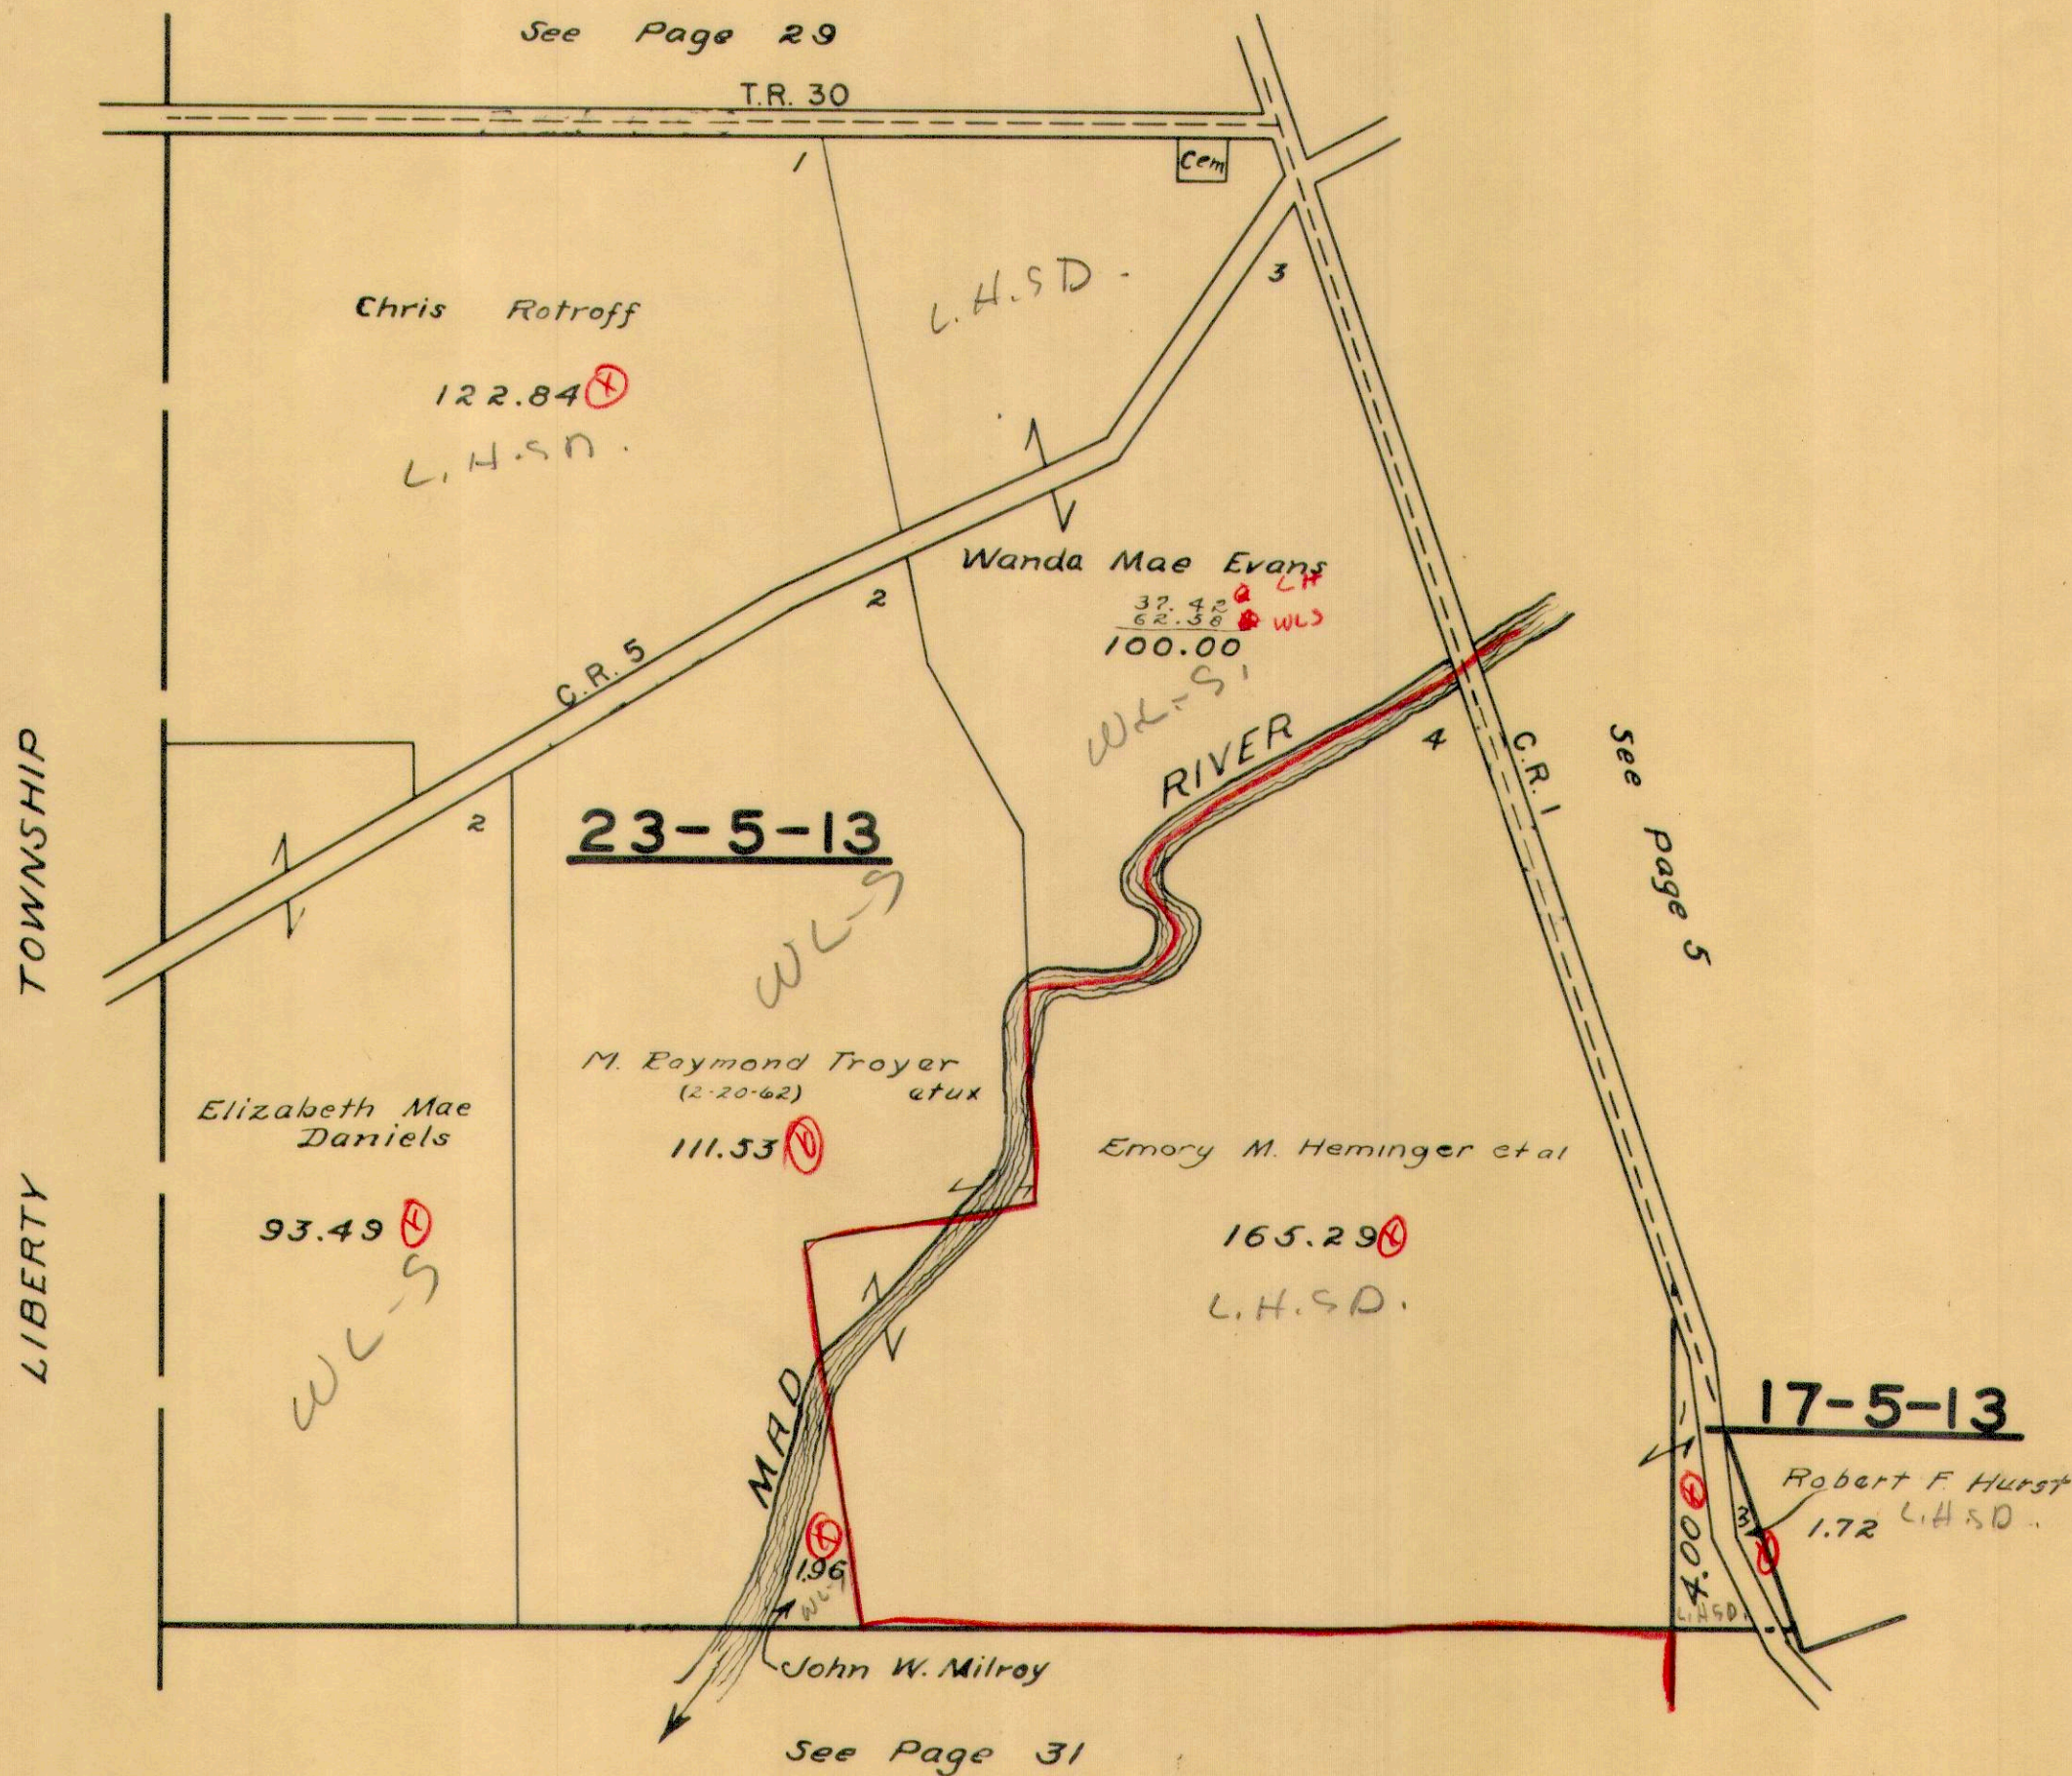


SECTION 22 TOWN 5 RANGE 13
SECTION 16 TOWN 5 RANGE 13

SCALE 10 CHAINS TO THE INCH

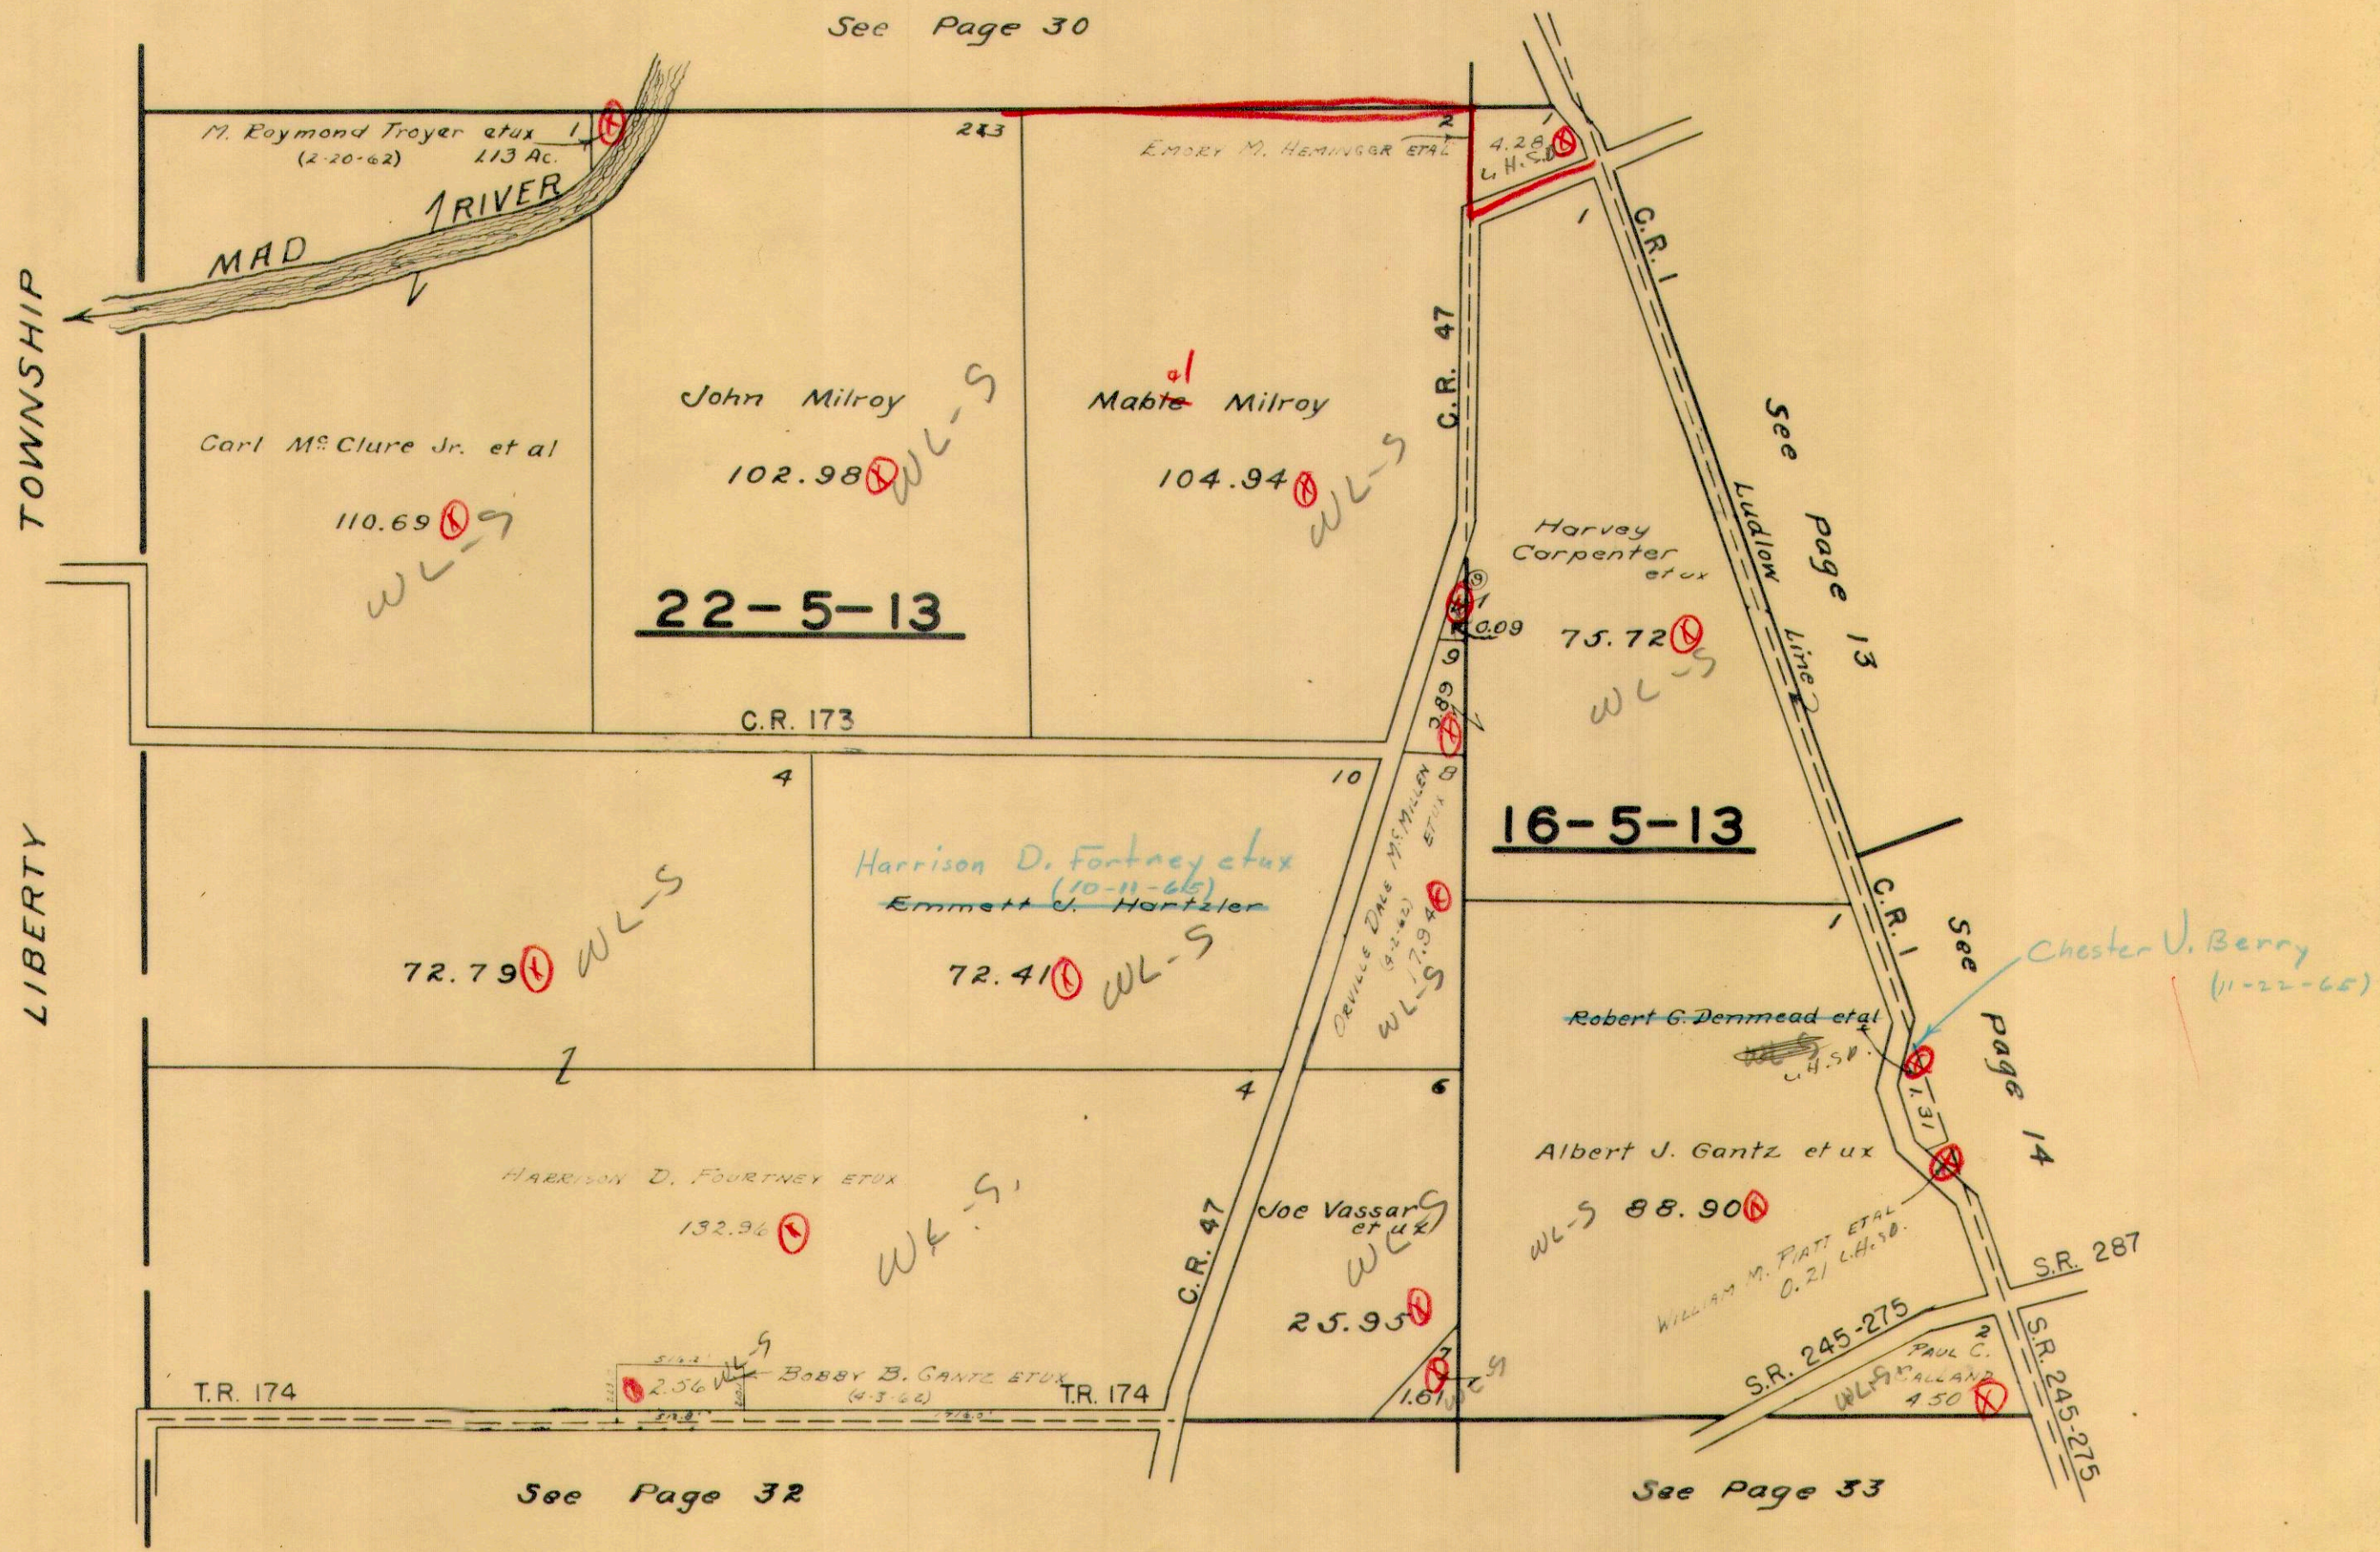


MONROE TOWNSHIP
SECTION 21 TOWN 5 RANGE 13

SCALE 10 CHAINS TO THE INCH

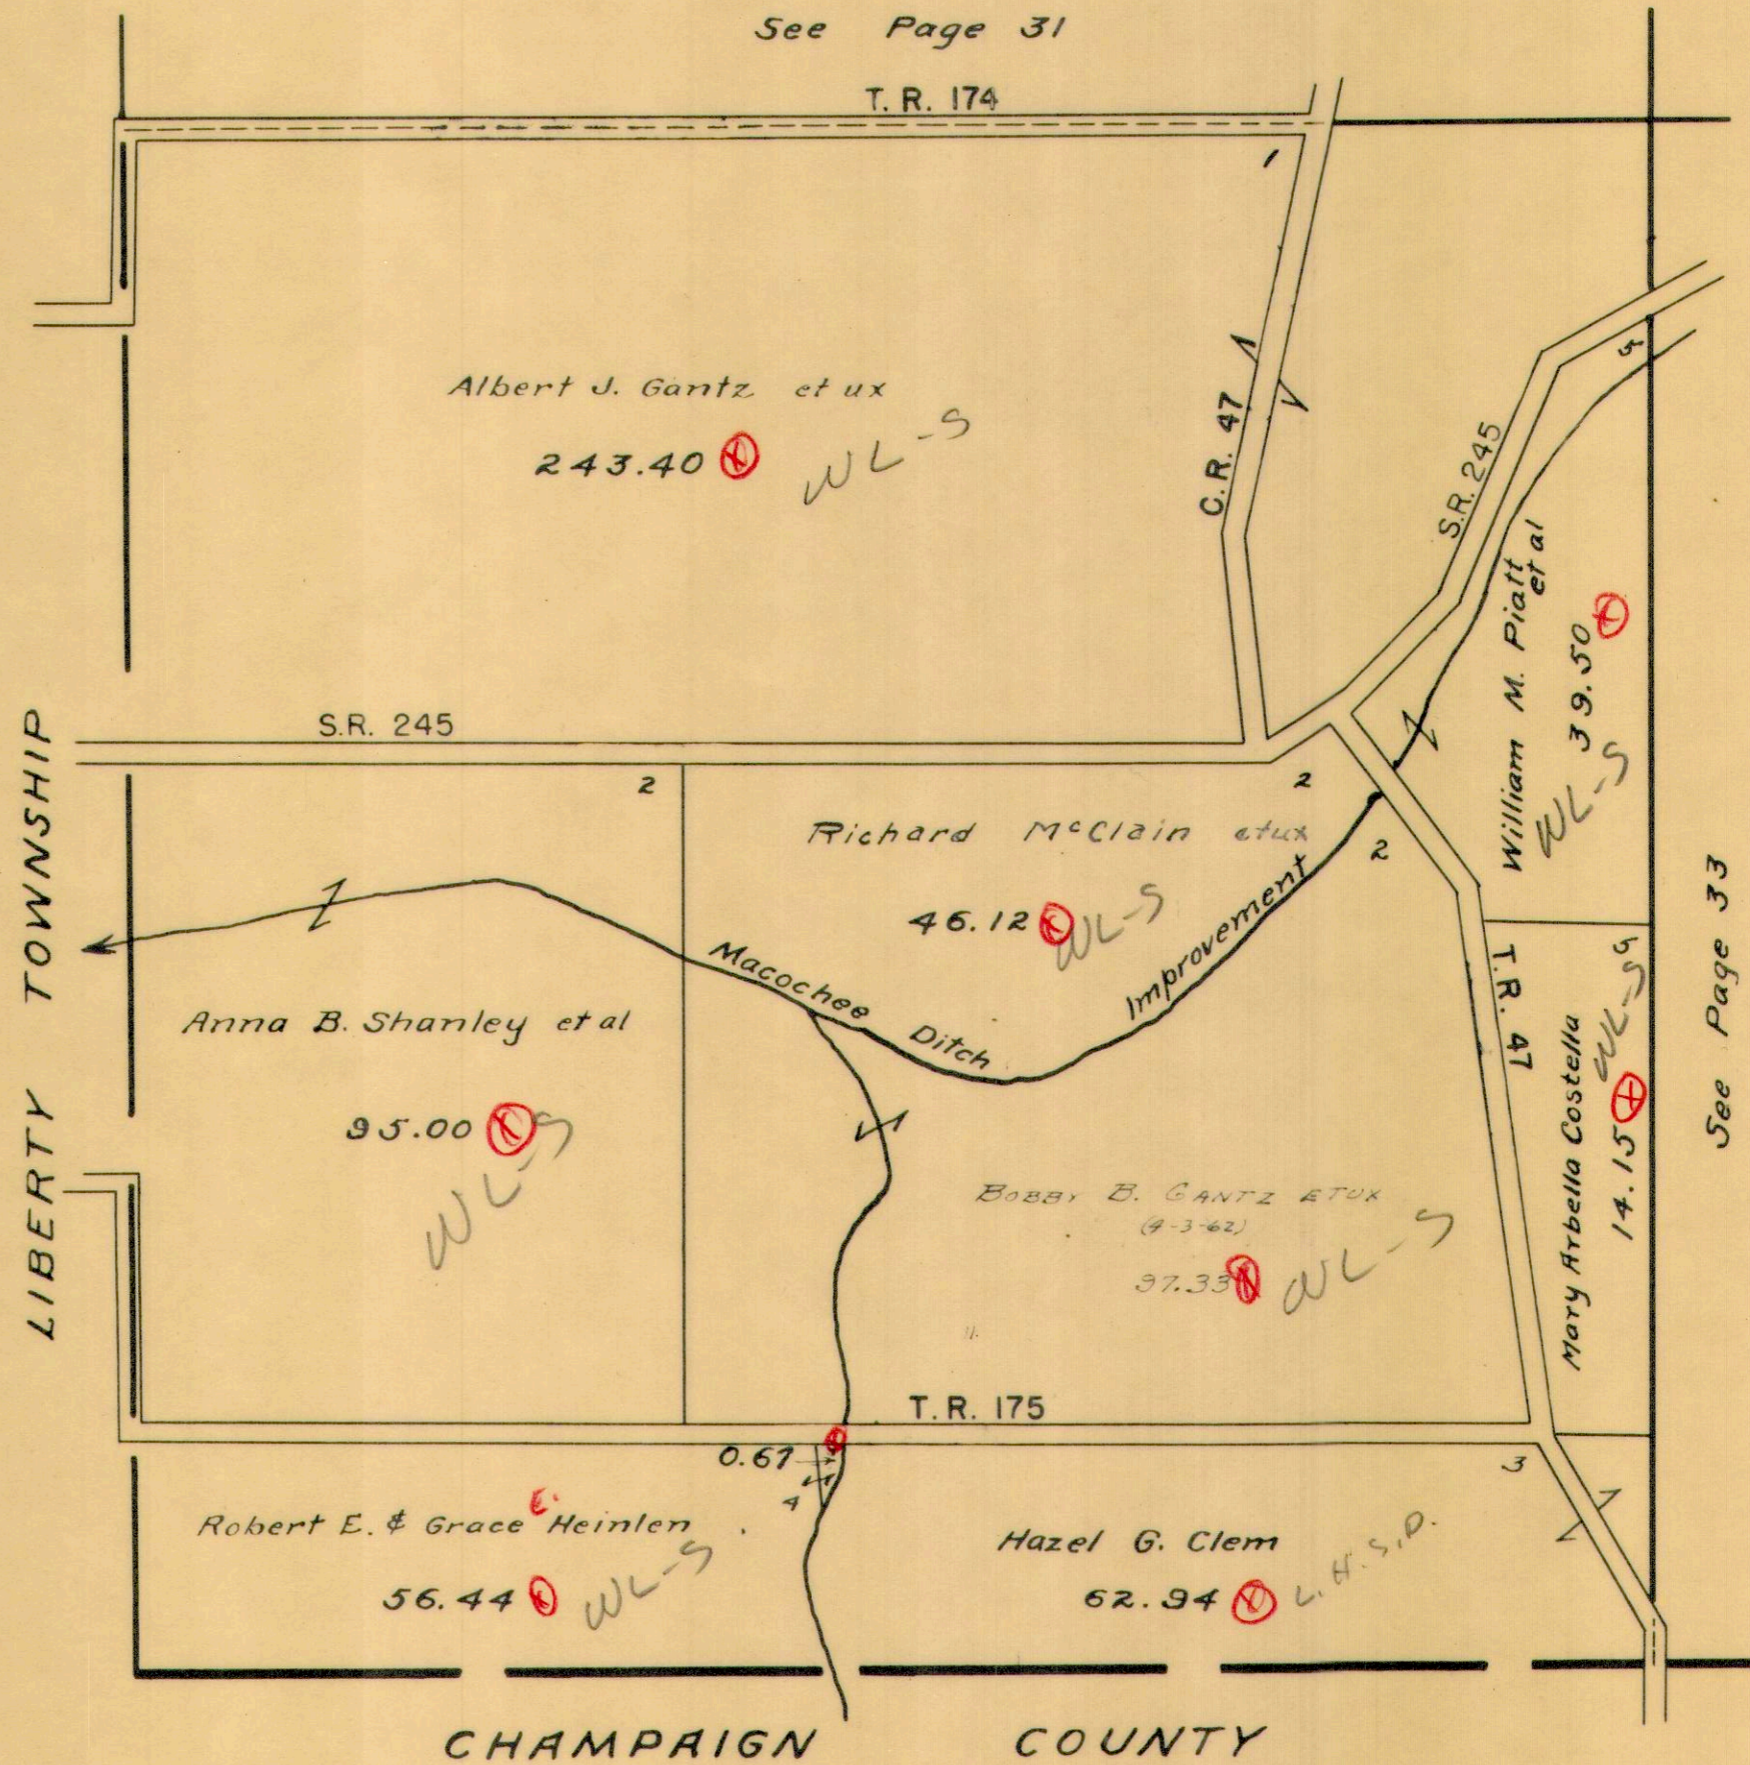

MONROE TOWNSHIP
SECTION 15 TOWN 5 RANGE 13

SCALE 10 CHAINS TO THE INCH

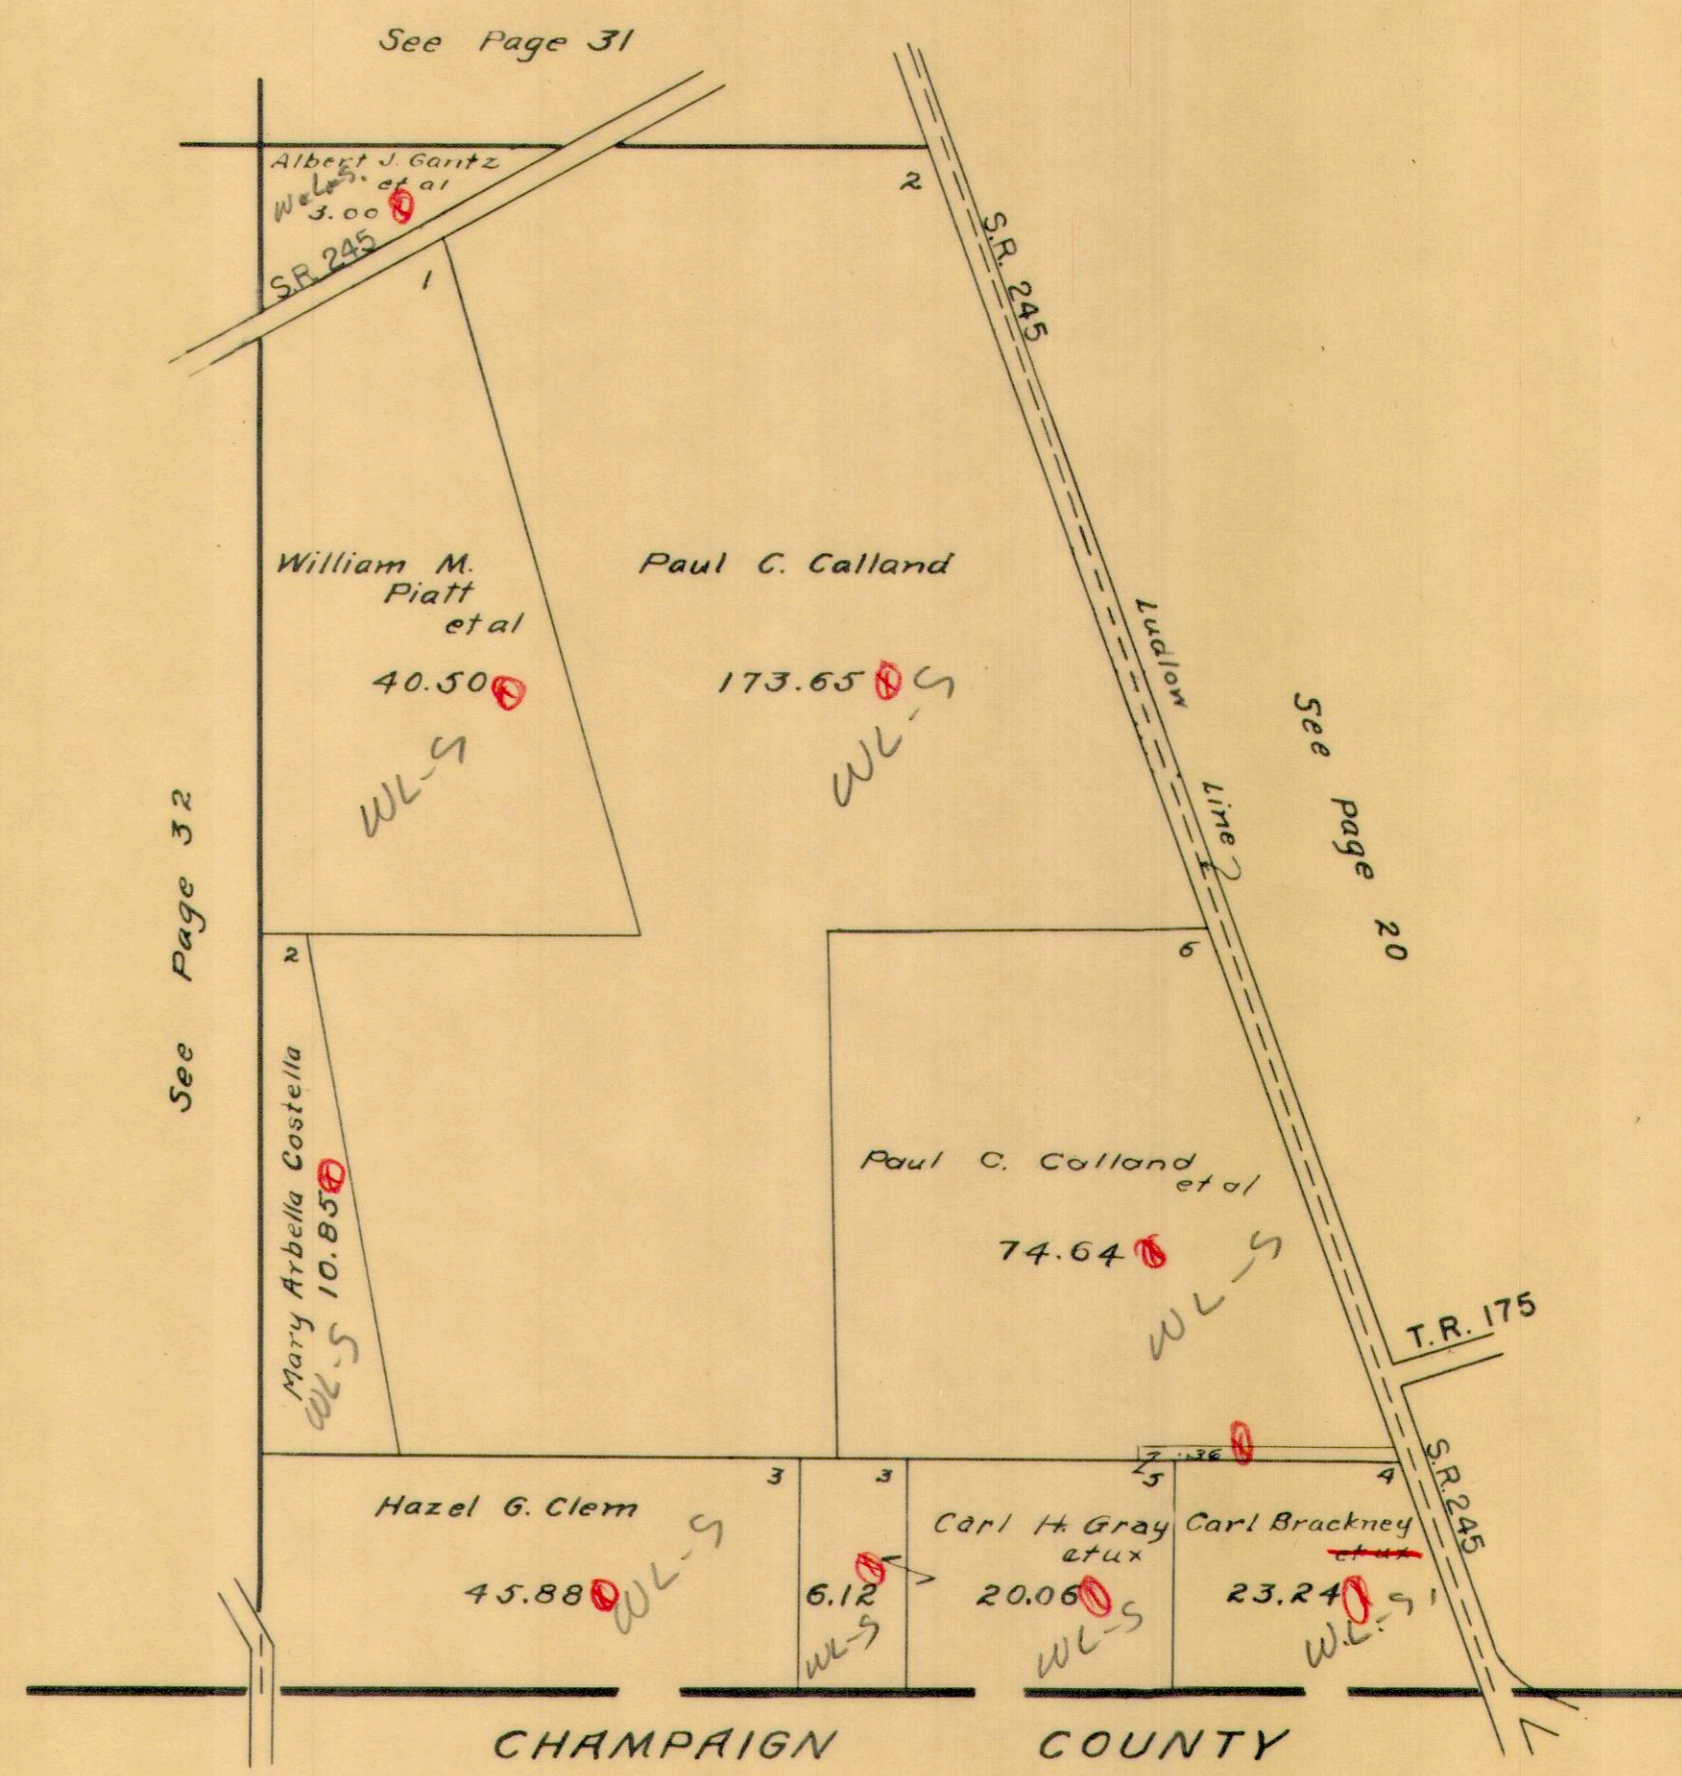

PICKRELLTOWN

SCALE 100 FEET TO THE INCH

3221

