


William E. Tharp et ux 50.60

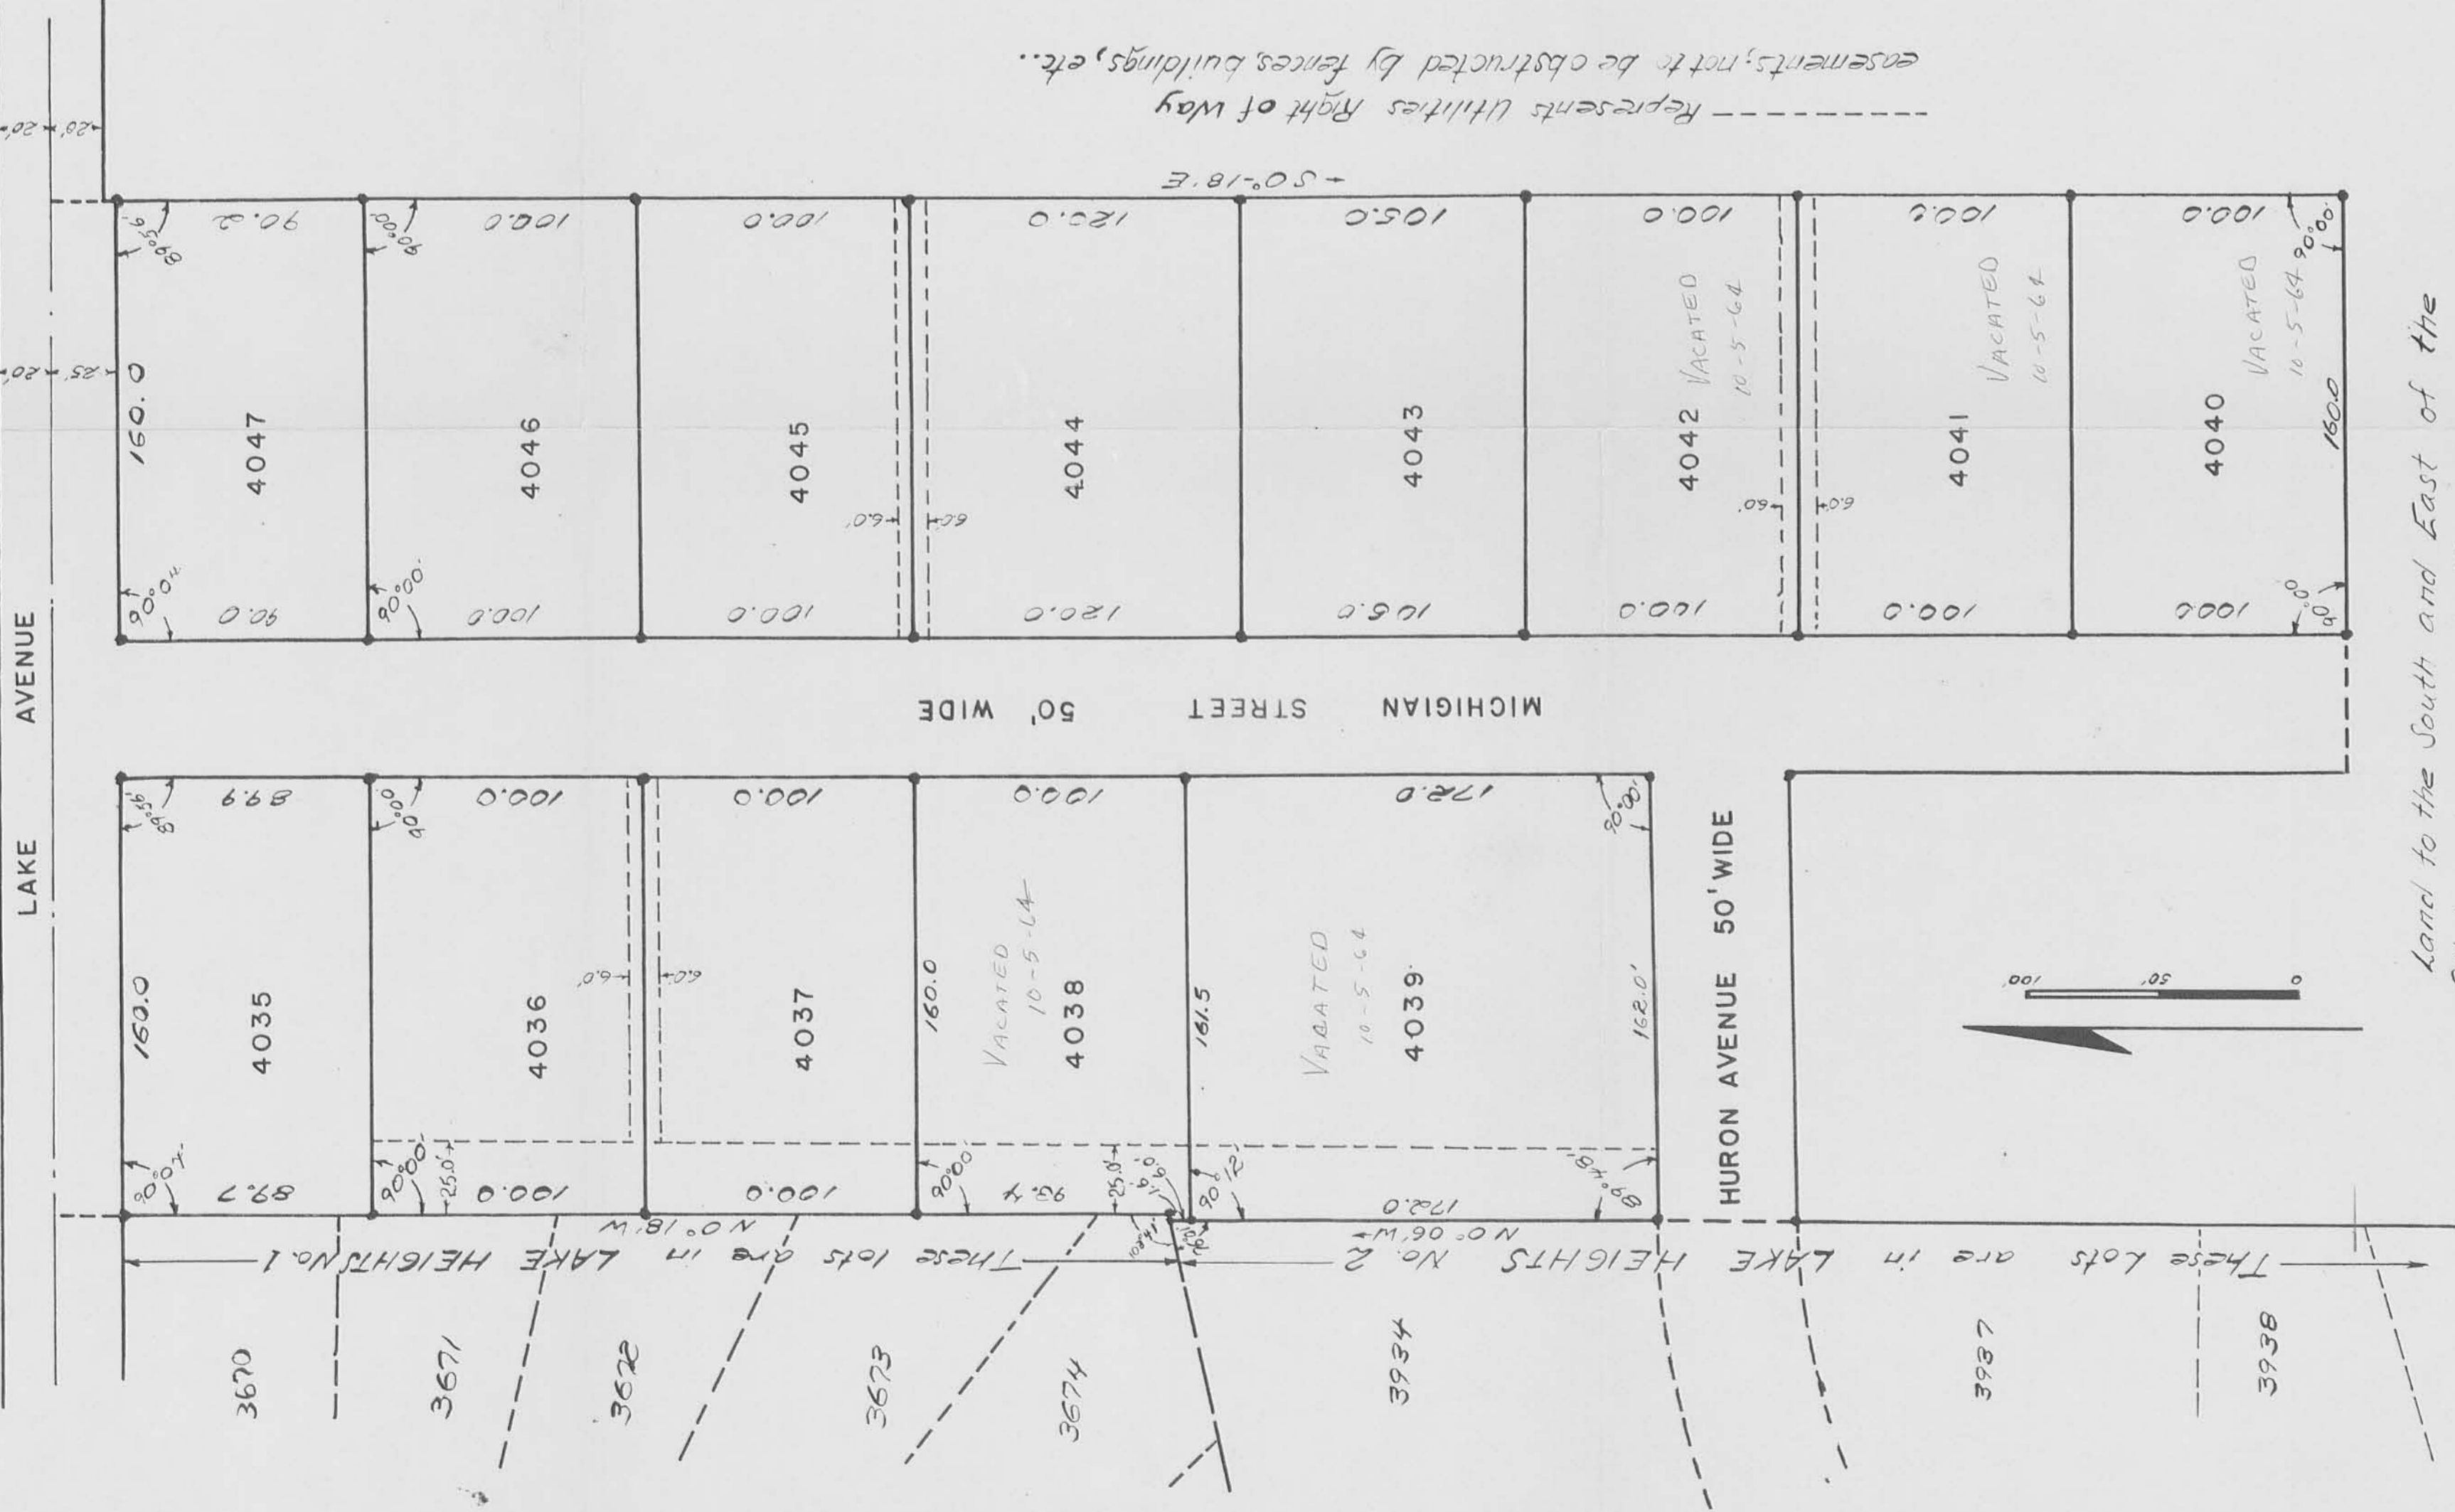

Represents Utilities Right of Way easements, not to be obstructed by fences, buildings, etc.

Land to the South and East of the Allotment owned by Roy E. Morris et ux. 343A

AUDITOR'S OFFICE LOGAN COUNTY, OHIO

The within lots transferred this 9th day of March, 1957.

Harry E. Tharp
Auditor of Logan County

RECORDER'S OFFICE LOGAN COUNTY, OHIO

Received for record at 10:00 O'clock A. M. on the 9th day of March, 1957.
Recorded in Plat Book 4 Volume D Page 41

Journals L. Streashed
Recorder of Logan County

3424
INDEXED ON MAP

3424
INDEXED ON MAP

MORRIS ALLOTMENT
BELLEFONTAINE, OHIO
SECTION 27 TOWN 4 RANGE 14
LAKE TOWNSHIP LOGAN COUNTY
1957 1" = 50'

SURVEYOR'S CERTIFICATE

The accompanying plat represents a Sub-division of land in Section 27, Town 4, Range 14, Lake Township, Logan County, Ohio and in the city of Bellefontaine. The tract has an area of 1.33 acres in Streets and 5.06 acres in lots making a total of 6.48 acres. Surveyed July, 1956. The width of the streets are as shown. Iron bars were placed at all lot corners. All measurements are in feet and tenths of feet. I hereby certify that the accompanying plat is a correct representation of the MORRIS ALLOTMENT.

Queen K. Shirk
Registered Surveyor 164211

DEDICATION

Know all men by these present that Roy Morris et ux and William Frail et ux proprietors of the land indicated in the accompanying plat has authorized the laying out of same as indicated in the accompanying plat and do hereby dedicate the streets to the use of the public forever.


Witnesses
Roy E. Morris
William Frail
M. G. Dodd
A. A. Dodd
Proprietors

STATE OF OHIO, COUNTY OF LOGAN: SS

Be it remembered that on the 11th of February in the year of our Lord One Thousand Nine Hundred Fifty Seven before me, a Notary Public in and for said County, personally came Roy E. Morris, William Frail, and Ruth E. Frail grantors in the foregoing dedication who acknowledged the signing thereof to be their free and voluntary act and deed.

Dec 20-1957
My Commission Expires

Zetta M. Reed
Notary Public, Logan County

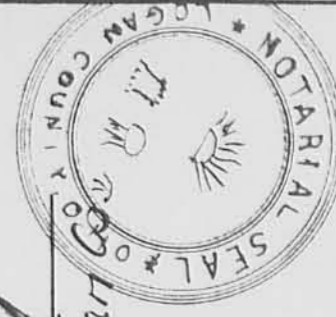

ACCEPTANCE

The annexed plat was adopted by Ordinance No. 2452 as an addition to the city of Bellefontaine State of Ohio. Said ordinance was passed at a regular meeting of Council on the 25 day of February, 1957.

Paul E. Watkins
Pres. of Council
Clerk

JJ-103

A-120

JJ-103 A-120