PLAT CAB. B SLIDE 85B

AUTUMN WOODS CONDOMINIUMS

PHASE II
ADDITIONAL PROPERTIES NO. 3, NO. 4, NO. 5 AND NO. 7

SECTION 27 AND 33, TOWN 4, RANGE 14
PART OF LOT 4701 JADO VILLE SUBDIVISION AND
PART OF LOT 4887 JADO VILLE SUBDIVISION II
CITY OF BELLEFONTAINE
LAKE TOWNSHIP, LOGAN COUNTY, OHIO

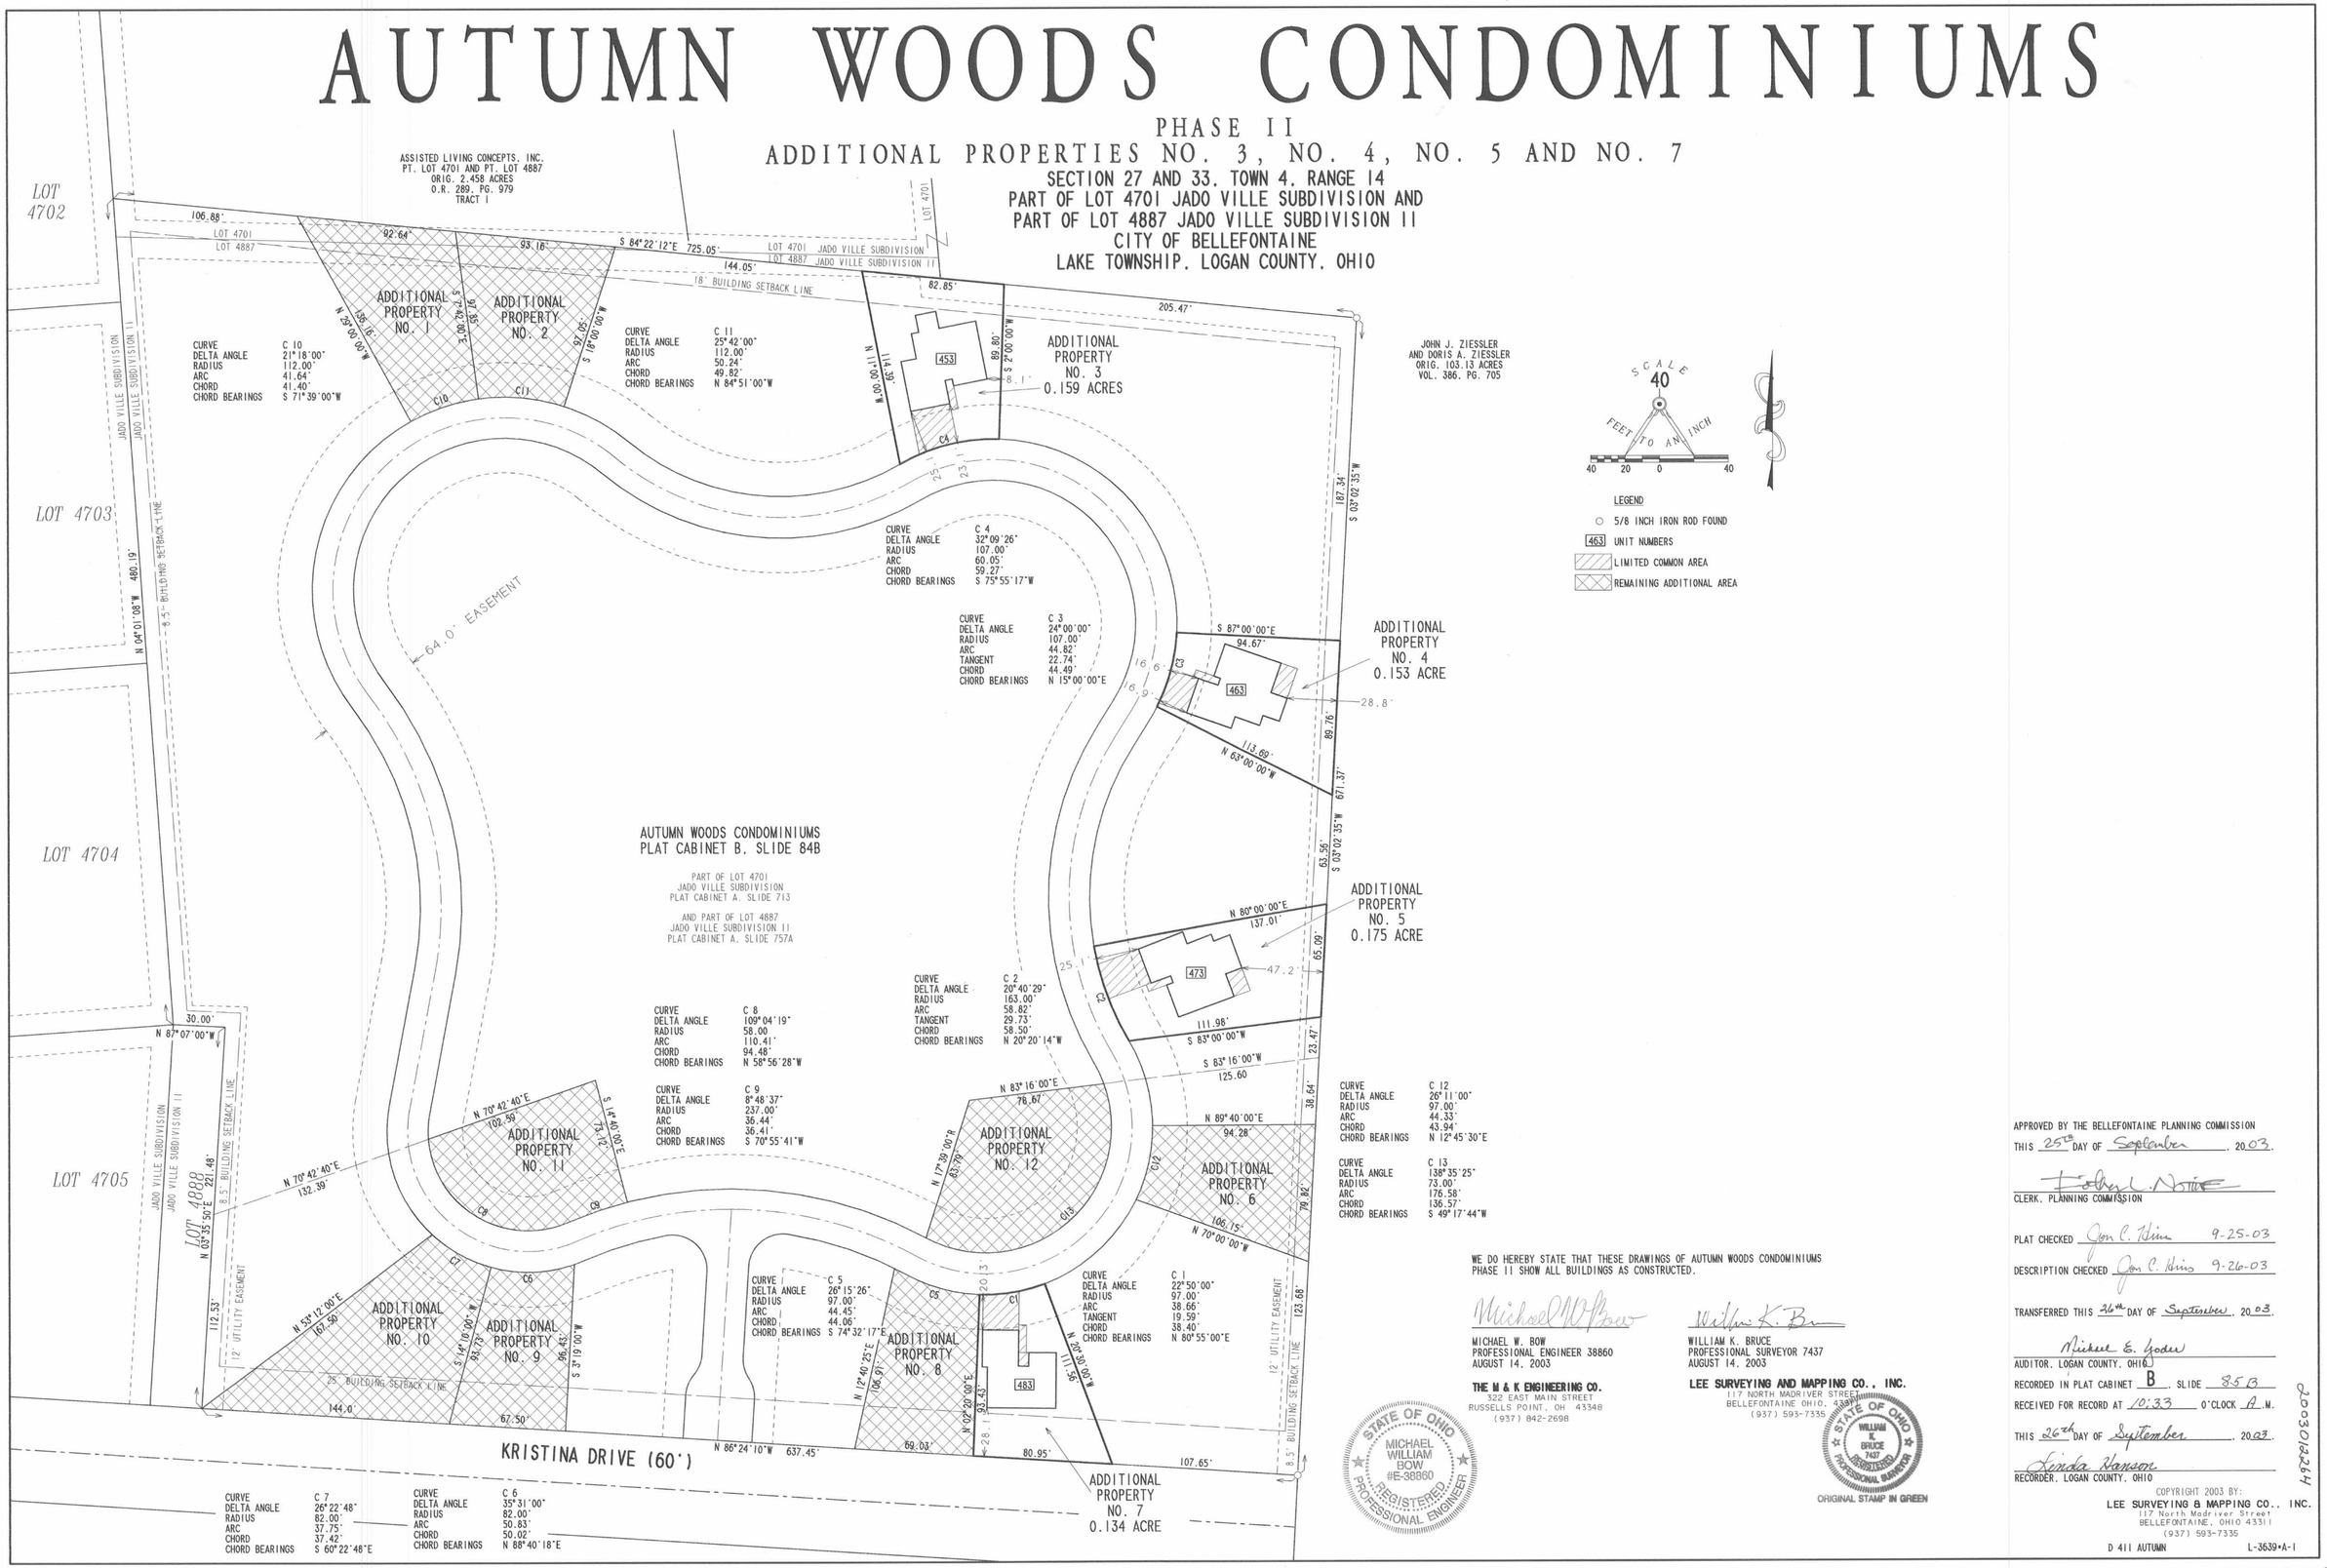

CURVE C 10
DELTA ANGLE 21°18'00"
RADIUS 112.00'
ARC 41.64'
CHORD 41.40'
CHORD BEARINGS S 71°39'00"W

CURVE C 11
DELTA ANGLE 25°42'00"
RADIUS 112.00'
ARC 50.24'
CHORD 49.82'
CHORD BEARINGS N 84°51'00"W

CURVE C 4
DELTA ANGLE 32°09'26"
RADIUS 107.00'
ARC 60.05'
CHORD 59.27'
CHORD BEARINGS S 75°55'17"W

CURVE C 3
DELTA ANGLE 24°00'00"
RADIUS 107.00'
ARC 44.82'
TANGENT 22.74'
CHORD 44.49'
CHORD BEARINGS N 15°00'00"E

CURVE C 2
DELTA ANGLE 20°40'29"
RADIUS 163.00'
ARC 58.82'
TANGENT 29.73'
CHORD 58.50'
CHORD BEARINGS N 20°20'14"W

CURVE C 8
DELTA ANGLE 109°04'19"
RADIUS 58.00'
ARC 110.41'
CHORD 94.48'
CHORD BEARINGS N 58°56'28"W

CURVE C 9
DELTA ANGLE 8°48'37"
RADIUS 237.00'
ARC 36.44'
CHORD 36.41'
CHORD BEARINGS S 70°55'41"W

CURVE C 12
DELTA ANGLE 26°11'00"
RADIUS 97.00'
ARC 44.33'
CHORD 43.94'
CHORD BEARINGS N 12°45'30"E

CURVE C 13
DELTA ANGLE 138°35'25"
RADIUS 73.00'
ARC 176.58'
CHORD 136.57'
CHORD BEARINGS S 49°17'44"W

CURVE C 5
DELTA ANGLE 26°15'26"
RADIUS 97.00'
ARC 44.45'
CHORD 44.06'
CHORD BEARINGS S 74°32'17"E

CURVE C 1
DELTA ANGLE 22°50'00"
RADIUS 97.00'
ARC 38.66'
TANGENT 19.59'
CHORD 38.40'
CHORD BEARINGS N 80°55'00"E

CURVE C 7
DELTA ANGLE 26°22'48"
RADIUS 82.00'
ARC 37.75'
CHORD 37.42'
CHORD BEARINGS S 60°22'48"E

CURVE C 6
DELTA ANGLE 35°31'00"
RADIUS 82.00'
ARC 50.83'
CHORD 50.02'
CHORD BEARINGS N 88°40'18"E

WE DO HEREBY STATE THAT THESE DRAWINGS OF AUTUMN WOODS CONDOMINIUMS PHASE II SHOW ALL BUILDINGS AS CONSTRUCTED.

MICHAEL W. BOW
PROFESSIONAL ENGINEER 38860
AUGUST 14, 2003

THE M & K ENGINEERING CO.
522 EAST MAIN STREET
RUSSELLS POINT, OH 43348
(937) 842-2698

STATE OF OHIO
MICHAEL WILLIAM BOW
#E-38860
REGISTERED PROFESSIONAL ENGINEER

WILLIAM K. BRUCE
PROFESSIONAL SURVEYOR 7437
AUGUST 14, 2003

LEE SURVEYING AND MAPPING CO., INC.
117 NORTH MADRIVER STREET
BELLEFONTAINE OHIO, 43311
(937) 593-7335

STATE OF OHIO
WILLIAM K. BRUCE
7437
REGISTERED PROFESSIONAL SURVEYOR

ORIGINAL STAMP IN GREEN

APPROVED BY THE BELLEFONTAINE PLANNING COMMISSION
THIS 25th DAY OF September, 2003.

Esther L. Norris
CLERK, PLANNING COMMISSION

PLAT CHECKED Jon C. Hiss 9-25-03

DESCRIPTION CHECKED Jon C. Hiss 9-26-03

TRANSFERRED THIS 26th DAY OF September, 2003.

Michael E. Yoder
AUDITOR, LOGAN COUNTY, OHIO

RECORDED IN PLAT CABINET B, SLIDE 85B

RECEIVED FOR RECORD AT 10:33 O'CLOCK A.M.

THIS 26th DAY OF September, 2003.

Linda Hanson
RECORDER, LOGAN COUNTY, OHIO

2003012269H

COPYRIGHT 2003 BY:
LEE SURVEYING & MAPPING CO., INC.
117 North Madriver Street
BELLEFONTAINE, OHIO 43311
(937) 593-7335

D 411 AUTUMN L-3639-A-1

A-153 D