

Denny-Batis Survey

M. S. [unclear] } ch or
 Walter Batis }
 Denny Denny } Wks.
 Milo May }

Begin at stone in road SW^{1/4}
 to Denny 1559. Measured
 with road for Denny
 west line 3342 ch. and
 set stake in center road
 for Denny N^{1/4}

March 20 - 1902

Line A from stake set as above.

Random line


N 82 1/4 E

at 14.58 set stake in line

" 3237

" 4497 1/2 post claimed by Batis as <

(A 7 1/4 N) Elm Stump N 73 1/4 W 37 ch
 (A 5 1/2 S) " " N 94 E 31 "
 Set corner stone at 4496

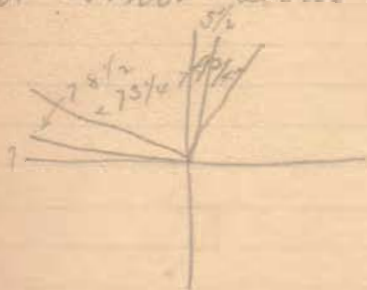

Came out 6.2' too far north
 for < as set.

Line "B"

produced line "A" West
5821 ft

at 8.60 set south 80 lks
run by bearing -

19.00 set north 40 lks

at 20.50 corner stone SMR
Bater came out 48 lks south
of corner stone

$$40 + 48 = 88$$

$$88 - 80 = 8$$

Total southing 8 lks

$$.66 \times 5.28'$$

See calculations back of this book


move stake N.W. to Denny
North 1.7'

$$\begin{array}{r} 6.2 \\ 1.7 \\ \hline 4.5 \end{array}$$

$$\begin{array}{r} \cancel{44.53} \\ \cancel{40.5} \\ \hline 72.00 \\ 58.12 \\ \hline 44.96 \end{array} \quad \begin{array}{r} 60.385 \\ \hline 44.96 \\ \hline 20.425 \end{array} \quad \begin{array}{l} 1.5 \\ \hline \end{array}$$

$$\begin{array}{r} \cancel{32.37} \\ \cancel{40.5} \\ \hline 16.85 \\ 129.48 \\ \hline 44.96 \end{array} \quad \begin{array}{r} 145.665 \\ \hline 134.88 \\ \hline 10.785 \\ 8.992 \end{array} \quad \begin{array}{l} 3.2 \\ \hline \end{array}$$

Adjustment of stakes
on line "A"

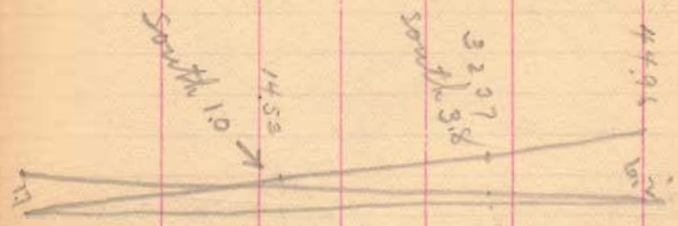

$$\begin{array}{r} 3 \overline{) 6.2} \\ \underline{2.1} \\ 1.1 \\ \underline{1.0} \\ 1.0 \end{array}$$

$$\begin{array}{r} 3 \overline{) 3.4} \\ \underline{1.1} \end{array}$$

$$\begin{array}{r} 4.4 \\ \underline{.6} \\ 3.8 \end{array}$$

$$\begin{array}{r} 32.37 \\ \underline{6.2} \\ 26.17 \\ \underline{6.47} \\ 19.70 \\ \underline{19.42} \\ 44.91 \overline{) 208694} \\ \underline{17984} \\ 20854 \end{array}$$

$$\begin{array}{r} 3 \overline{) 17} \\ \underline{.6} \end{array}$$

Moved stake in road
NW to Drummy 1.7' north
and 3.5' east.

Drummy North line 44.91
" Met " 33.44'

Hit: Drummy NW
Wild cherry, 14" S65 3/4 E 27' loc
Pin oak, 14" S73 1/4 E 44''

May promise to set Barren
corner stone

Hamilton lots Rush Ave

March 22-1902

Set stake in center of ave at
N & E Odor.

30' from stake line of Lot
Fairview, Add. and in
line with iron bar N & E
to Fairview Add. in center
Rush Ave 195.4' from said
bar -

N 38 3/4 E

Set stake at 380'

D.L. 34 min -

N 38 1/2 E

Line B. at 834.4' R.P. split

< to Jeff McAdams -

Jeff McAdams West line
from spike in road
D.R. 89.25' 551' E
362.34'

On Odors east line

S 47' E

385'

set stake

232
 50
 181.6
 383.6

Stake lots on line 30'
 south of center Rust St -
 at west side 50' street
 then each lot 116'

at 101.6 from NW 3d lot
 angle stake 383.6 from west
 line

The 10th or north lot next
 to McAdams is 123.1' on
 30' line -

Turned 90° at 1st line south
 of McAdams at east side
 road from 30' line.

Back end of lot next McAdams
 120.8'

Bearing of back line
 S37 1/2 W

Back line of lot next to
 50' street 144.7'

South line 1st lot -	249.2
" " 2d "	345.4
" " 3d "	342.6
" " 4d "	340.9
" " 5d "	339.2
" " 6d "	338.1
" " 7d "	337.1
" " 8d "	336.2
" " 9d "	334.8
" " 10d "	333.6

O. P. Taylor Survey

Line A^{on} east line Taylor 1000
from S&S at Stone
set west 12'

A. 56

at 22.60 set stakes in 12' line

set < stone at 22.63

1 1/2 north from its location on line
as first run

Jas Polk Huffman } ch. or
O. P. Taylor }

set stone at N&S Taylor

April - 2 - 1902

Line B
from Staylor N&S to Taylor
on his N. line set north 12'

N 20 1/2 W

at 249 app stone in road
sufficed to be Scott's S&S

at 20.00 set stakes in random
line - set this south 16' to true line

at 456 2 1/2 < stone N&S to
Taylor came out 32 1/2 with

32
66
142
142
2 1.12
12
9.12

total northing -

Measured from Hick < true S&S
to Taylor on west 22.28 1/2 to stone
< to S&S.

Corrected Taylor north line
 measured south at stake set
 at 2000 oh 4' south & got
 in 12' line
 ran through on this line setting
 stakes south 12' at frequent
 intervals
 N 86 1/4 W

Corrected this line after
 moving location of N.E. corner
 1 1/2' north

45.62

20

25.62

1.5

128.70

25.62

3673 8430.84

3648

1950

McCormick Survey

Line A
Start from stone in road
292 to Sec.

Set north 12'

390 ft

at 20.14 1/2 stone set to Van Horn

at 40.29 set stakes for dirt and
line

at 52.75 set stake off stone

McCormick NTR

52.75

20.14 1/2

32.60 1/2

at 60.20 stake set by property owner
for line Trimmens and Van Horn
set stake at 60.43 1/2

Moved down stringline pole
to 80.16 set stake found
Nothing

14
April 4-1912

130 : 105 : 320

$$\begin{array}{r} 130 \overline{) 17500} \\ \underline{3200} \\ 3200 \\ \underline{2600} \\ 760 \\ \underline{650} \\ 1100 \end{array}$$

See McCormick / oh or
Jas. R. Smith

Line B

Start from stone 12 1/2 the north of
Taylor fence -

This stone is evidently the corner
set by Mr Moore in 1856

See also on 18" 575 1/2 N 200

(old with: Syc 4" 572 1/2 N also)

189 1/2 N

set north 8' from stone

at 20.00 set stakes in line and dist

on west side M.S.C.J. Ditch also tree
notched claimed by Taylor as line
tree at about 16.00 line was 21'
north of elm.

set stakes for line and dist at 40.00

set south 12' at east side Hampshire
fence

at 60.57 found brick and stone
stone was on top of ground
set stone on top of brick for 1/4
see L

came out 4000 north

$$\begin{array}{r} 66 \\ 40 \\ \hline 2640 \\ 12 \\ \hline 3540 \\ 8 \\ \hline \end{array}$$

3) 30.4 total working -

$$\begin{array}{r} 10.1 \\ 2 \\ \hline \end{array}$$

$$\begin{array}{r} 20.2 \\ 8 \\ \hline \end{array}$$

$$\begin{array}{r} 28.2 \end{array}$$

$$3) 57$$

$$\begin{array}{r} 19 \\ 2 \\ \hline \end{array}$$

$$38$$

at 40.38 set ^{stake} SWR to Taylor and Mr
Timmons set 28.2' South from
line as run.

$$\begin{array}{r} 10.1 \\ 5 \\ \hline 18.1 \end{array}$$

at 20.19 set stake NW to Smith
and Mr Timmons
set south from line 18.1

Line "C"
 on line between South and
 Timmons from stake set
 by self
 51 1/2

at 20.30 set stake in line

at 40.21 line stake on line
 at 12' offset
 came out 54' too far west

$$54 + 4\frac{1}{2} = 58\frac{1}{2}$$

40.21) $\begin{array}{r} 58.5 \\ 20 \\ \hline 1170.0 \end{array}$ | 29
 $\begin{array}{r} 8042 \\ \hline 36580 \\ 36189 \end{array}$

April 22 - 1902

From NW McLeonnick claimed
 west at 7.67 small round stake
 for Smith & Van Horn

$\begin{array}{r} 52.75 \\ 7.67 \\ \hline 60.42 \end{array}$

at 27.40 stake set on former survey
 at dist for Sec. 2

at 47.30 west line of Job Van Horn
 and East line Malachi Taylor in
 Sec. 16.

$\begin{array}{r} 47.30 \\ 7.67 \\ \hline 40.13 \end{array}$

Measured back and at 40.12 came
 out at stake

$\begin{array}{r} 60.42 \\ 40.13 \\ \hline 100.55 \\ 20.11 \end{array}$

$\begin{array}{r} 100.55 \\ 20.14\frac{1}{2} \\ \hline 4)80.40\frac{1}{2} \\ 20.10 \end{array}$

20.14 1/2
20.00
 40.24 1/2
20.10
 60.34 1/2

On M^cConnicks North line
 at 40.24 1/2 set stakes for L
 Trimmom & Smith -
 Set stake in line for NW² M^cConnicks
 at 52.75
 set stake for in line for SW² Smith
 at 60.34 1/2
 at 89 3/4 N

On West line Samp Van Horn
 100 acres
 start from stone SW²
 at 40.27 stone SW² & Taylor
 (Mr. Moon's meas. 160.9 = 40.22 1/2)

R. E. Cunningham } ch. co. sworn
 N. H. Van Horn }

at 50.38 NW² Sampson Van Horn
 20 acre tract found stump of brack.
 Lynn standing stone out.
 at 60.55 center road north of
 Taylor

60.55
40.27
 20.28

width of road 46 lks

On Taylor west line start with
 center of road (width of road 60 lks)
 at 20.08 stake set for Taylor
 SW² set stone.

Bracing of line between Trimmor
& Smith
South -

Hitings < south line between
Smith & Trimmor
Hal. 6" S46E 30 lbs

set stave

Hit: MTR McCormick

Cherry. 6" S3 $\frac{1}{4}$ E 82 lbs
Lynn. 4" S7 $\frac{3}{4}$ E 48 lbs

set down SWR Smith -

40 24 $\frac{1}{2}$

20 14 $\frac{1}{2}$

20.10

18

60 24 $\frac{1}{2}$

40 24 $\frac{1}{2}$

20.10

Henry Fleming Survey

Ed Cox }
John W. Smith } ch or
Stanley Mitchell }
Henry Fleming } Men

Line "A" start of stone in
fide SW $\frac{1}{2}$ Longbrake and
SE $\frac{1}{4}$ to Fleming -
with fide - set stake 15.25'
at 29 $\frac{1}{2}$ '
at 30.51 $\frac{1}{2}$ ' stone in + roads \leftarrow
Shully, Smith, Smith & Hill
Middle S. Line Sec.

set iron bar in fide at 15.25 $\frac{1}{2}$ ' ch
for line Fleming and Smith

April 24 - 1902

see Book C
page 311

Sec. 27 T. 2 R. 8

Line "B"
with middle line of sec.
from stone end of line "A."
at 1 $\frac{1}{2}$ ' ok set at 1 $\frac{1}{2}$ '
at 39.94 $\frac{1}{2}$ ' found old water bucket
stake by measuring 10 lbs from
old red oak stump.
(See Surveyor record of page 214)
ran 8 lines out of corner
set 1 $\frac{1}{2}$ ' gas pipe in place of old
stake -
set stone on top -
dit: Sugar 12" S 14 $\frac{1}{2}$ ' N 119 $\frac{1}{2}$ ' lbs
Walnut 8" N 39 $\frac{1}{2}$ ' E 89 "

495

INDEXED ON MAP

Line "6"

set north 12'

$\# 89 \frac{3}{4}$

set stakes in line as run 12' north
at 15.25

" 20.21 1/2 fence line Lucy Cole
and Dan Ruda,
found corner stone
our line is 33 links north of
stone

53
66
198
198

21.78 feet

12

9.78 northing to first 20 ch

$\# 42$

10.50

20.21 1/2

30.71 1/2

At 30.71 1/2 set stake for distance and
another for line as run -

at 40.25 stone SB $\frac{1}{2}$ to $\frac{1}{2}$ sec 27

came out 69 lbs north of this stone

69
66
41 1/2
41 1/2
40.25

40.25
21.78
23.76

40.25

30.71 1/2

9.54 1/2

Makes Smiths North line of 15.04

across 9.54 1/2

(9.54 1/2 - 9.47 1/2 = 7 lbs surplus)

10.50 x 23.76

20

10.5

11880

23760

20) 249480

1247

21.78

34.25

set corner between Fleming and
Amos Smith at 30.71 1/2 set south
from line as run 34.25 feet
set gas pipe 1 1/2" and stone on top.

With:

double Syc. 36" $\# 72 \frac{1}{2}$ at 48 lbs

Syc 24" $\# 39 \frac{1}{2}$ 127 lbs

495

INDEXED ON MAP

Set corner in north line between
Flanning and J.W. Smith

$$\begin{array}{r} 2) 30.71\frac{1}{2} \\ \underline{15.36} \end{array}$$

at 15.36 set corner

$$\begin{array}{r} 15.36 \\ 2921 \end{array} \times 9.78$$

$$\begin{array}{r} 15.36 \\ \underline{9.78} \end{array}$$

$$7.43 + 12 = 19.43$$

$$\begin{array}{r} 12.288 \\ 10.752 \\ 13.824 \\ \hline 202) 15022.08 \end{array} \quad \begin{array}{r} 7.43 \\ \hline 14.147 \\ \hline 87.50 \\ \hline 80.64 \\ \hline 6.660 \end{array}$$

Measure south from line as run
19.43'

Dist: Locust 12' N 67 $\frac{1}{4}$ E 50% Ula
Brooks 14' S 48 $\frac{1}{2}$ E 43 ..

22
On East line Flanning
Set east 18'
S 1/2 E

Set stake at 10.00

" " " 15.87

" " " 21.00

" " " 26.00

At 40.17 $\frac{1}{2}$ corner stone in
pile and beginning < this
Survey.

$$\begin{array}{r} 15.87 \\ 24.13 \\ \hline 40.00 \end{array} \quad \begin{array}{r} 5) 17\frac{1}{2} \\ \underline{3\frac{1}{2}} \\ 2 \\ \hline 7\frac{1}{2} \end{array} \quad \begin{array}{r} 15.87 \\ \underline{7} \\ 15.94 \end{array}$$

$$\begin{array}{r} 40.17\frac{1}{2} \\ 15.94 \\ \hline 24.23\frac{1}{2} \end{array}$$

Hoolman & Knight Add.

Columbus Ave -
Logan St. Iron bar

Spring Hill North " "

St. Paris North " "
St. ← Stone foundation remaining
58'10"

Prince post St. Co., lot NW 59'2"

Troy Iron bar
Fence post N. 29' 7/2"
" " NE 4' 7/4"

Sandusky St +
Logan Iron bar

Spring Hill Iron bar

St. Paris - Iron bar
Top corner Hyd. N.E. 33'6"
St. ← stone found. N.W. 61'10"

Troy Iron bar
Apple trees east of north 81.8'
" " north of east 67'

25
Hoolman & Knight Add -

Traced line between
Hannay factory property
and Bellefontaine Stone and
Lime Co's property.

found iron bar center St. Paul
St and north line Add.

found iron bar 196.35 dist
another corner.

found iron bar 181.5 dist.
another corner.

deflected 68° measured 198'
set bar for corner.

deflected 22° to right 108.9
Hoolman and Knight plat
shows 11° deflection.

Old deeds show 22° -
set bar in hole drilled
in ledge of stone

April 14 - 1902

On north line Add -
found iron bar center
west alley -
found stake east line
Logan St. produced this
line east 58.5 feet and
set iron bar corner
from this measured to bar
1.5 ft in ledge of stone
144.8'

See Book C
Page 318

503
INDEXED ON MAP

Line for Ida Cowman

Mad River & Chil. +	
Hyd Ser.	28.85
Lamp post SM.	29.85

Mad River & Aub. +	
Hyd Ser.	36' 10"
Lamp post SM.	29' 1"

Main to Mad River on Aub.
S. side 523.6'

Main to Mad River on Chil.
525.15

May 2 - 1902

77

526.5	526.5
523.6	523.6
<u>2.9</u>	<u>1.35</u>

2.9		
1.35		
<u>557</u>	<u>1.5508</u>	<u>.00208</u>
		<u>.06240</u>

525.15	525.15
.06	.06
<u>525.09</u>	<u>525.09</u>
dist. S. line Chil.	dist. S. line Chil.

525.15	525.15
.52	.52
<u>524.63</u>	<u>524.63</u>
dist. N. line Alby.	dist. N. line Alby.

526.5	526.5
525.09	525.09
<u>1.41</u>	<u>1.41</u>
8)	.176

526.5	526.5
524.63	524.63
<u>1.87</u>	<u>1.87</u>
8)	.23

Ida Cowman Dewey

On South line sidewalk S. side hill
from Mad River Cut to Main Cut

485.08	
25	40
15	
<hr/>	
525.08	

On North line alley between Old
Club -

484.30
<hr/>
40.
524.30

Murphy Farm

Line A

Start in center Main Street Dr. Staff
Hunted for iron bar - bar out 10'
found stone 6" to 1' far south
set harrow tooth at proper position
6" north of stone

set north 10'

385/4E

Murphy

at 19.57 stone set

See Book C

Pg 317

May 3 - 1902 -

Jas. Murphy } ch. cr.
John Murphy }
Oscar Murphy } Meter

Line B.

with east line

174/4E

at 19.75 wire fence S. side
Cemetery -

set stakes in line wire fence
8 ch west from center of gravel
in field for MR Fitzgerald

Line "C"

with south line of Cemetery
N 85 1/4 Wat 4.86 to corner post of
Cemetery.

Line "D"

with west line of Cemetery
N 5 1/2 E (110' from wire fence)at 6.23 corner post NW
Cemetery.

Line "E"

with north line Cemetery.
S 85 Eat 12.85 1/2 set stake in center
of gravel on fence and in line
St. James Cemetery.

Line "F"

with center of fence

N 5 E

at 11.27 set stake for N & L
Murphy farm
set iron bar

1501

INDEXED ON MAP

Line "5"

South line Gilchrist 4 1/2 acres

N 86 1/4 W

at 14.91 1/2 set stake

Hit: N.O. 28" N 19 W 2 lbs

came out 5 3/4' north

O.K. length 14.94 1/2

Line "7"

N 5 E

at 3.10 1/2 stone

Hit: Cottonwood 10' N 88 W 88 1/2 lbs

Med cherry 12' S 55 1/4 W 55 lbs

Line "9"

with north line Murphy.
set north 6'

N 86 1/4 W

at 25.73 1/2 stake east side pipe

" 2608 " west "

" 25.90 1/2 center pipe -

" 51.75 - stake on bank of

Gr. Mann River

found old stake came out
5' north of old stake

51.75

25.90 1/2

25.84 1/2

1506

INDEXED ON MAP

May 9. 1902

Line J.

With south line from
set 120' north from spike in
center Main St. Dr. Druff
run to 120' north from north
eye of double eye on bank
Main River

A 85 1/2 ft
34.58

Murphy Survey -

Line "K"
with River (intended to be parallel to river)
A 7 E
(13.46 - 46 lbs from Water's edge)
at 14.67 set stake 52 lbs from Water's edge

This line was run from 25 lbs east
of eye. tree making length of "J"
for calculation 34.33

Line L.
A 4 ft
at 3.55 set stake
(46 lbs from water's edge)

(1501)

INDEXED ON MAP

Line "M"

At 9 1/4

set stake at 4' 1.67 ^{sh} from water

" " " 8' 2.26

" " " 12' 2.85

" " " 16' 3.44

Measure west 2' at 16' and set stake

at 20' - 2.26 from water (25 lbs)

set stake in line as running 2' west from orig line

Line K

At 2 1/4 (corrected for the 2' 0" west 1/125)

at 2.08 N. line of farm

25 lbs east of corner stake

Hit to < stake on river bank

Ash 6" S 25 1/2 E 18 lbs

Double-budger 18" N 46 1/2 E 45 1/2 lbs

Line "O"

with center of fence and Main St. De Graff from iron bar.

At 25 1/2 ft

at 26.93 set square iron bar with ash 16" S 59 3/4 E 28 1/2 lbs

Line "P" with center of fence

At 6 1/2

16.49

set square iron bar in center of fence in north line of farm 6' south of stakes set in line "D" at 26.90 1/2 of line "D"

1501

Line "Q"

dug out & stone in pile 58 &
Sedgewood cemetery found
large stone in about 2 1/2' below
surface of pile with rough cross
on top. I set large polished
granite boulder on top of
this stone bringing top about
6" below top of gravel on pile.

Found stone at + road and
1/4 Sec. <
SSR

ran line between stones
measured from last stone
22.79 for < Gilchrist tract

3 links east of former stake
set for end of line "F"

set iron bar N & S Murphy
farm

(150)

July 15 - 1902 -

Surveyed 42.83 acres off of
the north end of the west part
of the Murphy Vfer for Oscar
Murphy -

Line A:

Start at iron box in Loganville
take end of line "O" orig Survey

S 28 1/2 E 113 links set iron

bar

N 41 Ash 16" S 84 1/2 E 30 1/2 links.

34

Line "B"

Dividing line -

N 86 1/4 E

~~set stake in line at 11.00~~

pass Ash 16" in line at 22.75

at 44.18 set stake on bank

of Miami River -

N 41 Elm 36" N 27 E 48 links

Double Maple 36 S 55 1/2 E 44

set stake in line for half of fence

at 12.09

1501

INDEXED ON MAP

Goss Survey May 22

1902.

37

William E. Petty } ch cr -
John Organ }

Line "A."

Start from stone < to Ditby
A. Seaman in west side
ground on lot 1 & 2. pit -
said stone is 11 links from
big Elm stub -
up to stone off old brick house
(Paul Sampford's) 126 1/2 ft
17.37 1/2 stone at brick house
(at 5.00 1/2 stone hole to
Levi Seaman's 4 acre
pass 2" east of stone)

(from set Da Seaman to this stone
5 + 17.37 1/2 = 22.37 1/2 = 89 1/2 rods)

$$17.37 \frac{1}{2} - 5.00 \frac{1}{2} = 12.37$$

Line "B"

from stone end line A.

17.39 ft

at 24.14 1/2 ft. line Goss

Dug for < in pit found nothing
set stake -

set stone

1st eye 6" S 43 ft 196 1/2 lbs

Eye 30" N 53 1/2 ft 199 1/2 "

Line "C"

with north line Eoss
from stake in pipe set north 4'
~~500 ft~~ O.K. cor S 40° W
at 18.75 (75 rods) set stake in this
line

set stake in line of old fence
35 links south of line as run -
set stone Total walking 29 links
Nite: Blk Walnut 24" S 40° W 14 links



Line "D"

S 38° E 56 1/2 links (2 1/2 rods)
set stone

Nite: Blk Wal 24" N 55° W 55 links

Line "E"

set north 8'

~~555 ft~~ O.K. cor S 55° W
1457

set stone at place described by
John D. Sharp a resident
for 63 years

came out 5' north -
S 55° W 3'

Line "D"
with west line "E" set west 8'
S 32 3/4 E
37.59 cor post

set stake at 37.75 in line of
fence - west line of E -
corner cut 4 ft. West Total casting 3 1/2'
set stone from stone 3" x 6" x 18"
with + on top.

Line B. from stake end of line
"D"

N 63 1/4 E
at 14.75 set stake in north side
of road grade
at 15.05
corner cut 20 links north of
stone set by myself for
S 82 3/4 E 3680
O.K. cor. N 64 1/2 E

Line H
from stake set end of
to Scamans SW 2
N 56 1/4 E
9.

from stone set for S 64 1/2 E 3680
to Scamans SW 2
N 57 1/2 E 9.29 to stone
ran 2' too far north
O.K. cor. N 57 1/2 E

May 27. 1962

Measured from stone SE <
Jordans 16 1/2 acre tract
19 ch - (76 rods) set stake
on south side Hannis fence

Measured from stone SW <
Jordans 16 1/2 acres
at 1895 (75.8 poles)
dug for < did not find anything
set stake and measured east on
fence
8.37 1/2 33.5 rods

dug hole for < stone SE < 3650
found nothing set stone line
stone on top of another limestone

Mix: Mild cherry 3" N 71 3/4 W 62 1/2
Walnut 1" N 68 1/4 W 62 W
(5' from center of gravel on fence
south)

Line N. ran from big stone
near sugar shed on Wallace S line survey
at 1345
big stone in line Wallace and
Miller and S line survey
set south 6'
N 61 E
at 49.28 fence west line
Pound Huffman 1 1/4
came out 58 links south
of stake set for end of line
1 1/2"
58.9 = 49 ch south

Line "D"
with west line Seaman
compass 2' east of wire fence

N 26 W [?] 1001
came out 2 1/2' east of corner post
set for 2'

Line "G" with north line of
Seaman to stone at 5.00% of
line "D" N 58 W Levi Seaman
8.00 1/2

Survey of W $\frac{1}{2}$ of lot 76 and

Found stone + Miami + South St
said to have been set by Pratt =
measured west

$$\frac{57.8''}{2} = 28.875$$

$$66 \times 4 = 264$$

Alley

$$\frac{292.575}{16.5} \text{ E. line Alley}$$

$$\frac{309.375}{264} \text{ H. " "}$$

$$264$$

$$\frac{573.375}{57.75} \text{ S. " Canby St.}$$

$$57.75 \text{ H. " "}$$

This last line came out with
fence line.

Mills East line =

$$\text{No. 74} = 66$$

$$\text{" 75} = 66$$

$$\text{" 76-}\frac{1}{2} = 33$$

$$\text{Street} = \frac{28.875}{193.875}$$

$$193.875$$

E $\frac{1}{2}$ of lot 77 for J.E. Mills
Survey of May 29-1902

Hit stone +

Miami + New St

$$\text{Maple } 10'' \text{ SE. } 28.8'$$

$$\text{" } 10'' \text{ SW } 29.8'$$

$$\text{Cor from building NW } 39.7'$$

$$\text{" Brick " NE } 52.9'$$

On Alley line south of South St
 measured from center line of
 Miami Street - giving street
 lots and alley proper width from
 west line of cross alley as measured
 to Canby Street east line as found
 266.7

The west line of alley falls 3'4"
 west of corner beam on lot No. 78.
 The east line of alley corners 4'
 west of corner of stable on lot 77.
 Building on Miami St at
 alley is 3'2" in street.

Survey of School property

Line "A"

Start with center line of Main St. as marked by iron bars on plat of Coupler's Add.

set stake in line Lake Avenue and in S.W.M. Melrose South line.

Bearing Main St.
N 29° 41' W

Lake View June 2-1902
Lake View Plat.

Iron bar center Main St and opposite south line Lot 30.

Coupler's Add.

NW 1/2 SW 1/4 house north side alley & east side Main St. 28.6'

NR 1/2 house south side alley & east side Main St. 31.2'

Iron bar center Main St and opposite N. line Alley North side Coupler's Add.

NW 1/4 Township house < strip 48.8'
SW 1/4 John Bellamy's house foundation 49.5'

Line "B"

With center of Lake Cochran.
Museum from center of Main
St. 396' (24 rods) ✓
set iron bar for MK school
property at 177.375 set iron
bar for MK same.
177.375 = 10³/₄ rods.
ran line of street from
center between street inlets
at Sandin and center of
pike west of Corporation V.
N 89 1/2° E ✓

Divided the school lot in 3 equal
parts 59.125 ft front to each.
set iron bars pt. E of each lot
in center Lake Cochran

Hit bar N 89° E Cox lot (unch)
corner Strip N 89° E tower U.B. stand
34.1
Ash tree in Lorton's lot No. 72.1

48.8
46
Hit bar N 89° E Cox (unch) lot
Ash tree Lorton's lot north
48.8
Maple 6" S.E. near street line 67.4

Hit: Bar N 89° E middle of
Memorial Board (Babcock)
Maple 6" south 27.7
Maple 4" north 22.1

Hit: Bar N 89° E Longbridge
corner MK school lot.
Maple 5 1/2" 62.8
5" S.N. east of H.S.H. 74.6

Line "c"

with east line School lot.
Measured 247.5 (15 rods) south
set pin.

Measured from center Main St
on south line McMillen 296"
(24 rods)
set iron bar for S&E

Measured west 177.375 dividing
it into 3 equal parts. 59.125 each

Measured on west line of lot
247.5 (15 rods) set iron bar
bearing west line S 2 1/4 E

set iron bars at south corners of
the 3 lots.

East lot D. W. Longbrake
Middle is Babcock Memorial School
West . Elmer Cox

Sunny Cory's line.

Main x High (south) Iron bar
 S.E. < Lawrence's stone wall 39.8'
 Lamp post S.E. 35.1'

Main x Williams Iron bar
 Hydr. N.E. 32.2'
 N.E. < E. coping Arch culvert 46.33'
 N.W. " " " " 48.25'

Mad River x Williams Stone
 Hydr. N.W. 53.2' Elm east 28.9'

Mad River x High (south) Iron bar
 Lamp post N.W. 129.5'
 Hydr. S.W. 27'

Main St Distances
 Williams to High St. 506.7'
 High St. to High S. 132'
 638.7'

Mad River Distances

Main St -

On Mad River Williams to High S -

Lt 1160 -	65'
di Horn	30
Tremain	103
Turner	52
Rice	52
Ally	16 1/2
Raukuberg	79
Bates	40
Pool	42
Chauffeur	104
	<hr/>
	583 1/2
Williams	31
High	35'
	<hr/>
	638 1/2

On Main east side from High -

Cruta to curb -	13'
S. end James canal walk	88.6 - 12 = 76.6
division of walk to line Stanton	218.5 - 88.6 = 129.9
N. line Godre Hall	293.3 - 218.5 = 74.8
S. line curb William	612.6

612.6	640.6
28	637.7
<hr/> 640.6	
	2.9
	1.5
	<hr/> 1.4

Crut Main to Mad R.	493.4
35	
<hr/> 458.5	
456.2	
<hr/> 2.3	

On Mad River - William to High 612.6

On High Mad R. to Main	493.4
35	
<hr/> 458.5	
456.2	
<hr/> 1.9	

14

N. line Old Stanton property
206.5' north from N. line High St -

S. line William Ave from N. line High	585.6
By plat	582.7
<hr/> Surplus -	2.9

from N. line Stanton property	
to S. line William 585.6 - 206.5 = 379.1	
By plat	377.7
<hr/> Surplus	1.4

Surplus per 100' = .37
" for Godre lot - 75' = .24
" " Cory " 50 = .18
<hr/> 42

from cruta High North -	
N. line Stanton prop.	231.5
Godre	75.24
S. line Cory	306.74
N. " "	50.18
<hr/> 356.12	

Survey for Ed. Cory & John

Reynolds Aug 14 - 1902

Set south 4' from stone S8 &
 Enclosed Reameters -
 S85 1/2 E

- Set hub at 851 1/2'
 - at 878 line Smith & Cory
 - " 912 set stake -
 - " 1776 1/2 stake on west bank Ry
 - " 1770 west Ry fence
 - " 1813 center Ry
 - " 1866 east Ry fence
 - " 2320 stake in line
 - " 2681 corner from S8 & 1/4 Sec
- corner out 18 1/2 north -
 total nothing 4 + 18 1/2 = 22 1/2
 at 1576 1/2 stake top of hill
 " 1168 line Reynolds & Cory

OK. Bearing
 S 85 1/2 E



2390 = 1947 - 4 = 1547
 1777 = 1491 - 4 = 1091
 912 = 765 - 4 = 265
 858 = 714 - 4 = 310
 1576 1/2 = 1323 - 4 = 923

2681
 1866
 27815
 407 1/2

1770
 878
 2) 892
 446

1770
 446
 1324

1790
 602
 1168

1576 1/2
 1324
 252 1/2

1168
 878
 290