Childrens Home
Harrison Twp

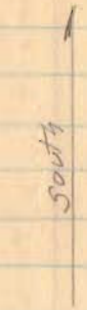

S.H. 234
Route 47

614+02.8
Ahead

Road 32

Nov. 30, 1934
Warren
Co. Wing 43
Eng. Corp.

scc 40 ft
18. for
House

INDEXED ON MAP

1580

500

S.S.-Jc Hy.

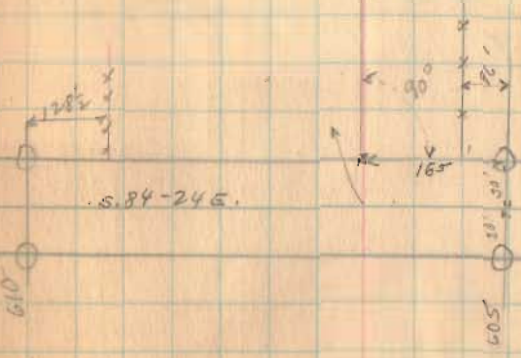

Scc Plan
L-20
Page 11

Children's Home

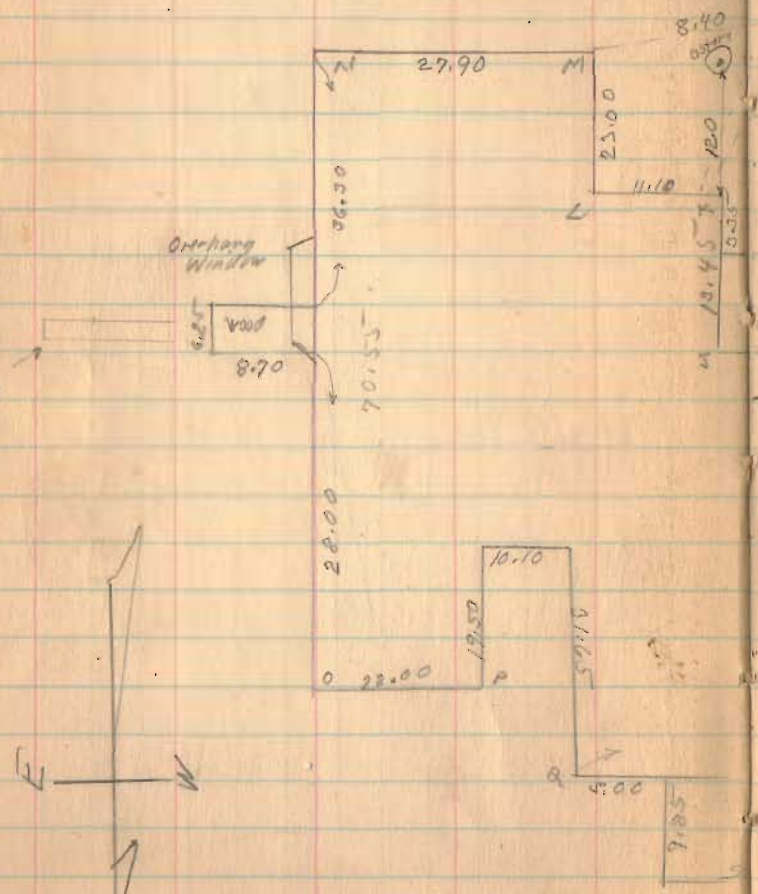
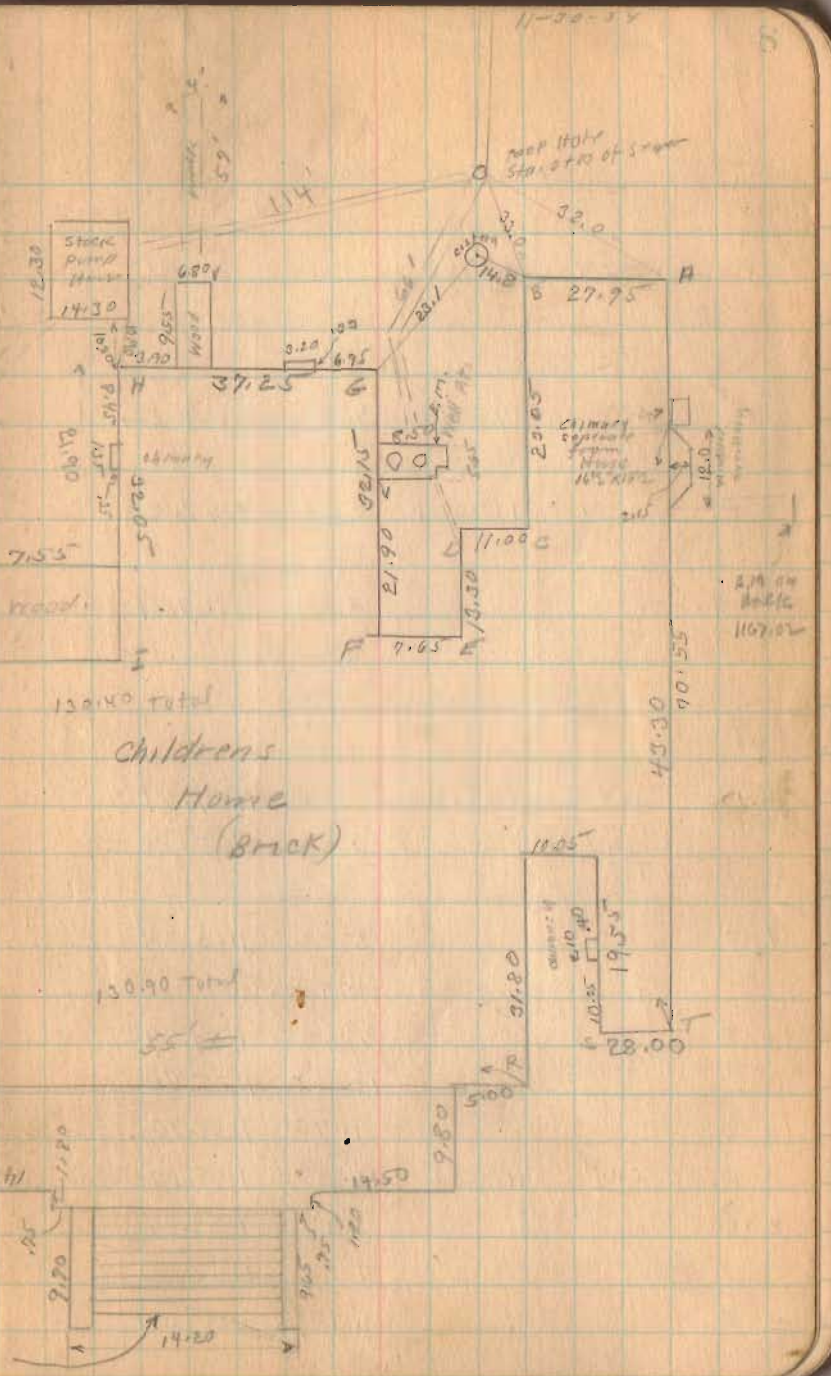
B.M. on hydrant 1167.84