Nov. 9th 83

Mr. Kinnon Hullinger Denman

Denman N line Mr. K = N 80 3/4 E

" of pike S 52 1/4 E

" line between Bickham & Windham N 88 1/2 W

or Letter N 8 1/2 W

Line A. Start at cent pike N line Mr. Kinnon ∠a S 80 3/4 W 2.74 chains = 10.96 ft to ∠ Mr. K + Hullinger in west survey lines

Denman & Denny line - N line Mr. K = N 9 1/2 W

Line B. Start at ∠ a Mr. K + Hullinger in west survey line, thence 39 1/2 E 17 poles to S N ∠ of 2 a sold to H by Mr. K. = ∠ c

Wit ∠ c = Elm 16" N 9 1/2 E 52 links
also Elm 18" N 88 1/2 E 68 1/4 links

Line C start cent pike N E ∠ 2 acres thence with cent of pike S 52 1/2 E 20.16 poles to S E ∠ 2 a cals. = ∠ d

wit ∠ d.

Line d start at ∠ c N 80 3/4 to 6.67 ch = 264 links to ∠ d in pike.

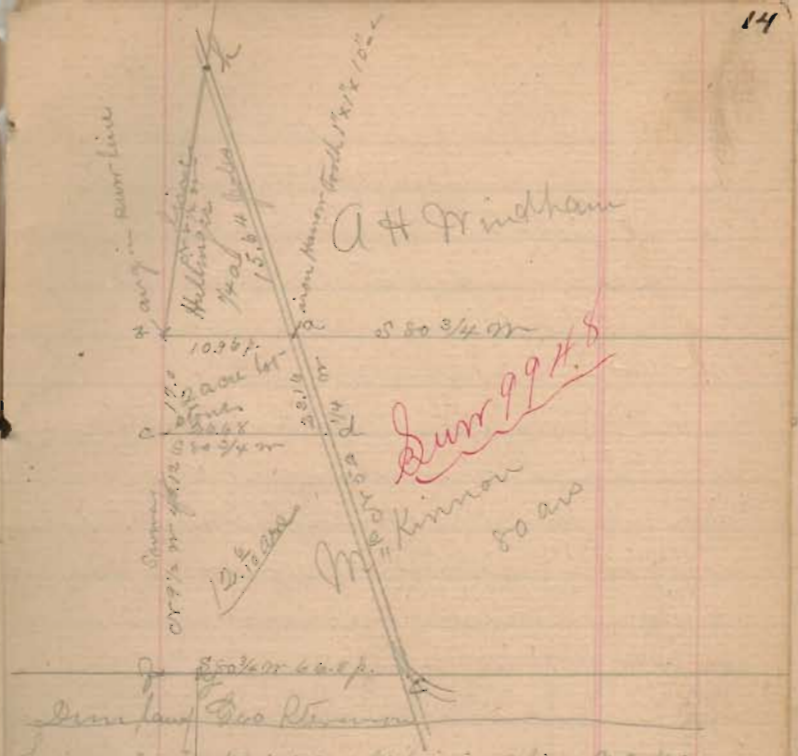

Denman land Due Kinnon

Line E start at ∠ e which is in S line Mr. Kinnon and center line of pike produced south, S 80 3/4 W 16.90 chains = 66 80 to ∠ f = S W ∠ Mr. K.

Line F start at ∠ f thence with sum line N 9 1/2 W 10.78 chains = 43.12 poles to ∠ e.

Line G. Start at ∠ a thence with pike N 52 1/4 W 3.91 chains = 15 64 poles to ∠ h