J-13

Field Notes.

A wooden stake driven at each point marked •

An Iron bar is " " " " " ⊙

Angles bac = 20°-45' cad = 5°-57' def = 22°-26'

Lots 5 to 13 inclusive, extend from Ottie's Lane to shore line

The north line of Lot 26 is on the Survey Line

Harding Road is 40 feet wide. Other roads are of various widths as shown on plat

All dimensions given in feet to nearest 1/10 foot

Central Angle 27°37' Radii as shown on plat

From end of regular arc, in S. line of Lot 4 to the S.E corner Lot 2. is an irregular curve, not located by transit.

Lots in Survey 13393 contain 9/10 of an Acre

" " " 9968 " 2 82/100 acres

Parks, Lanes or Roads are not estimated in acres shown above

Lanes or Road intersections are marked by a wooden hub 1½ N 1½ X 16" driven ½ down to ground level.

Other lot corners are marked by a ⅞" X 2" X 24" Wooden Stake driven 12" into the ground.

Witnesses to iron bar 30" long top 1¼" with thread, at the N.W. Corner of Lot 32, Sugar 18" di N 63½ W 33.2' Red Elm 10"

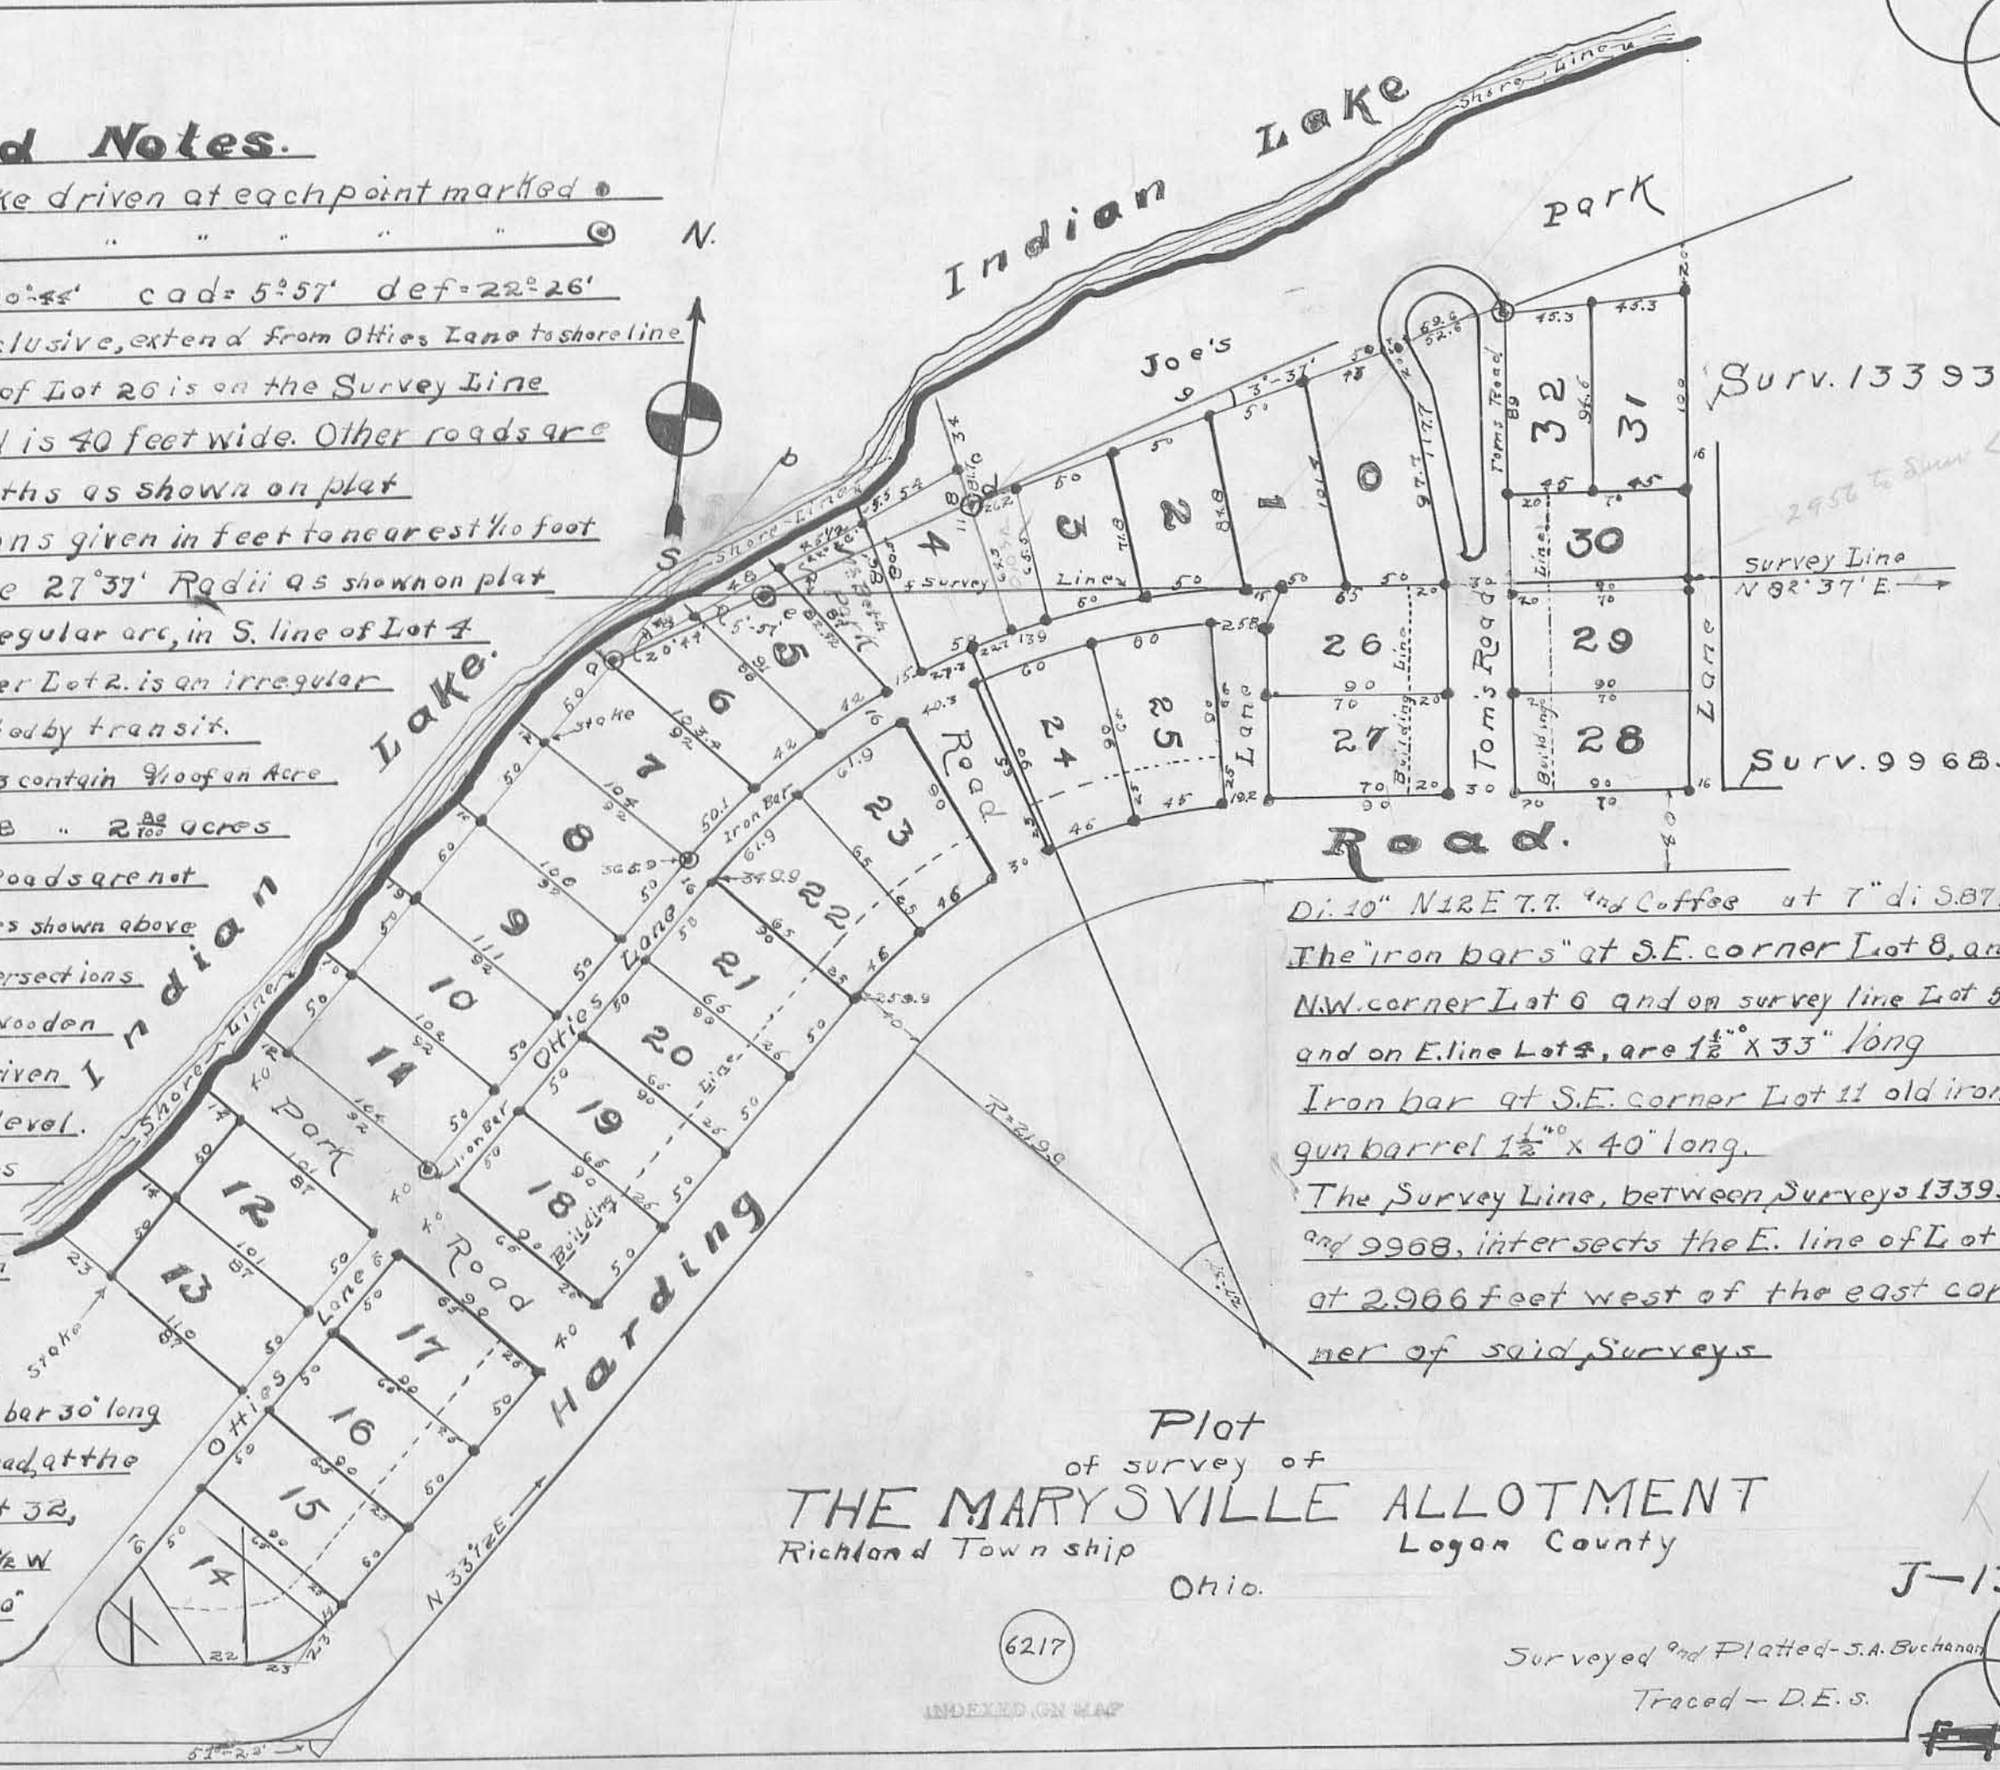

Di. 10" N 12 E 7.7. and Coffee at 7" di S. 87 E 9.2

The "iron bars" at S.E. corner Lot 8, and N.W. corner Lot 6 and on survey line Lot 5, and on E. line Lot 4, are 1½" x 33" long

Iron bar at S.E. corner Lot 11 old iron gun barrel 1½" x 40" long.

The Survey Line, between Surveys 13393 and 9968, intersects the E. line of Lot 30, at 2.966 feet west of the east corner of said Surveys

Plat
of survey of
THE MARYSVILLE ALLOTMENT
Richland Township Logan County
Ohio.

J-13

(6217)

Surveyed and Platted - S.A. Buchanan
Traced — D.E.S.

INDEXED ON MAP