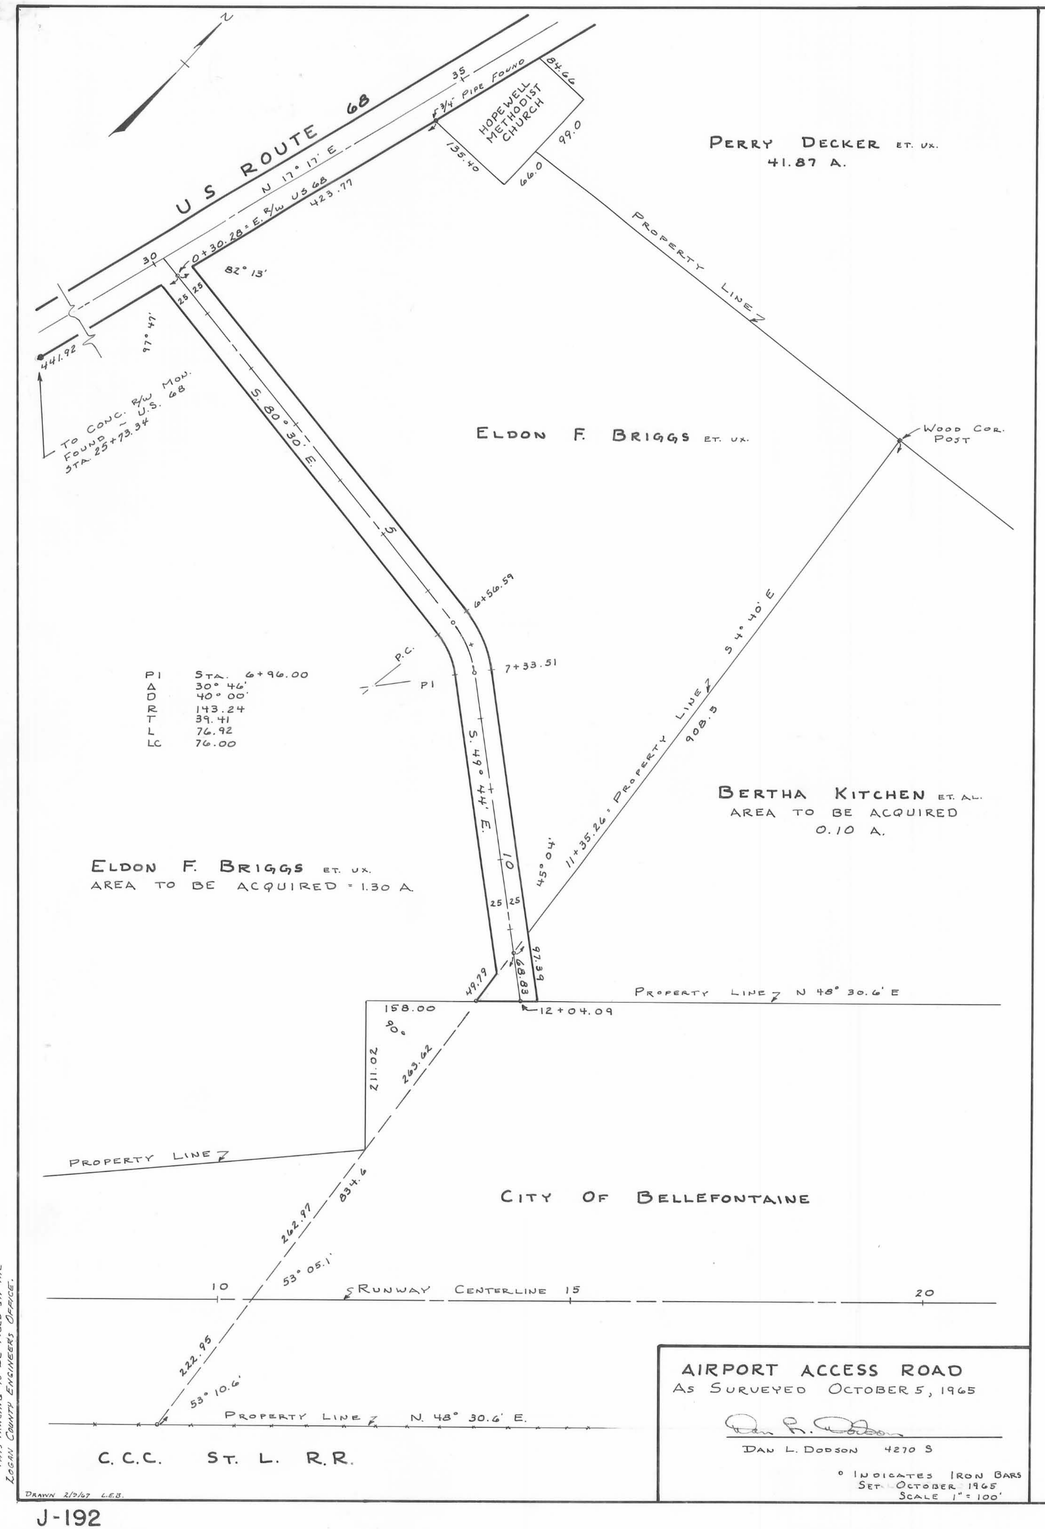

AIRPORT ACCESS ROAD
As Surveyed October 5, 1965

Dan L. Dodson

DAN L. DODSON 4270 S

° INDICATES IRON BARS SET OCTOBER 1965
SCALE 1" = 100'

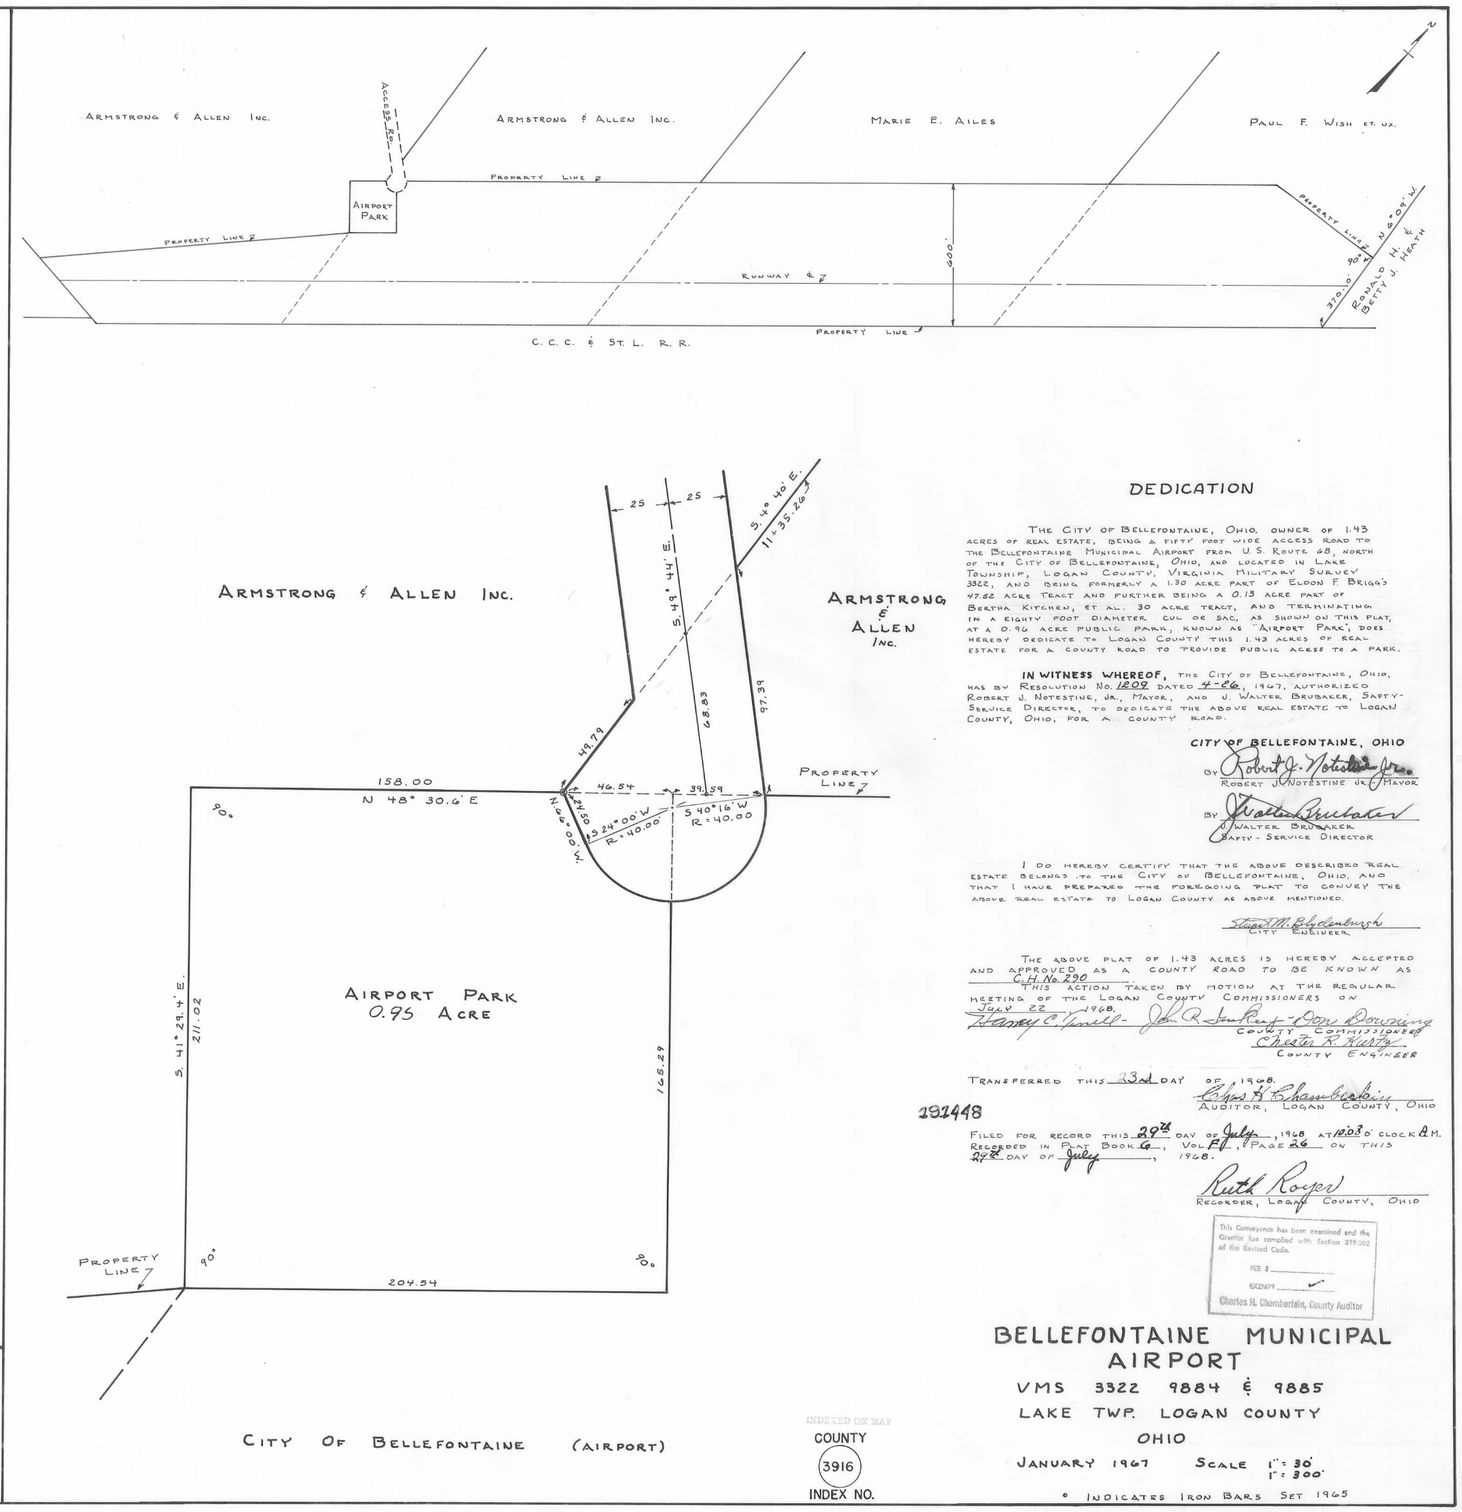

DEDICATION

THE CITY OF BELLEFONTAINE, OHIO, OWNER OF 1.43 ACRES OF REAL ESTATE, BEING A FIFTY FOOT WIDE ACCESS ROAD TO THE BELLEFONTAINE MUNICIPAL AIRPORT FROM U.S. ROUTE 68, NORTH OF THE CITY OF BELLEFONTAINE, OHIO, AND LOCATED IN LAKE TOWNSHIP, LOGAN COUNTY, VIRGINIA MILITARY SURVEY 3822, AND BEING FORMERLY A 1.30 ACRE PART OF ELDON F. BRIGGS' 47.82 ACRE TRACT AND FURTHER BEING A 0.13 ACRE PART OF BERTHA KITCHEN, ET AL. 30 ACRE TRACT, AND TERMINATING IN A EIGHTY FOOT DIAMETER CUL DE SAC, AS SHOWN ON THIS PLAT, AT A 0.96 ACRE PUBLIC PARK, KNOWN AS "AIRPORT PARK", DOES HEREBY DEDICATE TO LOGAN COUNTY THIS 1.43 ACRES OF REAL ESTATE FOR A COUNTY ROAD TO PROVIDE PUBLIC ACCESS TO A PARK.

IN WITNESS WHEREOF, THE CITY OF BELLEFONTAINE, OHIO, HAS BY RESOLUTION NO. 1209 DATED 4-26, 1967, AUTHORIZED ROBERT J. NOTESTINE, JR., MAYOR, AND J. WALTER BRUBAKER, SAFTY-SERVICE DIRECTOR, TO DEDICATE THE ABOVE REAL ESTATE TO LOGAN COUNTY, OHIO, FOR A COUNTY ROAD.

CITY OF BELLEFONTAINE, OHIO

BY Robert J. Notestine Jr.
ROBERT J. NOTESTINE JR. MAYOR

BY J. Walter Brubaker
J. WALTER BRUBAKER
SAFTY - SERVICE DIRECTOR

I DO HEREBY CERTIFY THAT THE ABOVE DESCRIBED REAL ESTATE BELONGS TO THE CITY OF BELLEFONTAINE, OHIO, AND THAT I HAVE PREPARED THE FOREGOING PLAT TO CONVEY THE ABOVE REAL ESTATE TO LOGAN COUNTY AS ABOVE MENTIONED.

Stuart M. Blydenburgh
CITY ENGINEER

THE ABOVE PLAT OF 1.43 ACRES IS HEREBY ACCEPTED AND APPROVED AS A COUNTY ROAD TO BE KNOWN AS C.H. No. 230 THIS ACTION TAKEN BY MOTION AT THE REGULAR MEETING OF THE LOGAN COUNTY COMMISSIONERS ON July 22, 1968.

Harvey C. Snell — John R. Van Reet — Don Downing
COUNTY COMMISSIONERS

Charles A. Kurtz
COUNTY ENGINEER

TRANSFERRED THIS 23rd DAY OF, 1968.

Charles H. Chamberlain
AUDITOR, LOGAN COUNTY, OHIO

191448

FILED FOR RECORD THIS 29th DAY OF July, 1968 AT 10:03 O' CLOCK A.M. RECORDED IN PLAT BOOK G, VOL. 1, PAGE 26 ON THIS 29th DAY OF July, 1968.

Ruth Roper
RECORDER, LOGAN COUNTY, OHIO

This Conveyance has been examined and the Grantor has complied with Section 319.202 of the Revised Code.
FEE $ ____
RECEIPT ____
Charles H. Chamberlain, County Auditor

BELLEFONTAINE MUNICIPAL AIRPORT

VMS 3322 9884 & 9885

LAKE TWP. LOGAN COUNTY

OHIO

JANUARY 1967 SCALE 1" = 30' / 1" = 300'

° INDICATES IRON BARS SET 1965

INDEXED ON MAP
COUNTY 3916
INDEX NO.

J-192

J-192