



BATHROOM ACCESSORY SCHEDULE FOR 2-BR. UNIT

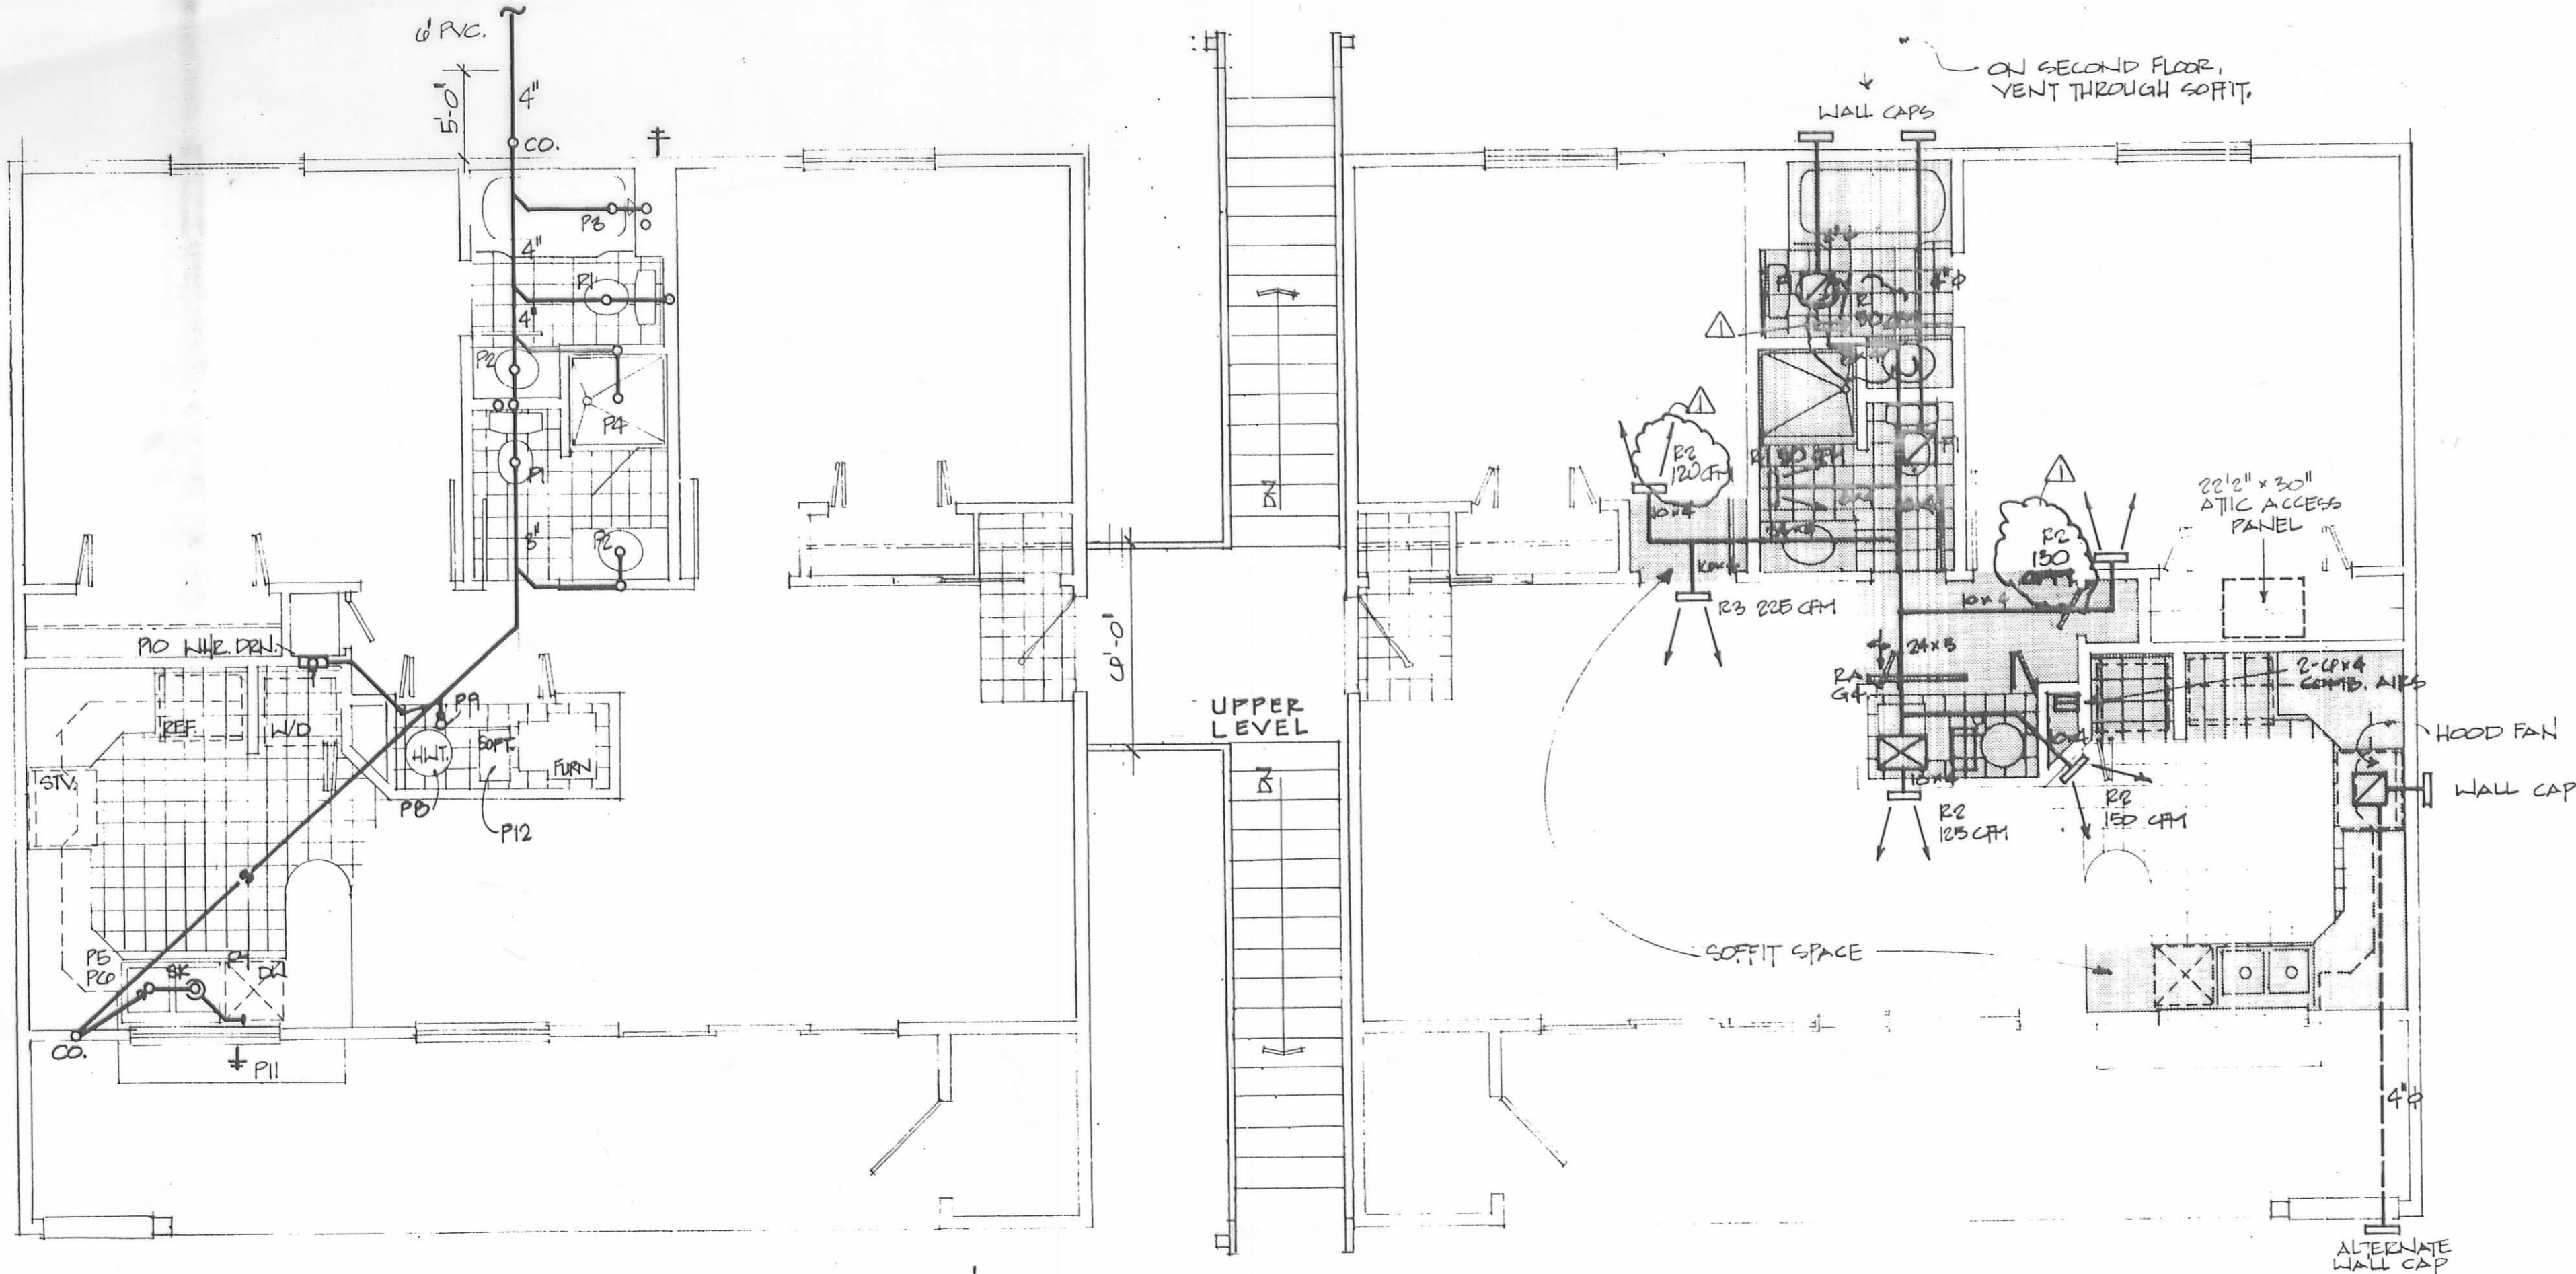


PLUMBING PLAN (TYP)

HVAC PLAN (TYP)

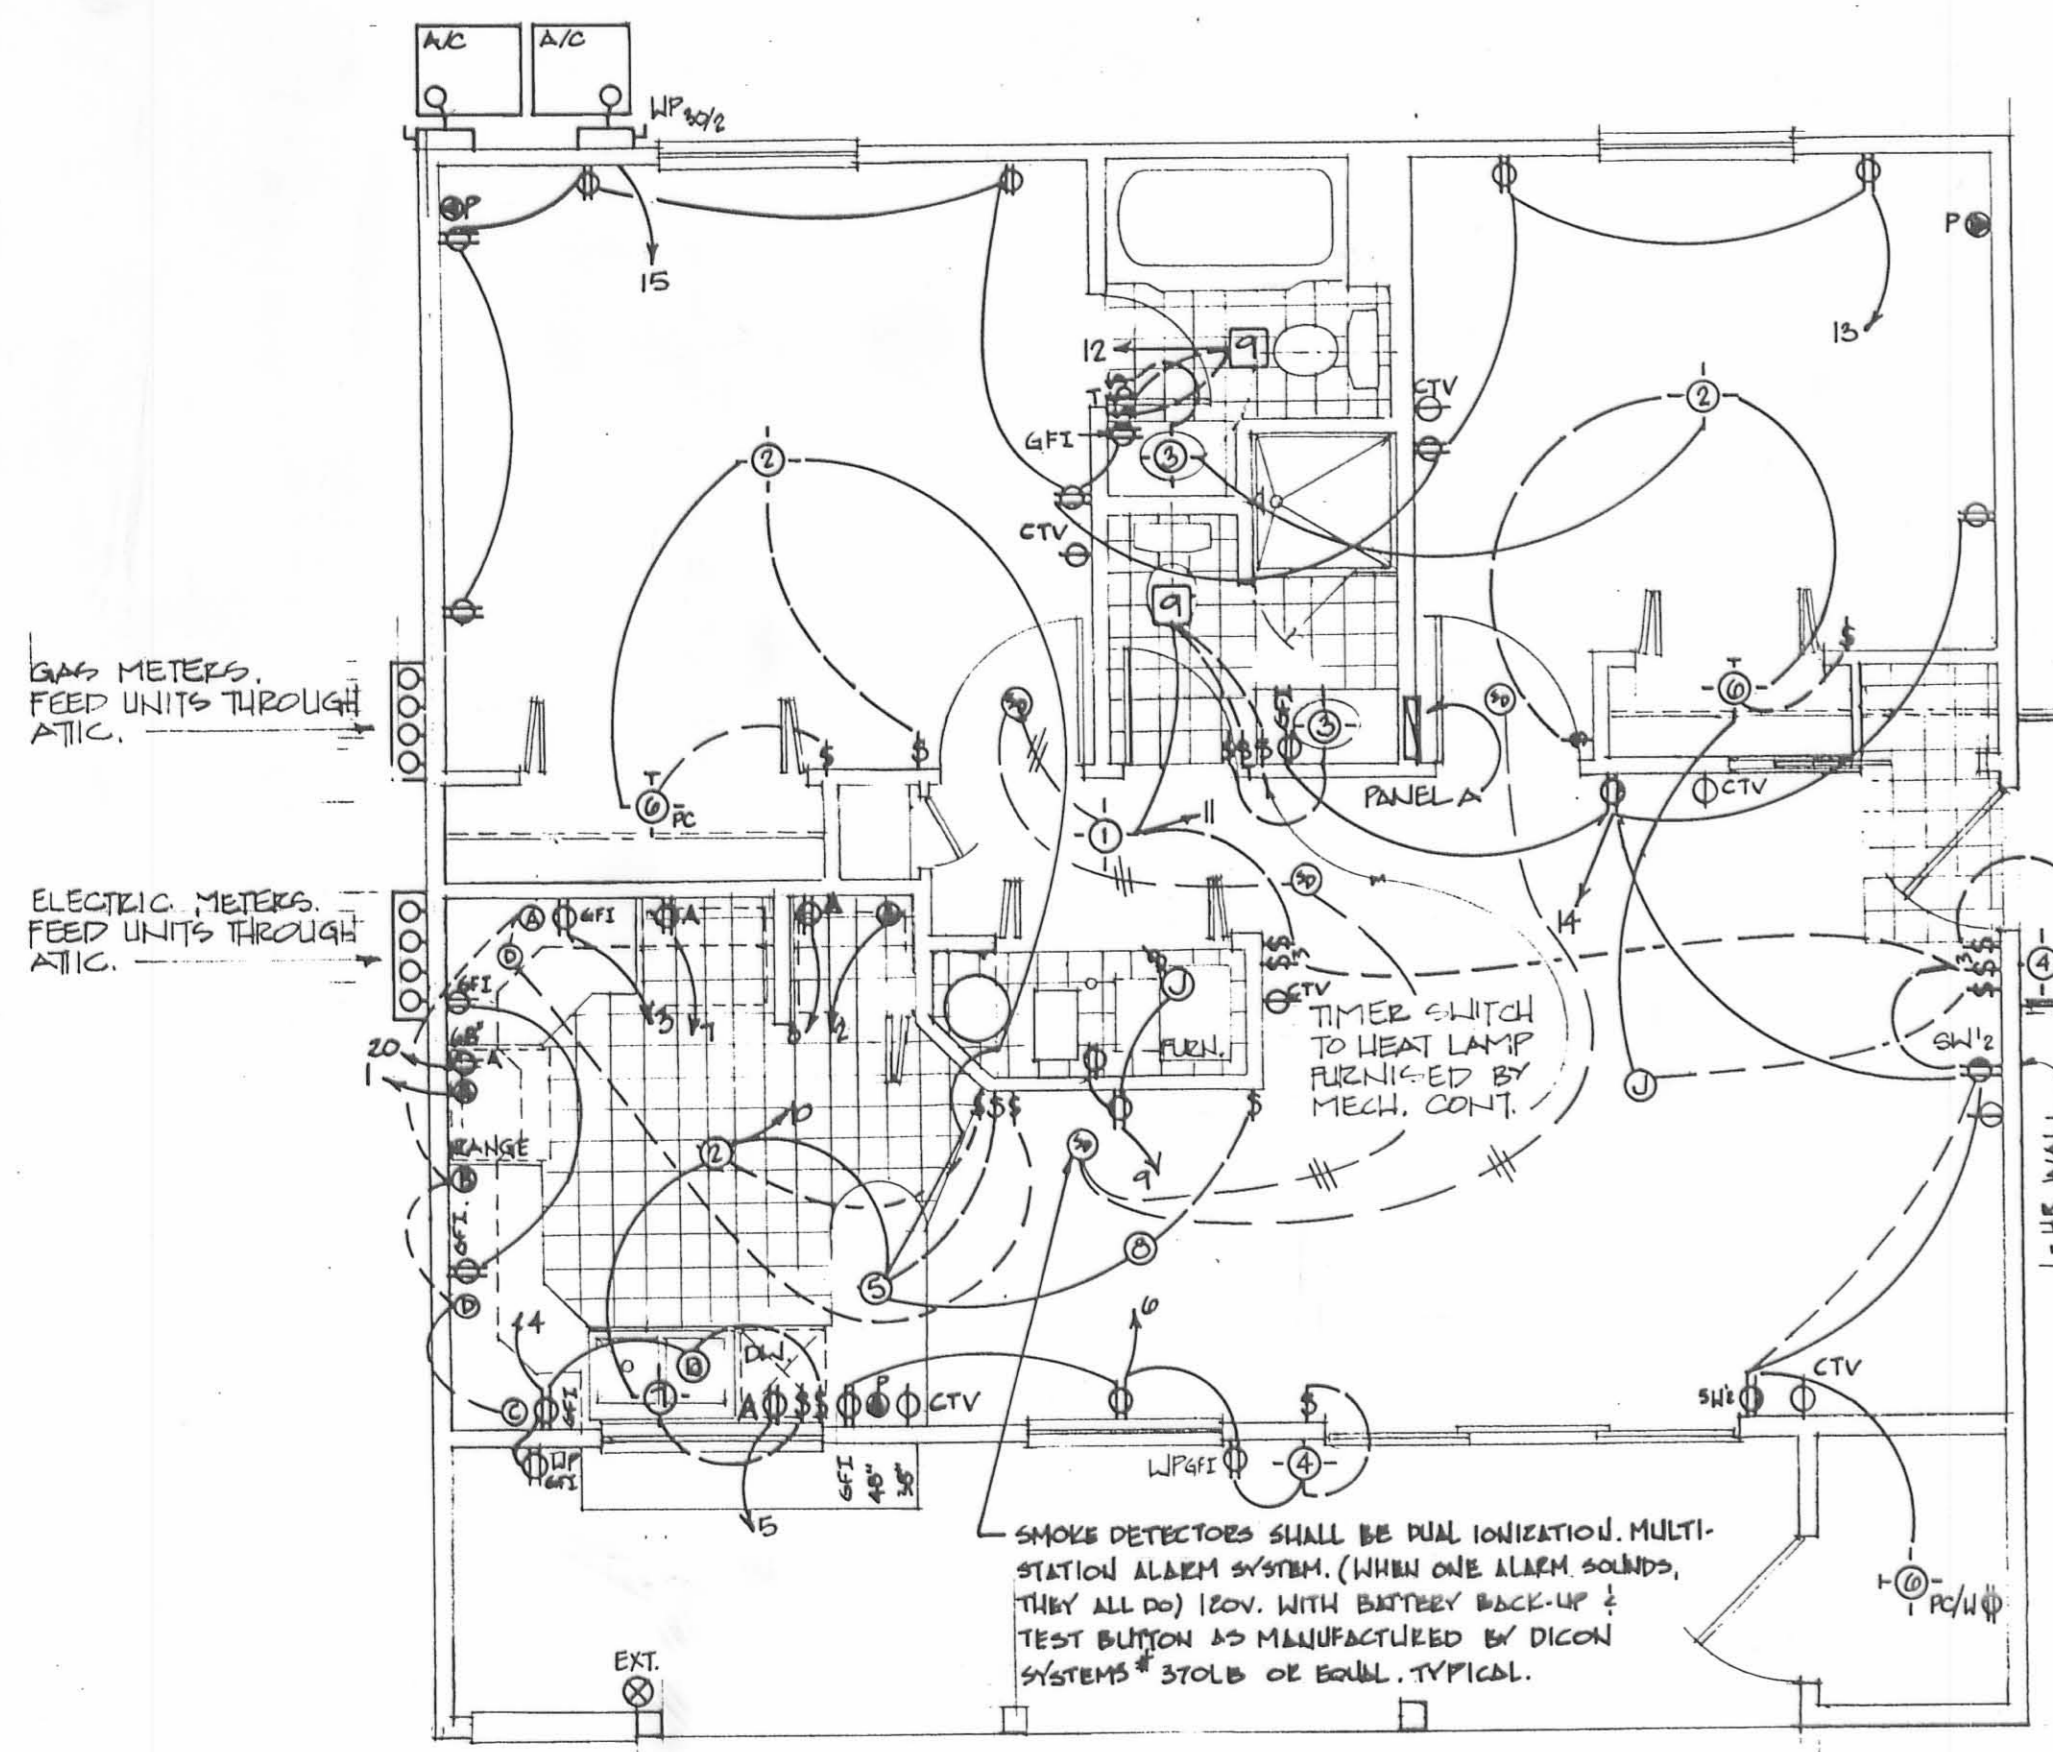

ELECTRICAL PLAN (TYP)

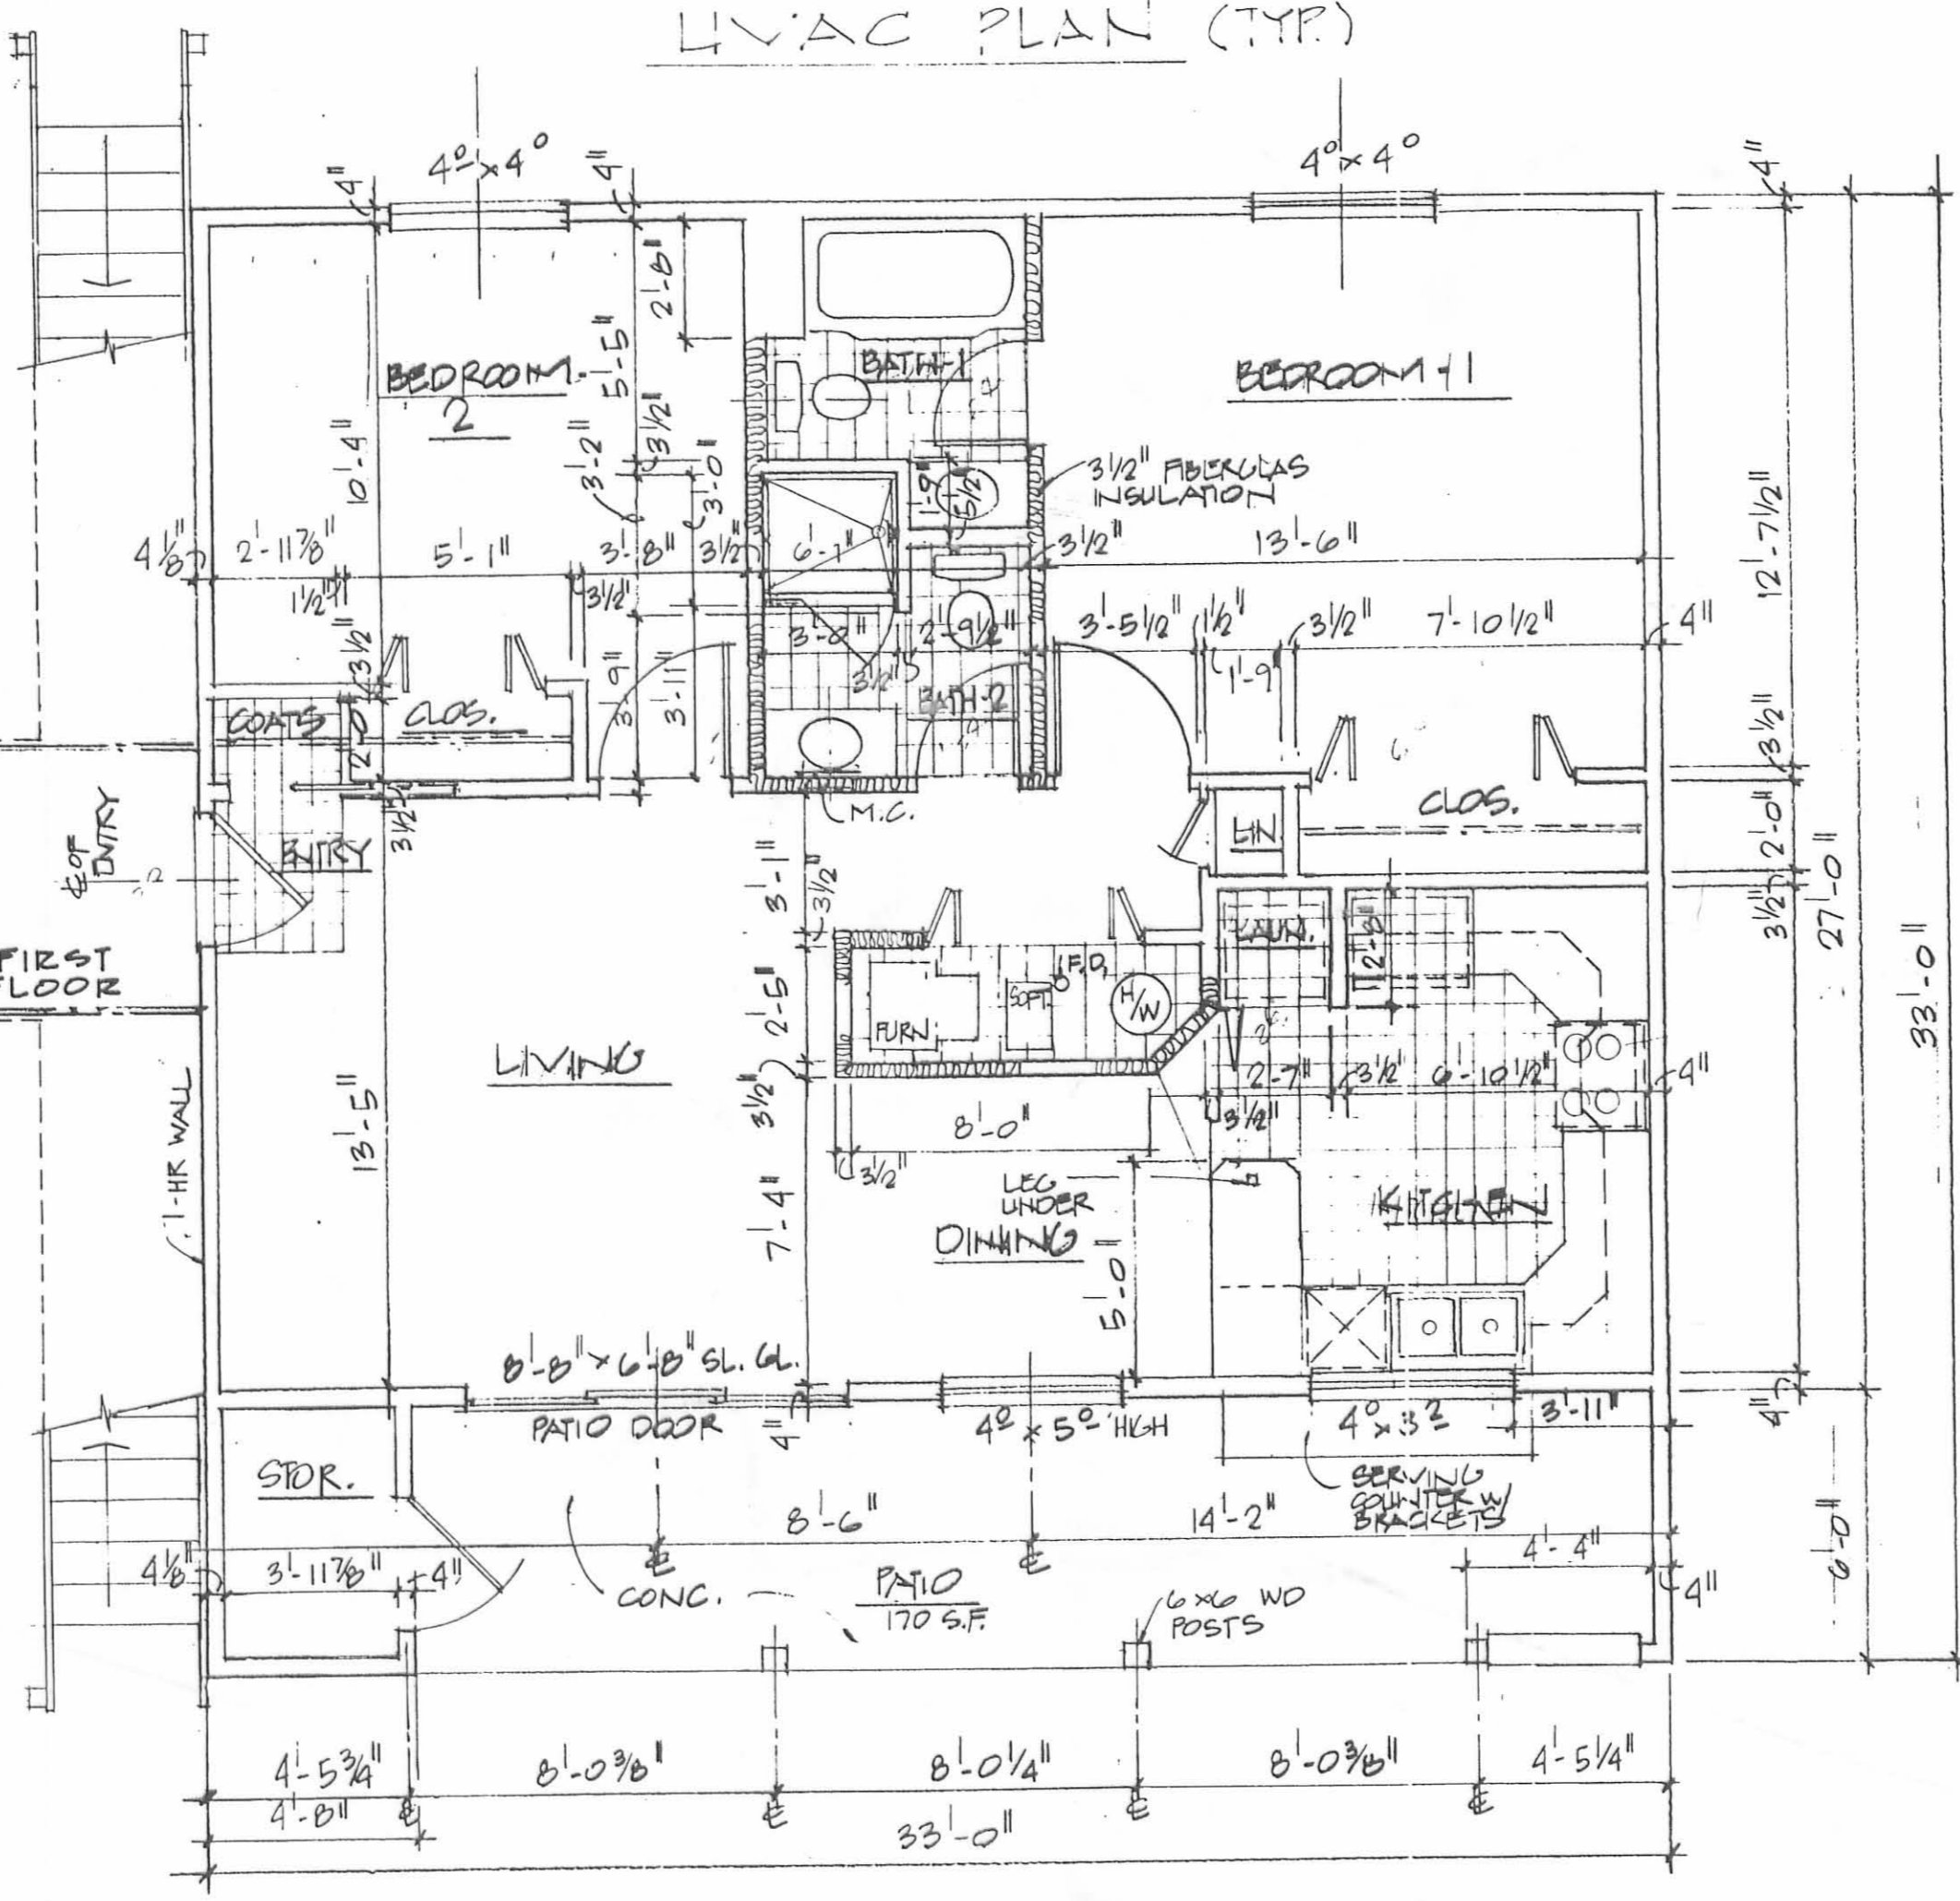

FLOOR PLAN 1/4"
 GROSS AREA: 919 S.F.

