Survey for Inlets
on Center St. between
Main & Walnut
Belle Center

0+00 West R/W line Main St.
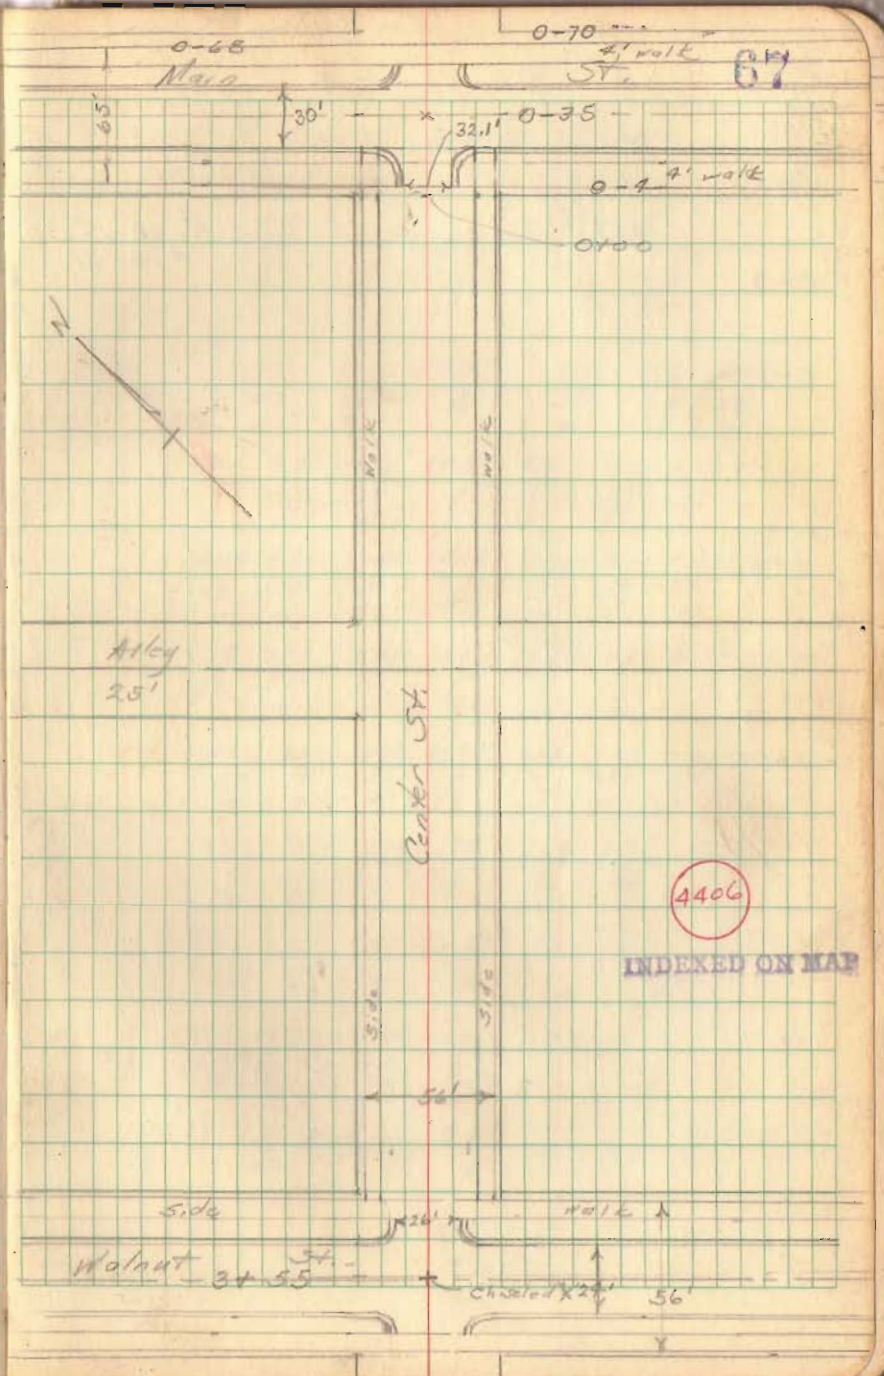
3+55 ℄ Walnut & Center St.