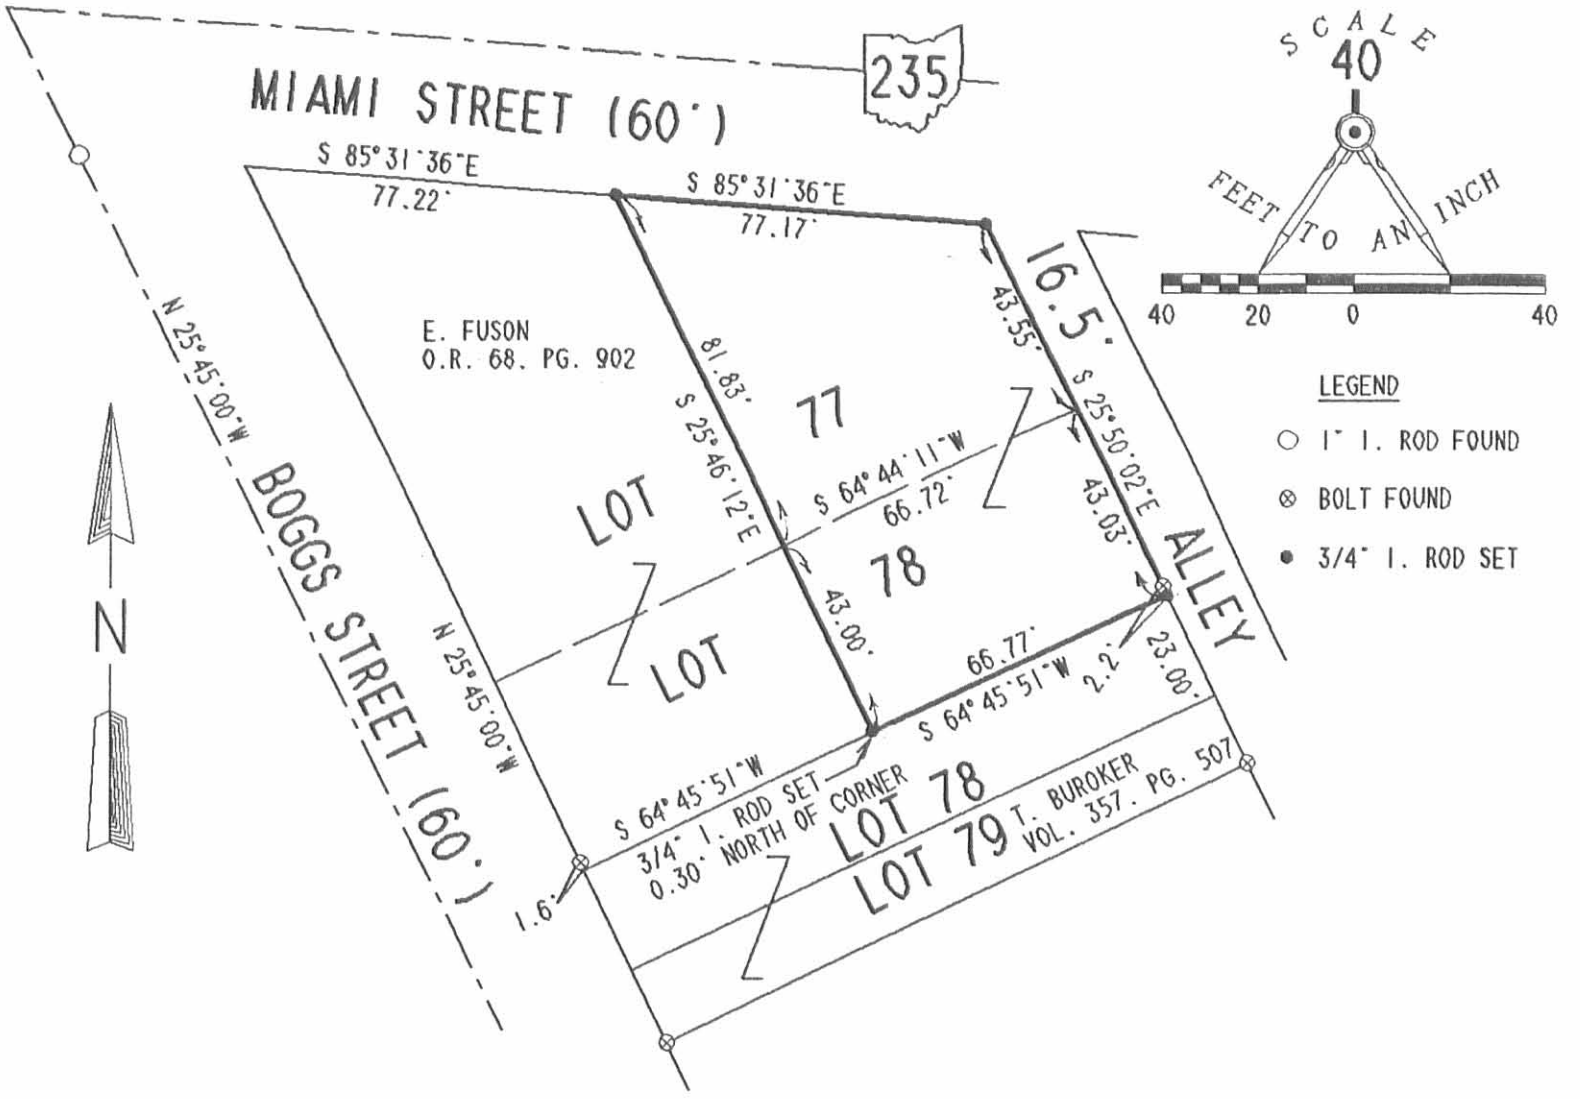

RETRACEMENT SURVEY OF PART OF LOTS 77 AND 78 FOR THE ETHEL BRUNSON ESTATE VOLUME 182. PAGE 548 VILLAGE OF DeGRAFF SECTION 12. TOWN 3. RANGE 13 MIAMI TOWNSHIP LOGAN COUNTY. OHIO

SURVEYED BY:

JEFFREY I. LEE
PROFESSIONAL SURVEYOR 6359
MAY 7. 1991

STATE OF OHIO
JEFFREY I. LEE 6359 REGISTERED SURVEYOR

LEE SURVEYING & MAPPING CO.
143 East Columbus Avenue
BELLEFONTAINE, OHIO 43311
(513) 593-7335

INDEXED ON MAP
8/23 IP

ORIGINAL STAMP IN GREEN

DISK 42 JCAREY

L 1912-5