Bill Jan 1924
" Aug. 12, 1925

See Note - Book 597 Page 34

Hamilton Survey Lot 2430 N. Madriver St. Bellefontaine.
(Robert Hamilton 556 N. Madriver St)

A Iron found See Page 60 for References
C. Stone " " " " " "
D Stone " " " " " "
E Iron with cover in Concrete street.
F Hub with Tack found.

G Hub placed by Wright
H " " " "
K " " " "
L " " " "

103

INDEXED ON MAP

AB = 166'-0"
G and H 30' from ℄ of Madriver. ?
DC = 428'-6" O.K with Plat.
CB = 216'-0" O.K " "
BF = 512'-4" Plat = ~~506'-6"~~ (Excess 5'-10")
FE = 213'-7½" Plat 216 Short 2'-3½"
CE = 512'-4" Plat ~~506'-6"~~ (Excess 5'-10")
Shortage at MN would be $\left(\frac{BM}{BF}\right)$(Shortage)

" " " " " $\left(\frac{186}{506.5}\right)\left(2'-3\frac{1}{2}"\right) = .84$

MN Would be (216.0 - .84) = 215.16
Without Streets
LK (Field) : LK (Plat) = MN (Field) : MN (Plat)
LK : 44 = (215.16-40) : (216-40)
LK = 43.79

July -10-1924
Fine Day

F. Wright
Ed. Core

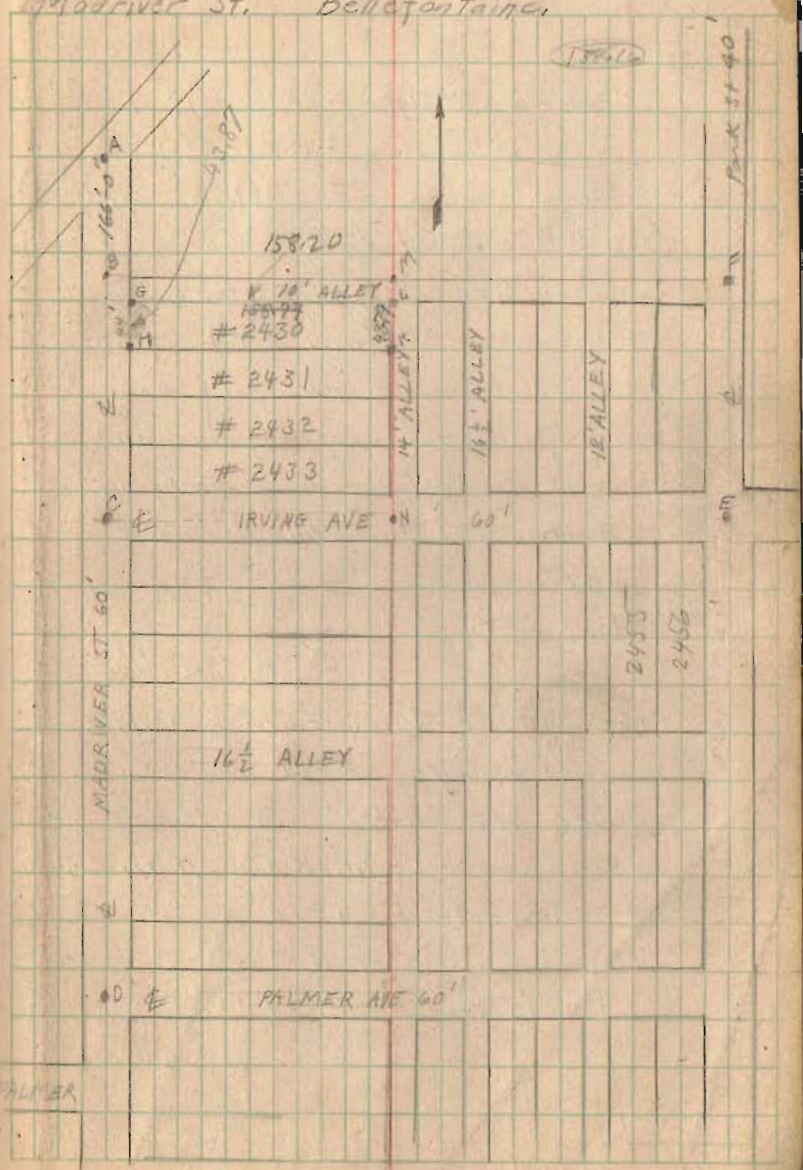

(over)