Sandusky & ~~Everett~~ West

West C.I. Marker Center of West and 5' south of center Sandusky
Top Screw Hyd NE 35.35
NW Cor fda 1SF SE 51.6
NE Cor 1½ SF SW 56.95
Top marker 10" below surface

Sandusky & Everett
see Record No 1 page 91 Pointon
Big 4 RR

Sand- Center Col & Everett S 526.4'

" Center line produced to point on Big 4 Ry near East side Everett C.I Marker N edge of N rail Main line Big 4 Ry S 55.7' Iron Post
Ry Signal Bell N of W 44.33'
Telephone pole N W 21.35

Garfield & West Iron pin
Top Screw Hyd NE 27.6
Water Valve Box N W 28.45
N E Cor fda 2 SF Res S W 36.2'
Telep pole S E 30.9
N E Cor Cement Spandrell wall W end
Culvert S.W. 42.0"
Maple 8" N.W. 58.9'

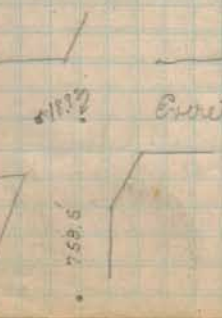

2645
34
230,1

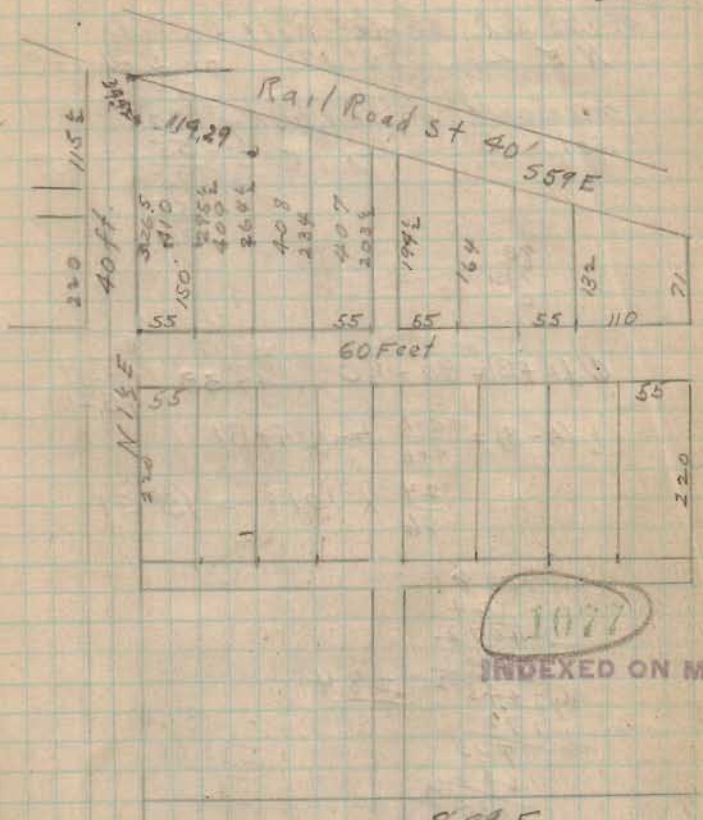

1077

INDEXED ON MA