X

Survey for Dr Chalfhant

(1252)

INDEXED ON MAP

Dec 22 1931
Ed Core
E Wright

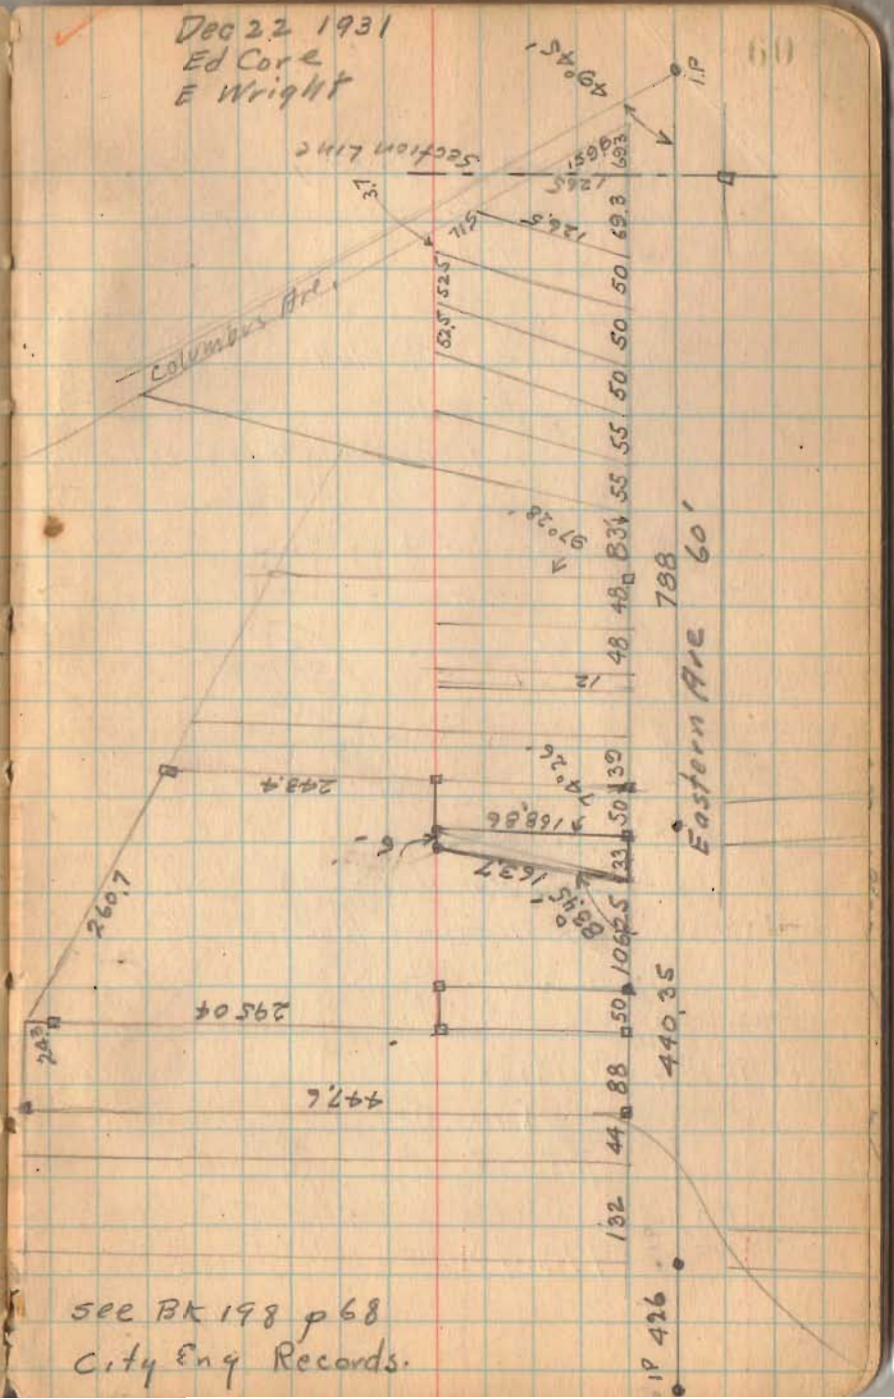

see Bk 198 p 68
City Eng Records.