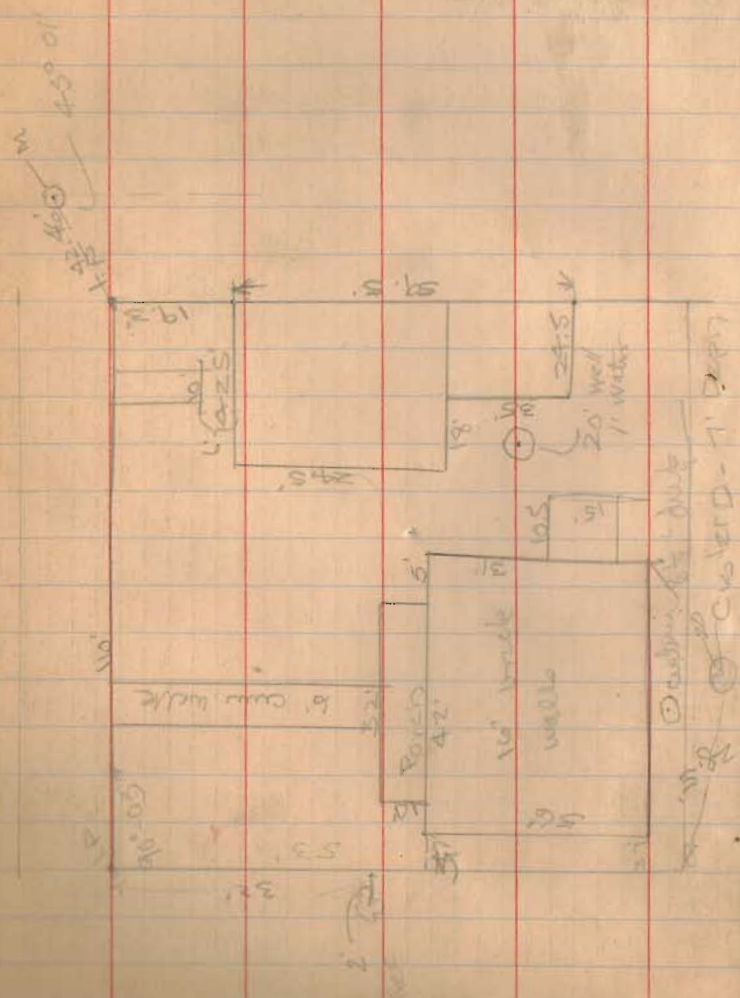

Detroit St 36' between Curbs
" " ~~4½~~ 15' Boulevard
4' Sidewalks
3' from Prop line

Chillicothe Ave 32' between Curbs
5' Walks
8' boulevard
Walks 1' off P line

Water Mains.
Detroit St
8" Main 6.5 E of W curb
6" " ℄ of St.
Chilli. Ave
6" Main 16' N of S curb

1" water Service } 4' E of W Prop line
1" Gas service } to be marked

INDEXED ON MAP

2180

Walls 1A X 32 x 7½ — 4 above Gr

Basement Walls 12 X 32 X 8 — 2

Depth Basement, 7½'

Ht above Ground ———

Excavation

Diang of cisterns & well

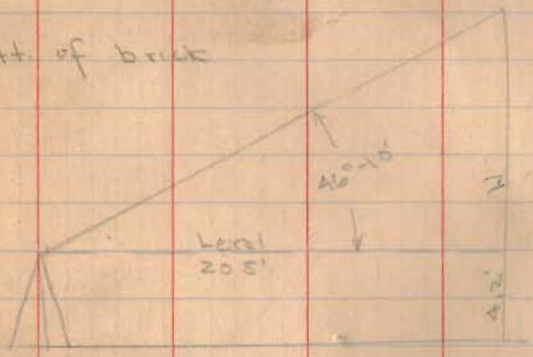

tang 46°-10' = 1.0416
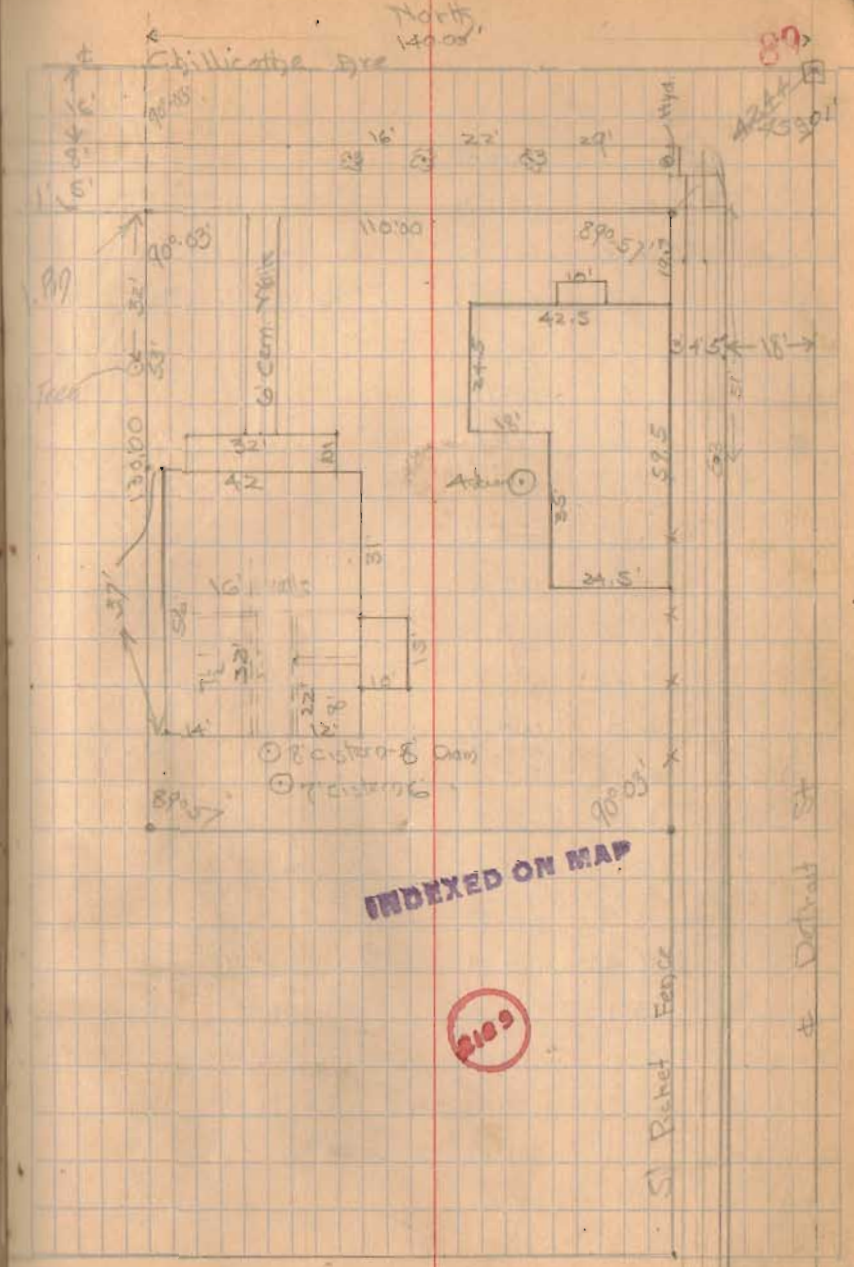
20.5 x 1.0416 = 25.5' = H