Hot

SURVEY OF LOTS
1875-1876
Iron City
Bellefontaine Ohio
June 9, 1933

"A" 1½" Iron bar (found) 15" below surface
12" Soft Maple SE. 29.7
12 Hard " SW. 29.3
8" Soft " NW. 29.3'

"B" 1" Iron bar (found)
E. rail C&LE. West 3.2'
Guy Pole SE. 29.4'
O.E Pole S.W 29.3'
10" tree N.W. 29.7'

Record in
Book A Vol. 2
Logan County Records.

Chas P. Inskeep
John A. "
Surveyor
Iron N'C'Wade

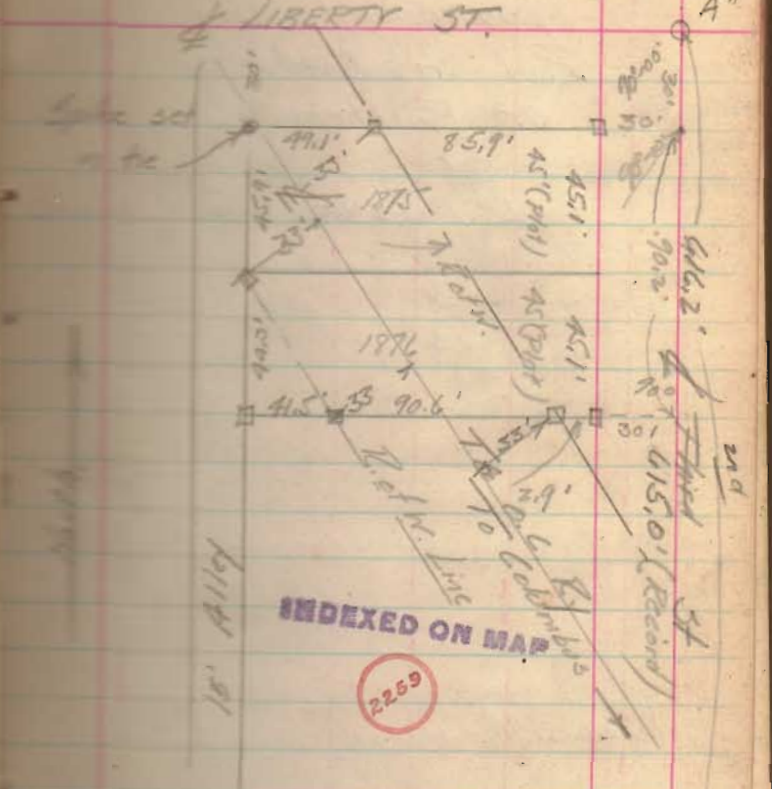
LIBERTY ST.
"A"
"B"
Stake set
49.1'
85.9'
45'(Calc)
45'(Plat)
45.1'
45.1'
45.1'
44.3'
44.5'
90.6'
7.9'
15' Alley
E. of W. Line
C&LE
Ry
Columbus
G16.2'
G15.0'(Record)
30'
30'
30'