Survey of Property for
Mrs. Ethel May Outland
Garfield Ave, Bellefontaine
Part of 35-A-14

A Found old stake
Set pipe on N. side

B - Set pipe on Line

South part of AB (about ½)
old fence — (25 to 30 yrs)

C Set pipe on Line

D Set pipe

E Found old bolt

C.A. Instcop 7/30/38
J.H. Instcop

59

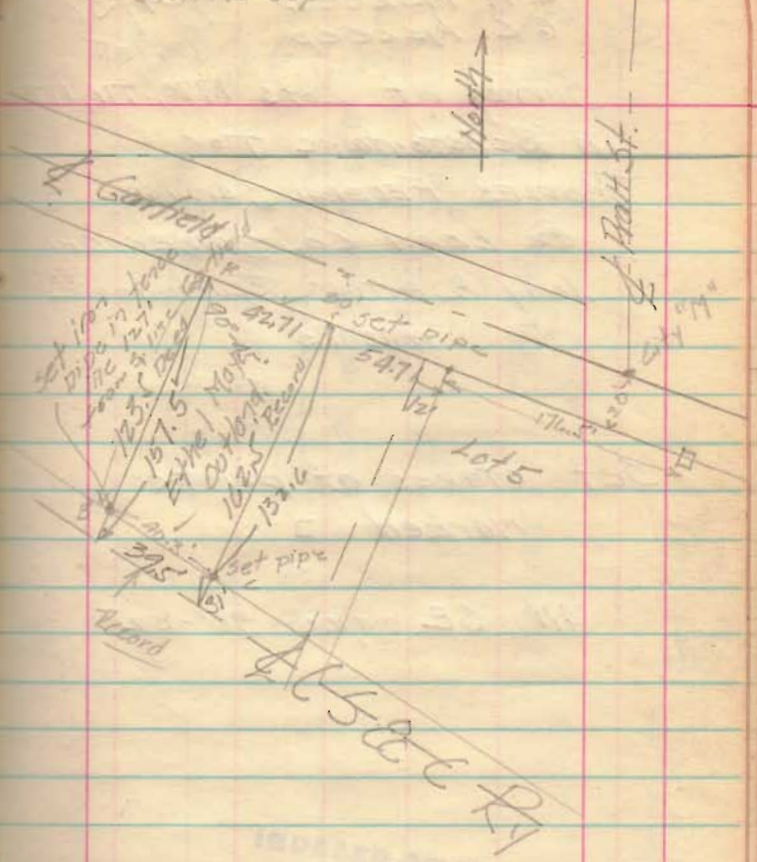

INDEXED ON MAP
2283