Survey of Lots 649 & 650
High Street
Bellefontaine, Ohio
for
Gilbert Tiffer

From	To	N or S	Plat	Meas	±
Mad River	Park	Brown	506.6	506.9	-0.6'
Brown	High	Park	430.5	432.25	+1.75'
Park	Mad River	High	506.5	505.9	-0.9'
High	Brown	Mad River	430.5	430.1	-0.9

3/12 × 1.75 = 1.75 / 12 = .6

3/12 × .6 = 7/12 = .7

156.6 − 155.8 = .8

Cahoskeep
FL Howell
Robt Huggins
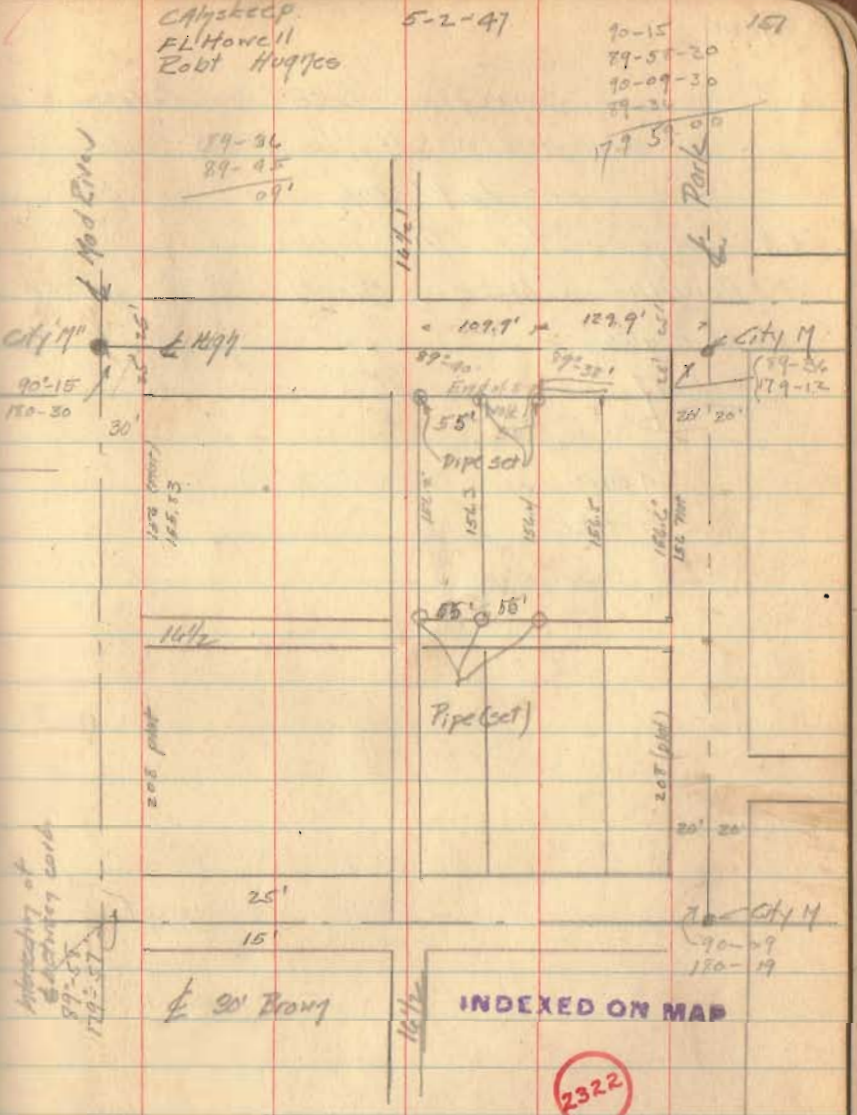
5-2-47