T.E. SAVAGE SURVEY

R.R. 2 Bellefontaine

See FB 588/17 For

Survey C.H 8 (S.R. 540)

INDEXED ON MAP
2834
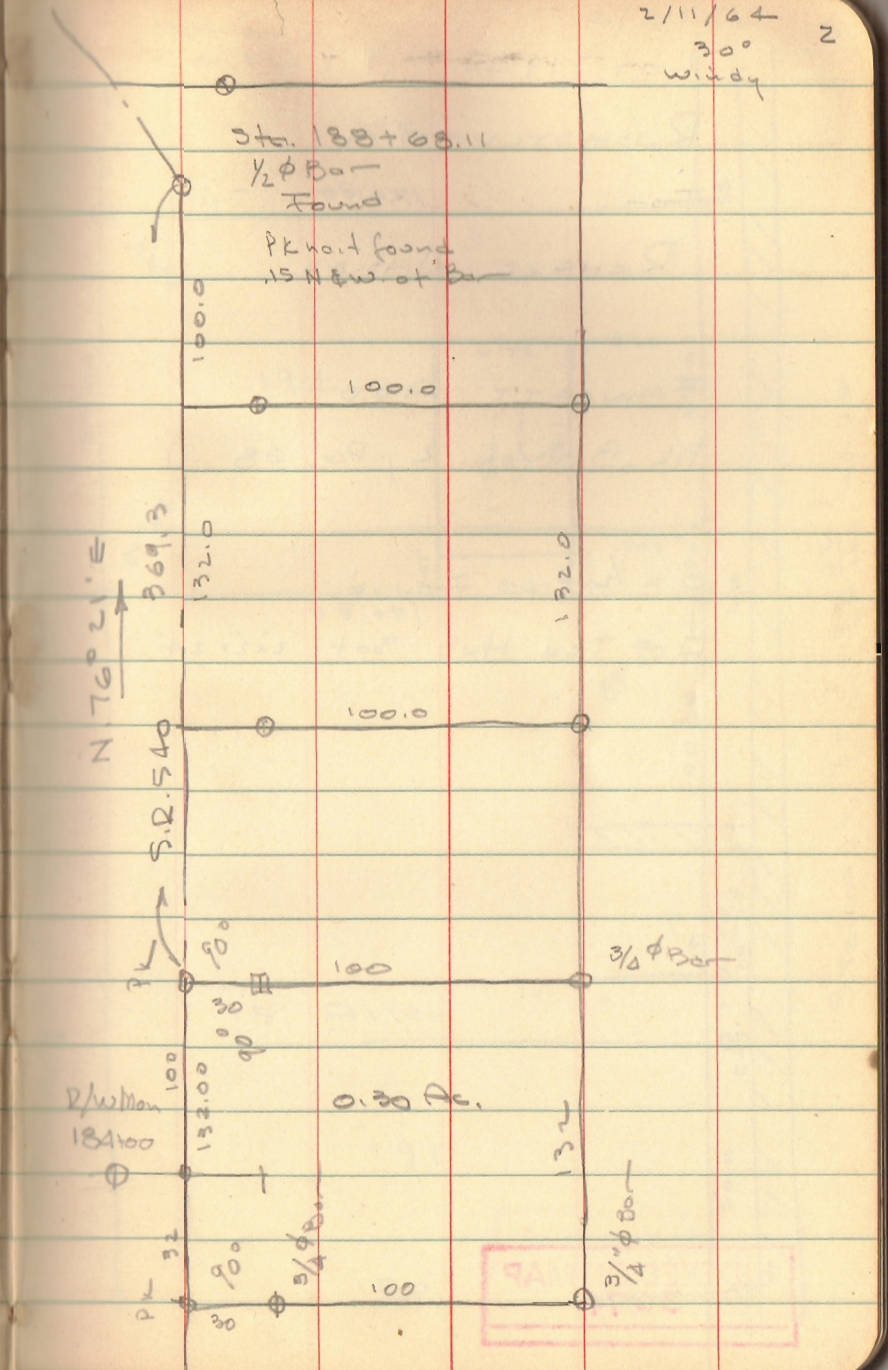
2/11/64
30°
windy
2