

LESLIE H. GEESLIN

REGISTERED SURVEYOR NO. 5248

P. O. BOX 274

RUSHSVLVANIA, OHIO 43347

PHONE: (513) 468-2793

SOORS SURVEY

September 10, 1975

The following described real estate situated in Bellefontaine, Ohio and being part of Virginia Military Survey No. 4990 and being more particularly described as follows:


Beginning at an iron pipe at the southeast corner of Frances L. K. Vaughn's 0.36 acre tract and in the west line of Woneta V. Sours' 0.70 acre tract, said iron pipe being S. $0^{\circ} 30'$ W. 200.0 feet from the south line of Columbus Ave. as described in Deed Book Volume 353 page 239; thence S. $86^{\circ} 26'$ E. 93.43 feet to an iron bar in the west line of Eva Belle Harbert's 0.27 acre tract; thence with said Harbert's west line and the west line of Frederick E. Houchin's 1.99 acre tract S. $0^{\circ} 30'$ W. 121.96 feet to an iron pipe, passing a 4" square concrete monument at the southwest corner of said Harbert's 0.27 acre tract at 18.50 feet; thence N. $89^{\circ} 32.8'$ W. 93.3 feet to an iron pipe; thence N. $0^{\circ} 30'$ E. 127.03 feet to the place of beginning.

Containing 0.267 acre more or less.

The above described 0.267 acre being on the south side of Woneta V. Sours' 0.70 acre tract.

I hereby certify that the above is a true and accurate description of a survey made by me.

Leslie H. Geeslin

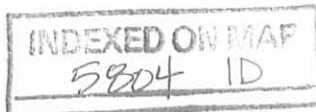

COLUMBUS AVE.

CONC. SIDEWALK

IRON PIPE FO

FRANCES L. K. VAUGHAN
0.36 AC.

WONETA V. SQUIRES
0.70 AC.

EVA BELLE HANBERT
0.27 AC.



200.0'

200.0'

5.36° 26' E.
93.43'

93' IRON BAR SET

IRON PIPE FO

N. 0° 30' E.
127.03'

0.267 AC.

121.96'
5.0° 30' W. 118.50'

2" x 4" CONC.
MON. FO.

FREDERICK E.
HOUGHIN
1.99 AC.

IRON PIPE FO

93.3'
N. 89° 32.8' W.

IRON PIPE FO

DWIGHT H.
REED
0.51 AC

N

0.25 AC.

SOURS SURVEY
SEPTEMBER 10, 1975
V.M.S. 4990
LAKE TOWNSHIP
BELLEFONTAINE, OHIO
SCALE 1" = 50'

5804 IP

INDEXED ON MAP

LESLIE H. GESSLIN
REG. SURVEYOR 5143
RUSHSVLVANIA, OHIO

EUGENE DIETZEN CO.
MADE IN U. S. A.

NO. 375 N.S.
DIETZEN "NO PRINT"
GRAPH PAPER
5 1/2" x 8" INCH