HESS
March 25, 1972

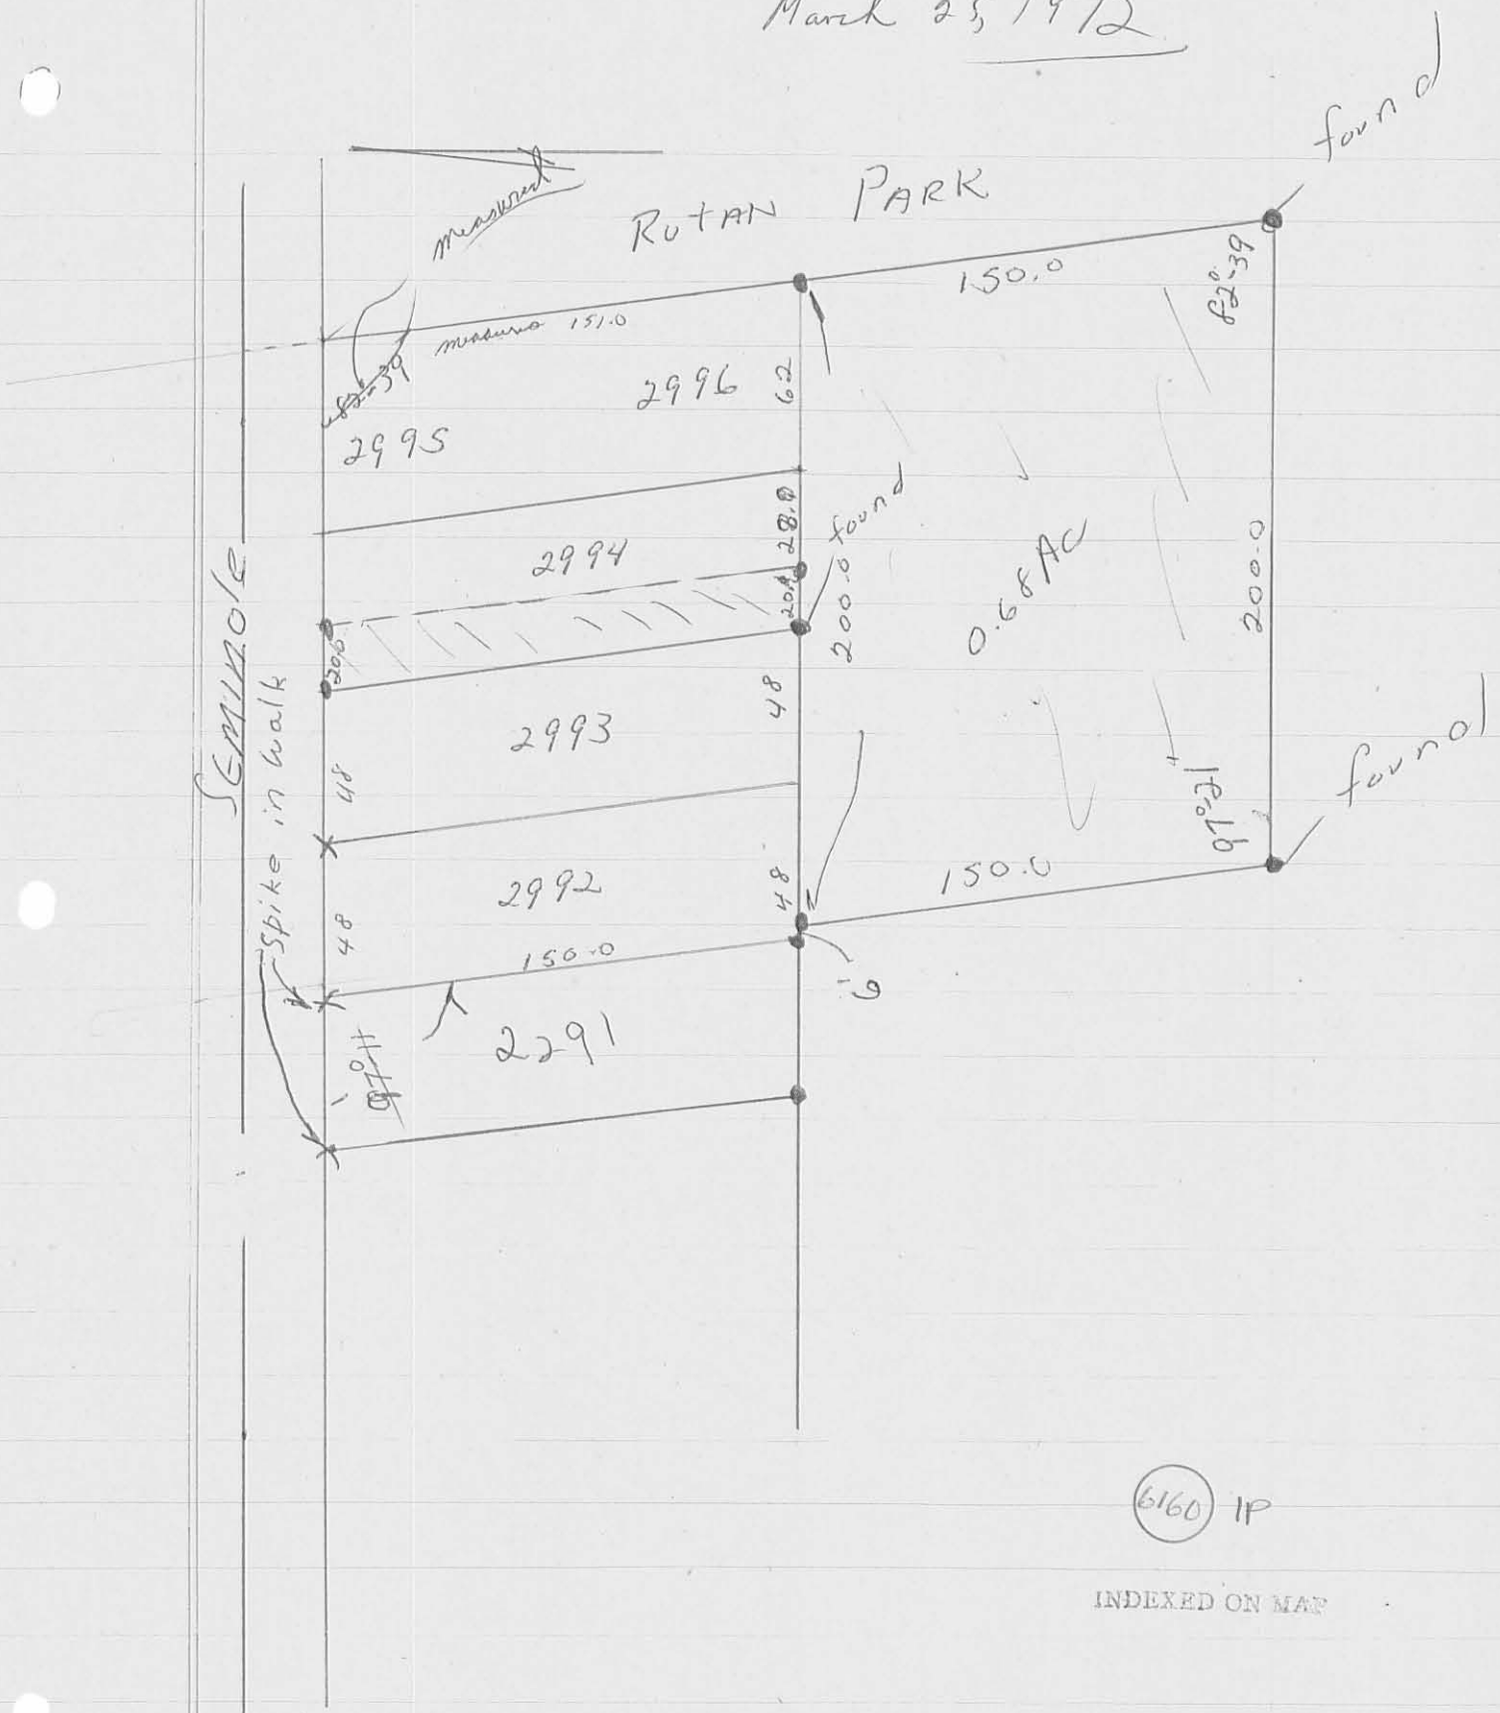

6160 1P

INDEXED ON MAP