

1 Received 10-5-92 OF 10-7-92

LESLIE H. GEESLIN
REGISTERED SURVEYOR NO. 5248
P. O. BOX 274
RUSHSVLVANIA, OHIO 43347

TELEPHONE: (513) 468-2793

RESOLUTION TRUST CORPORATION SURVEY
September 30, 1992

The following described real estate situated in the State of Ohio, County of Logan, Township of Lake, being part of Virginia Military Survey 4990 in the City of Bellefontaine and more particularly described as follows:

Beginning at a 5/8 inch iron bar set in the east right-of-way line of Hayes Street at the northwest corner of Betty Young's 0.15 acre tract as described in D. B. Vol. 374 Page 693, said iron bar being NORTH 301.30 feet from a 5/8 inch iron bar found at the intersection of the right-of-way lines of Hayes Street and Columbus Avenue.

Thence with the right-of-way line of said Hayes Street NORTH 43.90 feet to a 5/8 inch iron bar set at the southwest corner of Dorothea Heil's 0.16 acre tract as described in O. R. Vol. 133 Page 834.

Thence with said Heil's south line S. 89° 28' 00" E. 170.00 feet to a 5/8 inch iron bar set in the west line of Eric Nelson's 1.7 acre tract as described in D. B. Vol. 389 Page 105.

Thence with said Nelson's west line SOUTH 44.00 feet to a 5/8 inch iron bar set at said Betty Young's northeast corner.


Thence with said Young's north line N. 89° 26' 00" W. 170.00 feet to the place of beginning.

Containing 0.172 acre more or less.

The above described 0.172 acre tract being the same as M & M Federal Savings' 0.16 acre tract as described in O. R. Vol. 152 Page 606.

Bearings are based on an assumed bearing (NORTH) for the east right-of-way line of Hayes Street in this field survey by Leslie H. Geeslin, Reg. Surveyor 5248 on September 30, 1992.

INDEXED ON MAP
8751 ID

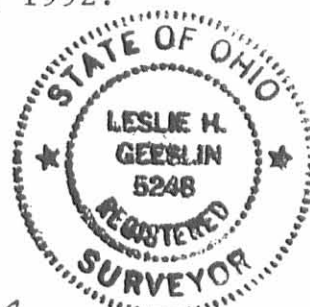

Leslie H. Geeslin

HAYES STREET

NORTH

301.30'

43.90'

5/8" IRON BAR FOUND

5/8" IRON BAR SET

5/8" IRON BAR FOUND

DOROTHEA HEIL
0.16 AC.
VOL 133 PAGE 834

S. 89° 28' 00" E 170.00'

0.172 AC.

N. 89° 26' 00" W. 170.00'

BETTY YOUNG
0.15 AC.
D.B. VOL. 374 PG. 693

SURVEY OF A 0.172 ACRE TRACT
IN THE CITY OF BELLEFONTAINE
VIRGINIA MILITARY SURVEY 4990,
LAKE TOWNSHIP LOGAN COUNTY
OHIO FOR THE RESOLUTION TRUST

SCALE: 1" = 20'



COLUMBUS AVE.

5/8" IRON BAR SET

44.00'

SOUTH
ERIC NELSON

1.7 AC.

D.B. VOL. 389 PAGE 105



INDEXED ON MAP
8751 IP

Leslie H. Geeslin
LESLIE H. GEESLIN
RUSHSVLVANIA, OH
(513) 468-2793